Crane St. – E.L. Bluff. to W.L. Broadview

BM. Elev. 165.35 ℄ on W.E. curb radius S.W. cor Fountain & Bluff
~~14.43~~ E end curb rad. S.E. cor Bluff & Broadview
14.43

Note: Add 50 to Elevations.

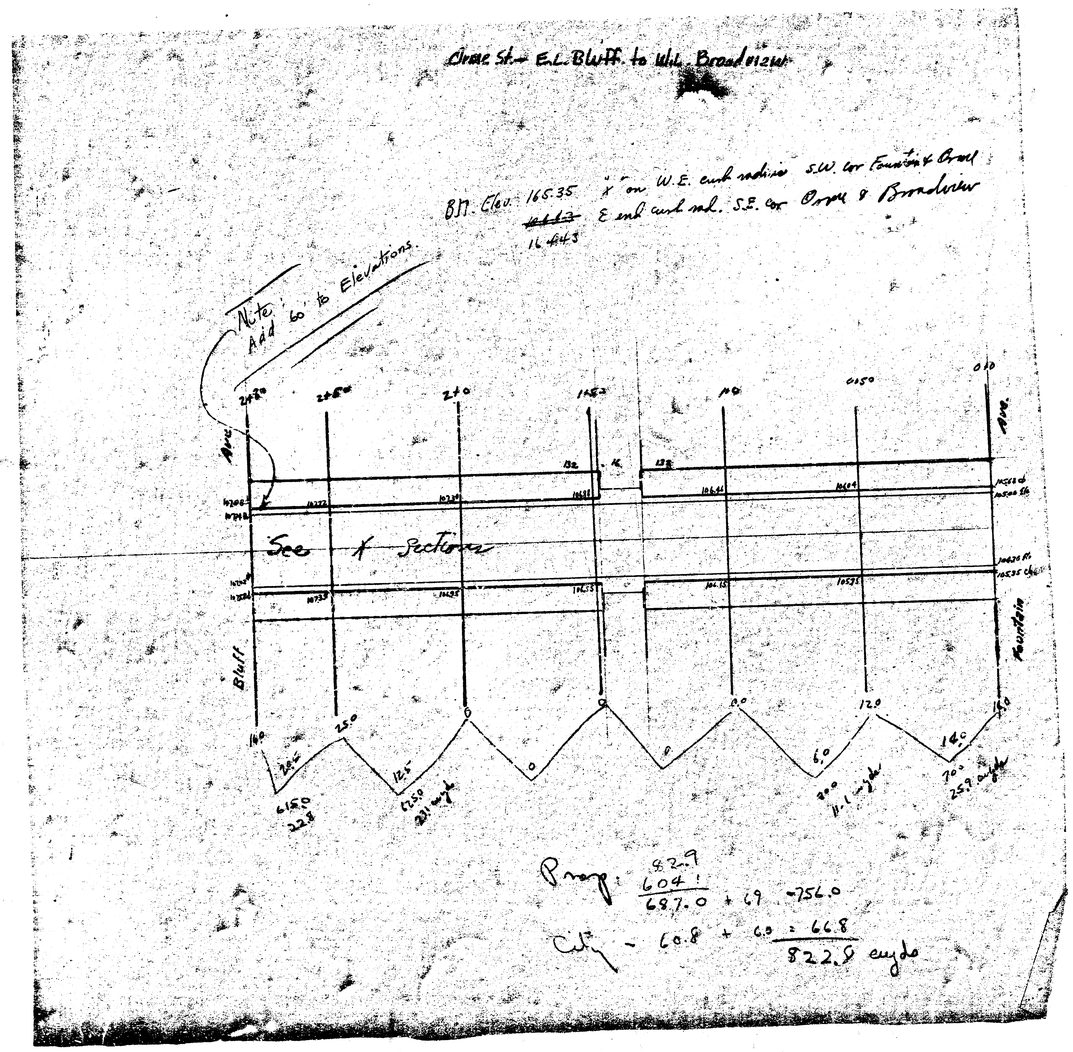

Prop: 82.9
604.1
687.0 + 6.9 = 756.0

Cut - 60.8 + 6.0 = 66.8
822.8 cu yds

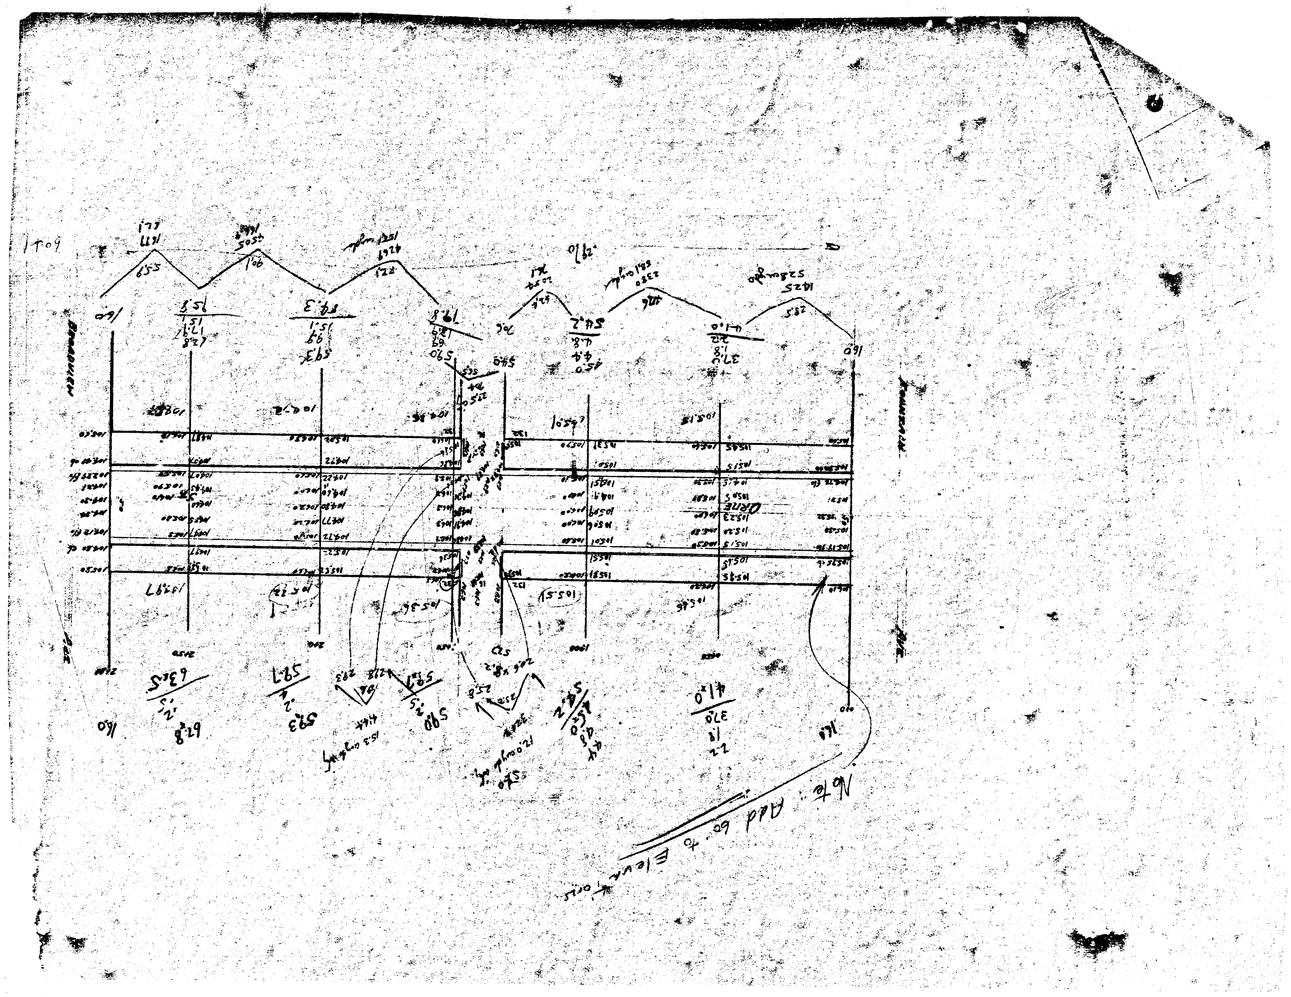
Broadway
Note: Add 60' to Elevations
N