



NOTE ALL DRIVES BUILT 5' BACK OF R

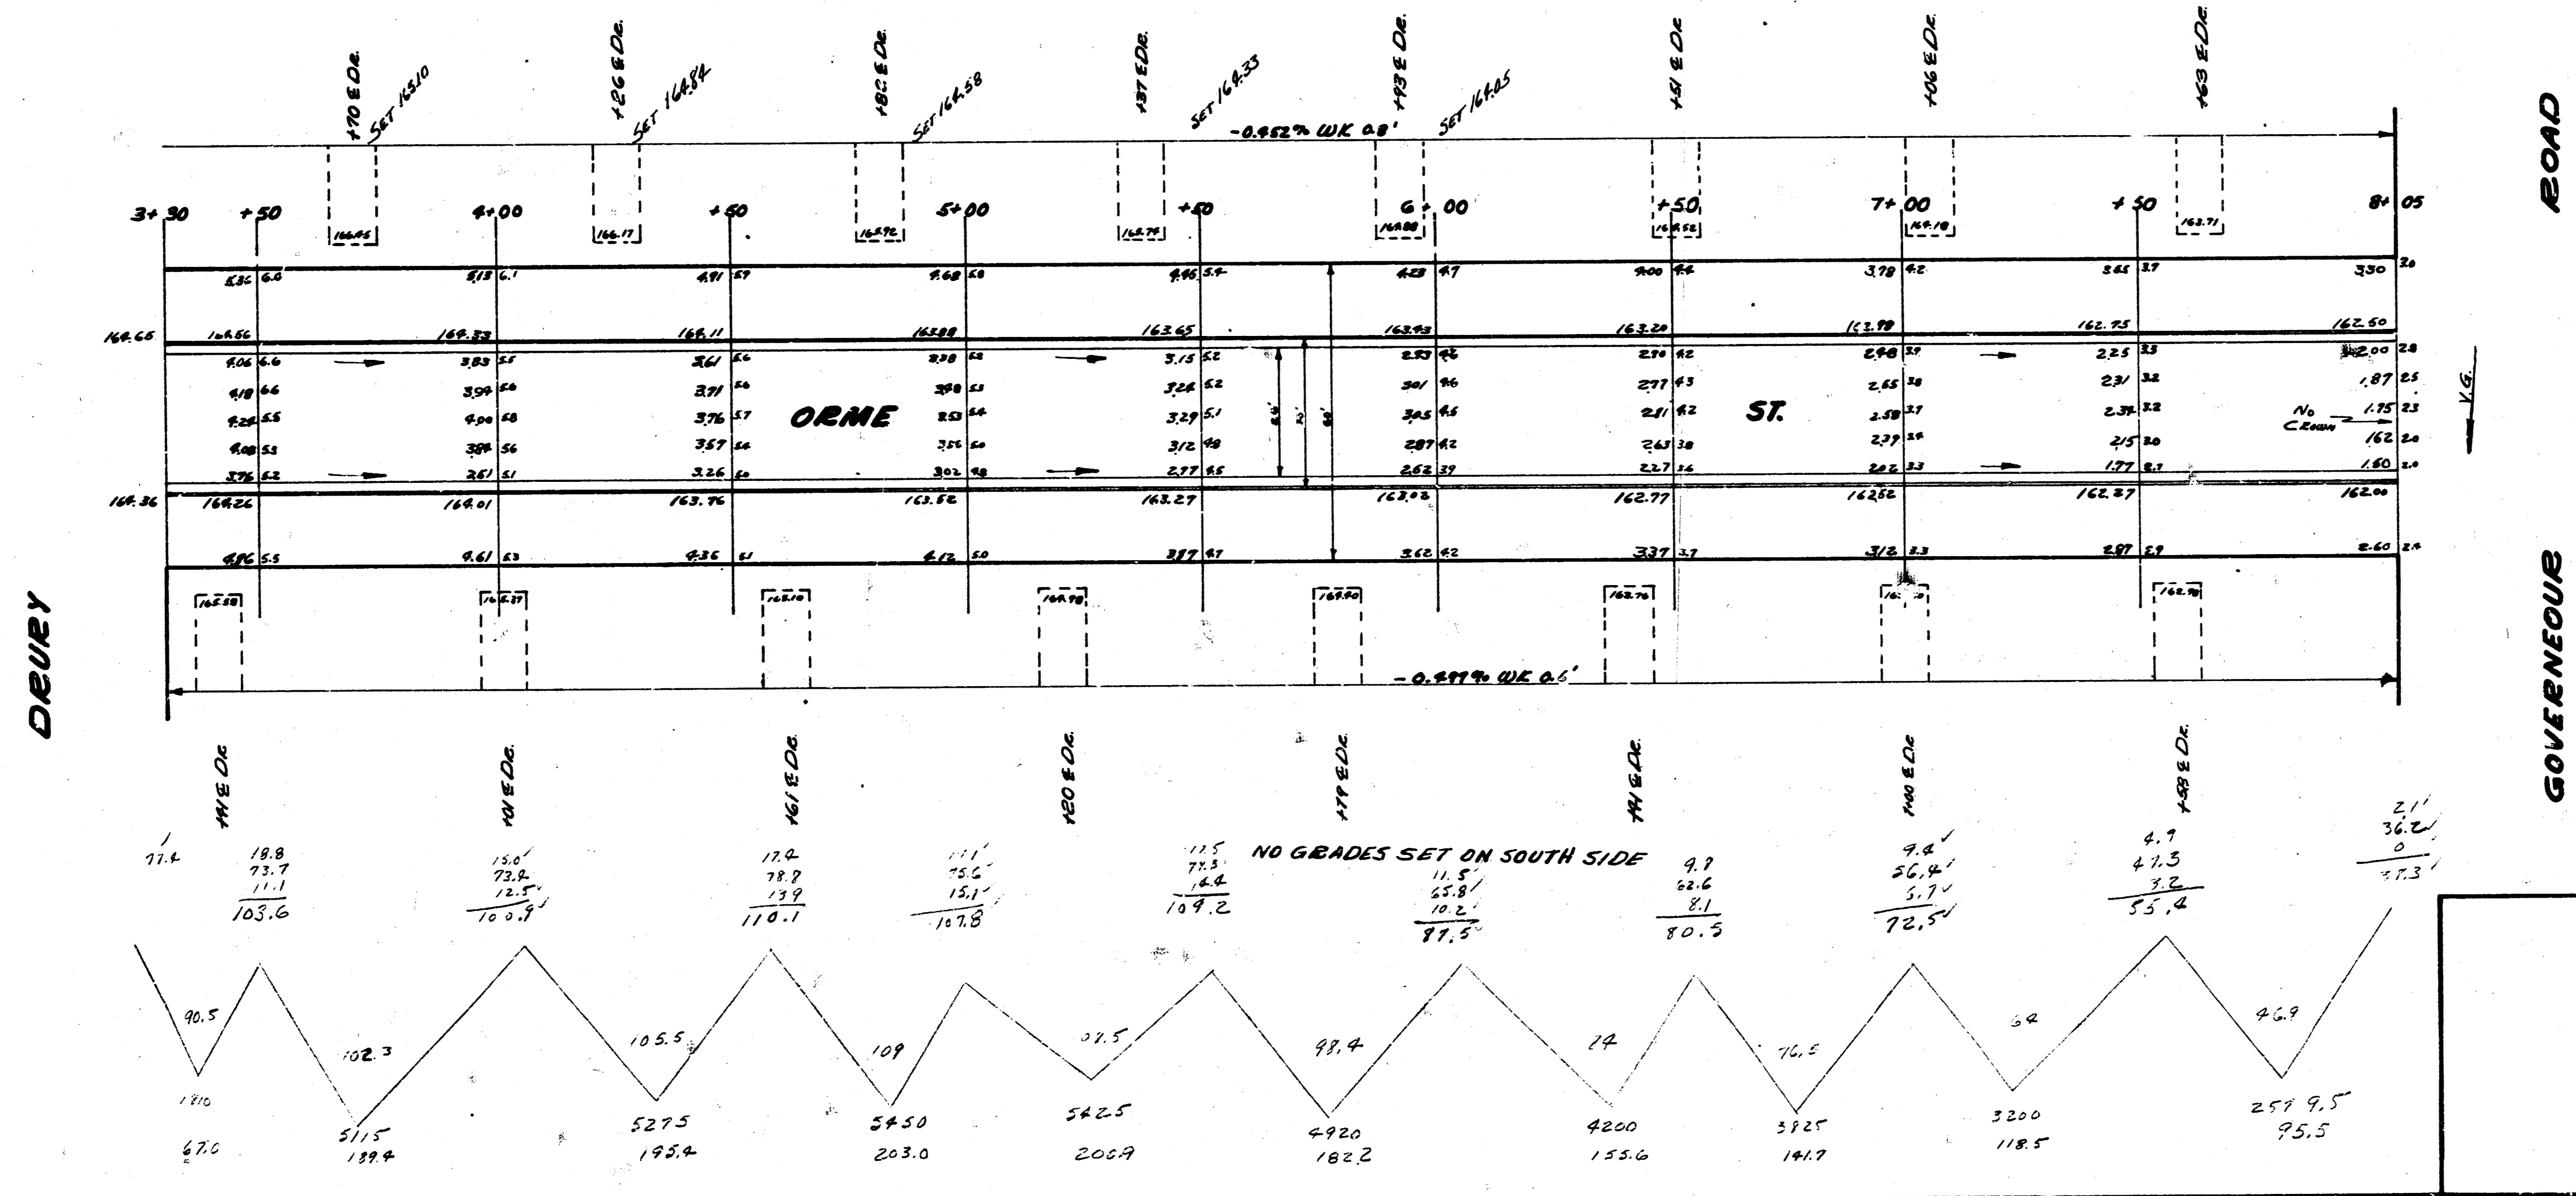

ORME
2/2

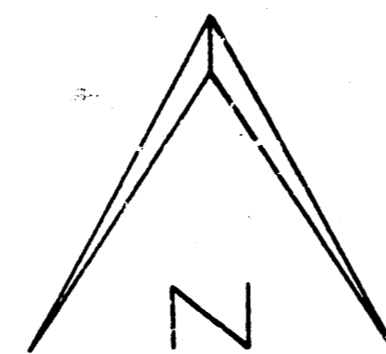