



Plan 5
1/4

B.M. 155.90 "X" on cb W.S. Yale N.S. Orme

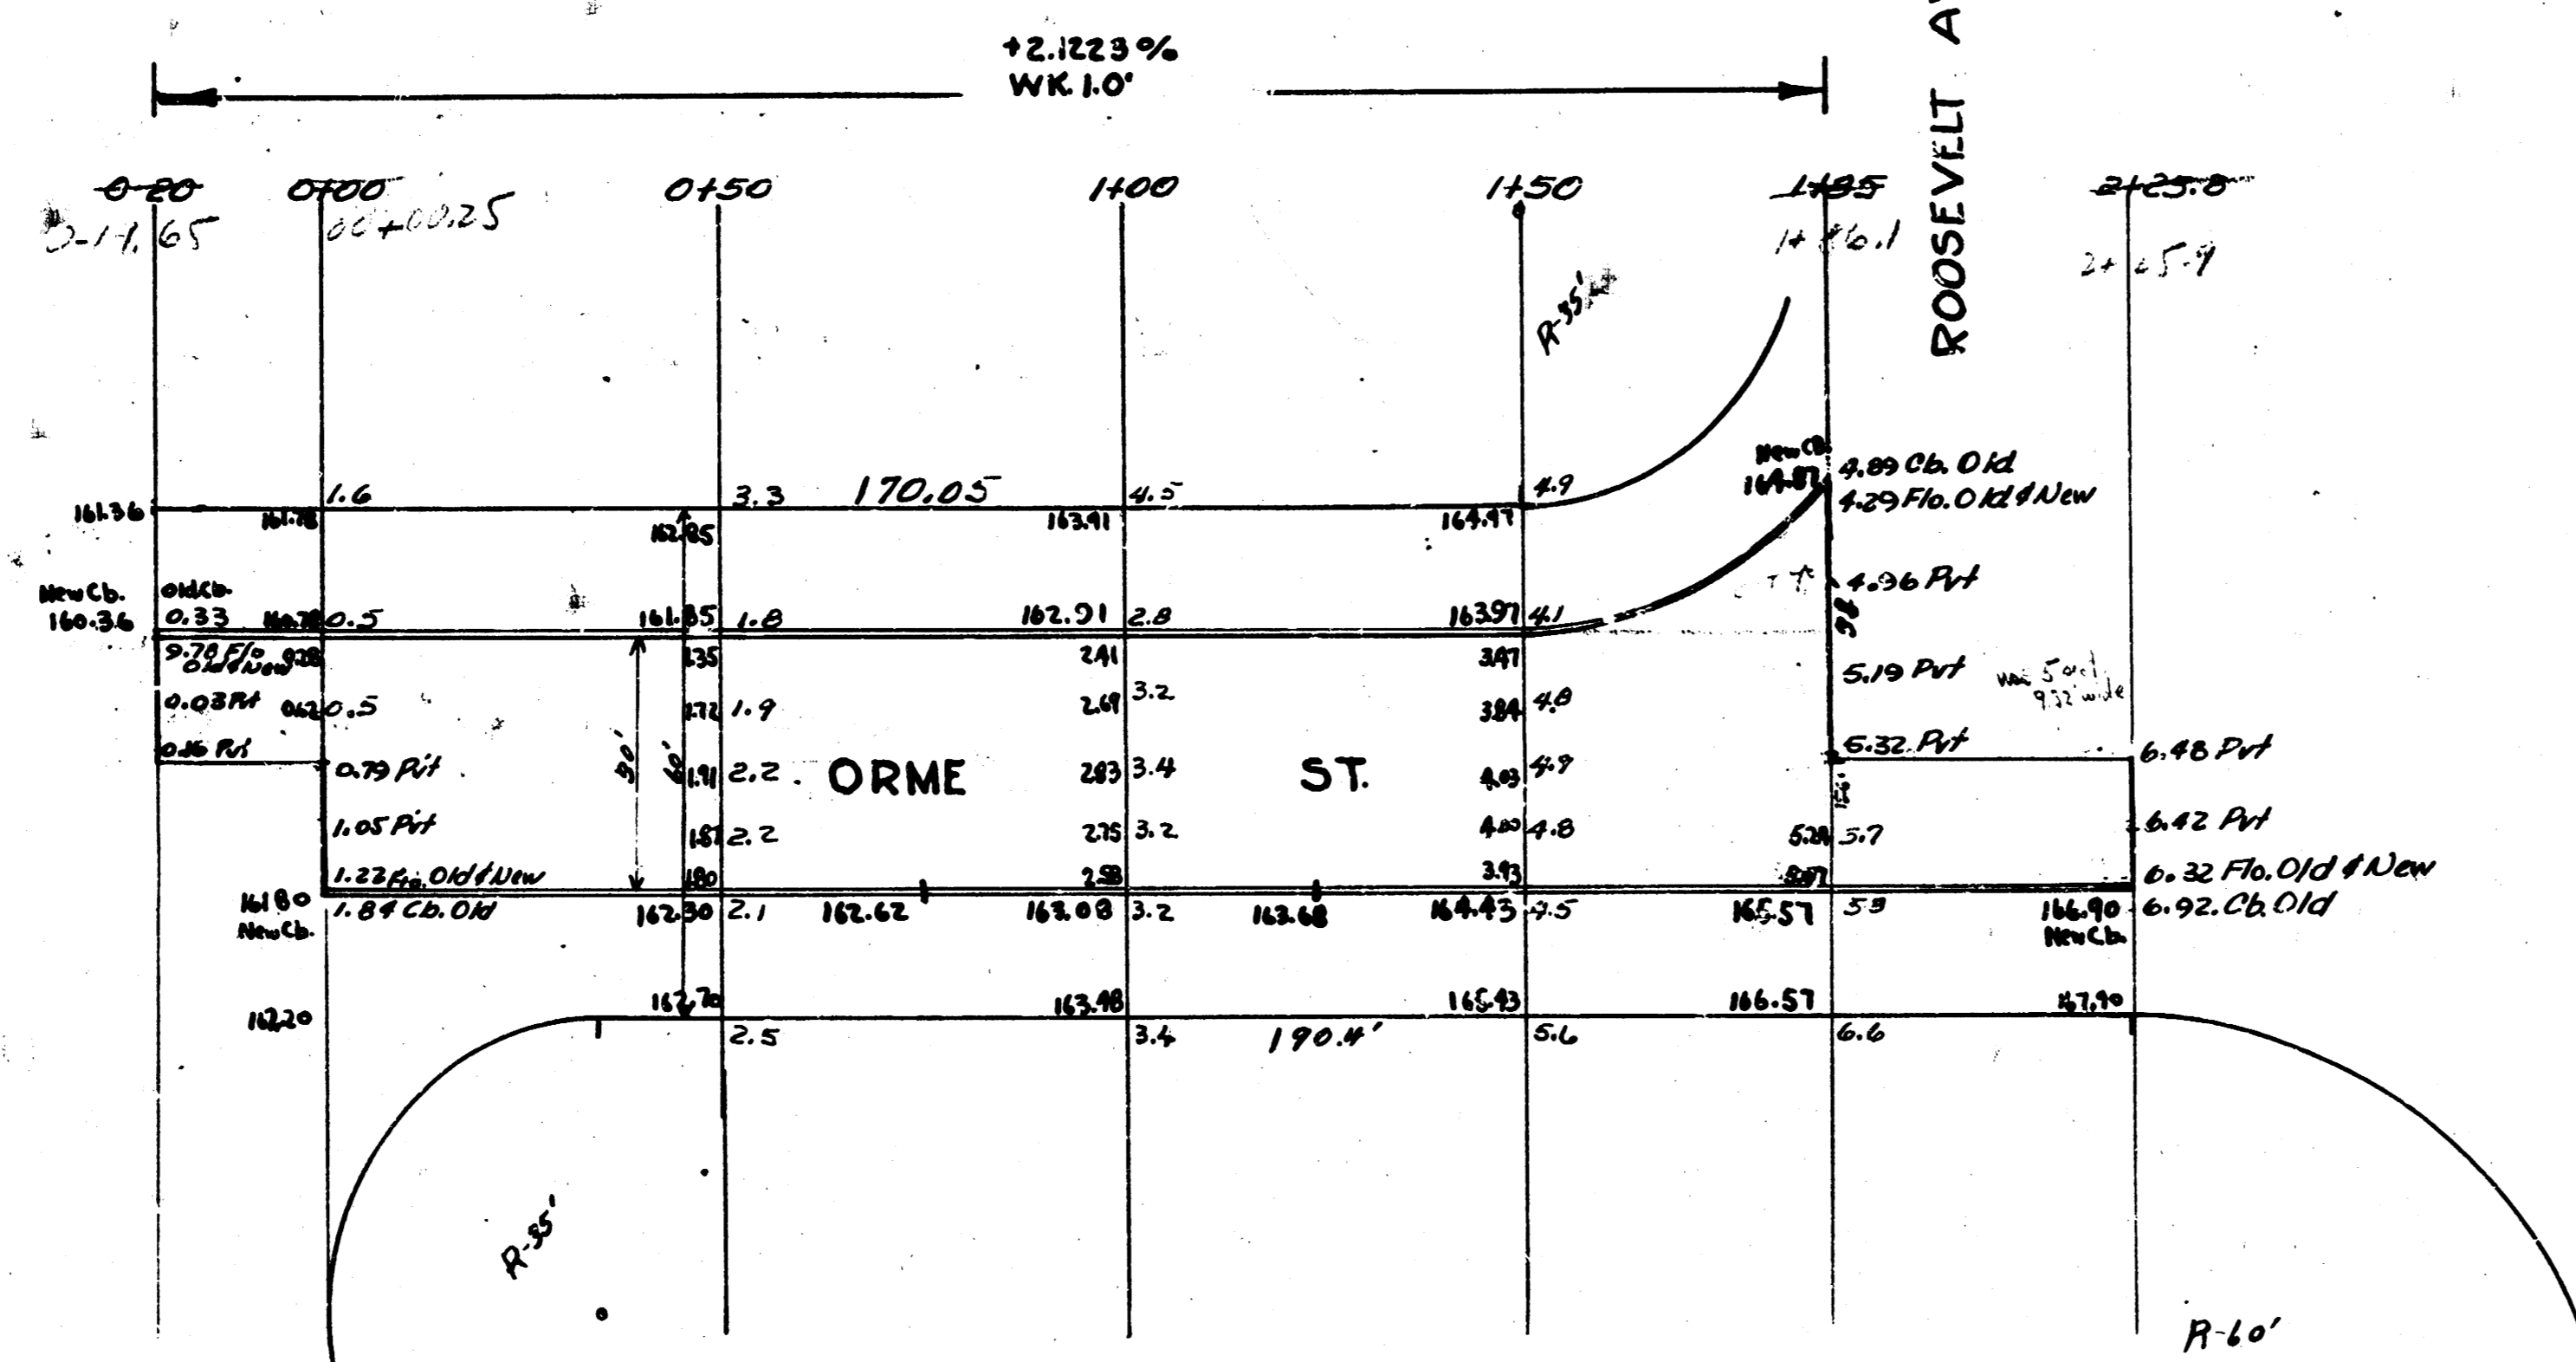

280
 59
 41.9
 61.1
 75.7
 50.2
 18.4

 233.2
 +.0%
 278.5 cu yds

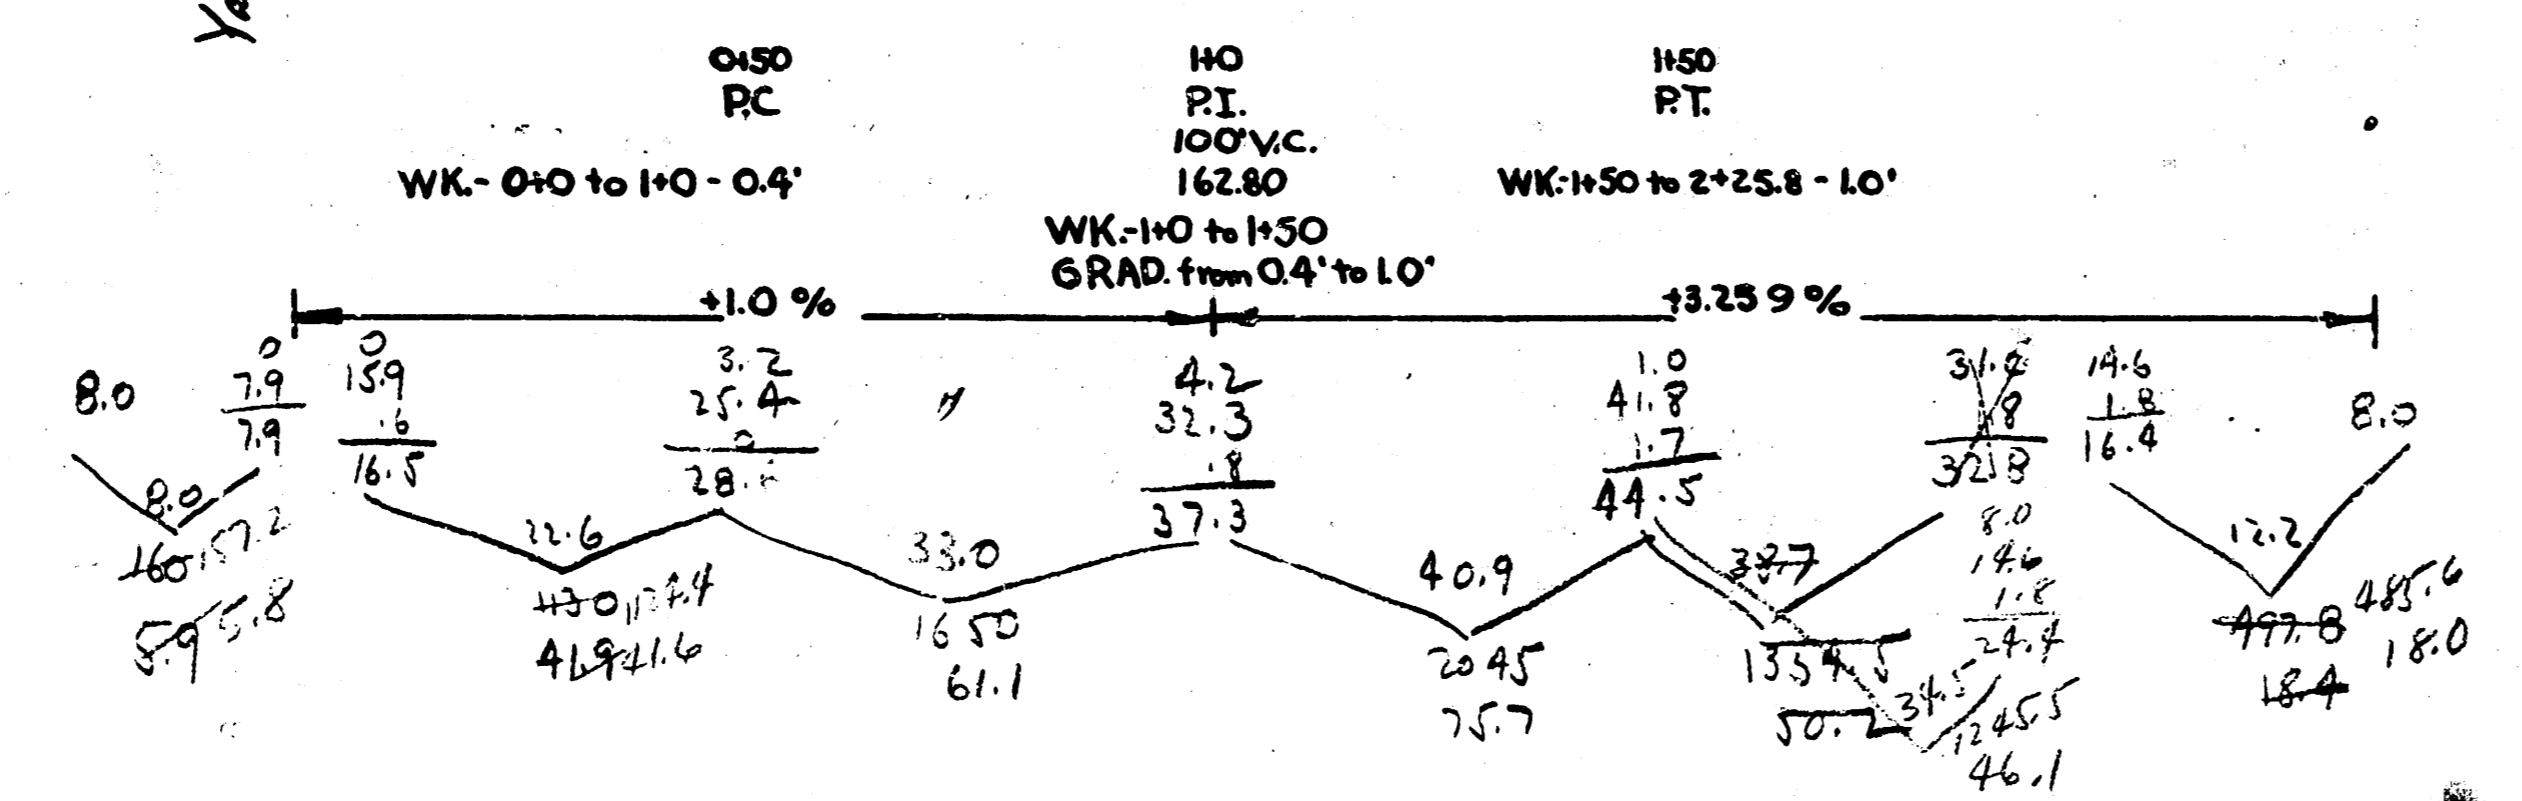

Orme ST.
 E.L. Yale WL Roosevelt
 30' W.C. "Cb."
 City of Wichita, Kansas
 L.K. White City Engineer
 December 1947 Project C17-85