


1941  
 ORME ST. - EL. QUENTIN TO W.L. BLUFF  
 30' CONC WITH INTEGRAL CURB

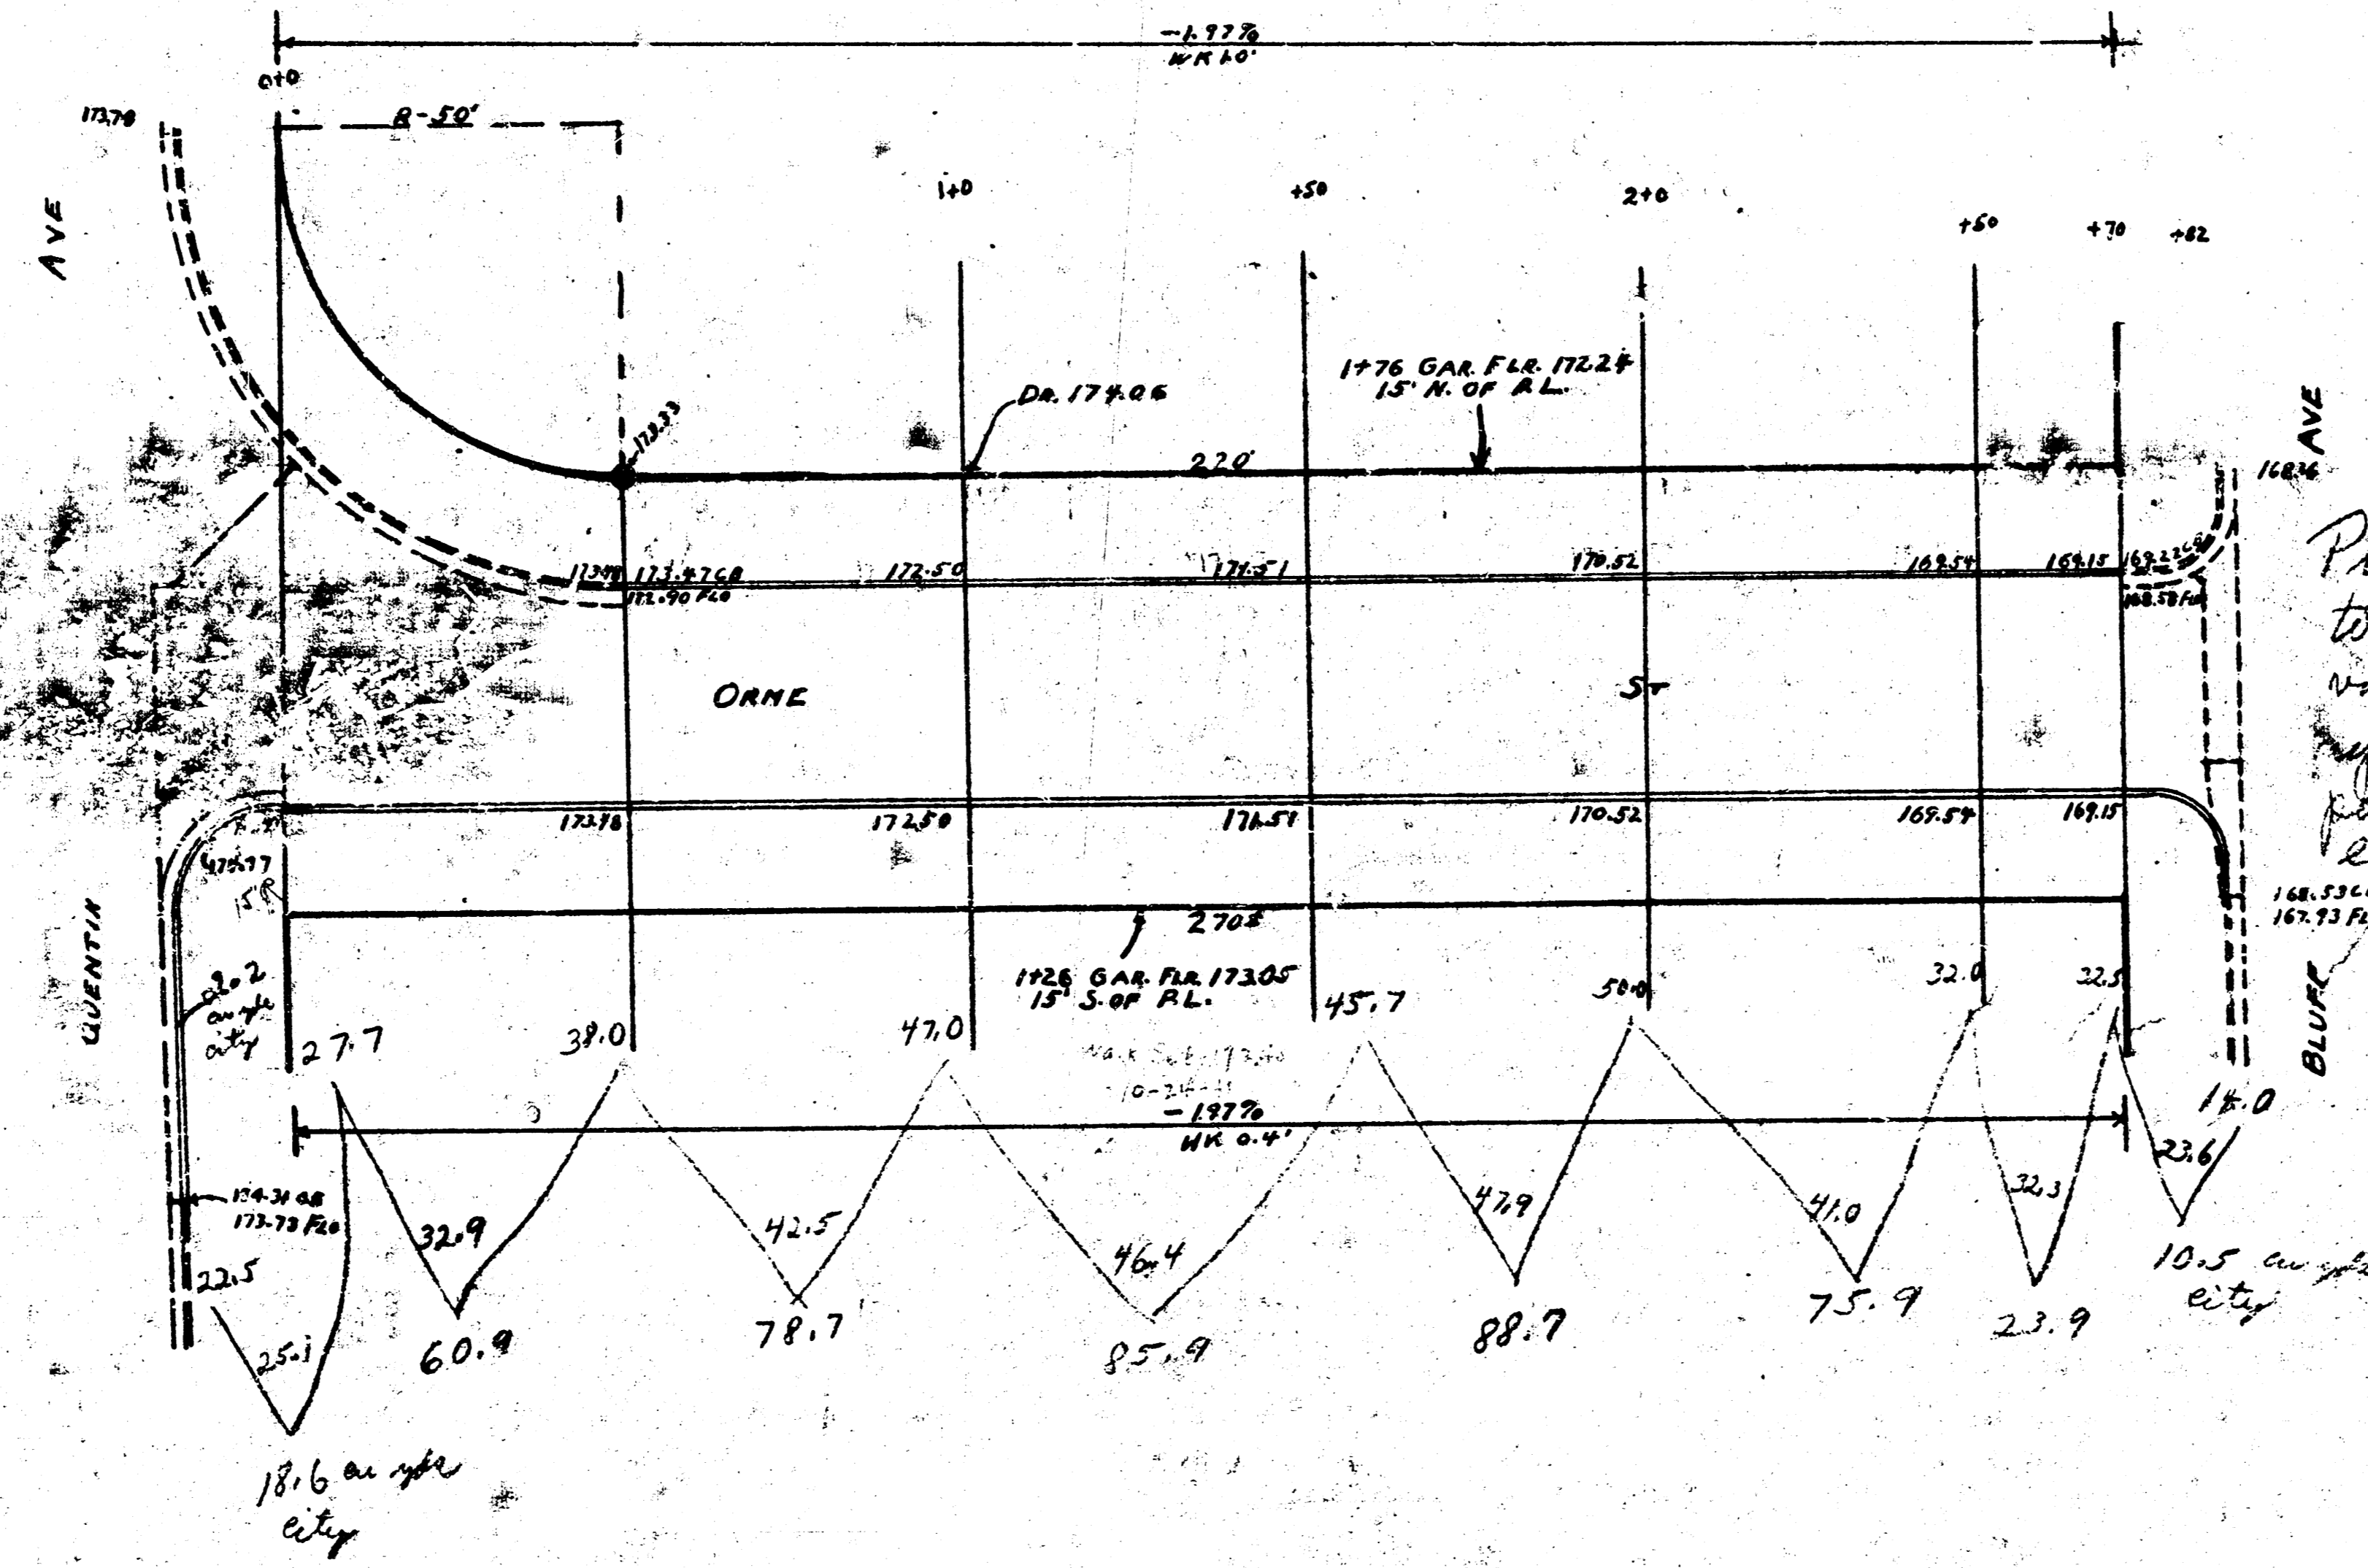

Probably advisable  
 to remove existing  
 valley gutter and  
 replace with 6"  
 pavement unless in  
 excellent condition  
 P.L.S.

PROP	CITY
60.9	3.2
78.7	18.6
85.9	15.5
88.7	31.3
75.9	
23.9	
<u>414.0</u>	

C.U. YDS + 1976 =  
 PROP 414.0 + 41.4 = 455.4  
 CITY 31.3 3.1 = 34.4  
489.8

Drawing Plan  
 1941  
 ORME ST.  
 EL. QUENTIN  
 W.L. BLUFF