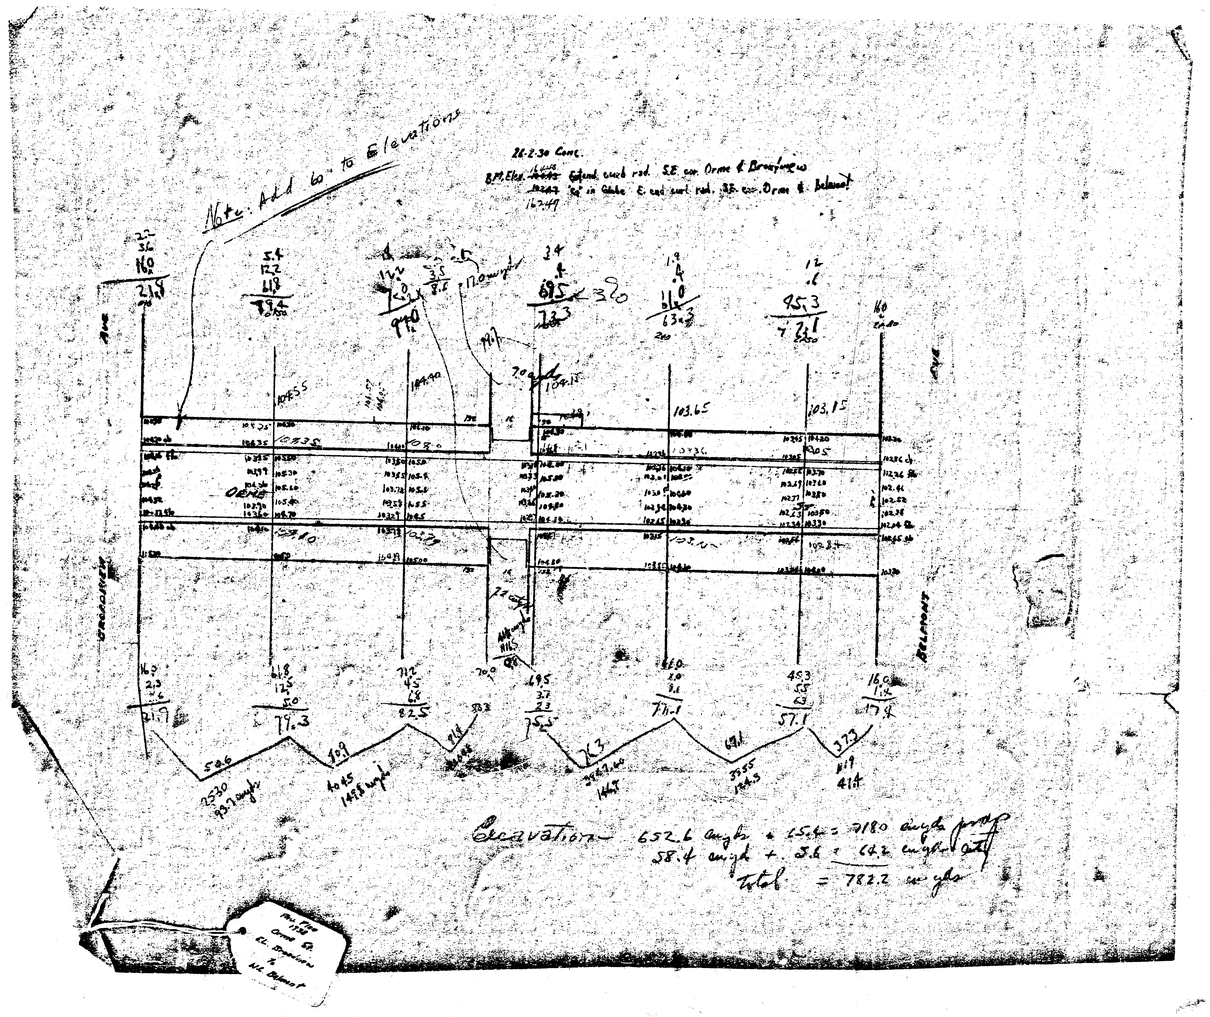
Note: Add 60' to Elevations
26-2-30 Cont.
B.M. Elev. 16447 Cut on rock rail SE cor Orme & Brentwood
16' in Cable E end curb rail SE cor. Orme & Belmont
ORME
BELMONT
Excavation — 652.6 cu yds + 65.4 = 718.0 cu yds fill
58.4 cu yds + 5.8 = 64.2 cu yds cut
Total = 782.2 cu yds