


B.M. 157.13 6" in Globe on Rod. N.W. Cor. Beverly Dr. & Orme
 B.M. 160.11 6" in Globe on E. End Rod. S.E. Cor. Marcilena Terrace & Orme

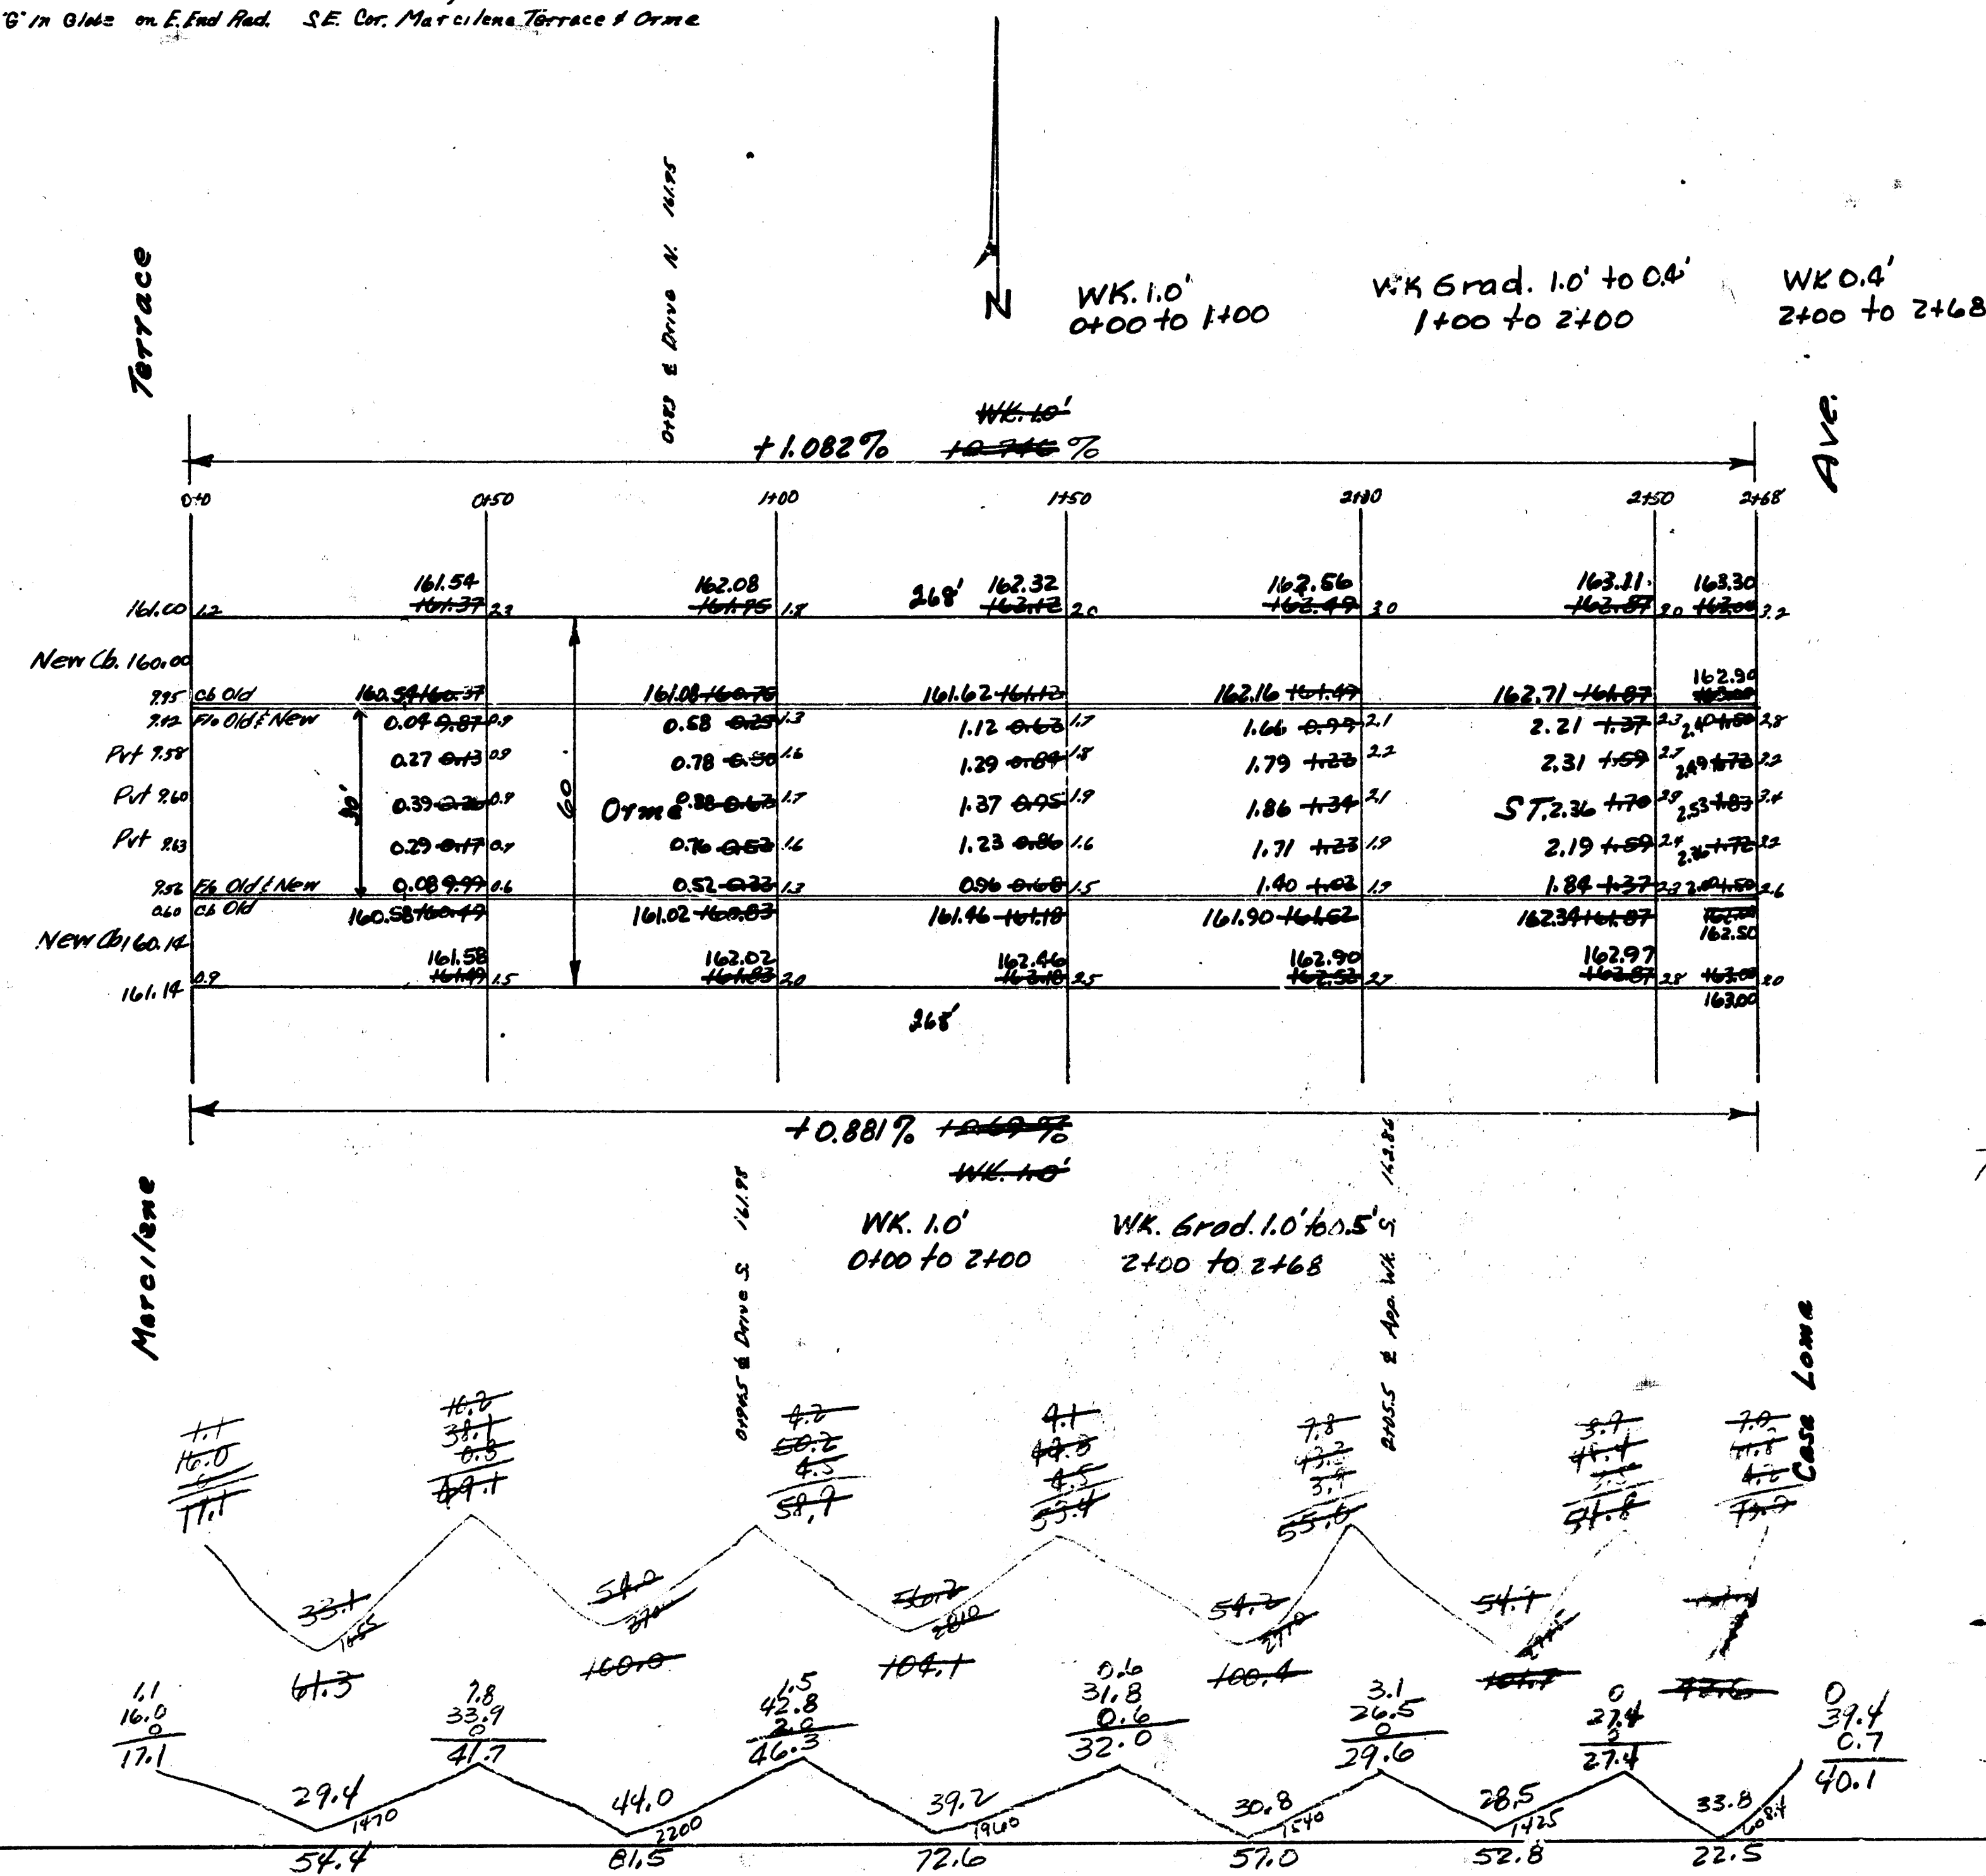

Prop

54.4
81.5
72.6
57.0
52.8
22.5
340.8
+10.1
total 374.9 cu. yds.

City

0

Prop.

51.8
120.0
15.4
16.4
16.7
42.6
510.1
+10.1
Total 561.1 cu. yds.

Orme St.
 E.L. Marcilena Terrace - W.L. Casa Loma
 30' Conc. Cb.
 City of Wichita, Kansas
 L.H. White City Engineer
 May 1948 Project C-18-72