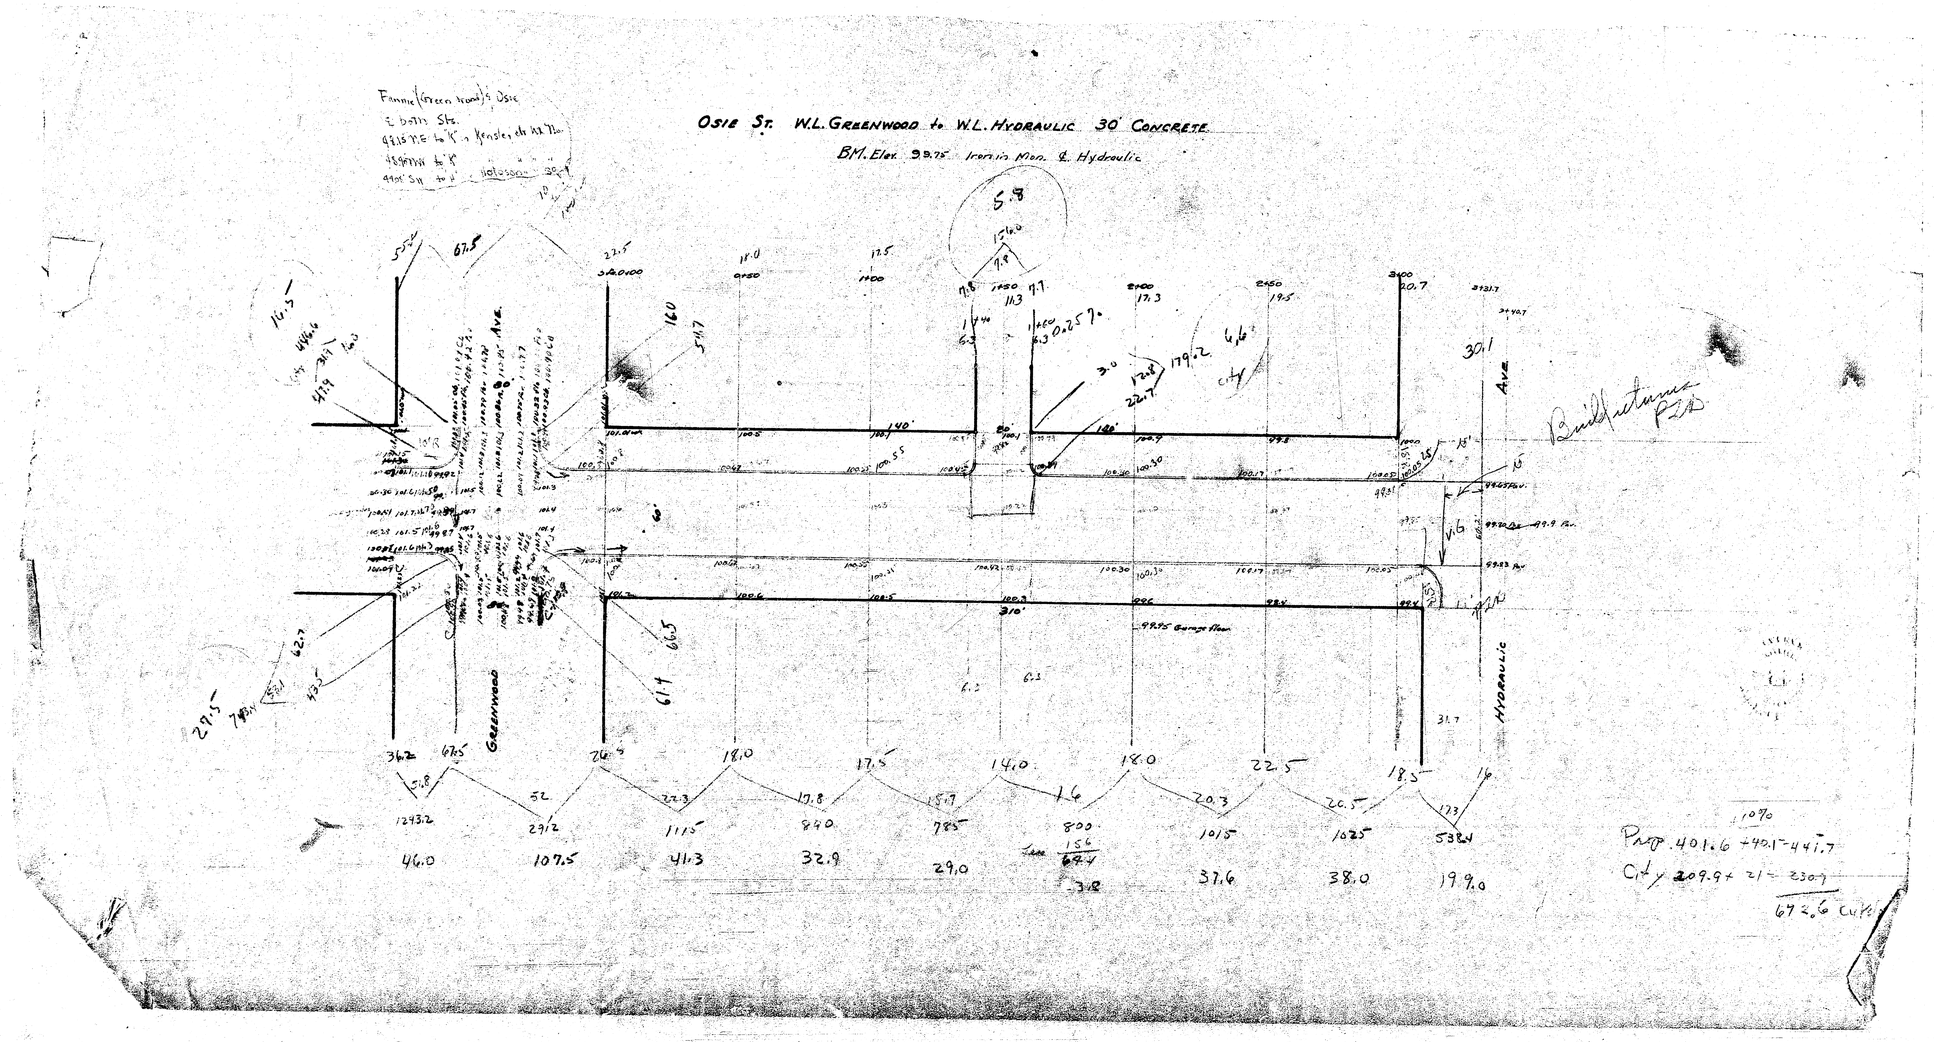
OSIE ST. W.L. GREENWOOD to W.L. HYDRAULIC 30' CONCRETE
BM. Elev. 99.75 Iron in Mon. @ Hydraulic
GREENWOOD
HYDRAULIC
AVE.
Prop. 401.6 + 40.1 = 441.7
City 209.9 + 21 = 230.9
672.6 cu yds