


BM. 140.24 NW COR. PORCH HOUSE  
 No. 1724 S. CLIFTON  
 CHAINING E ON 9' OFF SET FROM S  
 PROP. LINE

- +00 WL CHERRY HILLS ADD. IRON S.S.
- +13 B 8" CONC. DR. 9 FT. 10" 6" PIPE 7 RT.
- +15 B 8" CONC. DR. 51 FT. 10" 6" PIPE 36 LT.
- +31 WATER METER 42 LT.
- +44 WATER METER 60 RT.
- +54 3" TREE 4' 9" LT.
- +55 GRAPE ARBOR 5' 4" RT.
- +07 BEE 4' WIRE FC. E 15' 6" RT.
- +20 2" TREE 8' 4" RT.
- +49 4" TREE 8' RT.
- +52 END 4' WIRE FC. E 15' 6" RT.
- +07 BEE EXISTING PVT.
- +08.7 WL CLIFTON IRON S.S.

Shirley K. ...  
 Checked

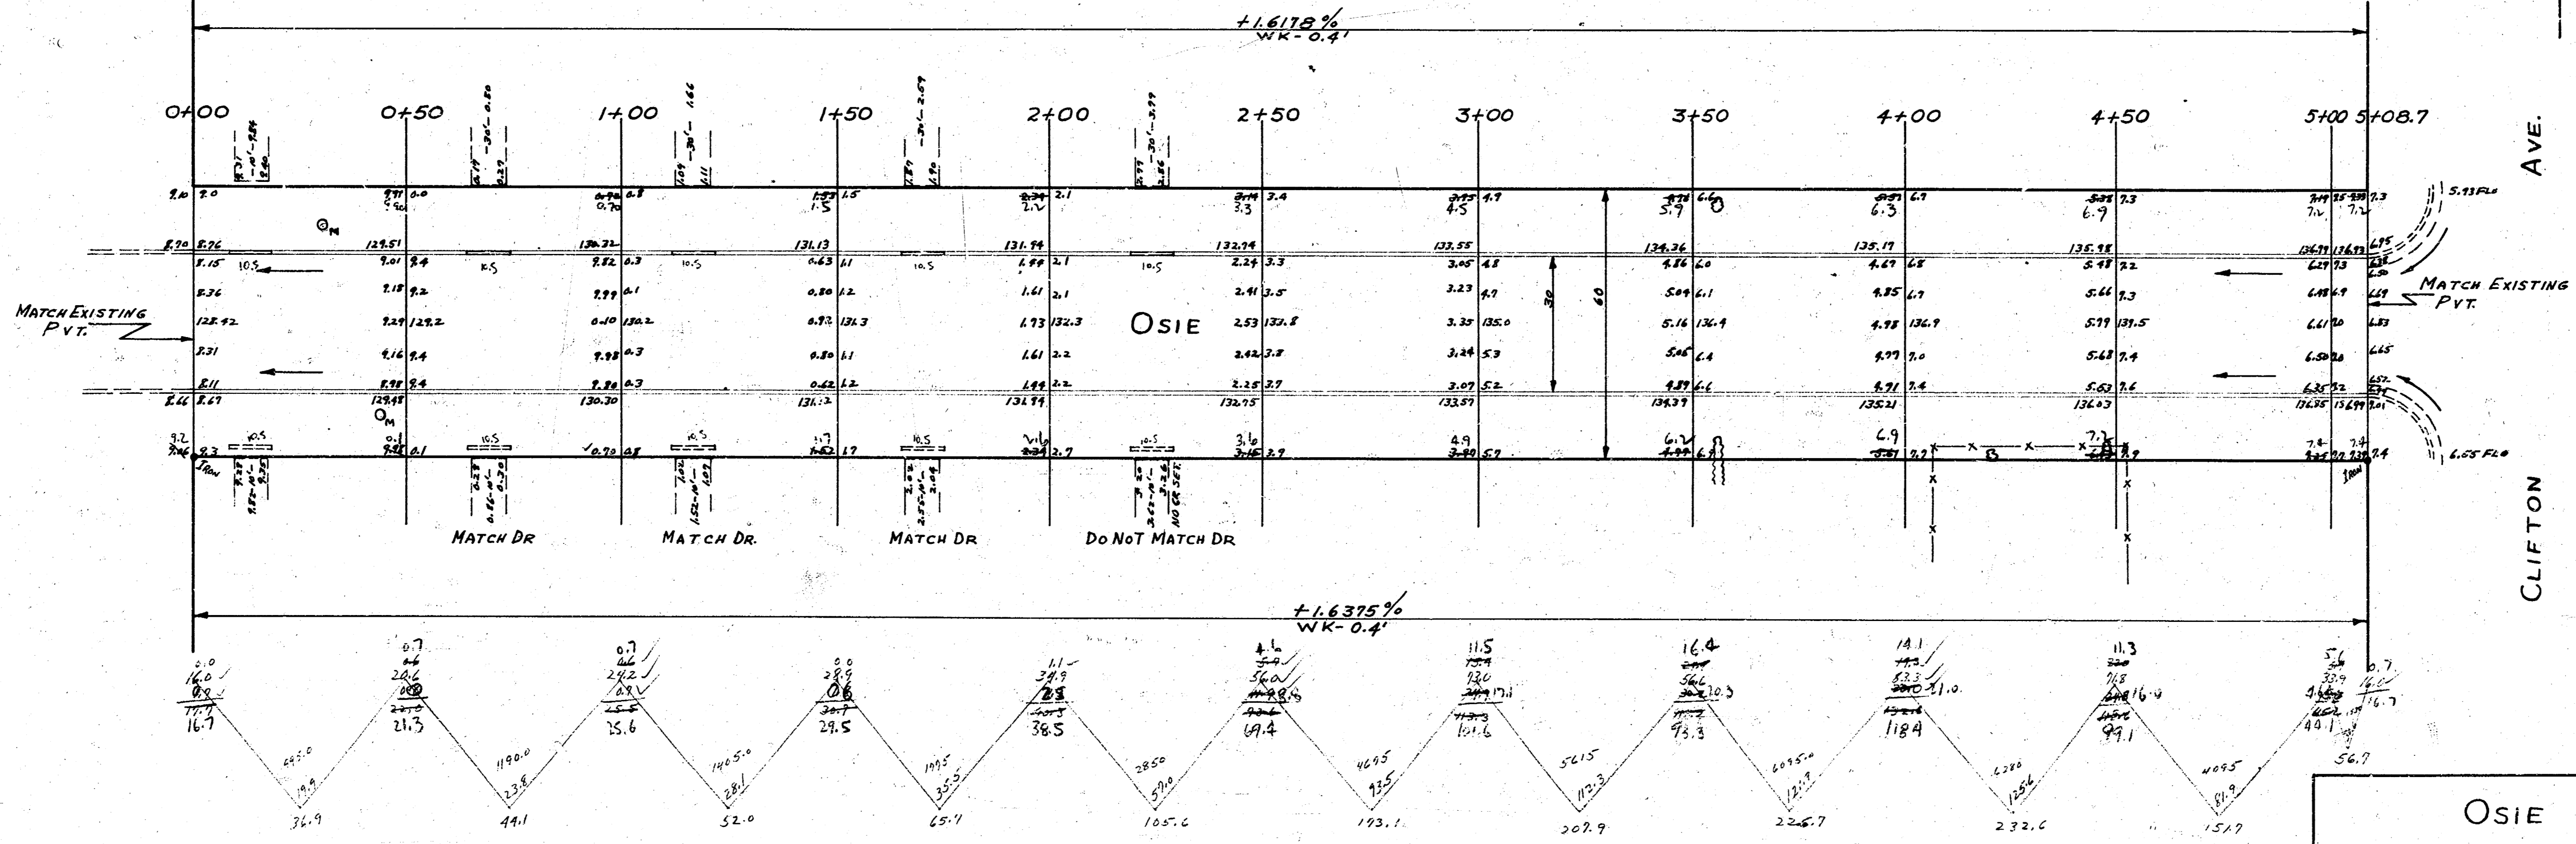

NOTE TO CONTRACTOR & FIELD ENG.  
 ENTRANCE PIPE WILL BE DISPOSED OF IN  
 ACCORDANCE WITH INSTRUCTION OF DIRT CHECKER

PROJECT 1  
 1352.0  
 110% 115.2  
 1887.2 QU. YDS CUT



OSIE  
 WL. CLIFTON TO WL. CHERRY HILLS ADD.  
 30' CONC. FCB.  
 CITY OF WICHITA KANSAS  
 B.E. SMITH CITY ENGINEER  
 MARCH 1954 PROJ. NO. C13-245