



BM 13628 60" SPIKE N55°P110°E of MINDOR S.S. CORNER
 BM 13625 "M" IN MUELLER F.H.D. N.E. COR. OSIE & FABRIQUE
 BM 13392 EXTREME S.W. COR. HURGUARD TRIPLE R.C.B.C. 30" S of DREHLMOER on HARRY

Prop. CITY
 13878 1621
 +10% 1523
 TOTAL 7326.5

STA ON SE

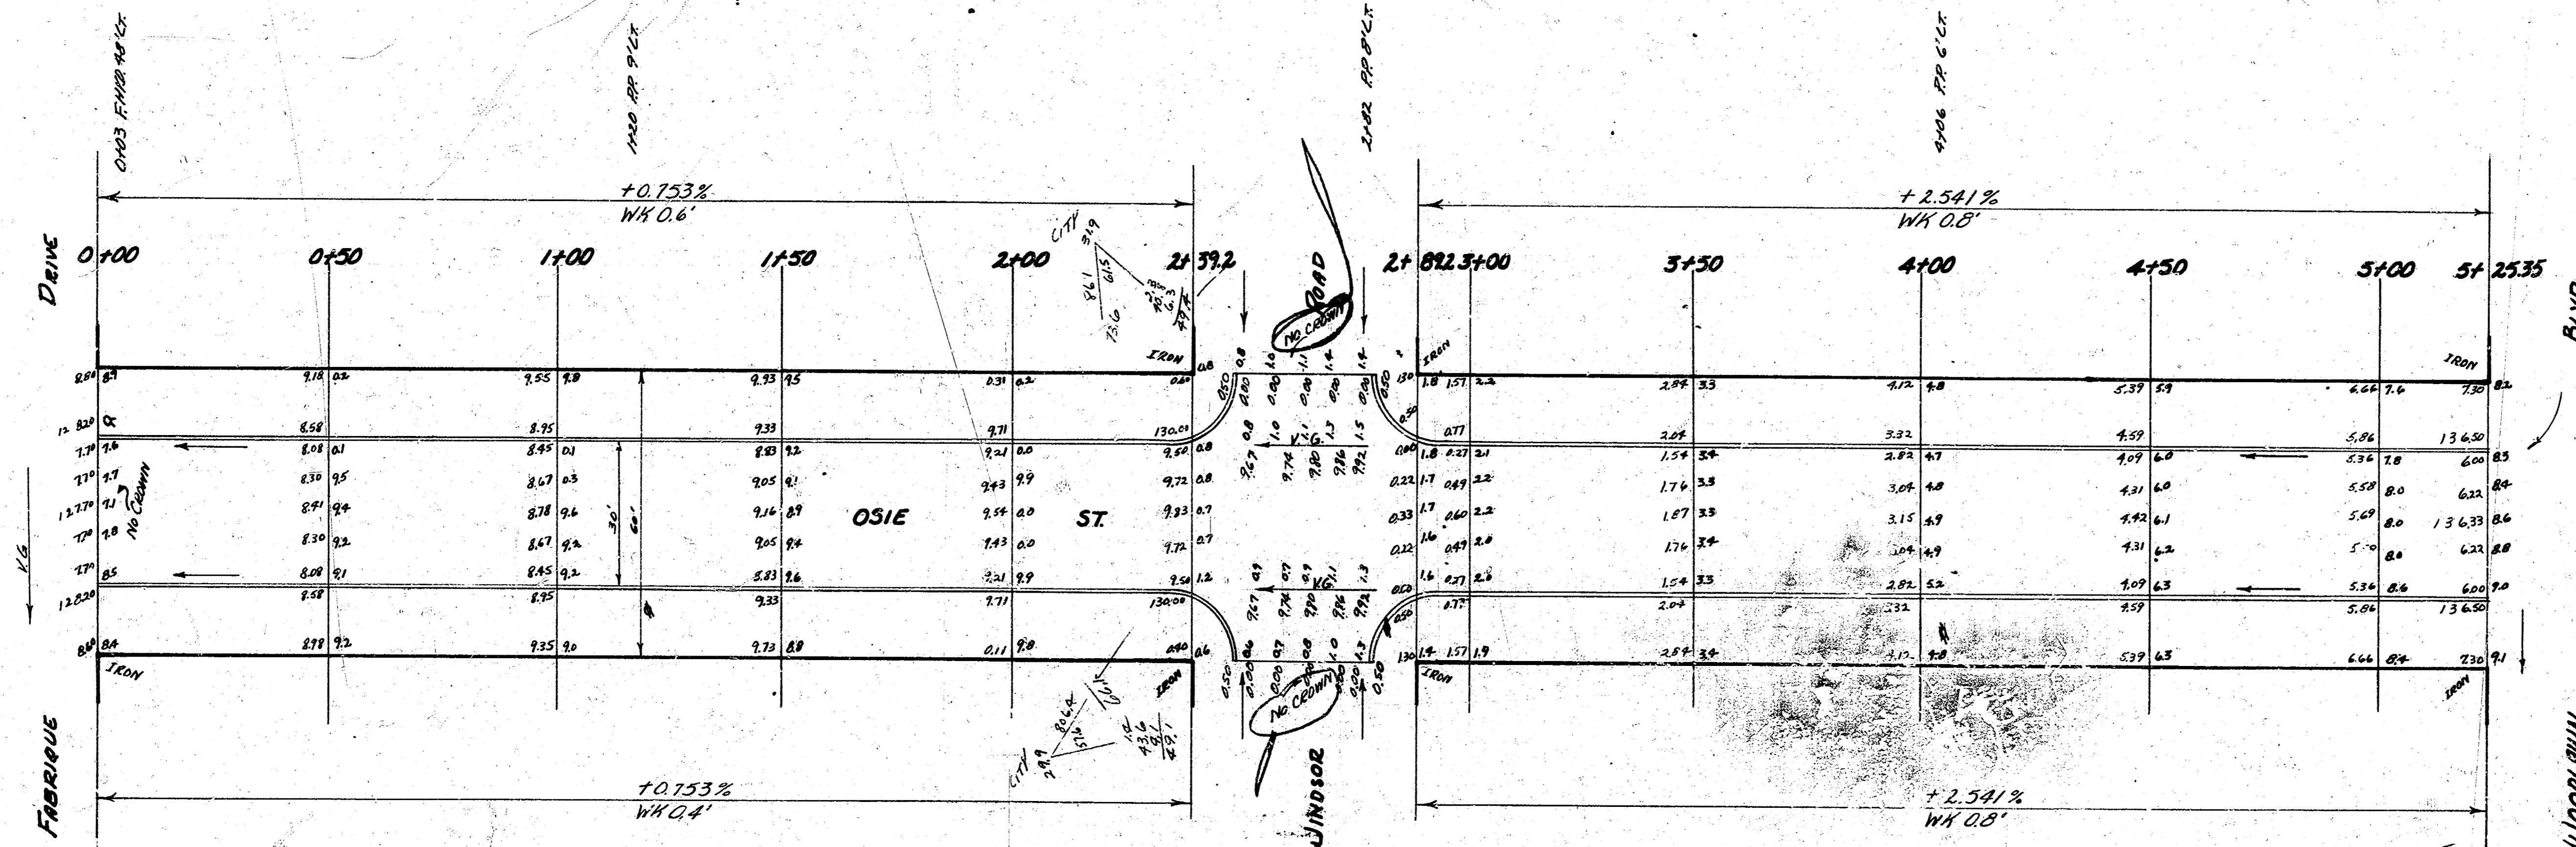

Plans
 Checked
 Exc. (S)
 BR 42-3

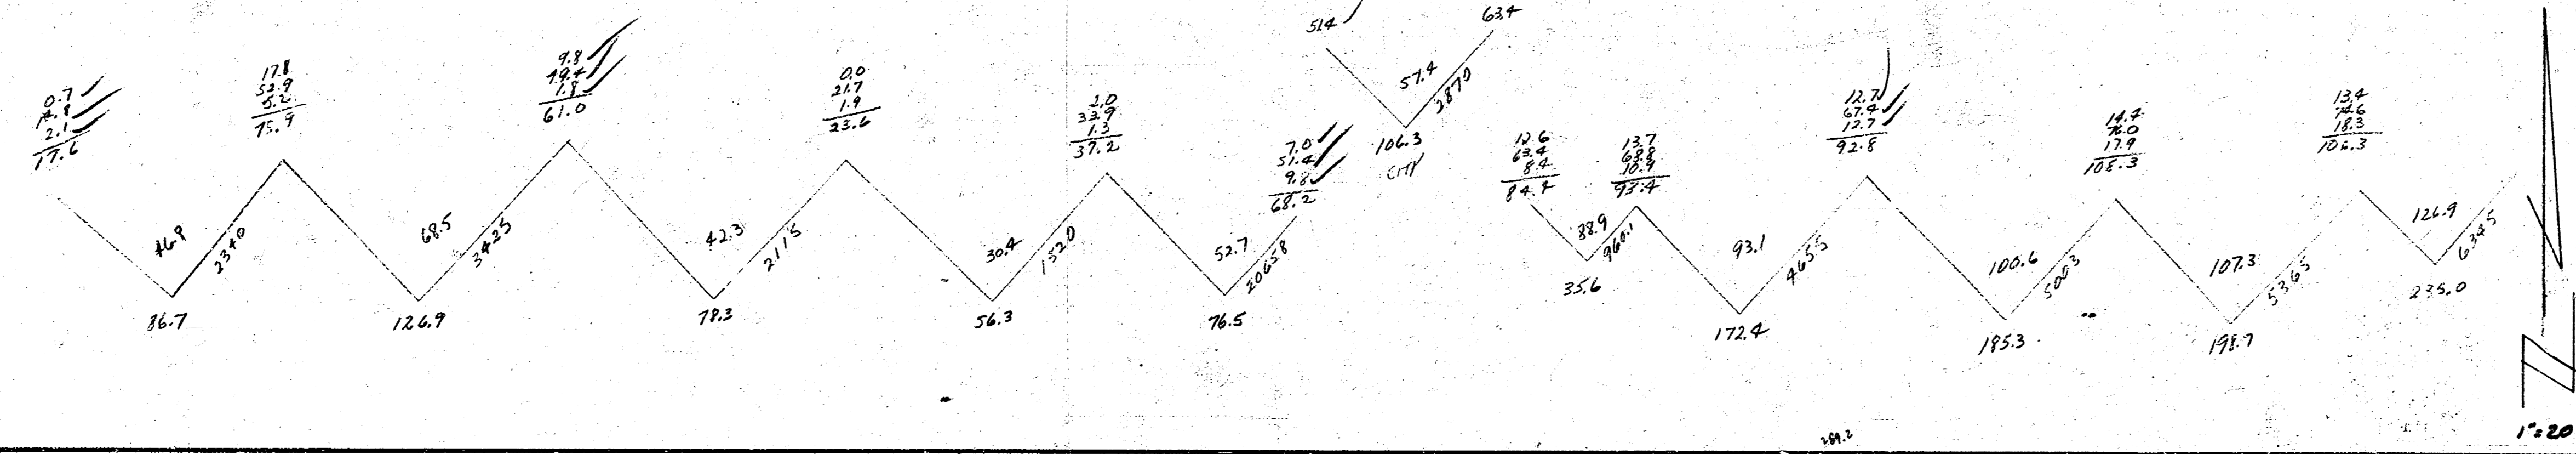

OSIE ST.
 EL FABRIQUE TO W.L. WOODLAWN
 30' CONC + CB.
 CITY OF WICHITA, KANSAS
 B.E. SMITH CITY ENGINEER
 JAN. 21, 1953 Proj. No. C12-308

1 2 1 2