






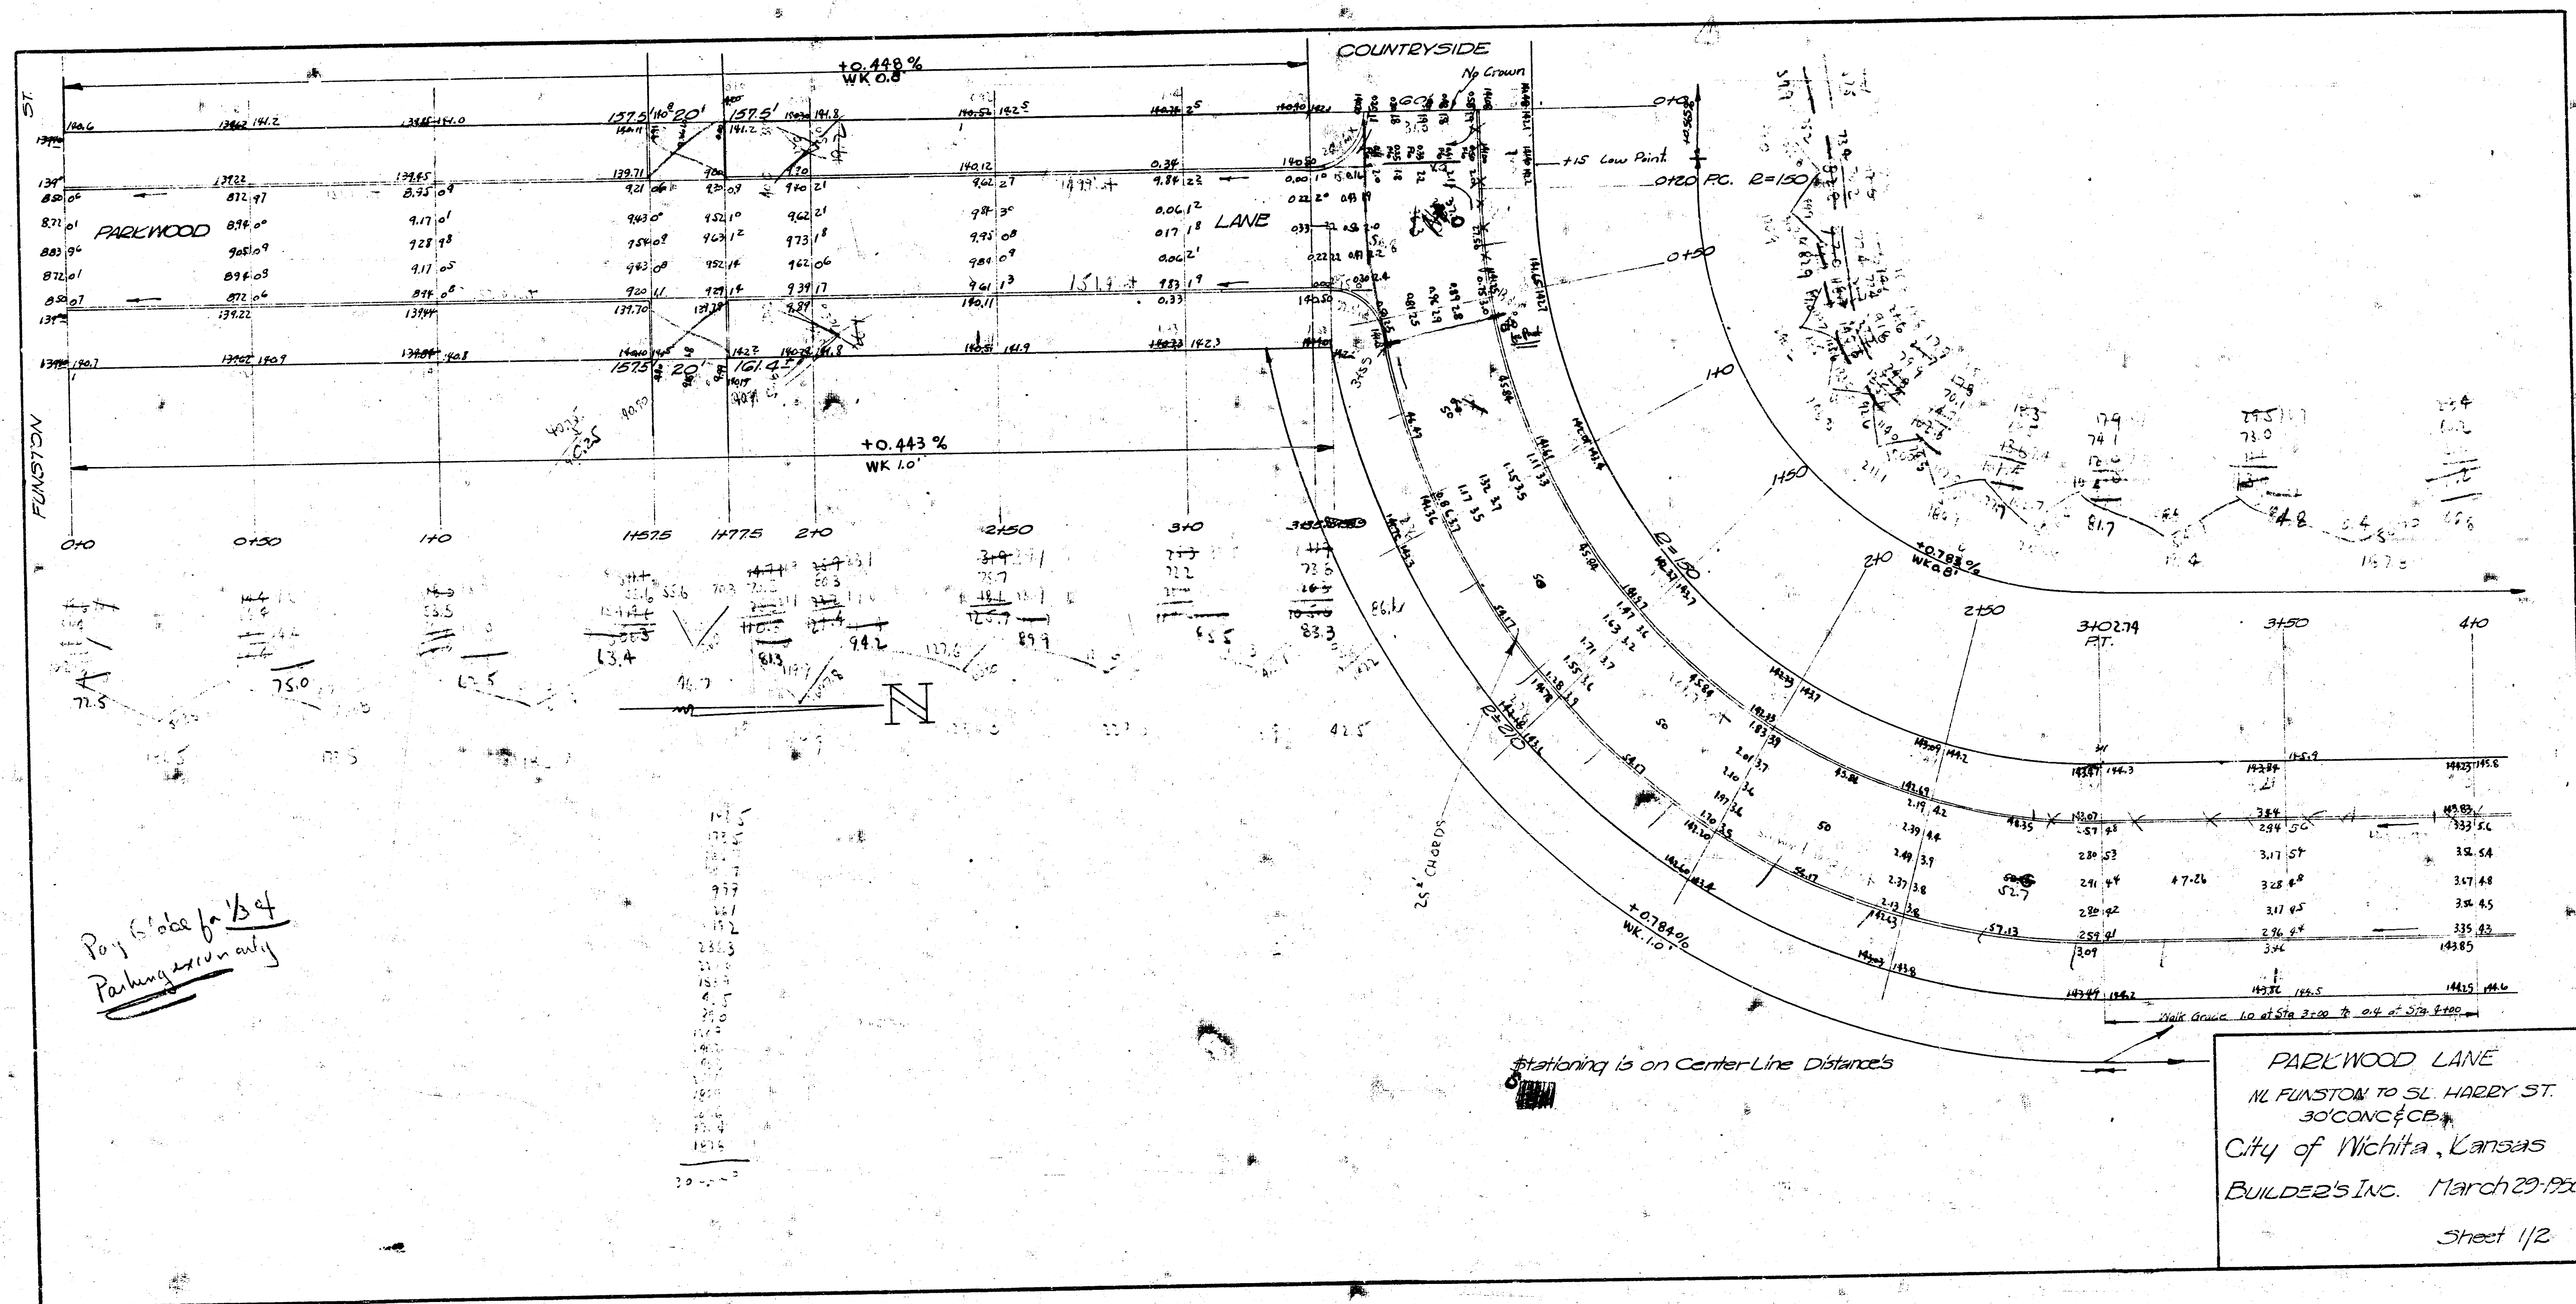

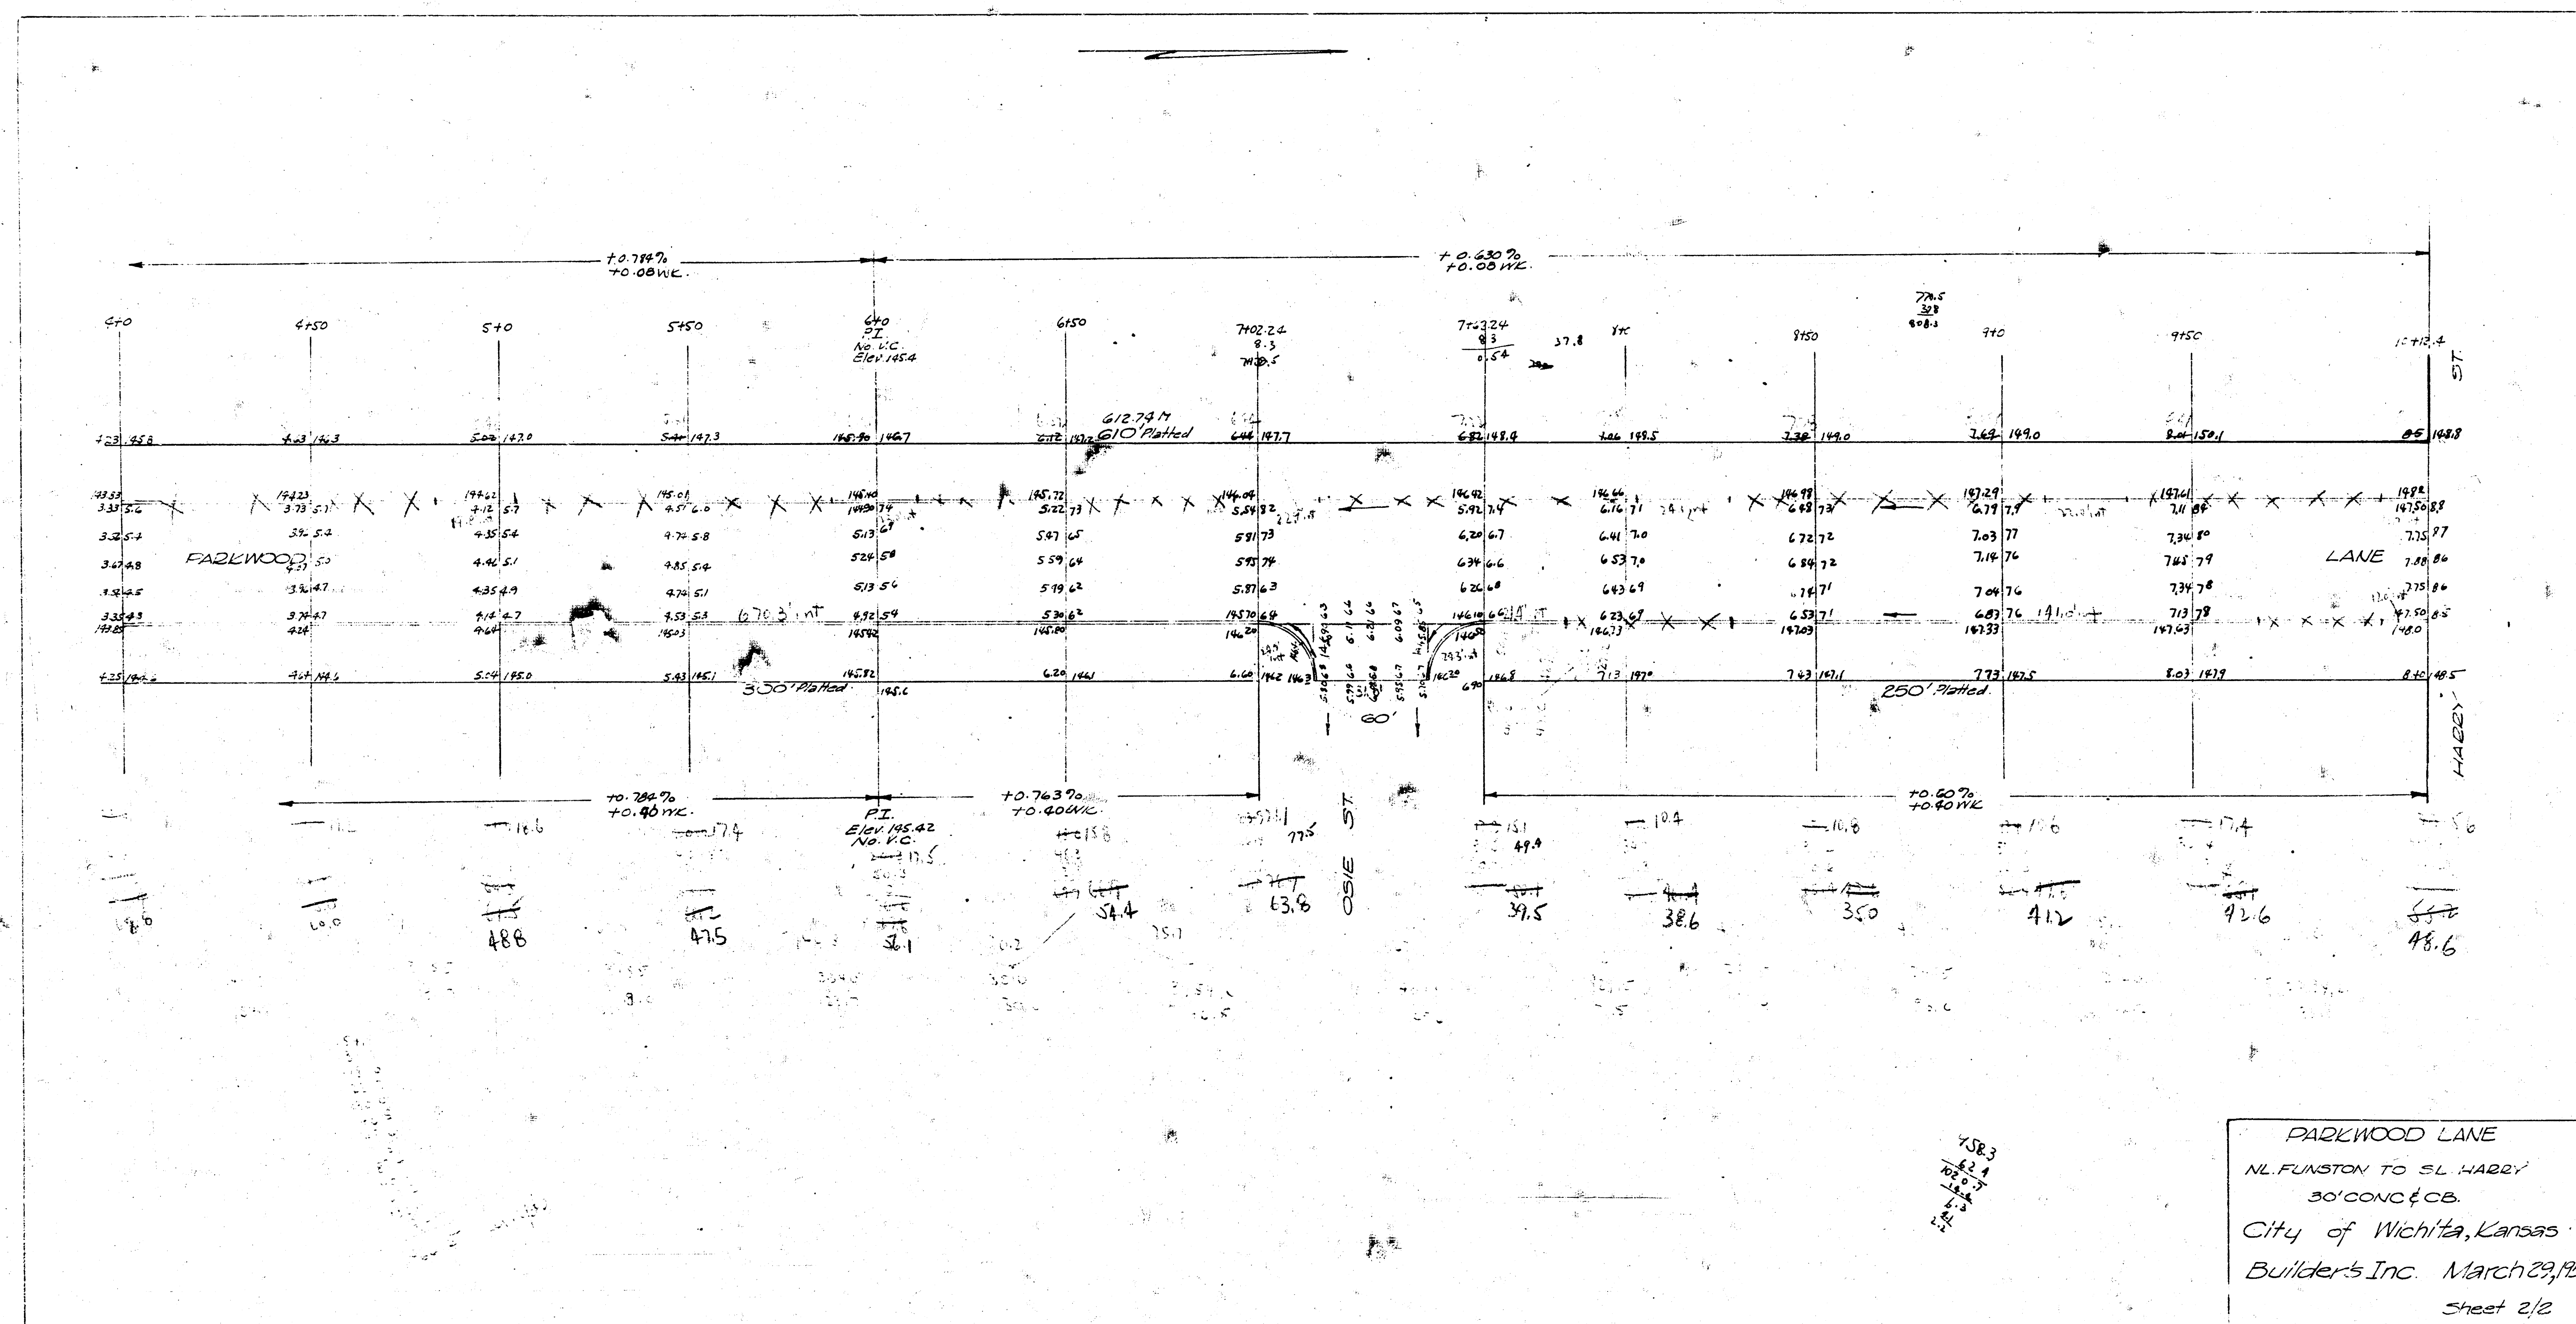

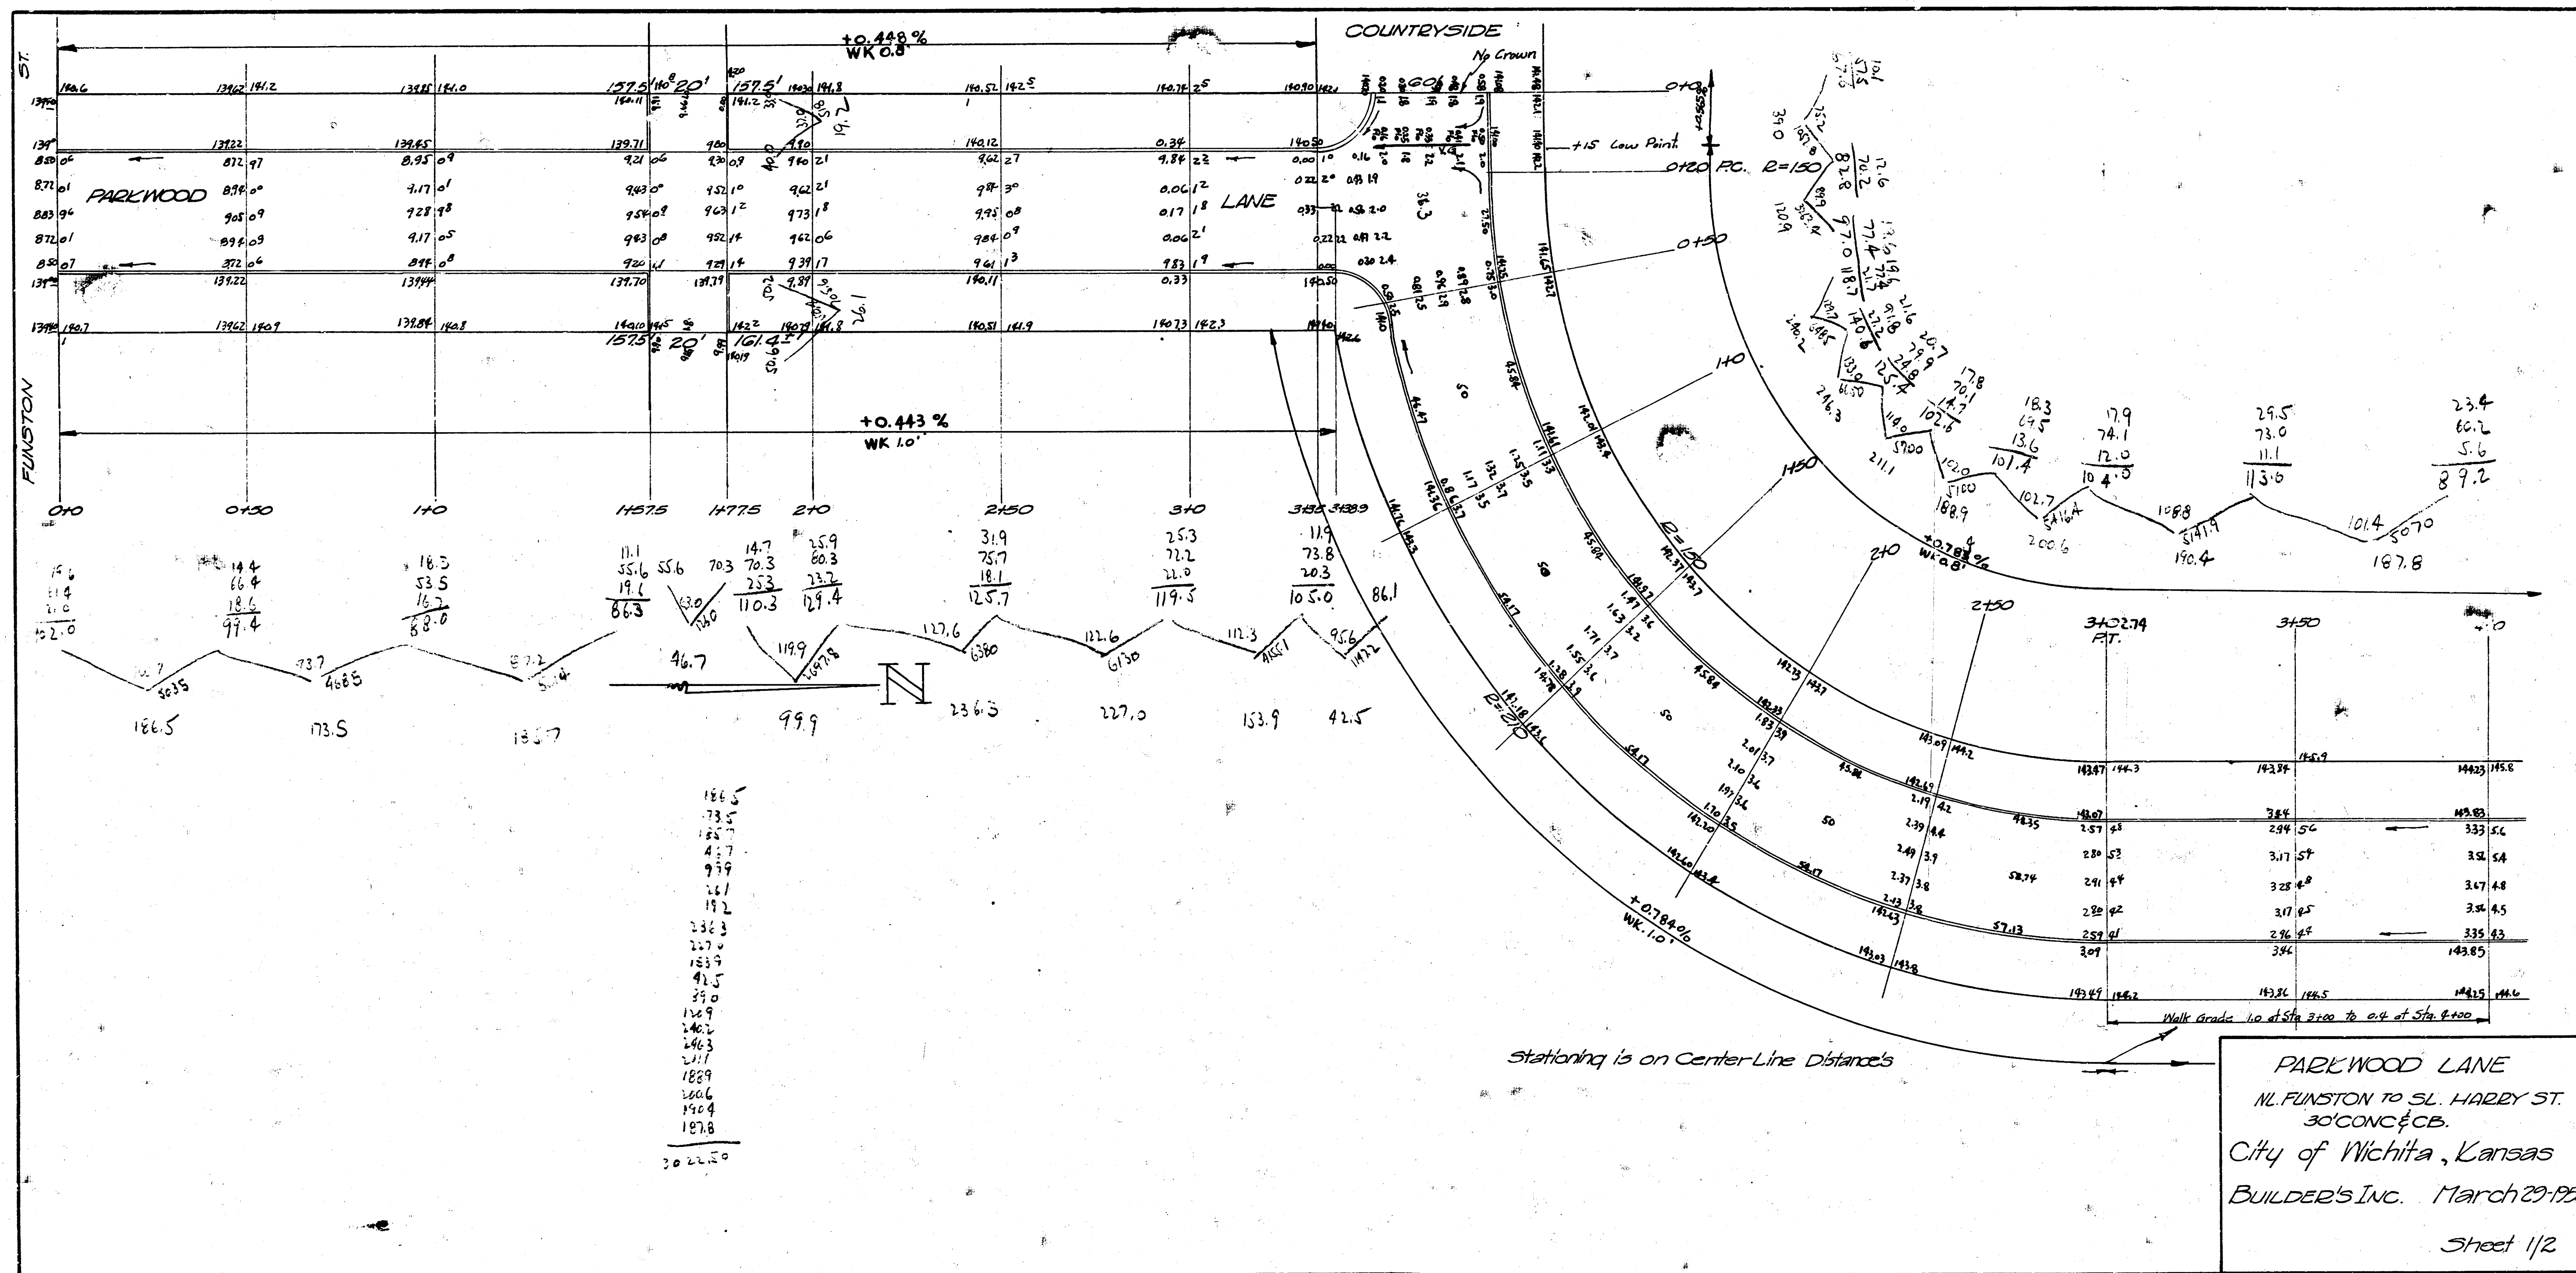



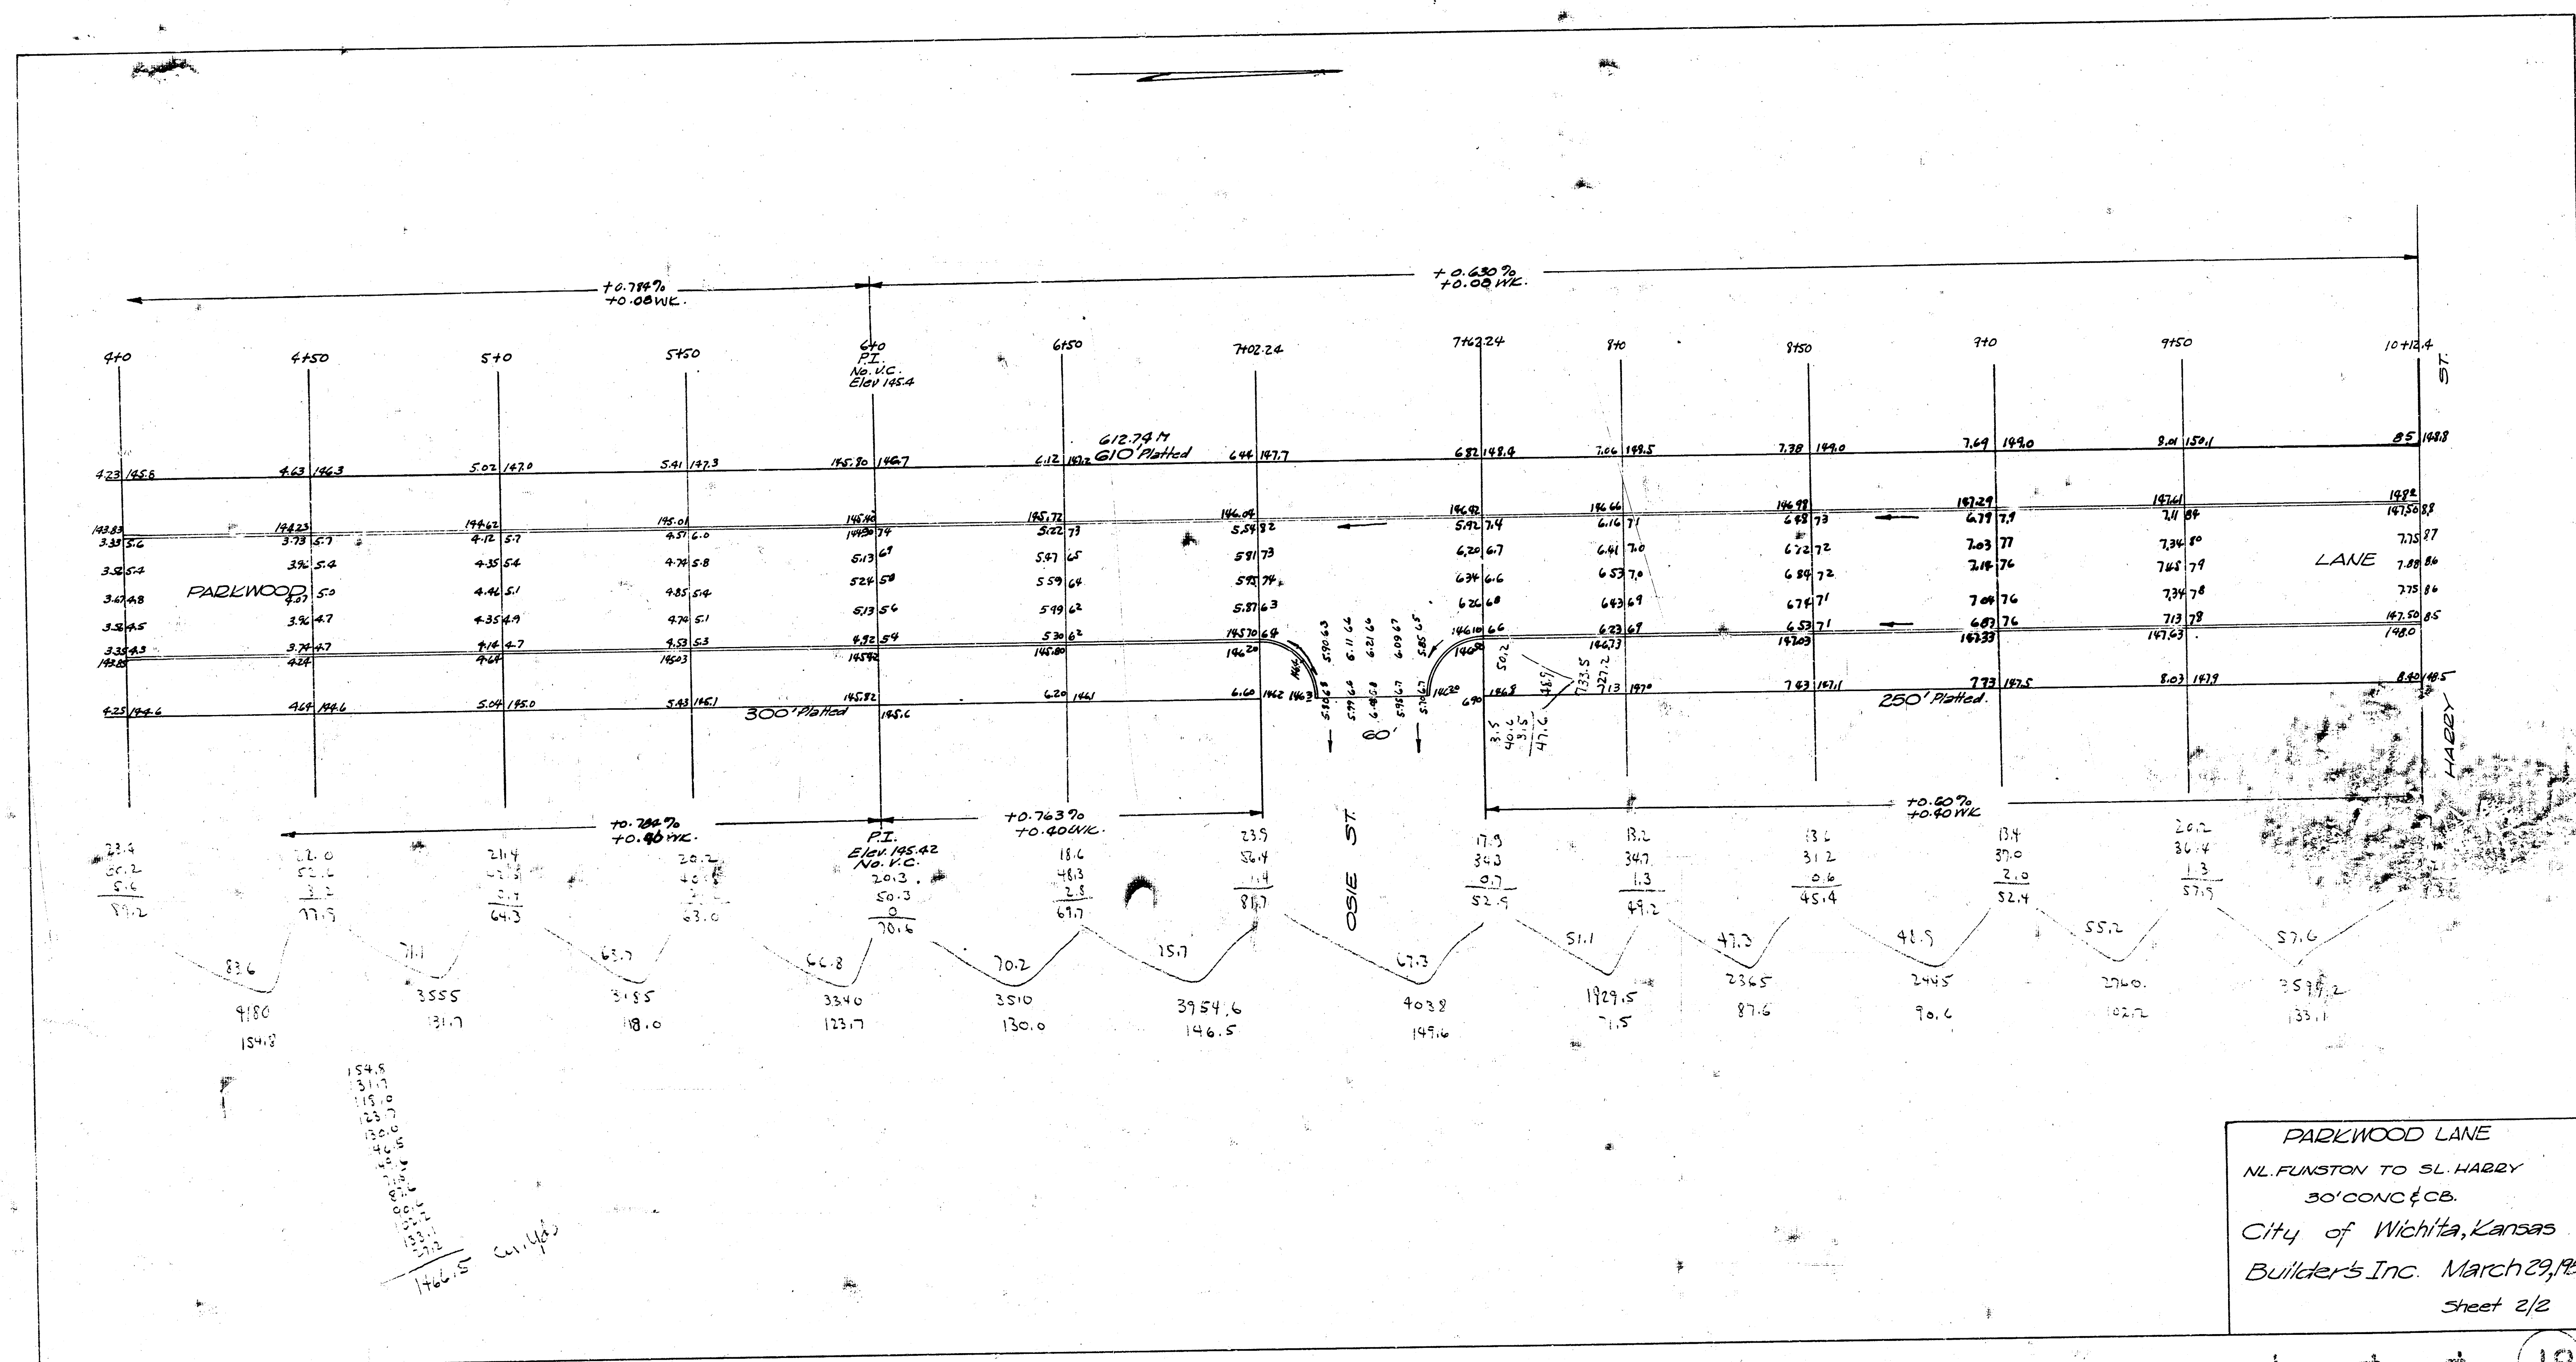


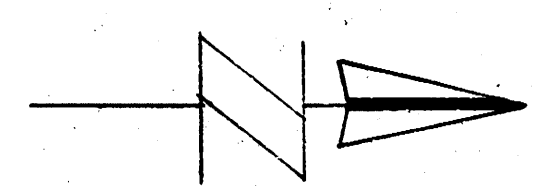

744.5
+ 1070
1034.5

SCALE 1"=20'

CHAINING N. ON E. R.
BM 150.61 5" IN BUILDING F. W. NE CORNER MT. VERNON & OLD MANOR
BM 151.51 1" IN MUELLER FIRE HYD. NW CORNER PARKWOOD & MT. VERNON

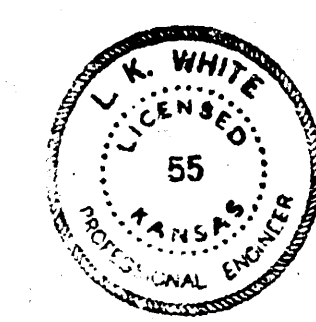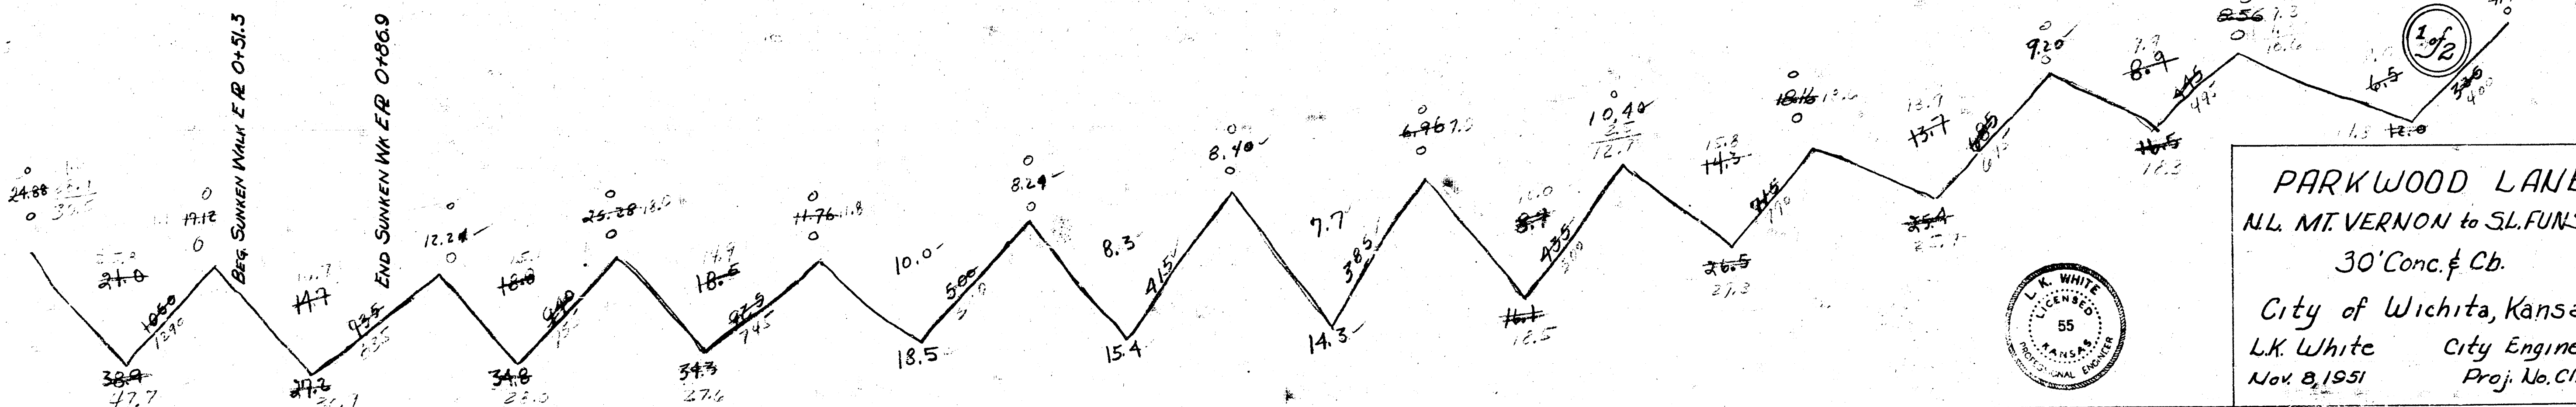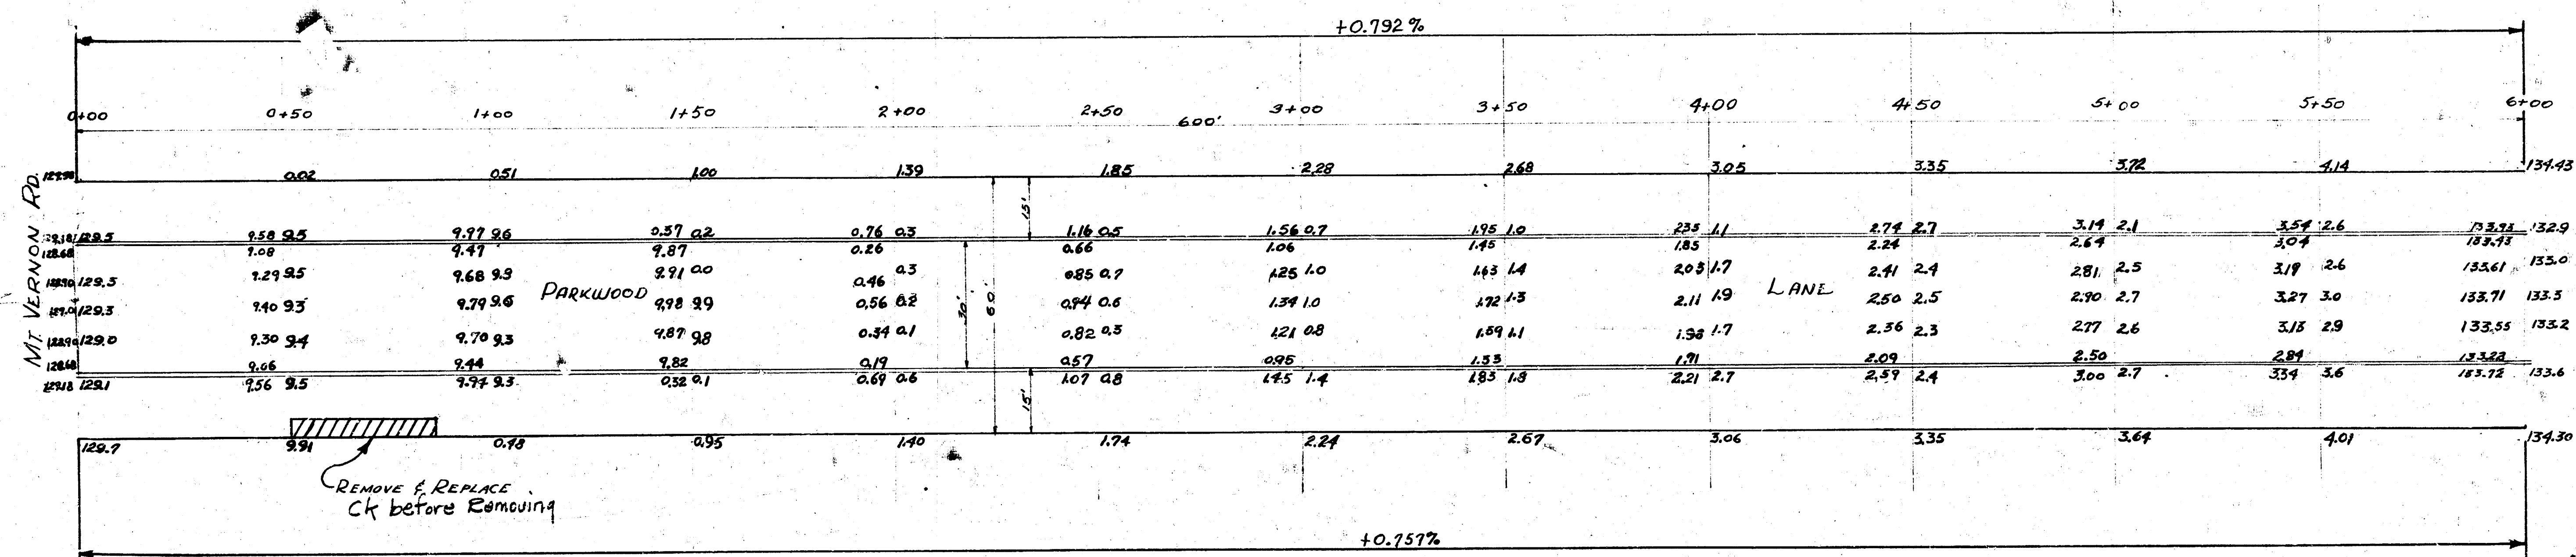

PARKWOOD LANE
30' Conc. & Cb.
City of Wichita, Kansas
L.K. White City Engineer
Nov. 8, 1951 Proj. No. C11-118

