Note - Parking only trimmed back 5'
on account of trees.

26-2-20 C&G only

BM. 185.87 N curb NBL Old Stanford Rd.
185.33 S. curb NBL " " "
189.65 "G" in Globe N end ch. rcf. Nw. Cor. 2nd & Parkwood

PARKWOOD

LANE
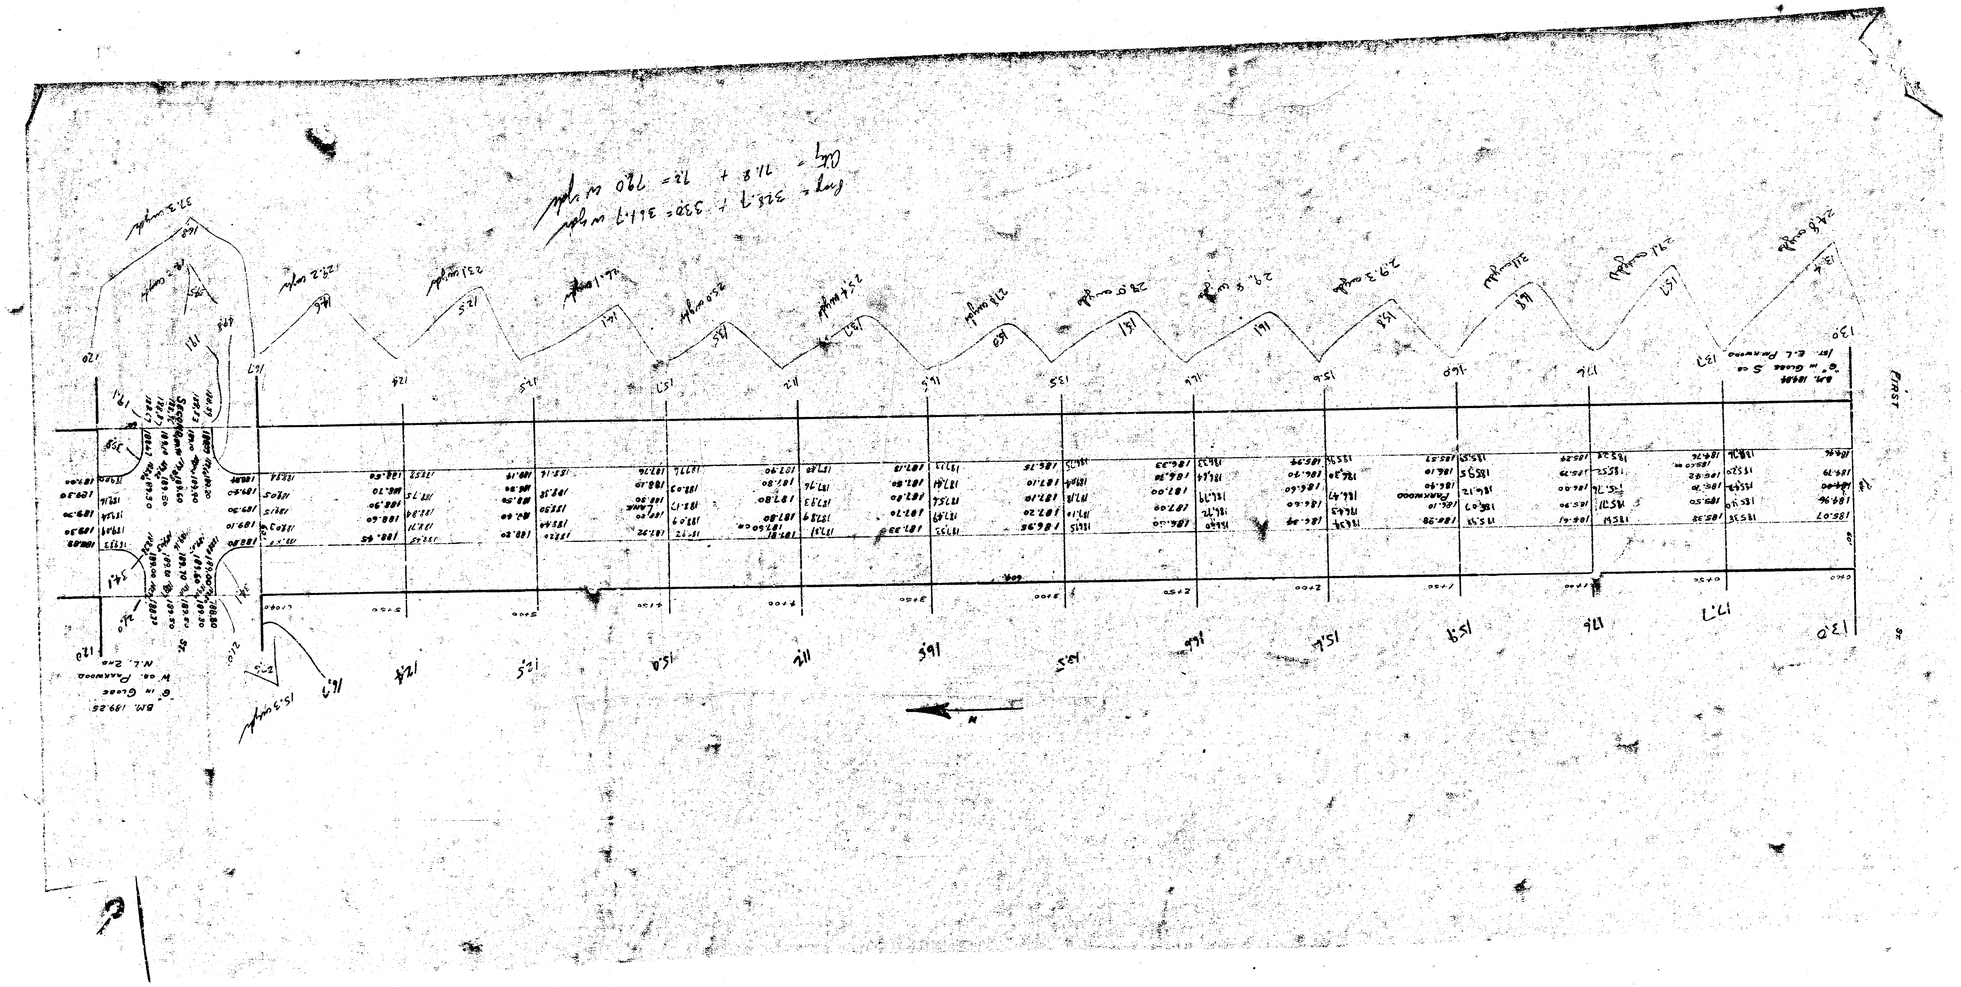
Proj = 959.6
754
1555.5