


B.M. TOP OF COLLAR ON SILL COCK, PKLS OF NO. 11008 E. ALTURA ELEV. 92.68
 B.M. "P" IN PK.S. W.C.B. PATTIE & N.L. DEL MAR ELEV. 90.60

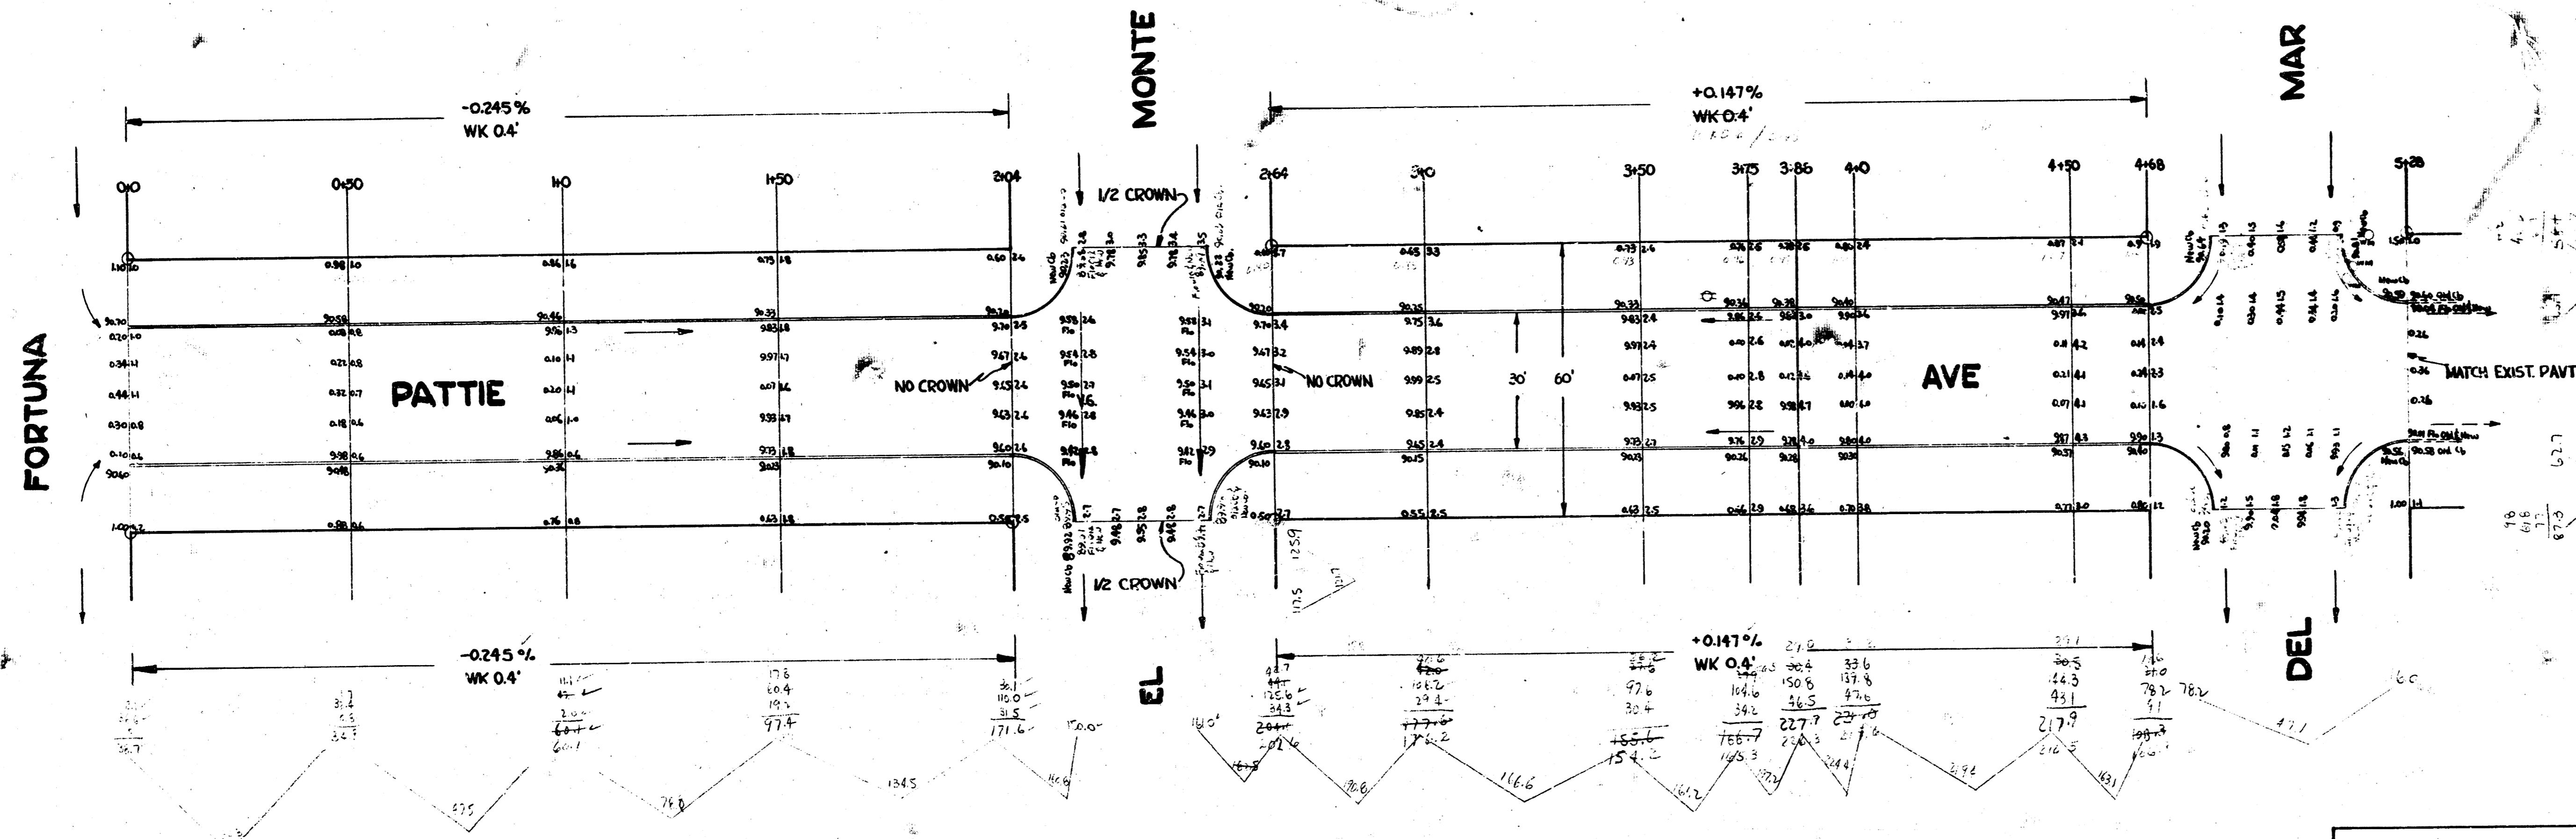

Survey City BK 57
 Plan 10
 Exc 10
 Checked 10

City
 6.41
 10.75
 6.81 7.36.3

Prop
 1771.9
 +10.76
 2174.9 7.36.3

PATTIE AVE
 N.L. FORTUNA TO N.L. DEL MAR
30' CONC. & CURB
CITY OF WICHITA, KANSAS
 B.E. SMITH CITY ENGINEER
 AUG 1955 PROJ. NO. C14-154