
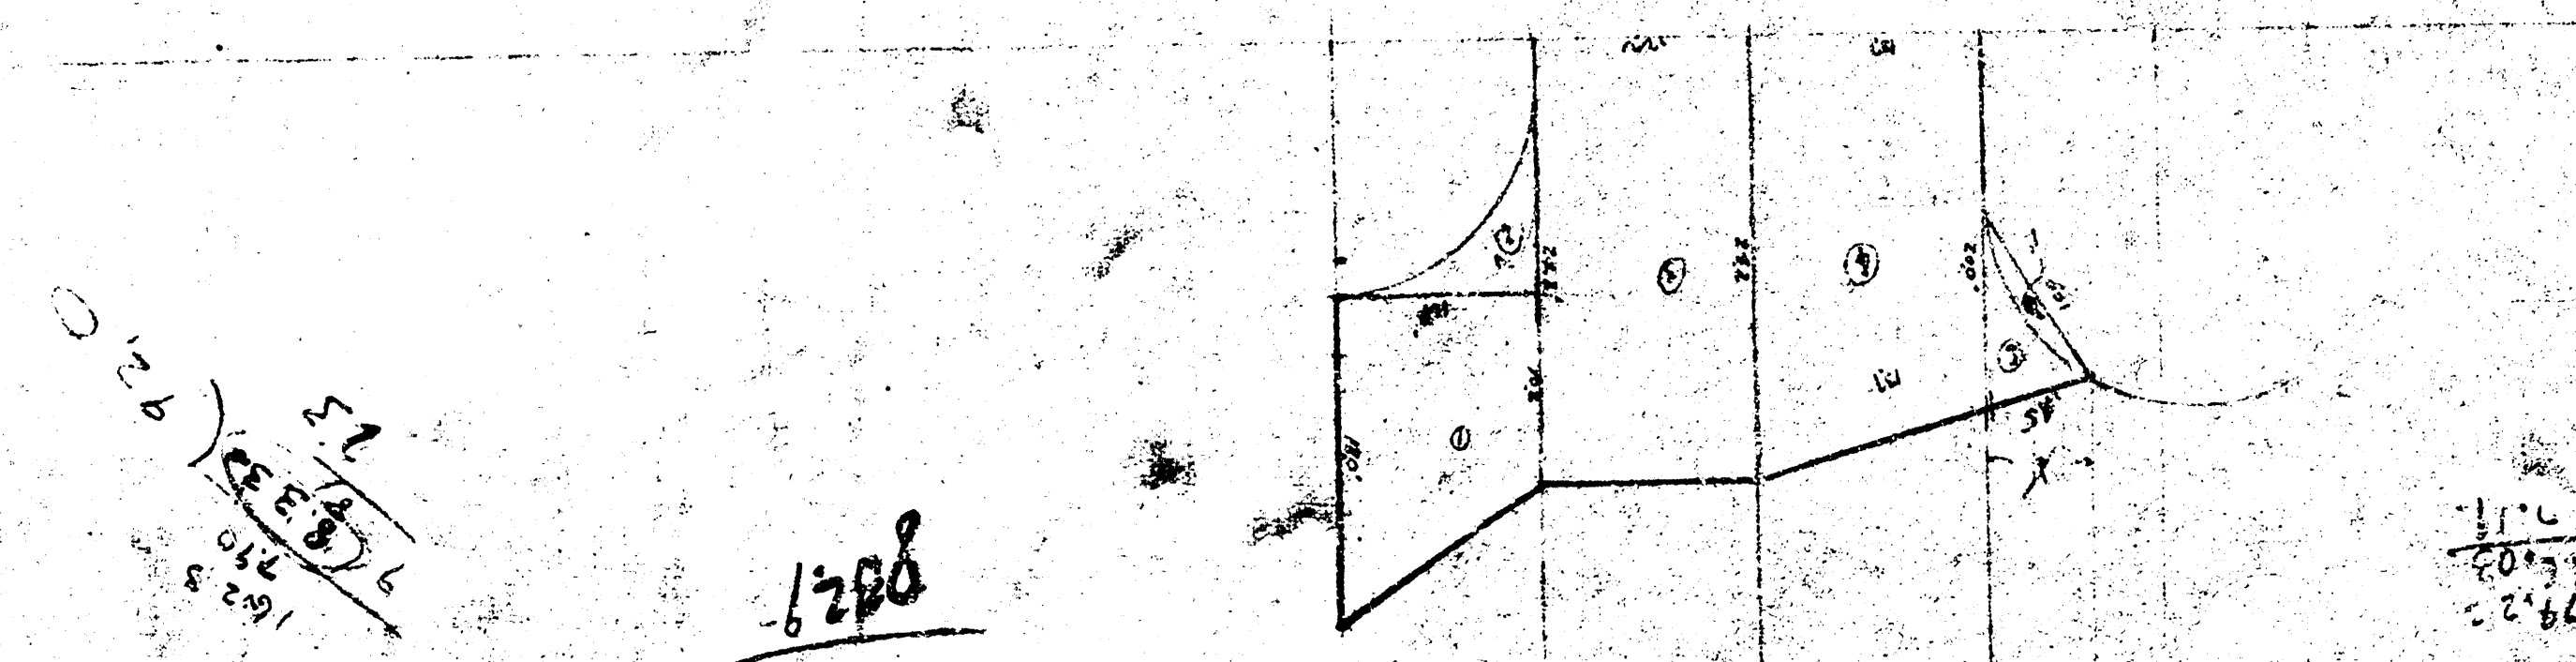


36-2-40

1879 Elec 11901 "G" in globe Dec 14th E.L. Payne

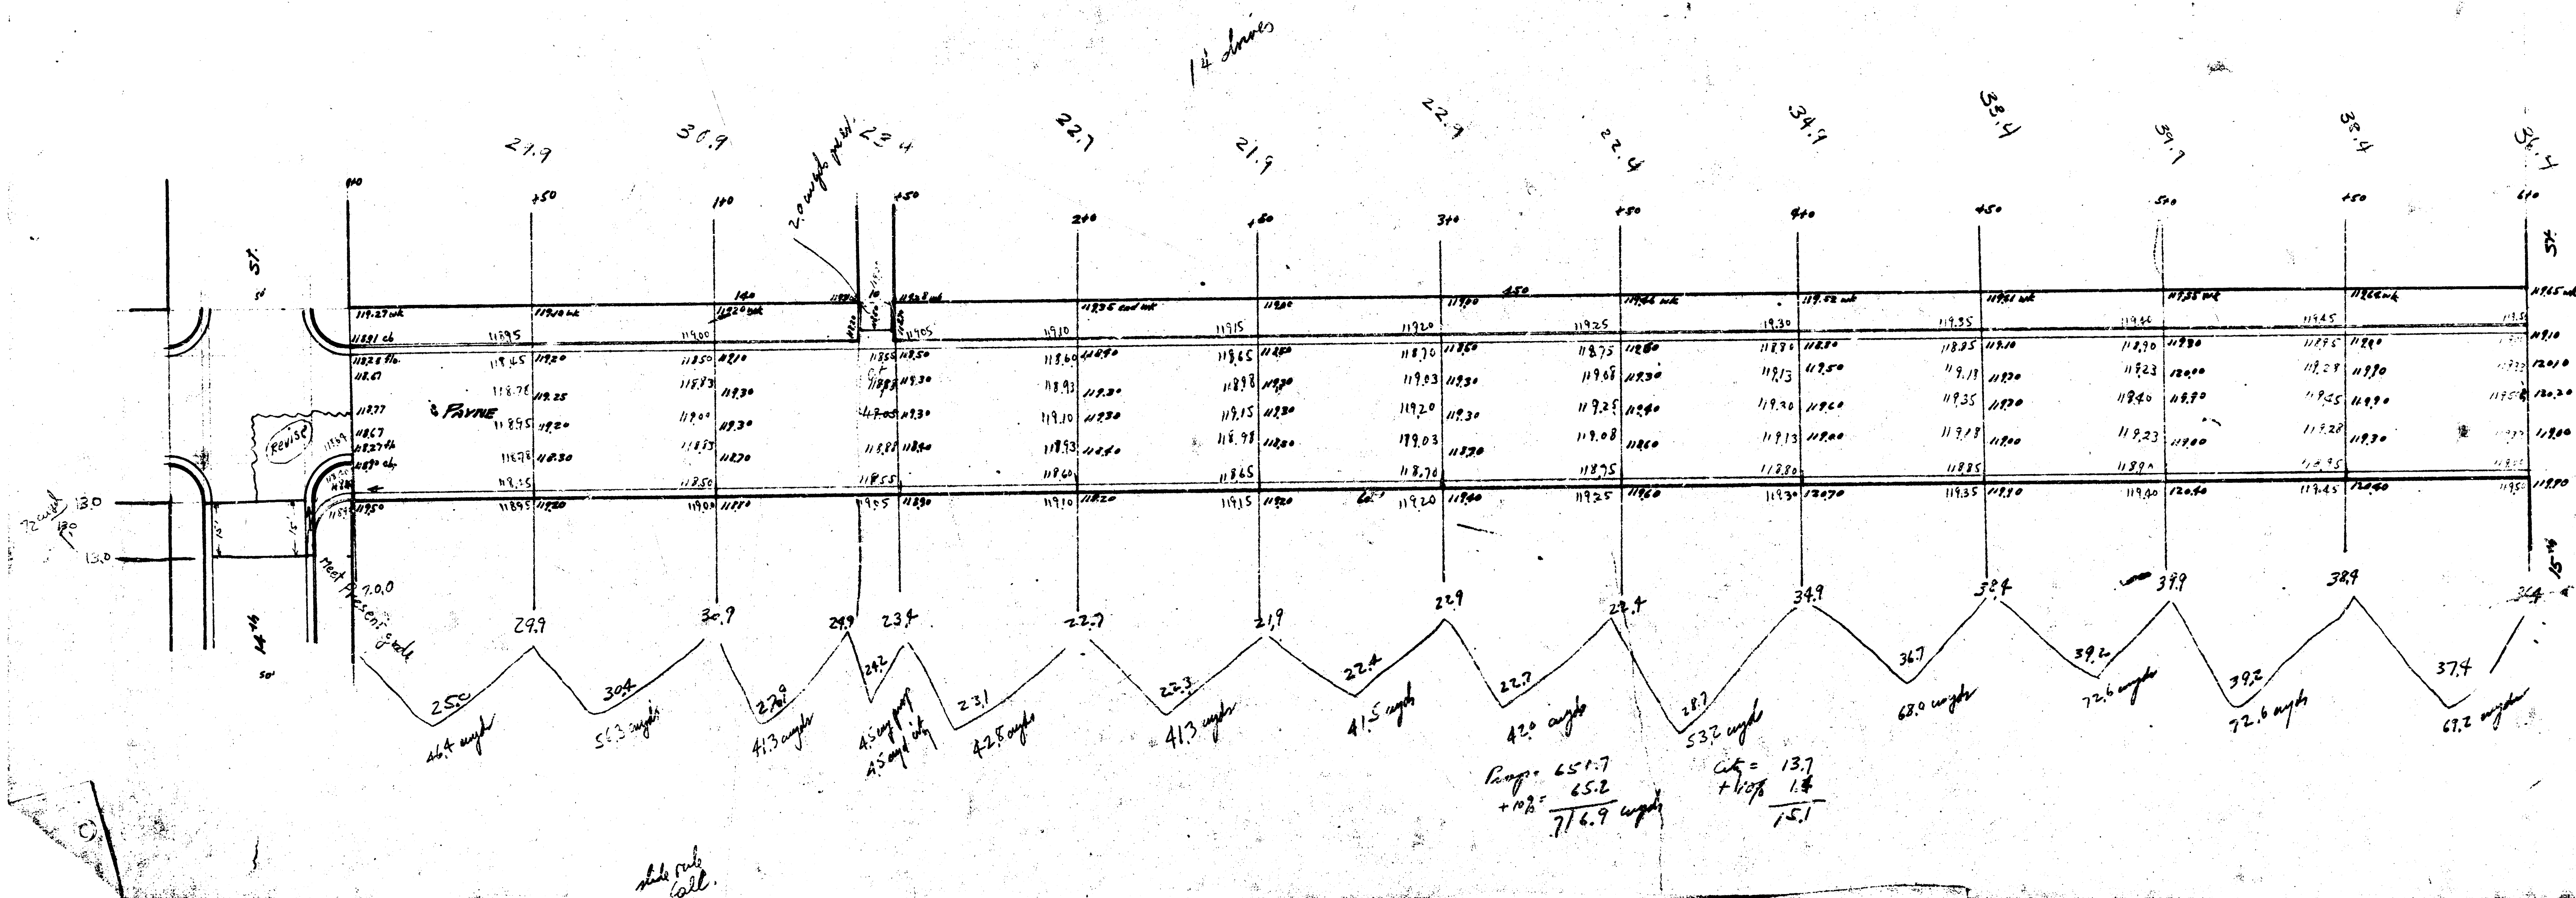

1208

371 - 13-50 (5)

79,22
6,603
7,11

64765
647
647
641
647








5751