


B.M. 60 #NAIL N.S.P. POLE S.W. COR. GARLAND & 25TH. ELEV. 125.66
 B.M. (STEP) P. POLE S.W. COR. PAYNE & 25TH. ELEV. 125.41

STA. ON E.

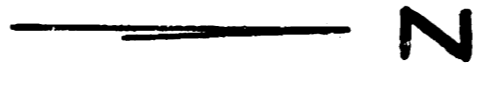

NOTE TO CONTRACTOR

WK. GRADE OF 0.4' WILL APPLY EXCEPT TO MATCH EXISTING CONC. DRIVES.

1404 E 8' DR. 301'R

1489 E 8' DR. 301'R

2105 E 8' DR. 302'R

2759 E 8' DR. 301'R


3405 E 8' DR. 302'R

3445 E 8' DR. 302'R
3455 E 8' DR. 288'L

4105 E 8' DR. 301'R & 288'L

4150 E 8' DR. 302'R
4160 E 8' DR. 30'L

5044 E 8' DR. 30'L
5110 E 8' DR. 30'R

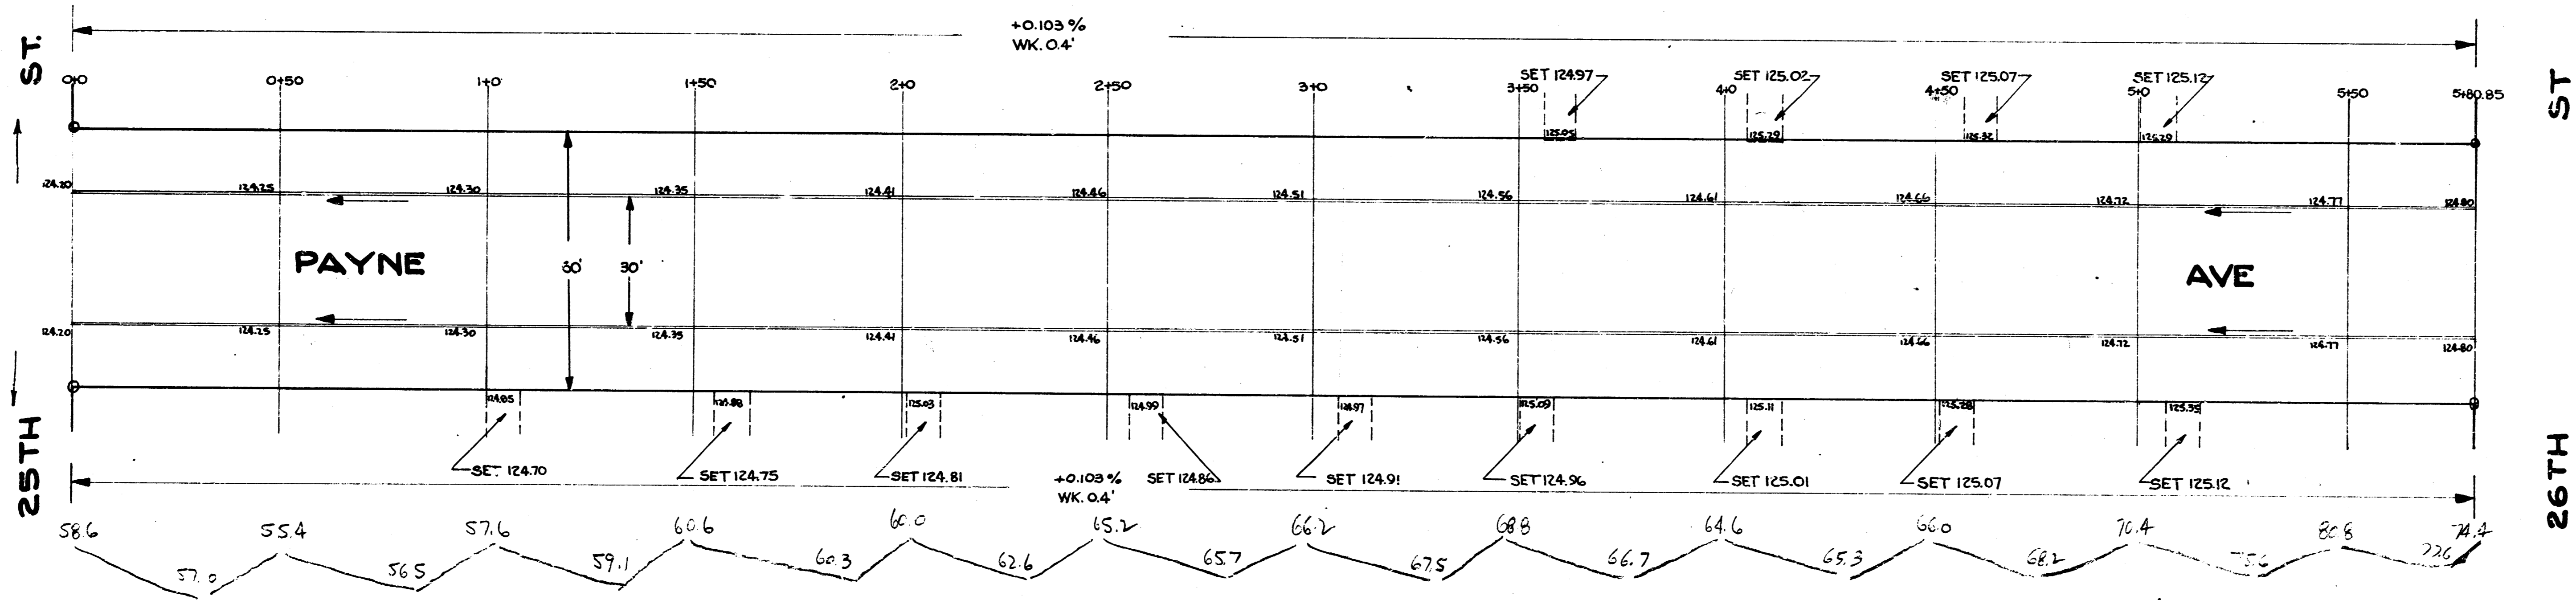

Survey 581
 Plan 10
 Check 77

1393.3 cu yds
 +100/6
 1537.6 yds

PAYNE AVE
 N.L. 25TH TO S.L. 26TH
30' CONC. & CB
CITY OF WICHITA, KANS.
 B.E. SMITH CITY ENGINEER
 FEB 1954 PROJ. NO. CB-124

