



Ref Book No. S.H. Mills-76.

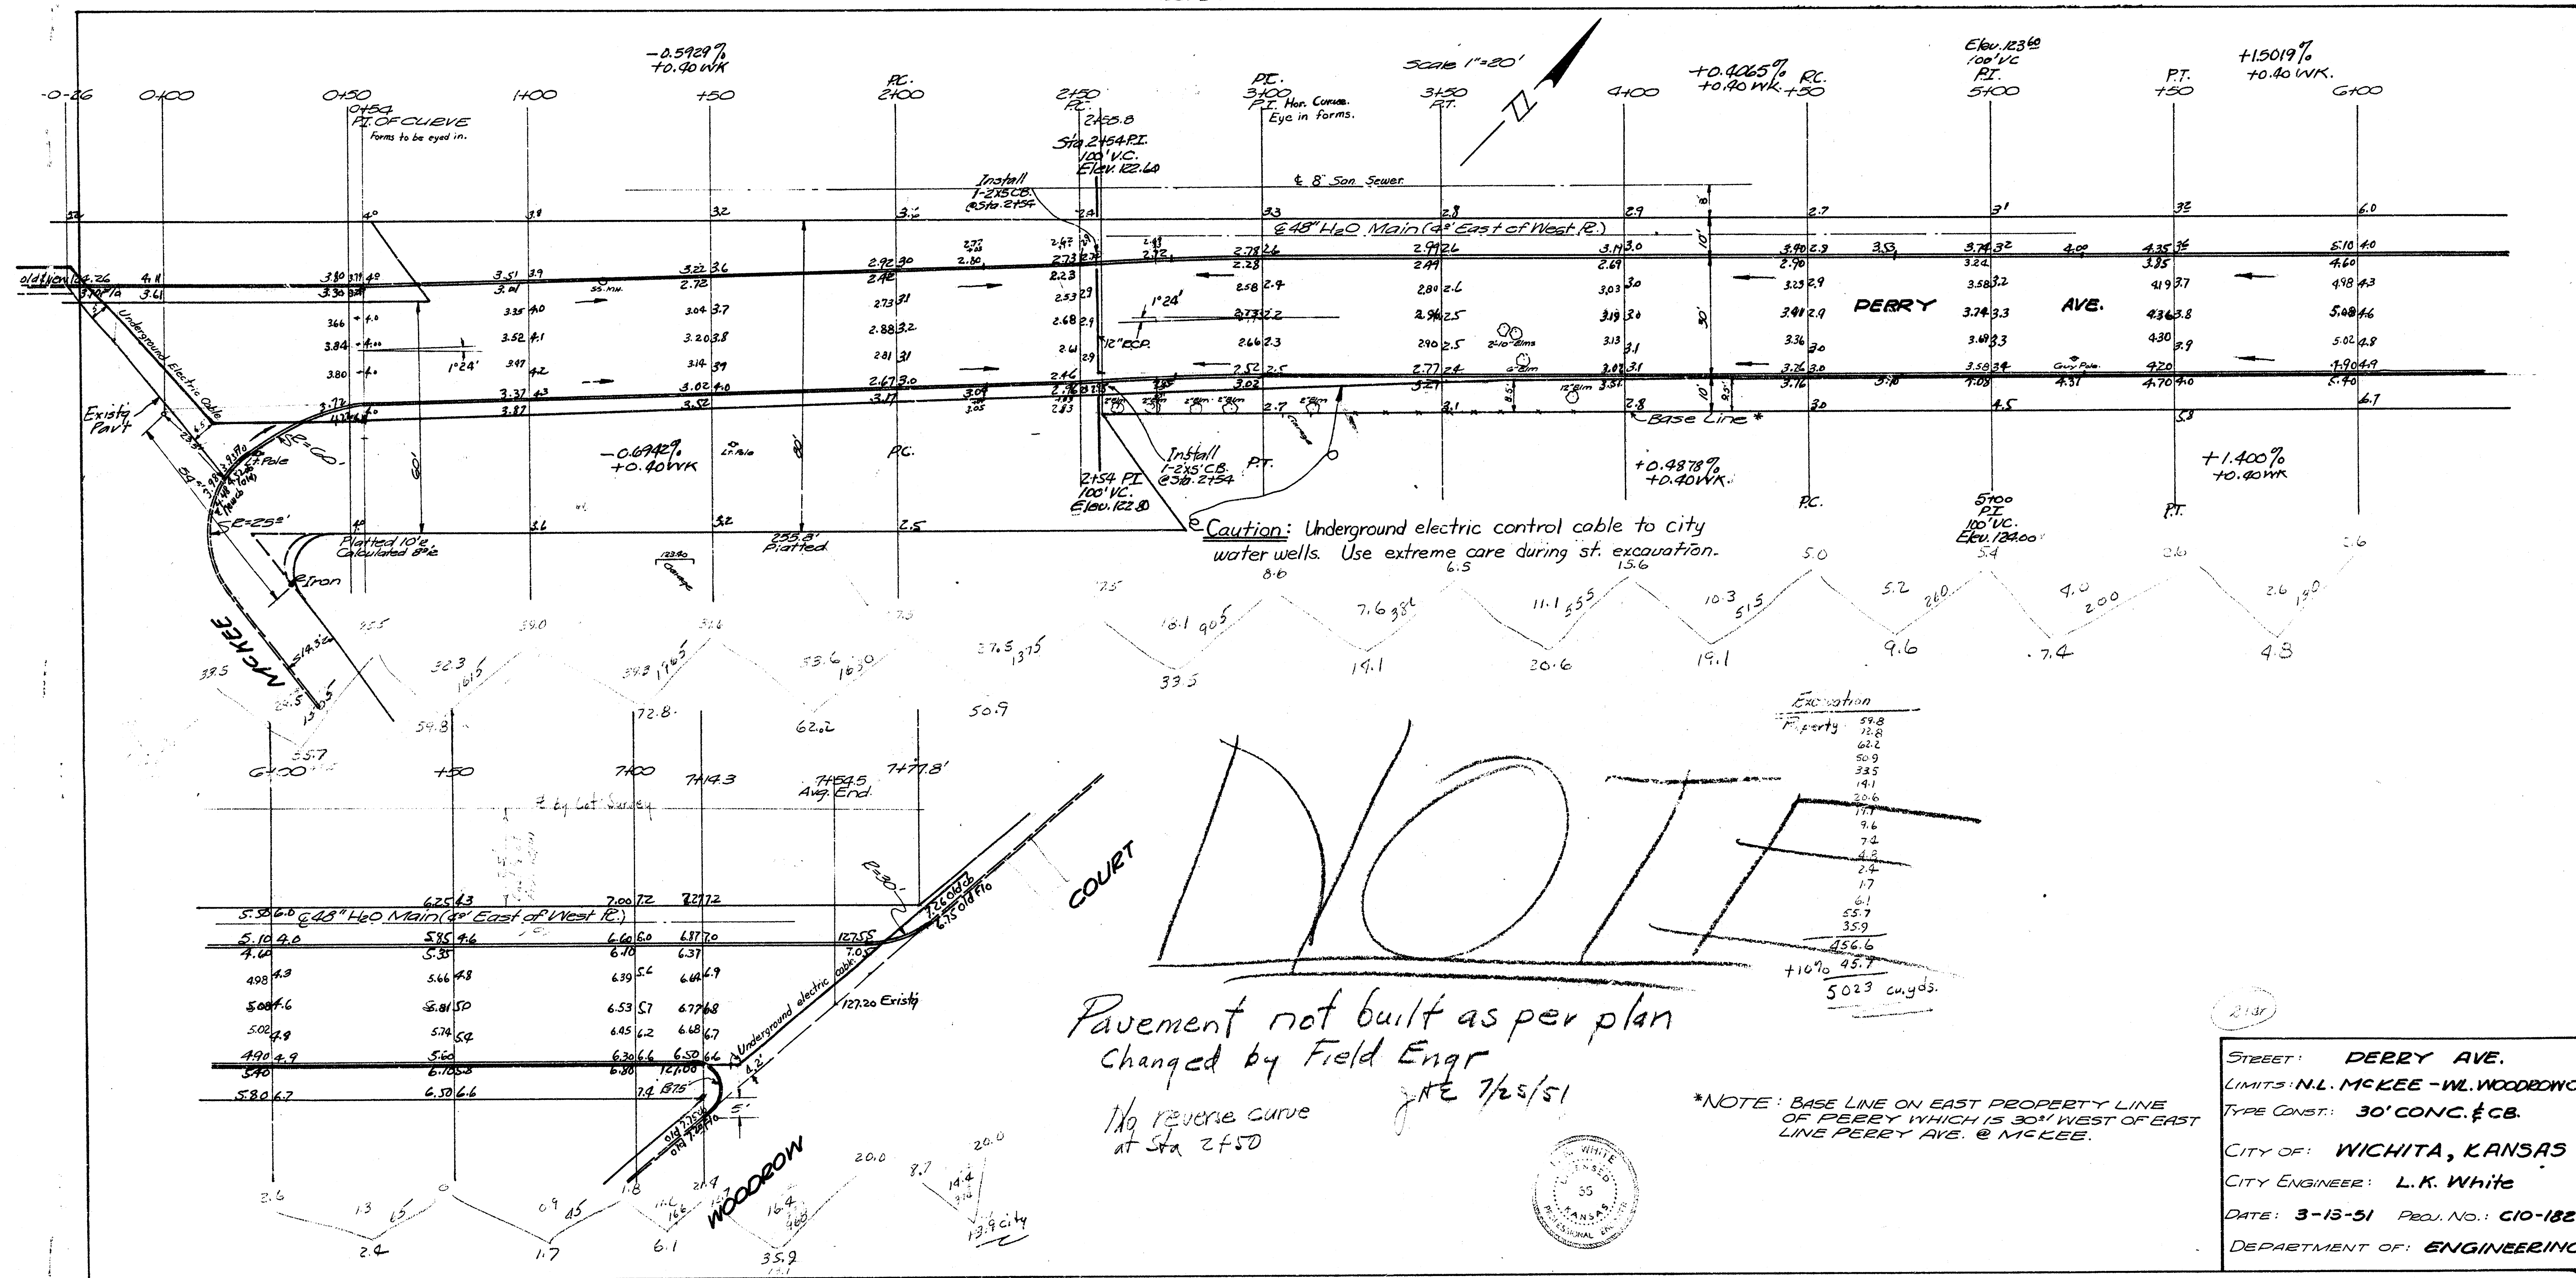

Ref. Book No. C.H. Mills - 76.

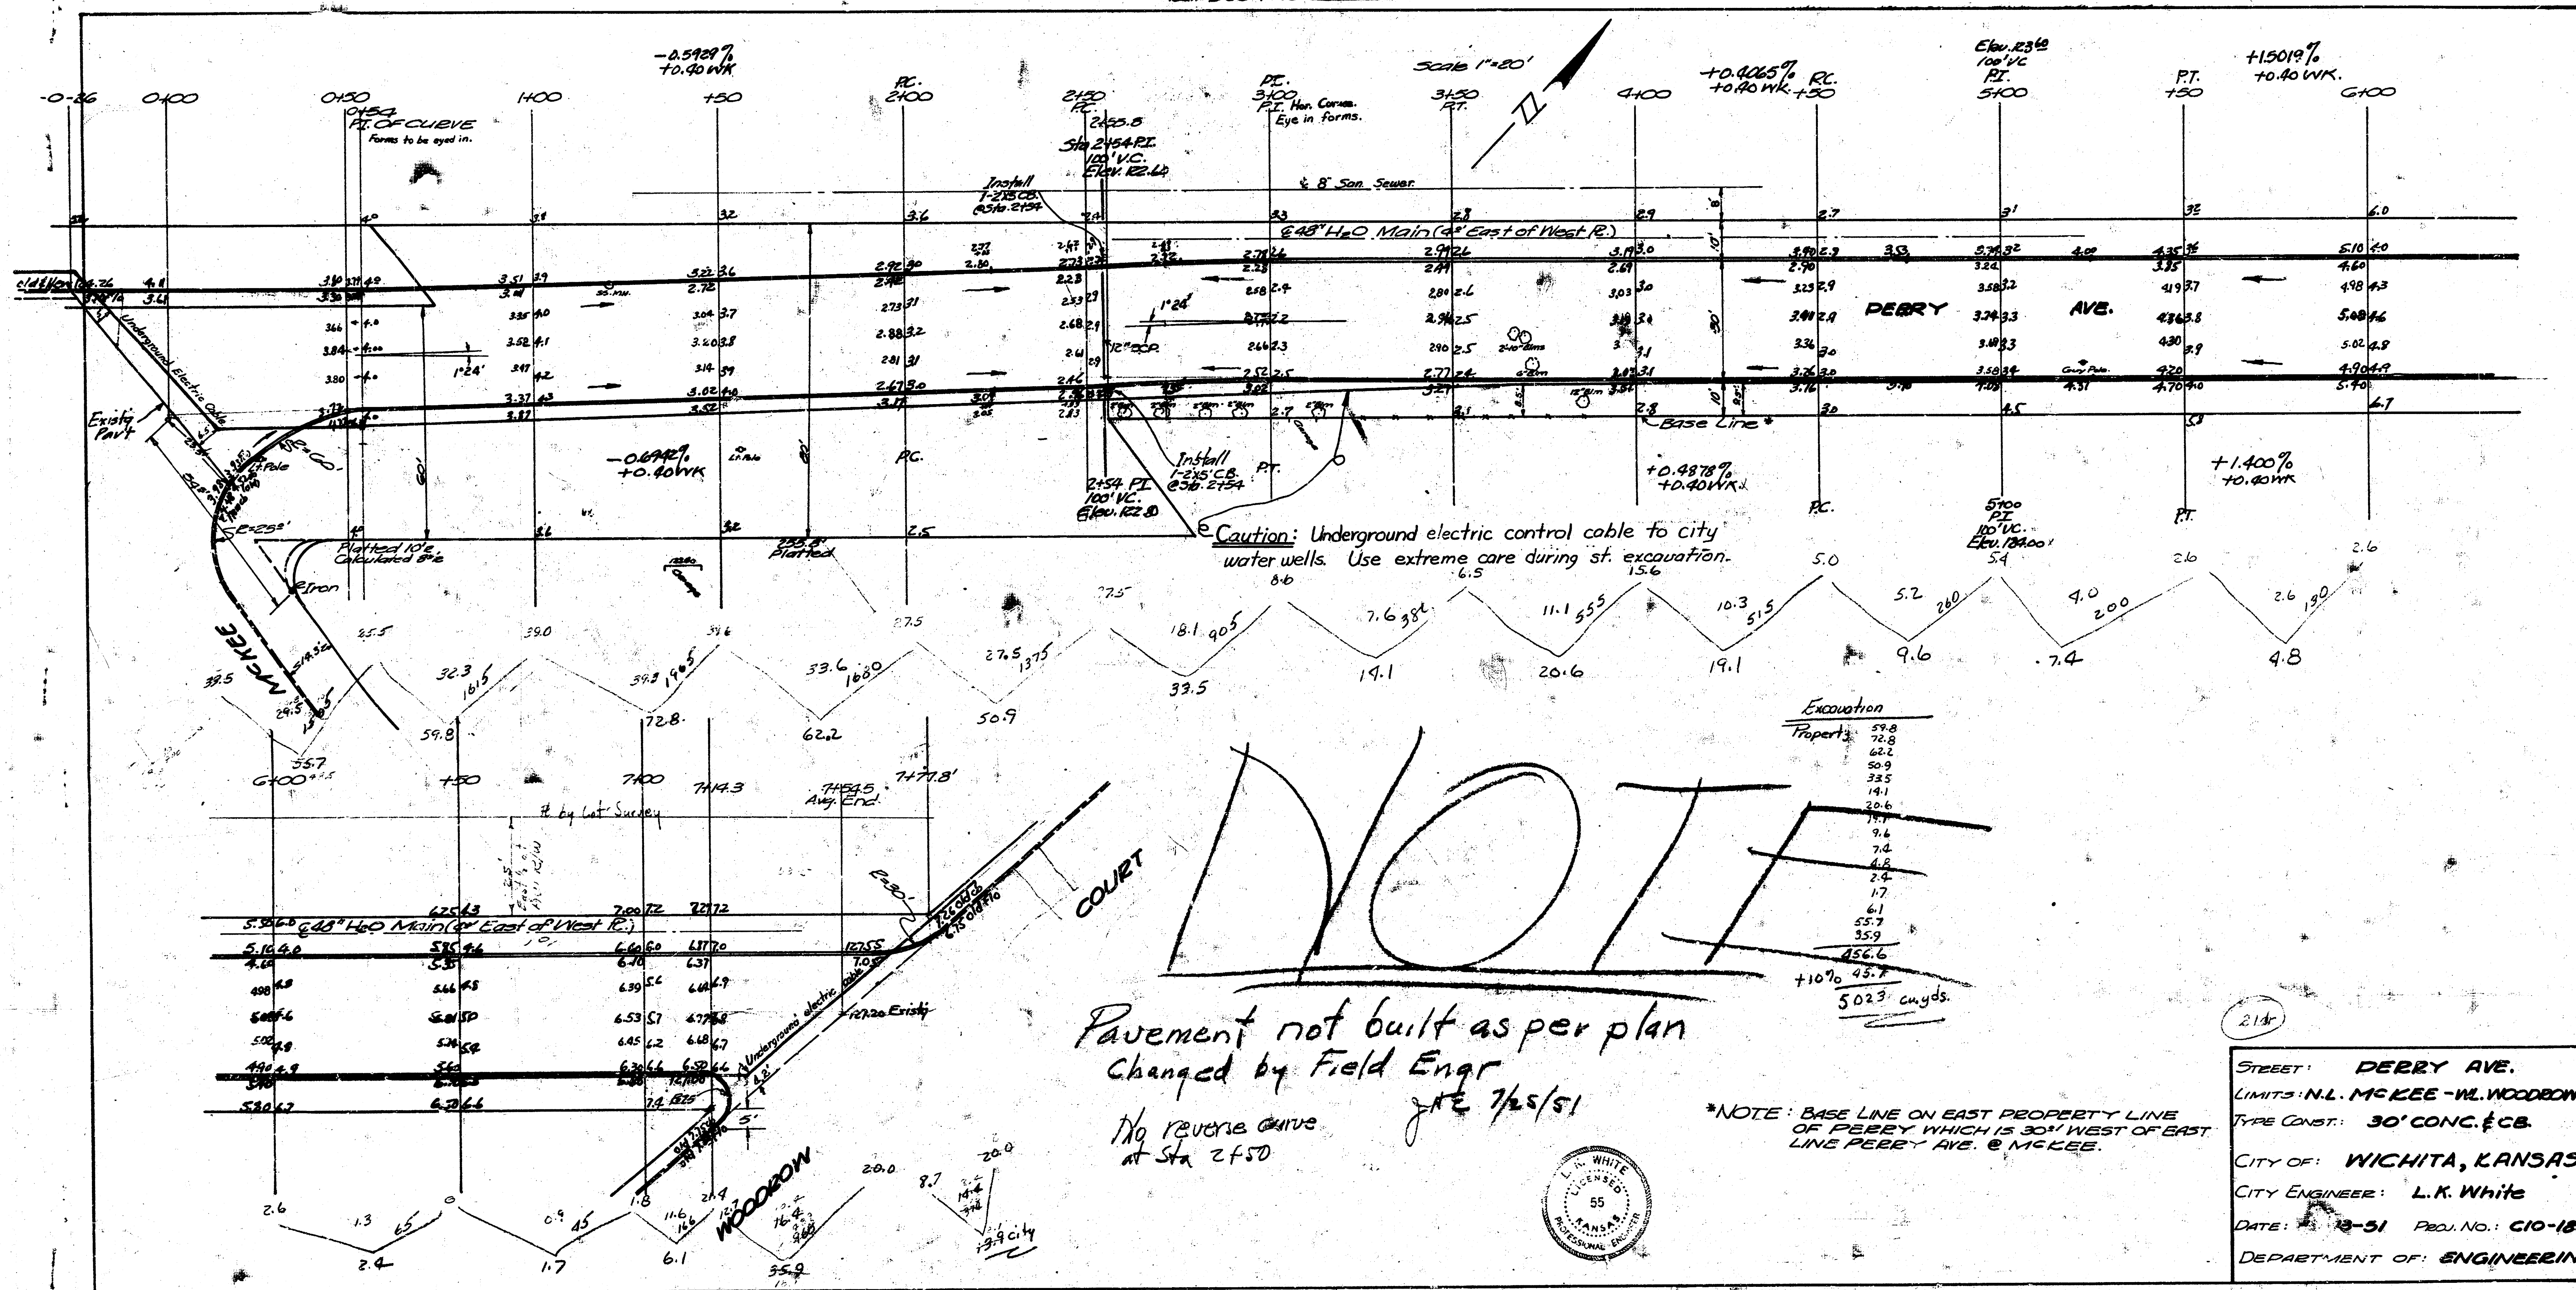

STREET: PERRY AVE.
LIMITS: N.L. MCLEE - W.L. WOODROW
TYPE CONST: 30' CONC. & CB.
CITY OF: WICHITA, KANSAS
CITY ENGINEER: L.K. White
DEPARTMENT OF: ENGINEERING