


B.M. 116-47 Rem. Thin C. Post & 13TH

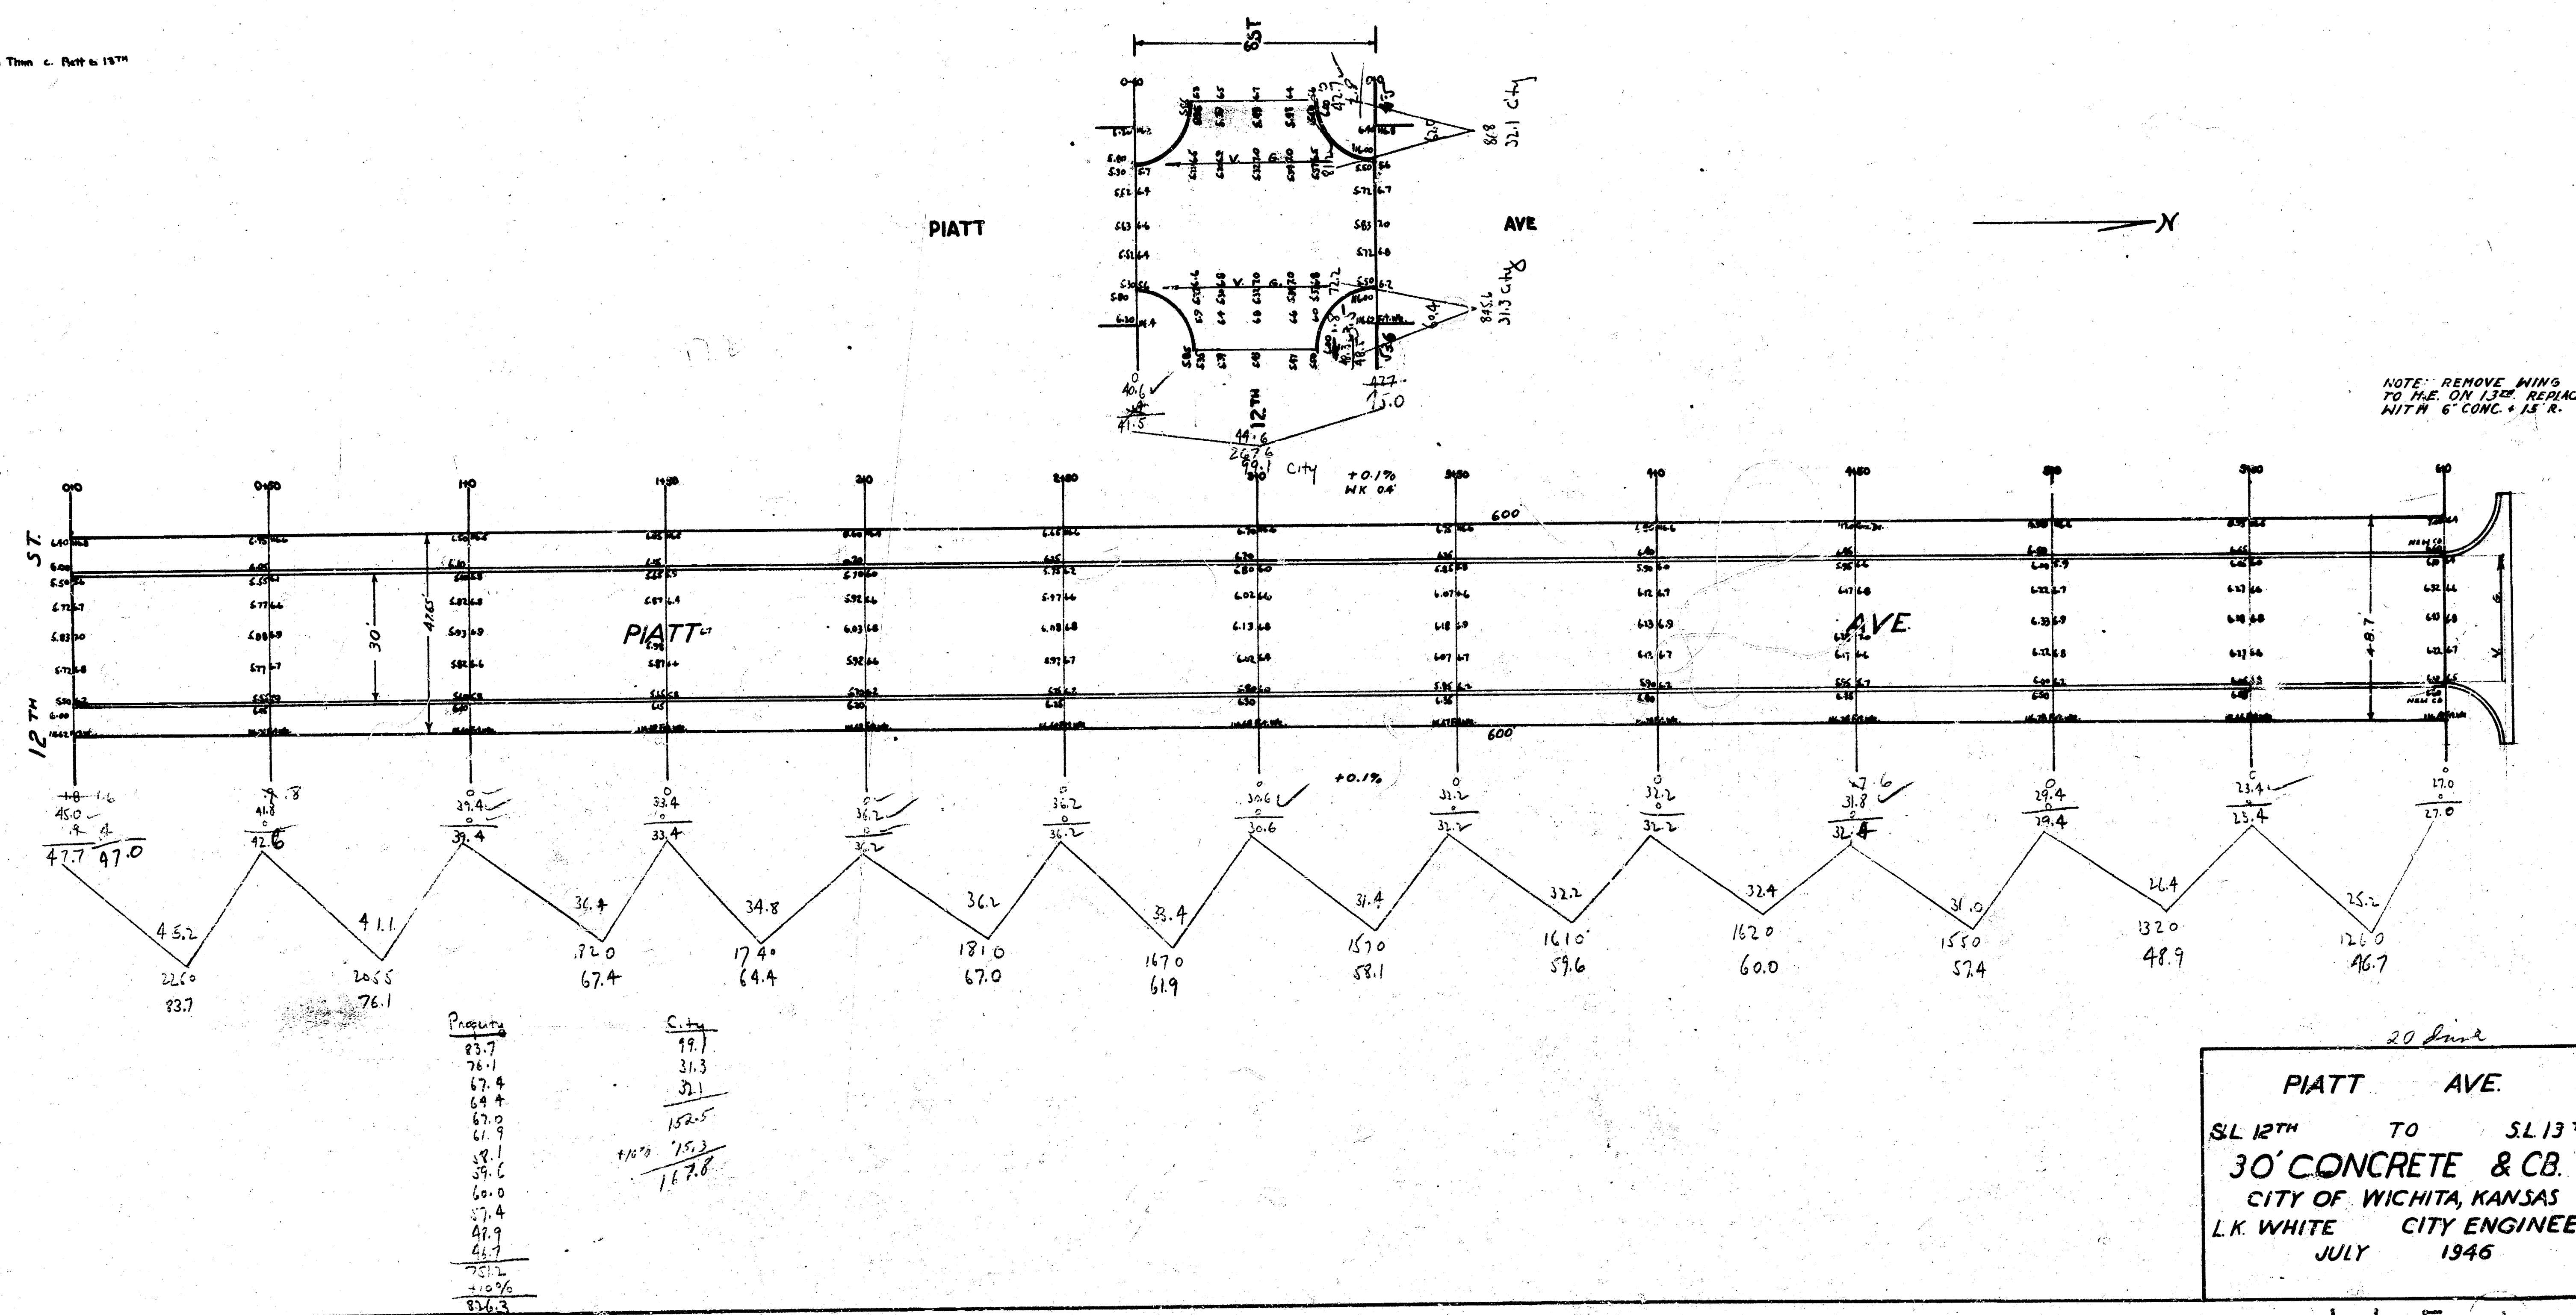

4 5 5 4