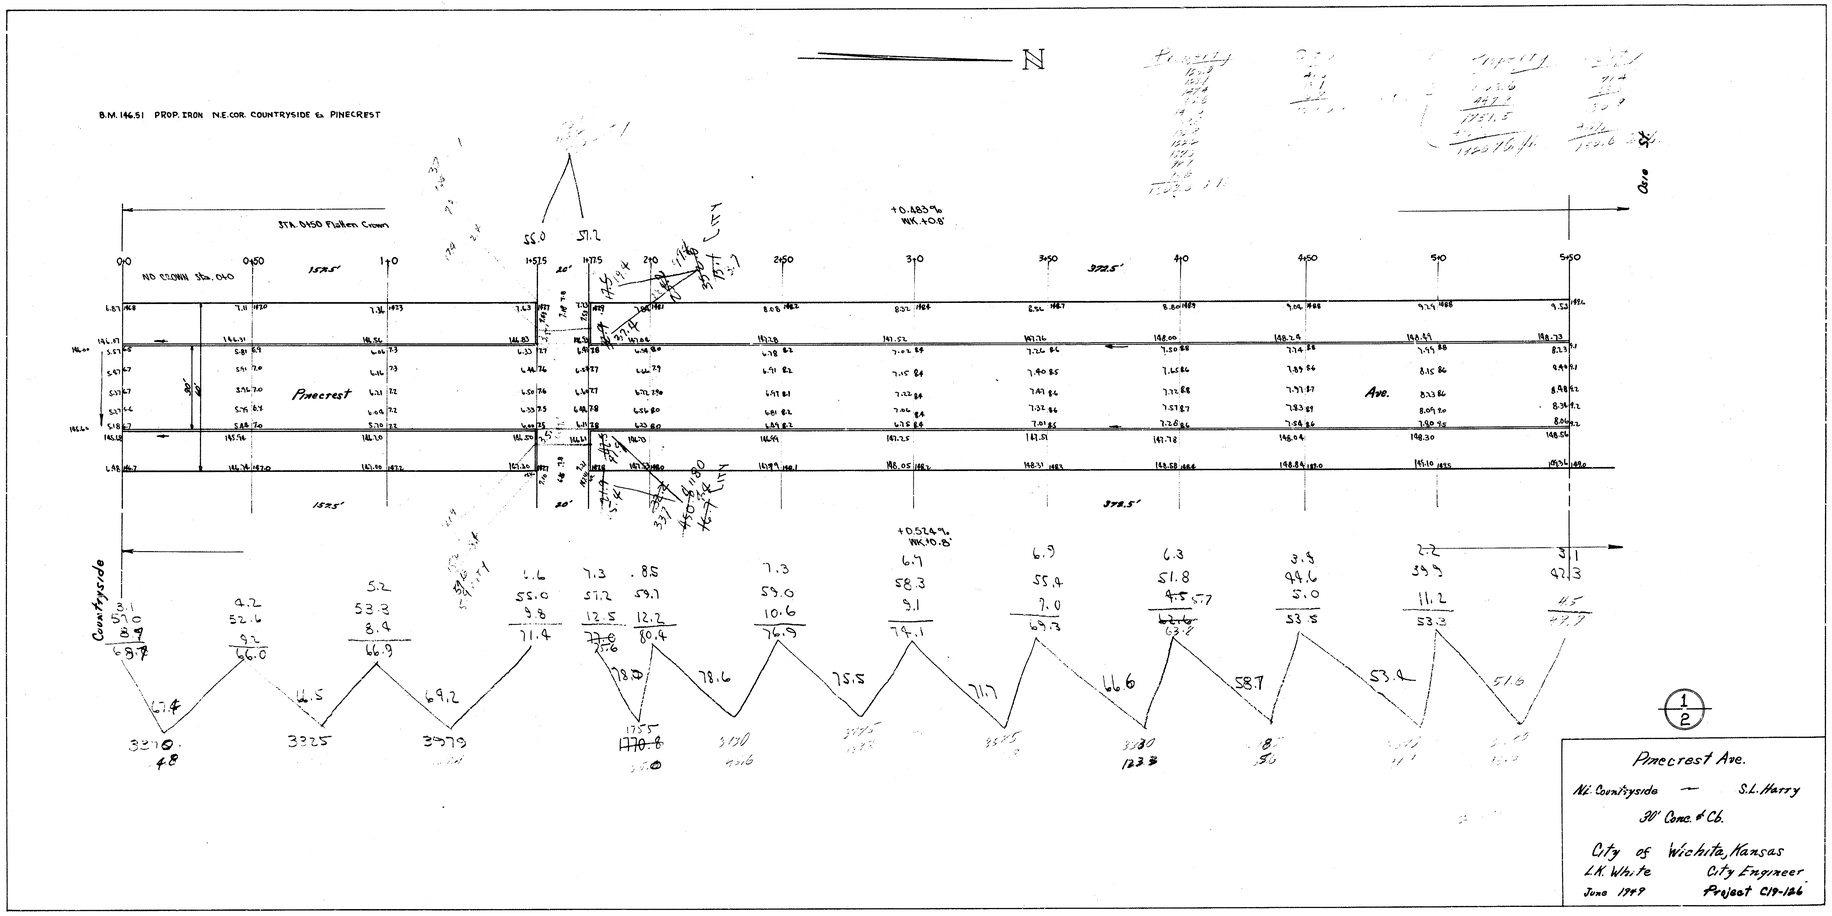
N
B.M. 146.51 PROP. IRON N.E.COR. COUNTRYSIDE & PINECREST
STA. 0+50 Flatten Crown
NO CROWN Sta. 0+0
Pinecrest
Ave.
Countryside
+0.483%
+0.524%
Pinecrest Ave.
N.E. Countryside — S.L. Harry
30' Conc. & Cb.
City of Wichita, Kansas
L.K. White City Engineer
June 1949 Project C14-126

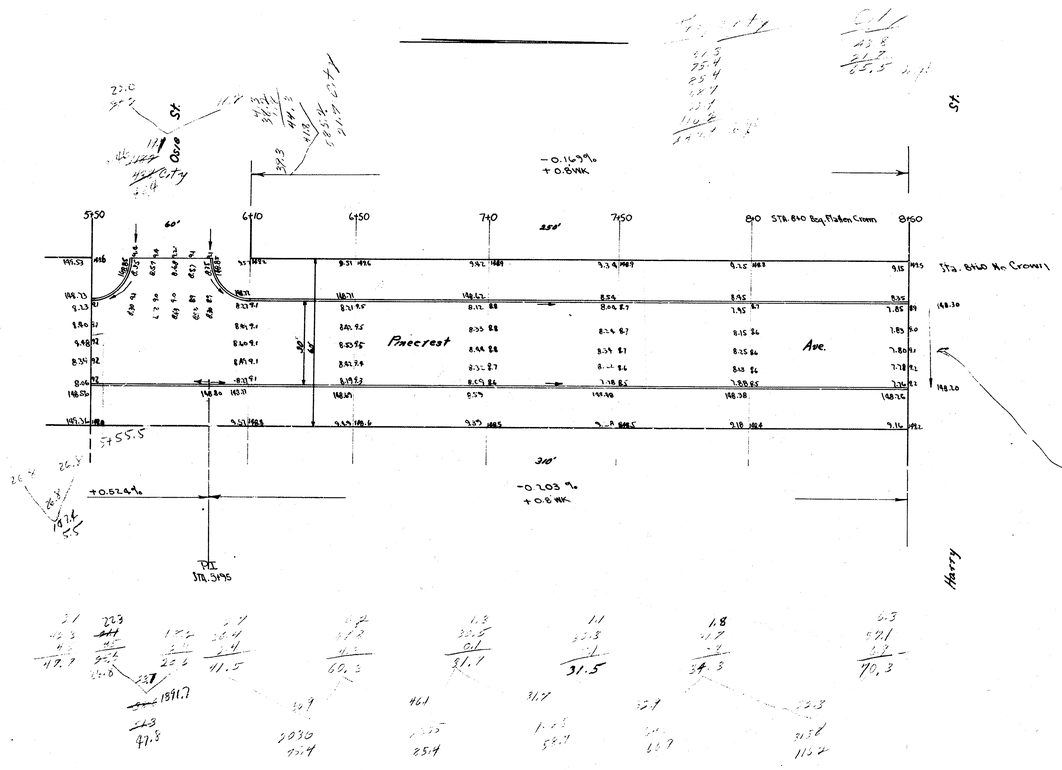

Note: Install 24" Con. Iron culvert & Connect end of slab to block tip in Harry St with asph surface.

PJB