


BM. 146.89 Standard SW corner Edgemoor and Harry.

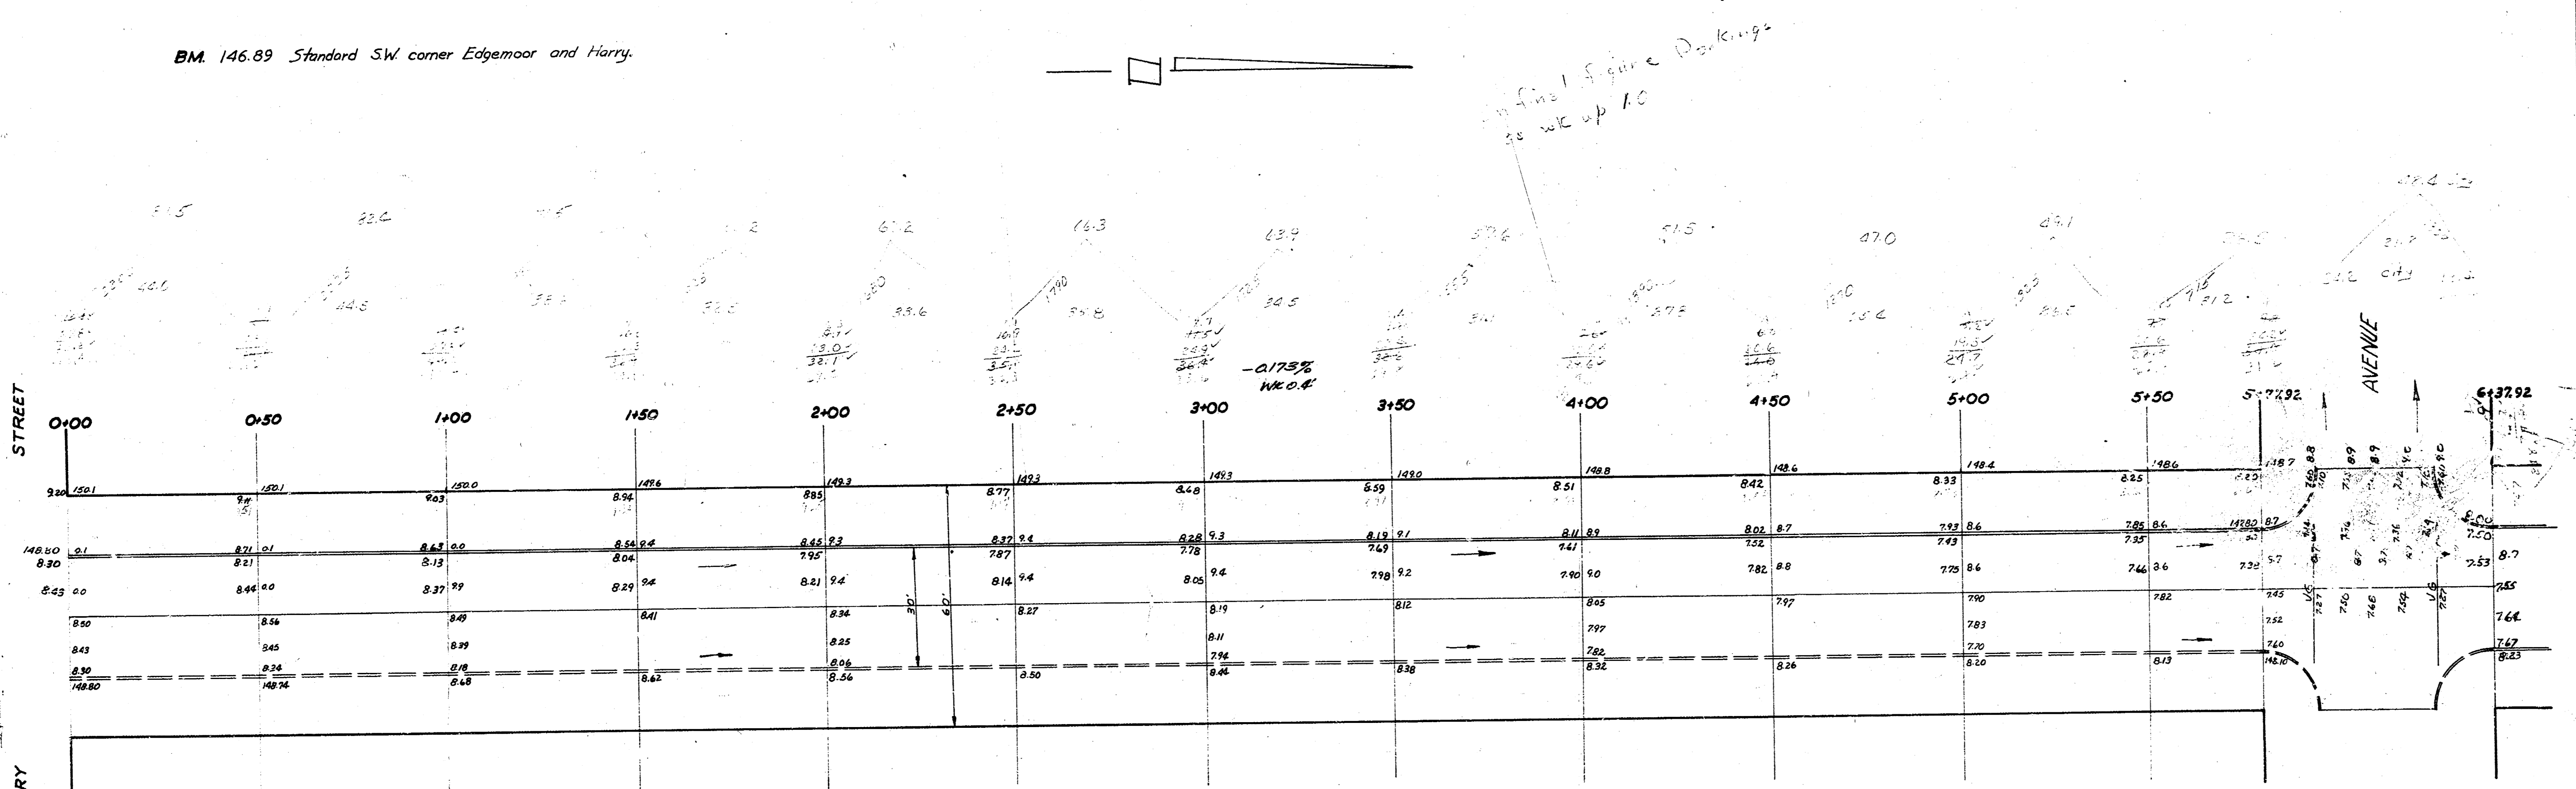

Excavation

Property	Site
81.5	
82.4	
71.5	
62.2	
68.3	
63.7	
52.4	
51.5	
41.0	
41.1	
21.5	
719.7	
71.0	
791.7	cu yds.

Excavation


Property	City
79.4	
78.0	
78.7	
50.7	
95.3	
40.8	
382.3	
9636.3	cu yds.
4101.382	
400.5	cu yds.

PINECREST AVENUE
 NL Harry St. to SL Lincoln St.
 30' Conc. & Cb.
 City of Wichita Kansas
 LK White City Engineer
 April, 1951 Proj No. C10-173




1/4

134.7
 211.9
 241.3
 271.3
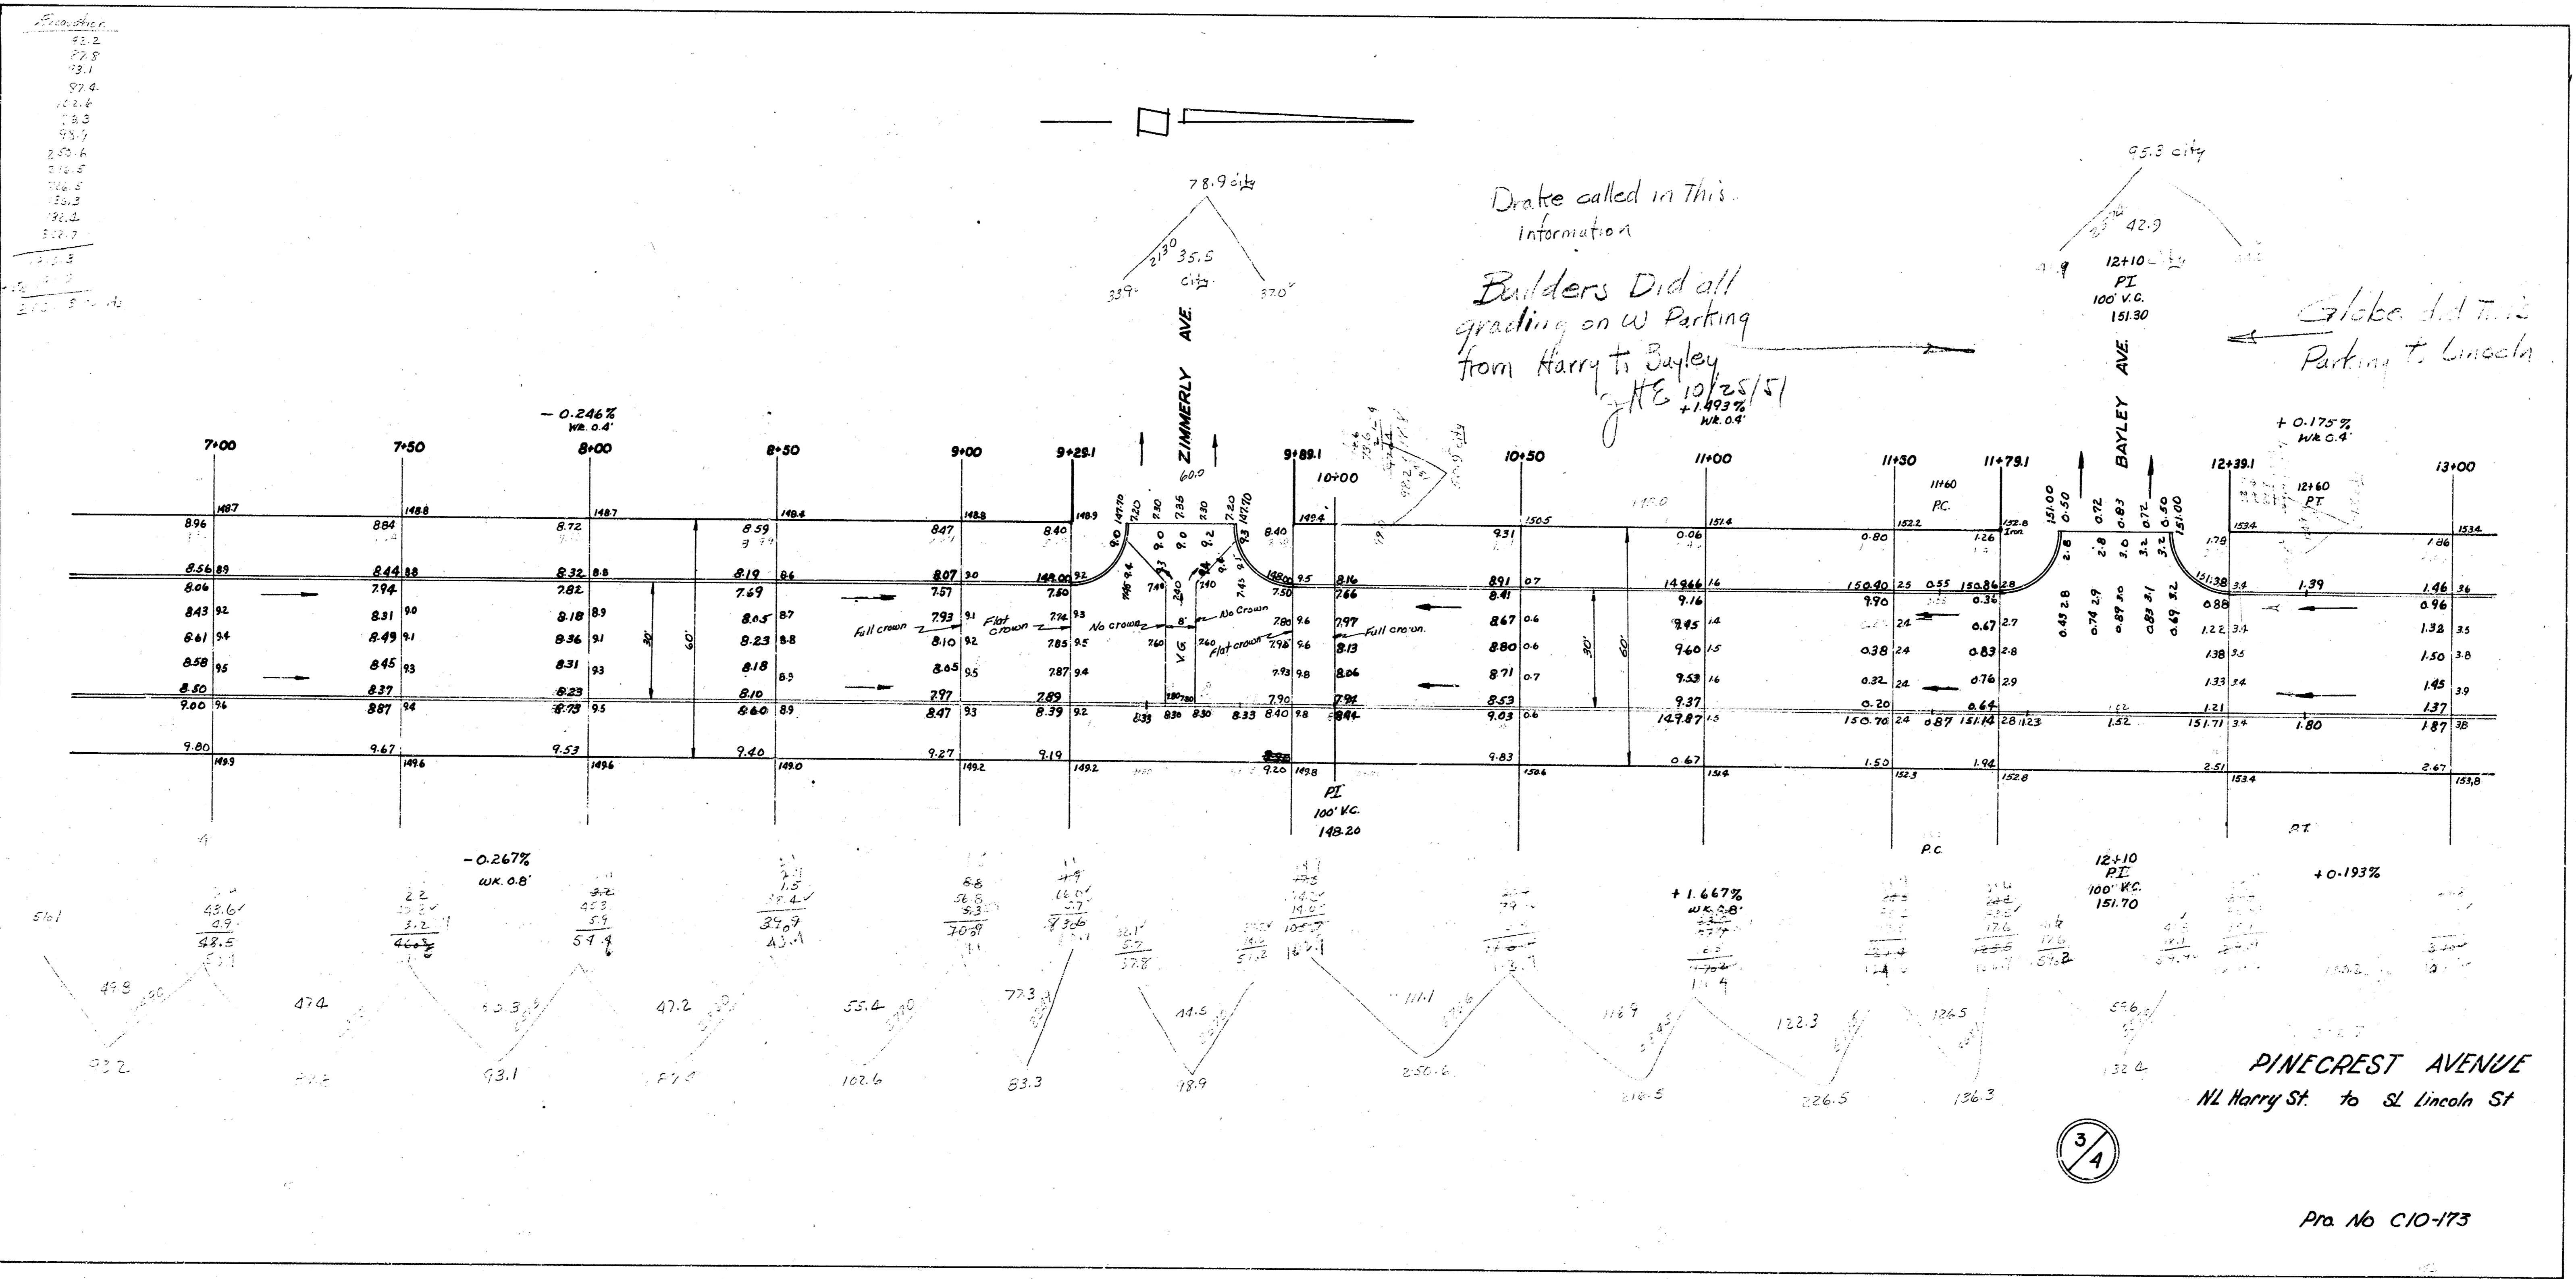


B.M. 146.89 Standard S.W. corner Edgemore & Harry.

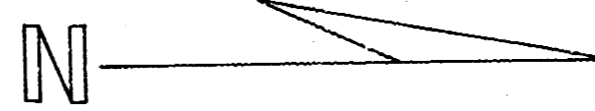


Property
 52.7
 94.1
 76.3
 80.2
 70.7
 78.3
 78.1
 76.5
 69.1
 81.3
 76.5
 33.1
 237.3
 210.0
 914.1 C.D. 485.

5+00
 15.5
 30.4
 4.8
 1.096
 53.8 C.D. 485.

St.

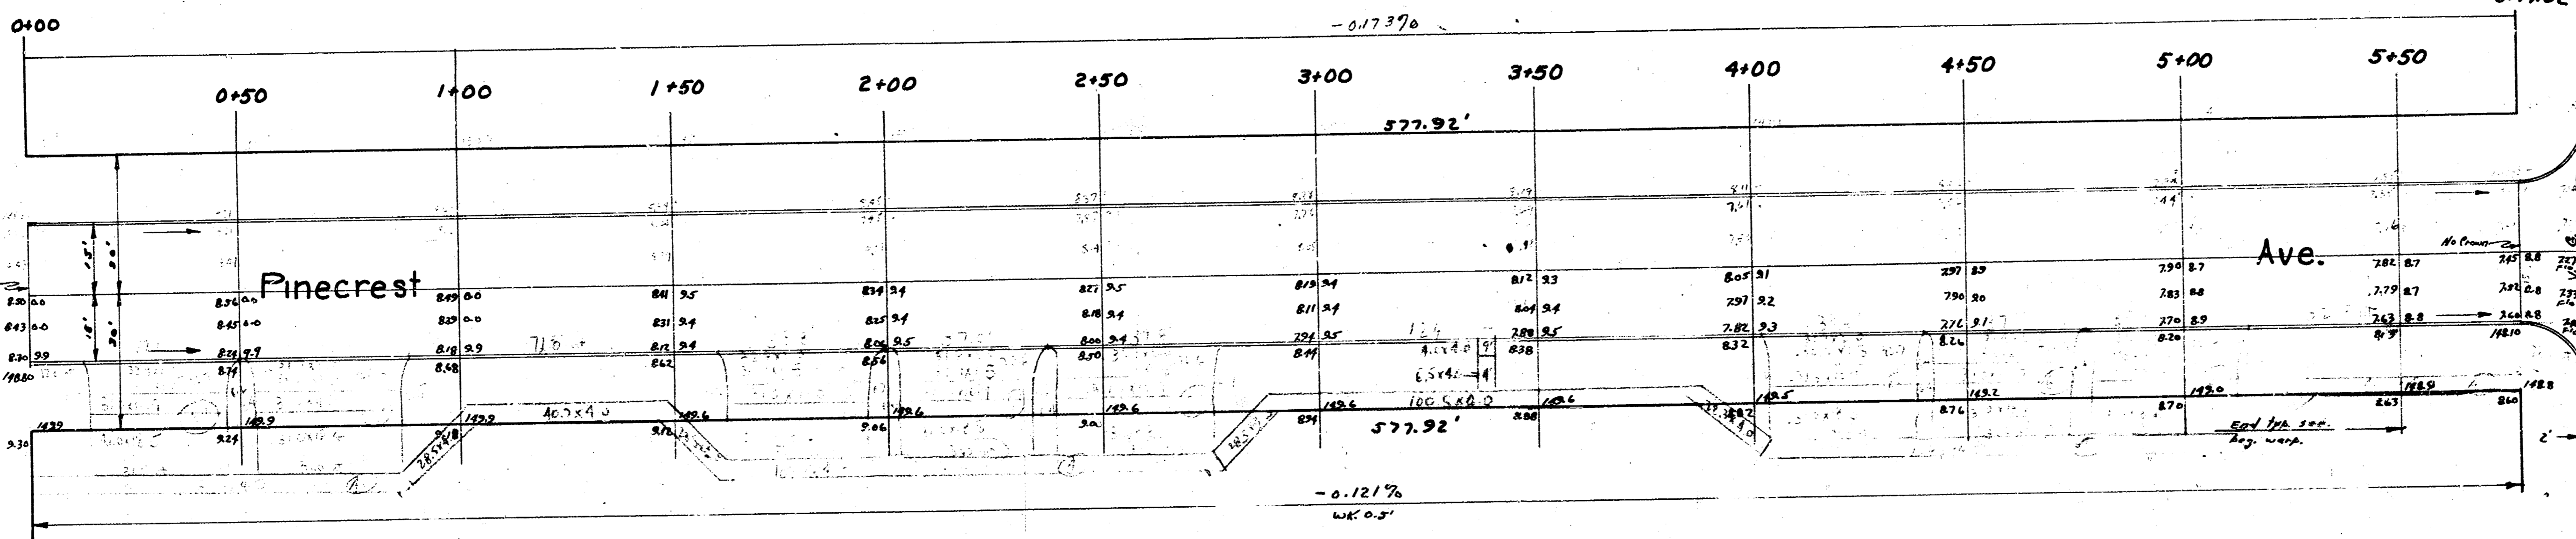

Harry

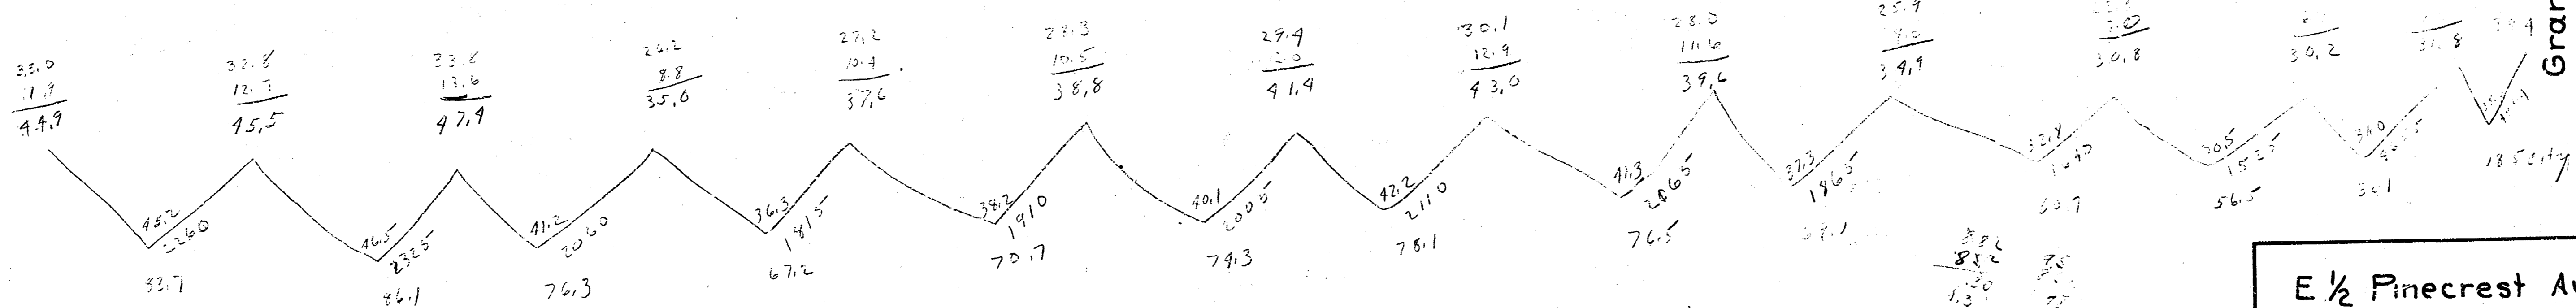

Grand

E 1/2 Pinecrest Ave.
 N. L. Harry to & Grand
 15' Conc. & Cb.
 City of Wichita, Kansas
 L. K. White - City Engineer
 April 1950 Private Job.

4 4 4 50