


3.1194.85 6" in GLOBE, MS. Pinecrest, SL 10TH
 Stationing on H.P.




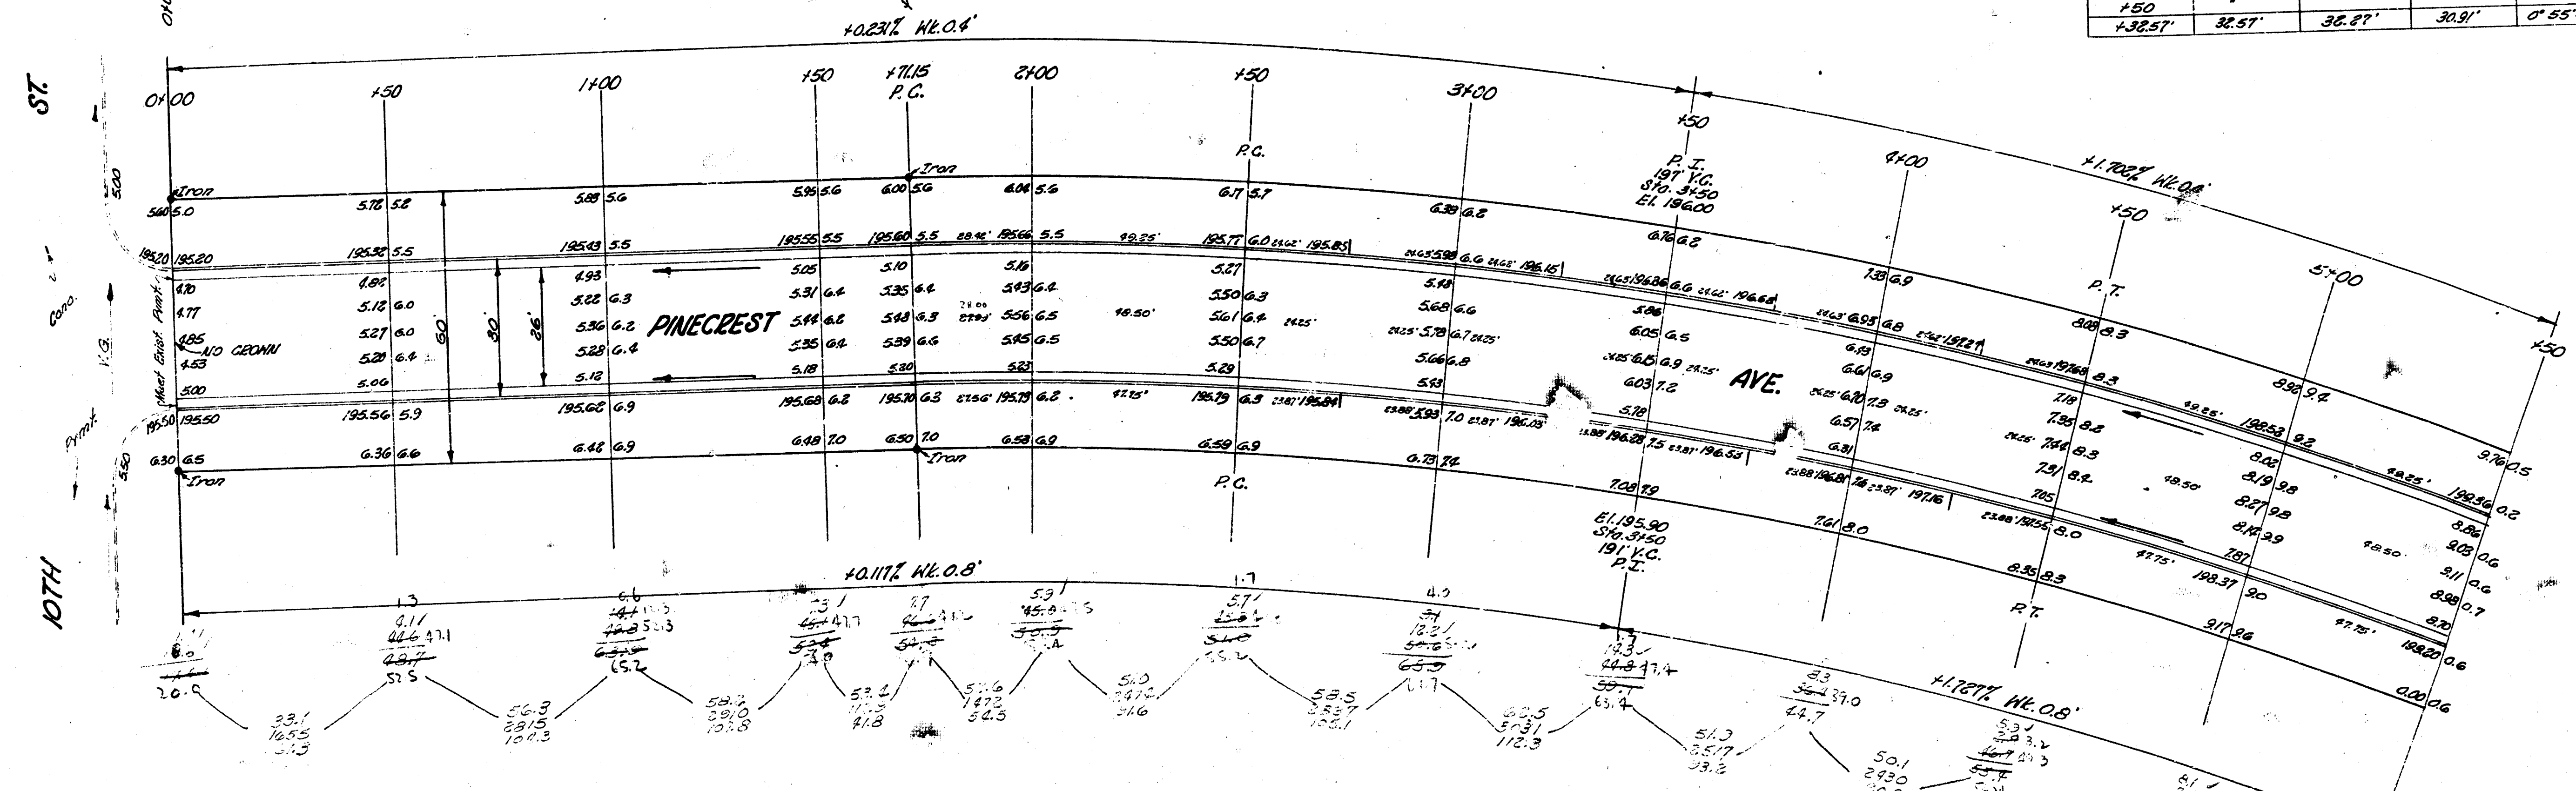

SECTION
 3.1194.85
 TOTAL 3417.4 CUBIC FEET

PINECREST AVE.
 N.E. 10TH ST. TO S.E. LAMARDALE DR.
 26-2-30 A.C.
CITY OF WICHITA, KANSAS
 B.E. SMITH
 Nov. 1953
 CITY ENGINEER
 P.E. No. 012-54


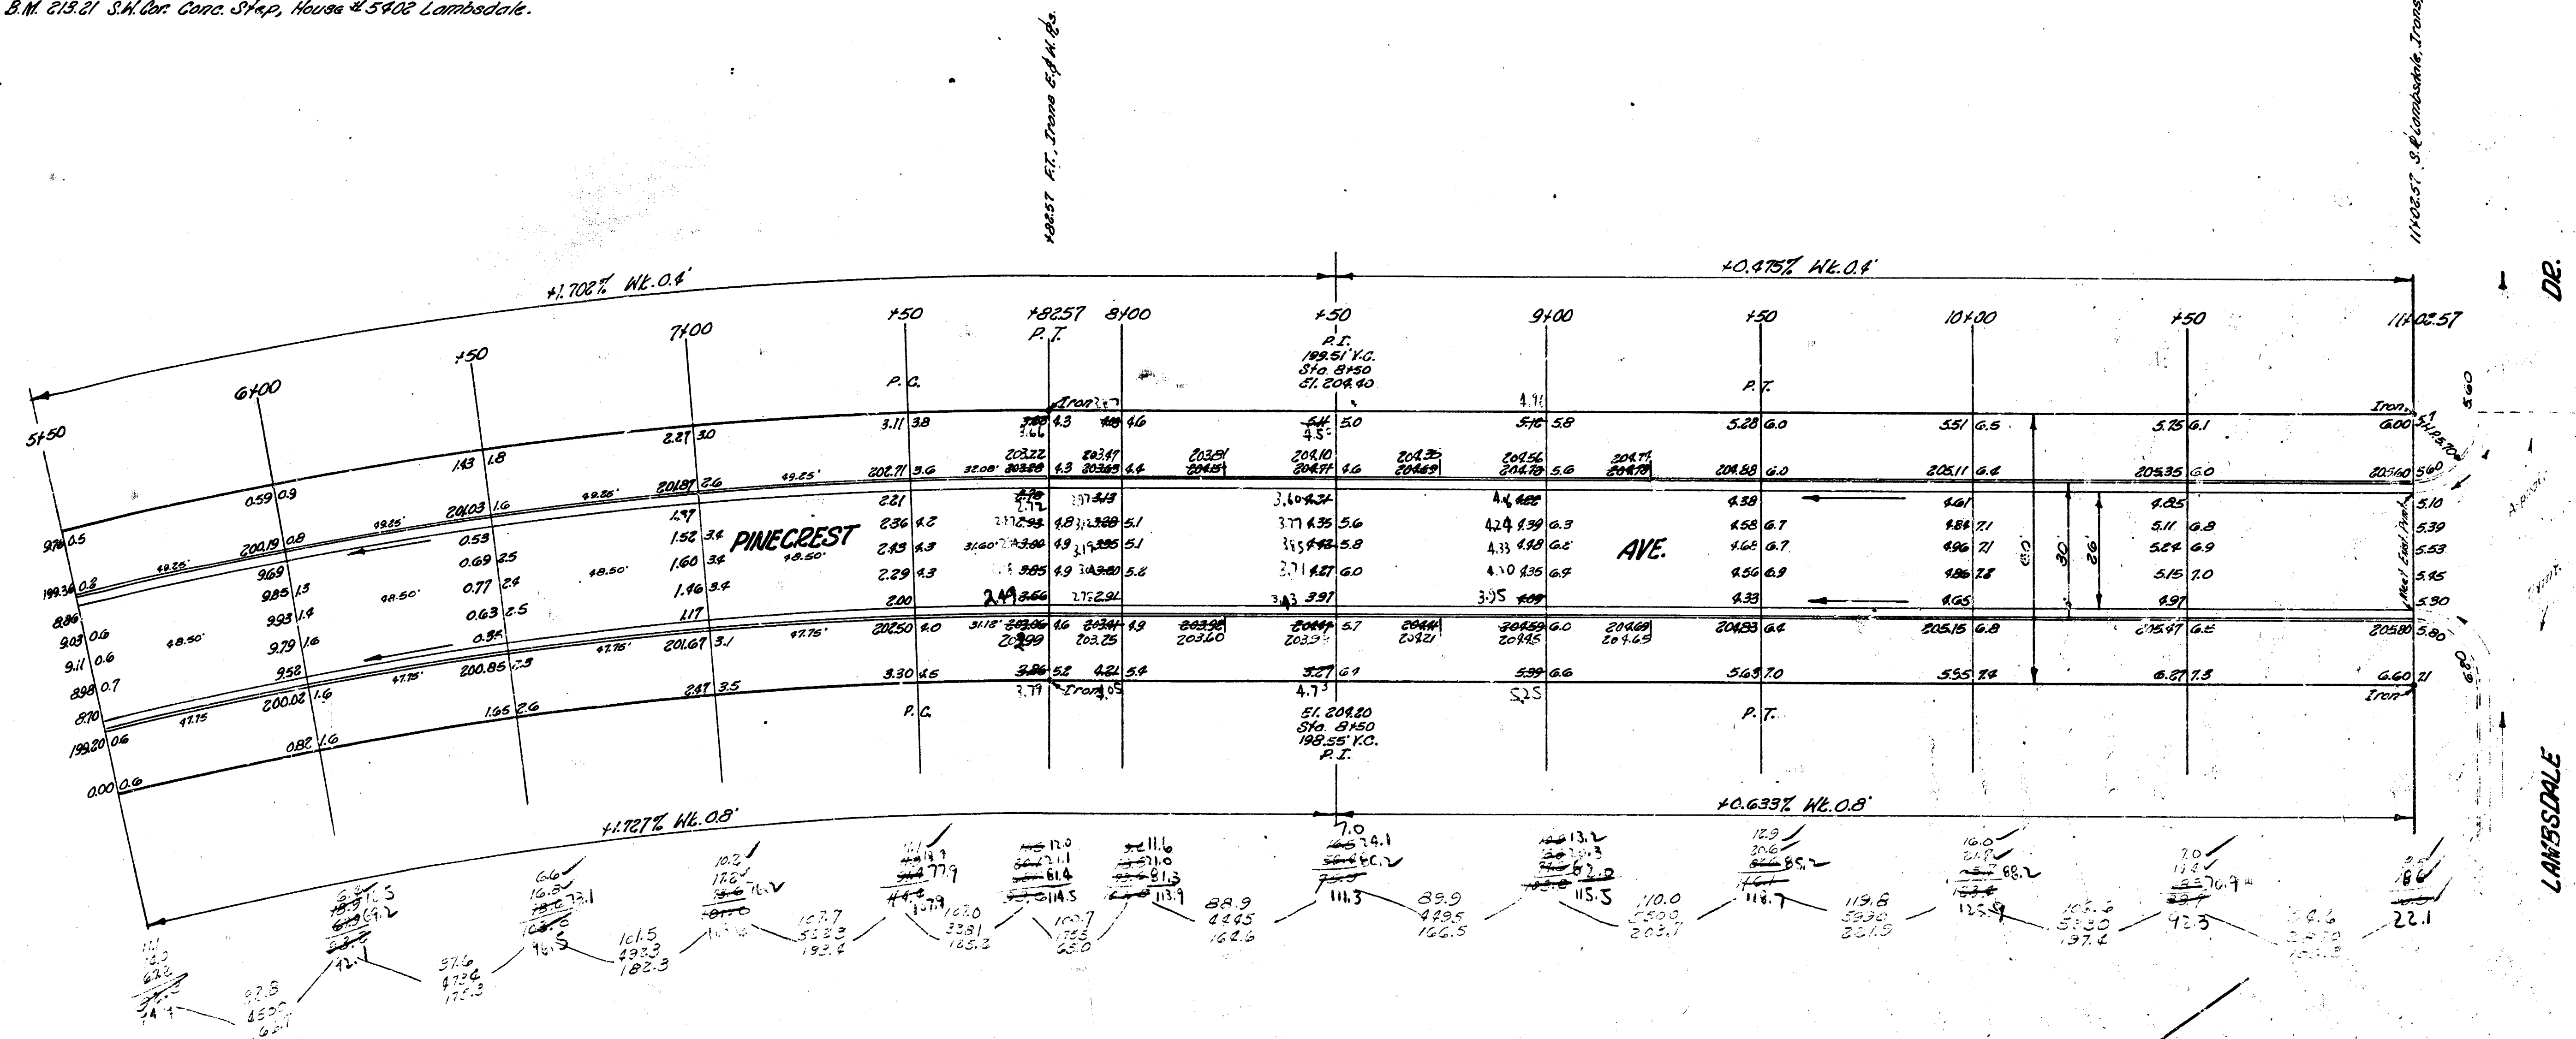

PINECREST AVE.

8/16