

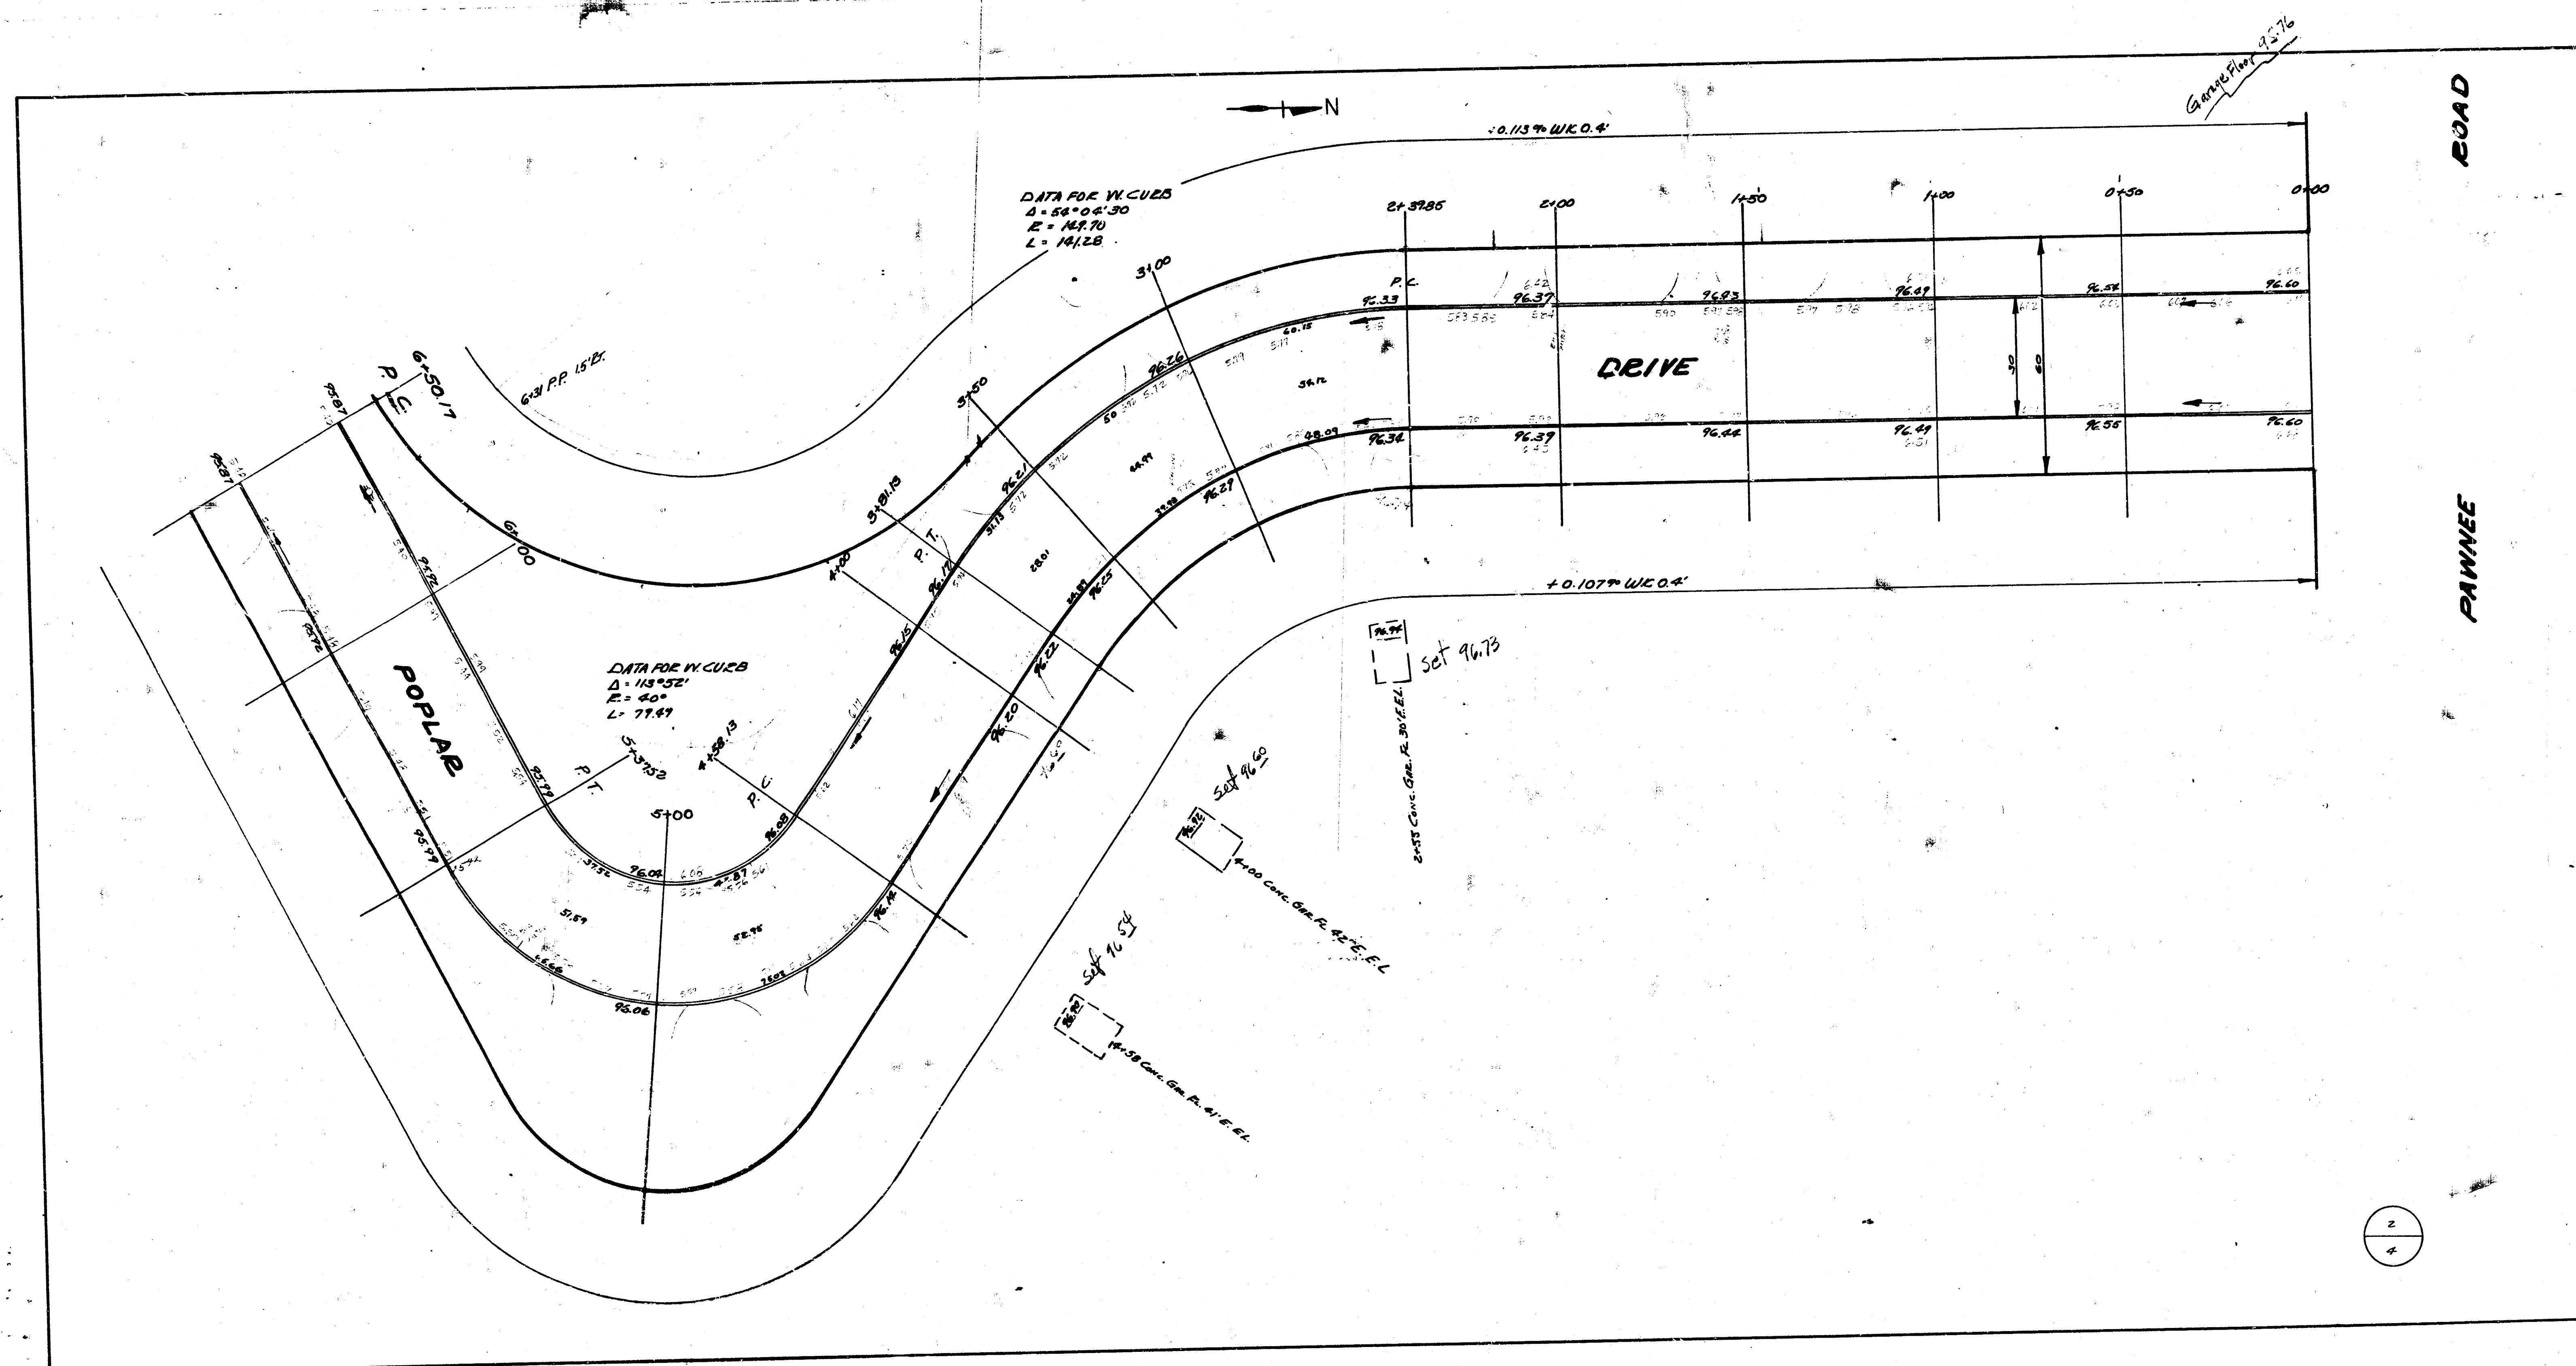


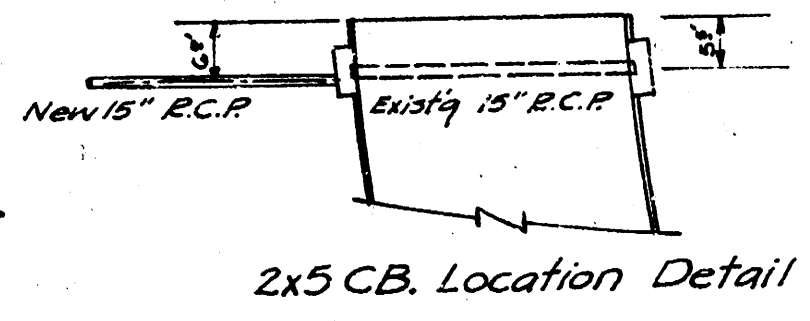

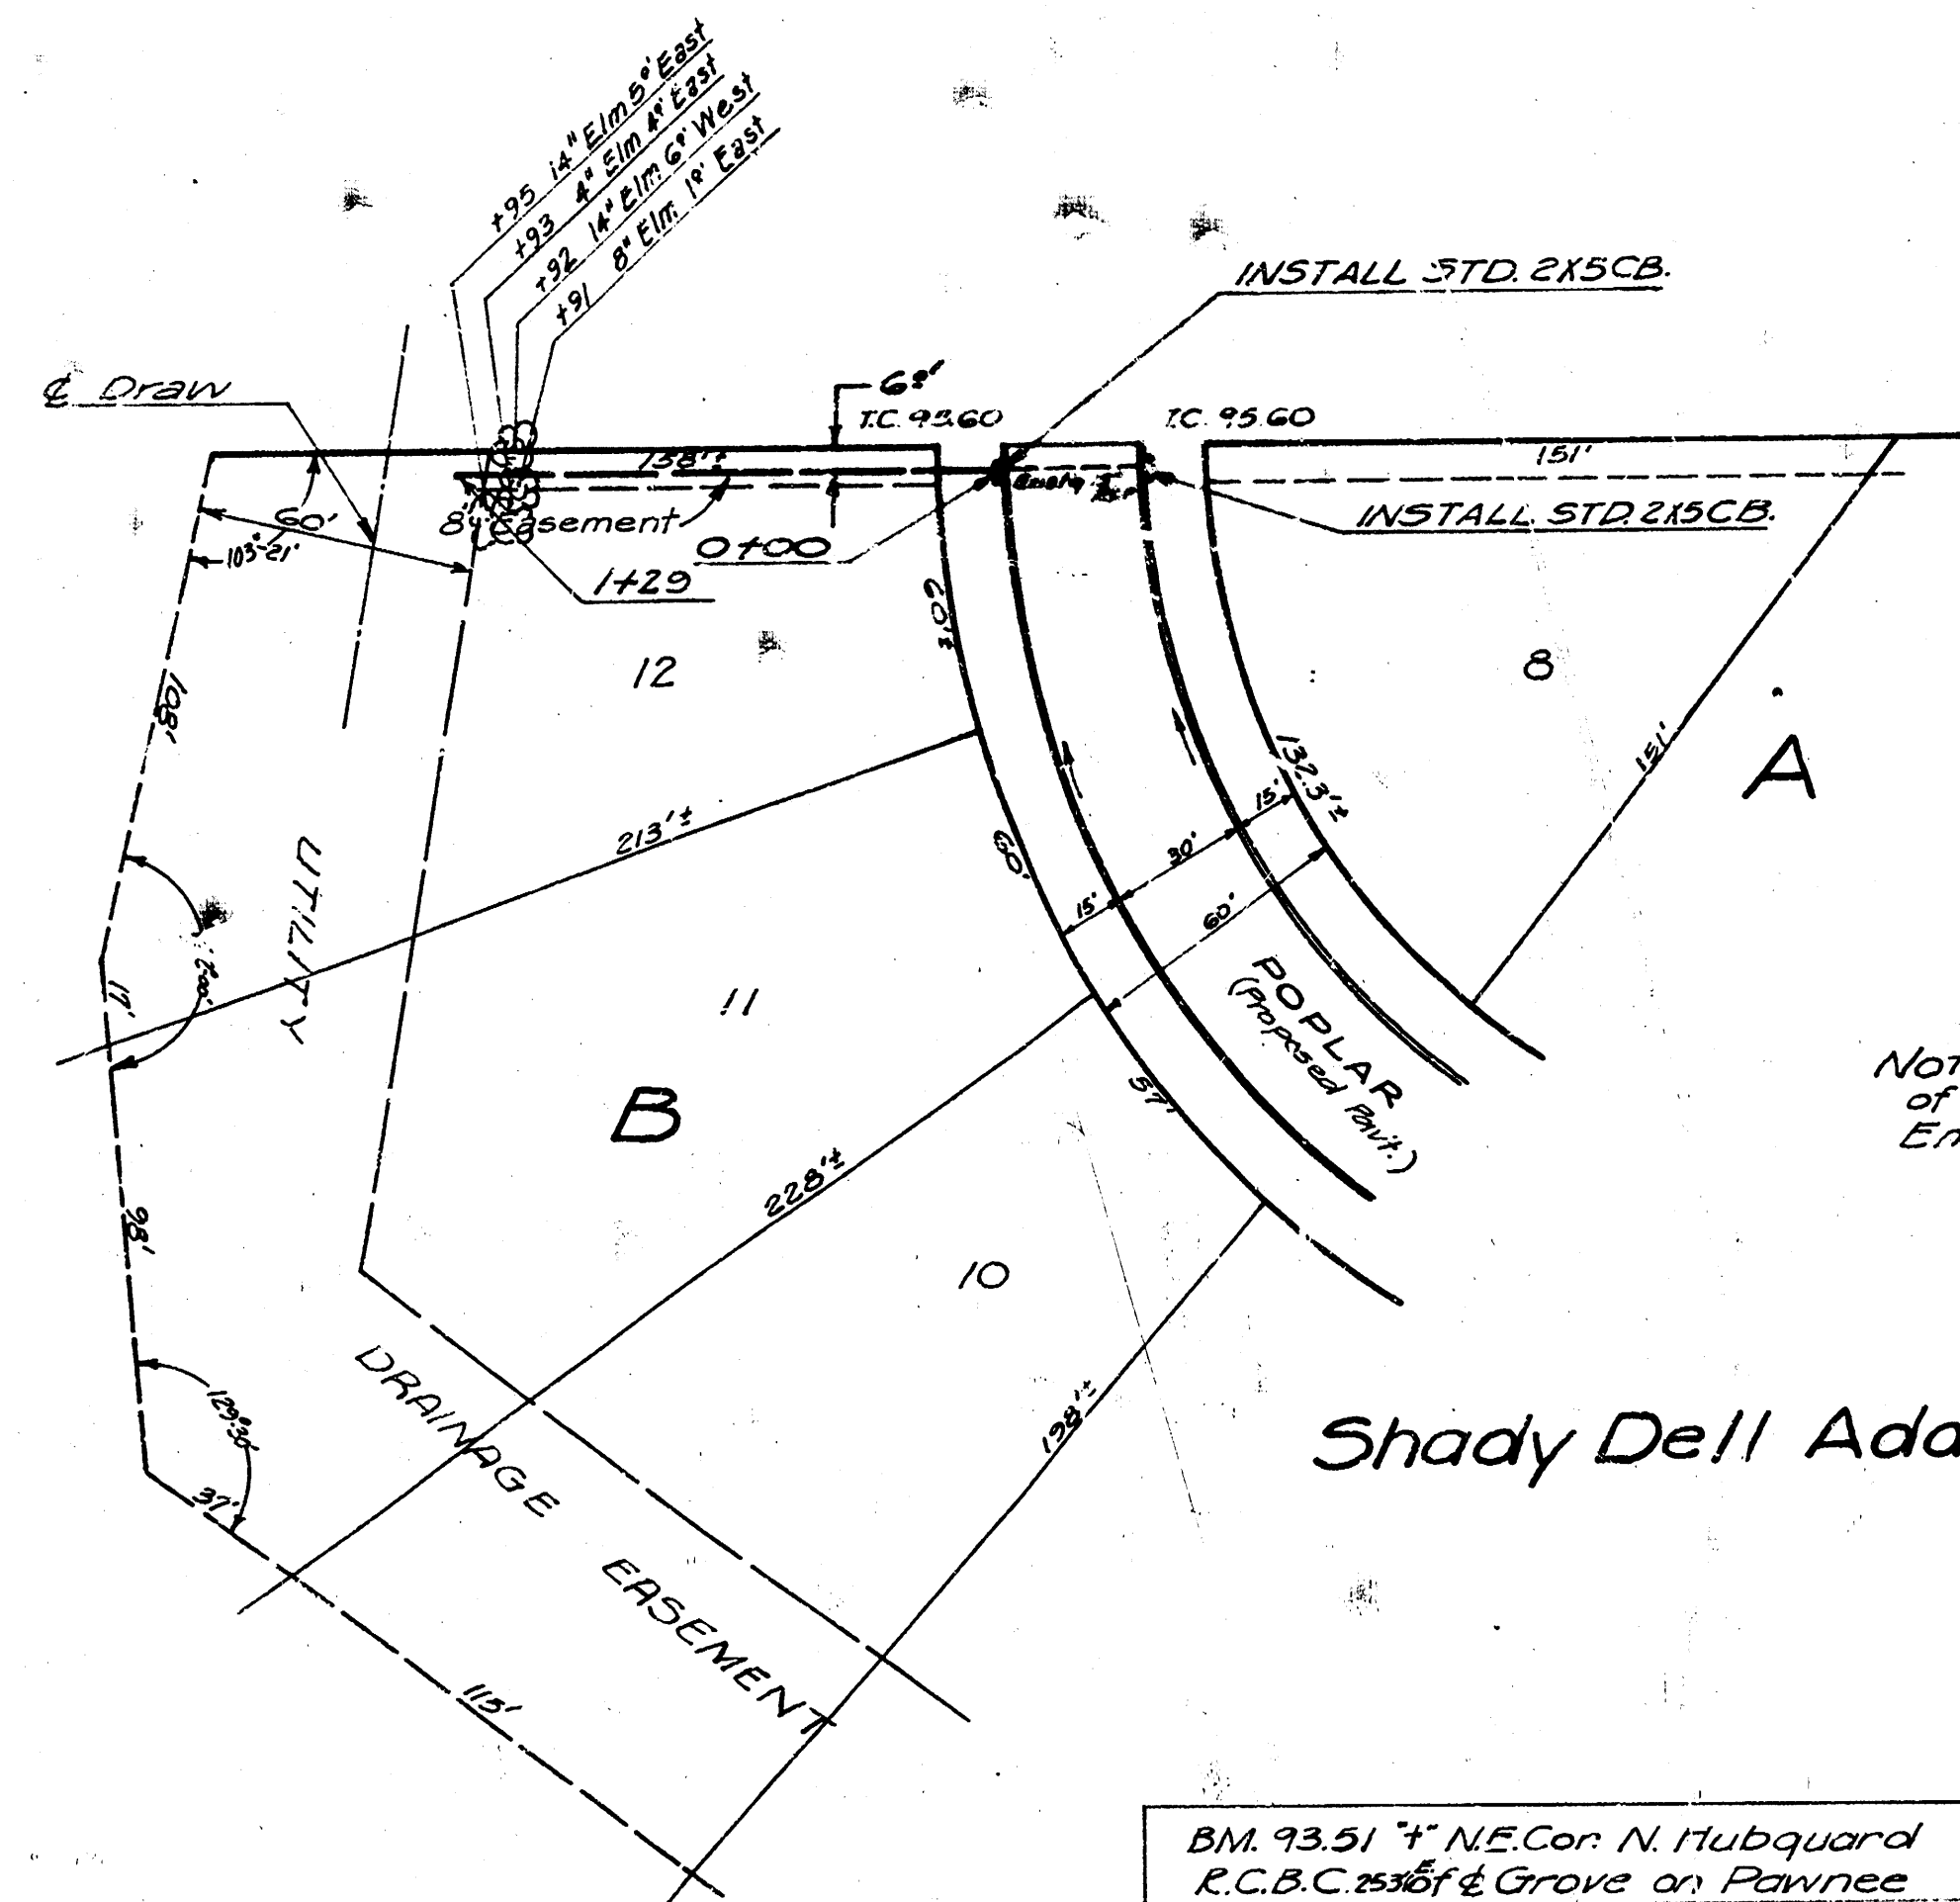


SCALE - 1"=40 ft.

Note: The last 4 Joints of 15" R.C.P. to be Concrete Encased.

Shady Dell Addn.

BM 93.51 4" NE Cor. N. Hubquard R.C.B.C. 1938 & Grove on Pawnee

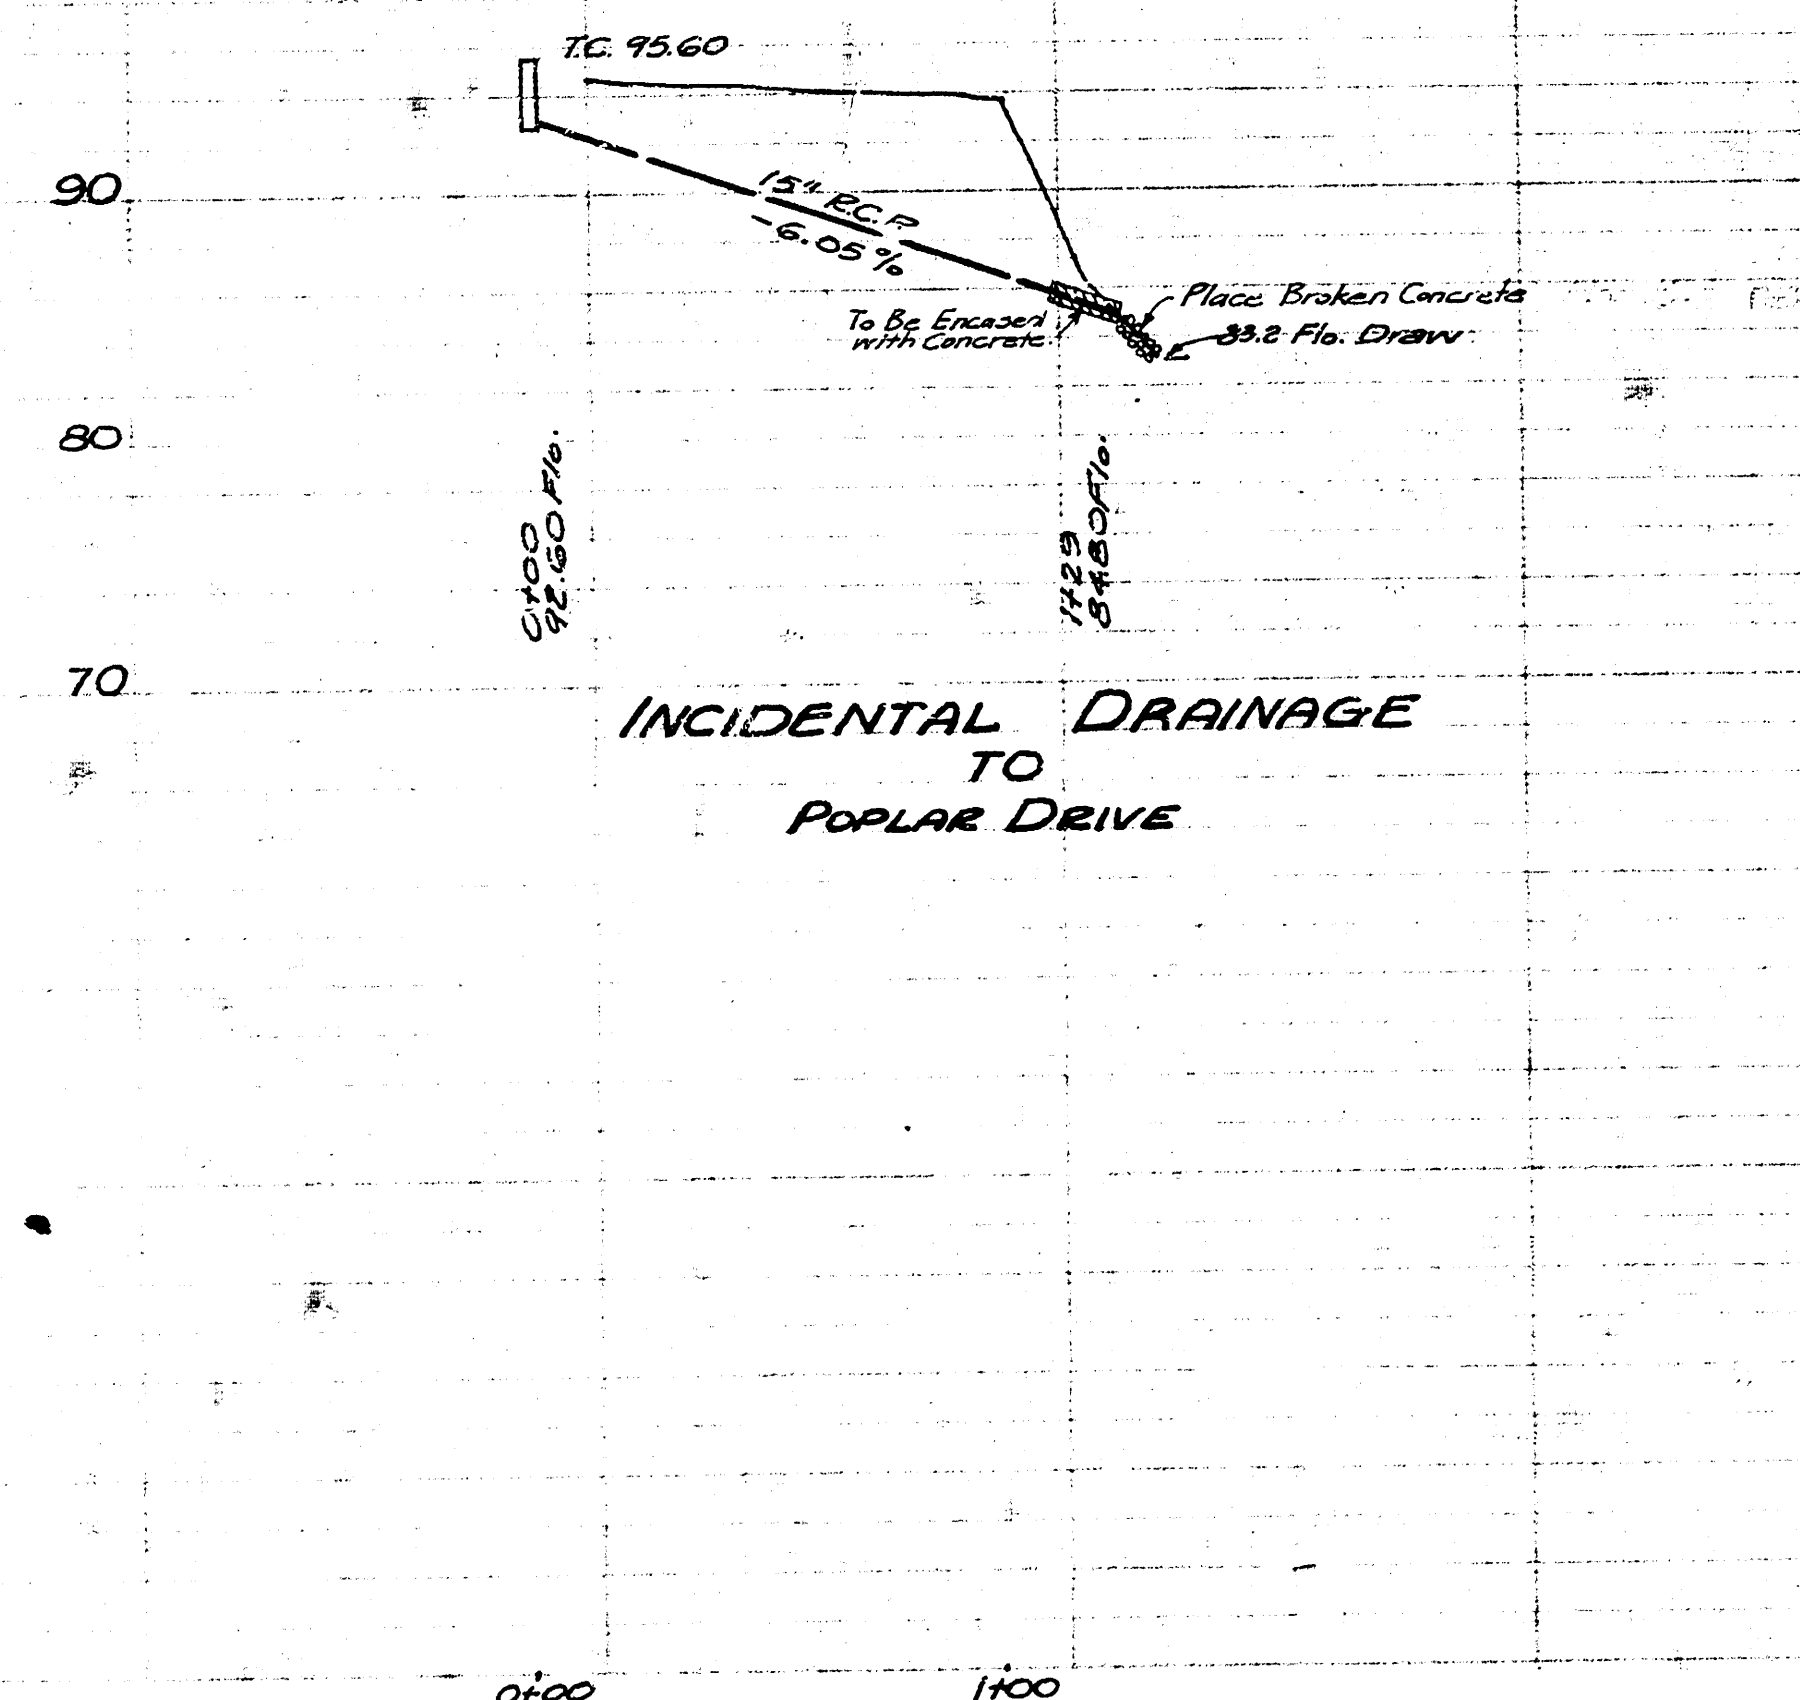

Drawn by: 10-27-95
Checked by: Sunny G. Seal
Note Book No. 624