


BM. 1632 S.W. COR. CONC. STEP HOUSE # 2220 S. GREEN
 BM. 9796 S.E. COR. CONC. PORCH HOUSE # 2205 S. POPLAR

NOTE:
 CHAINED ON W.P.L.

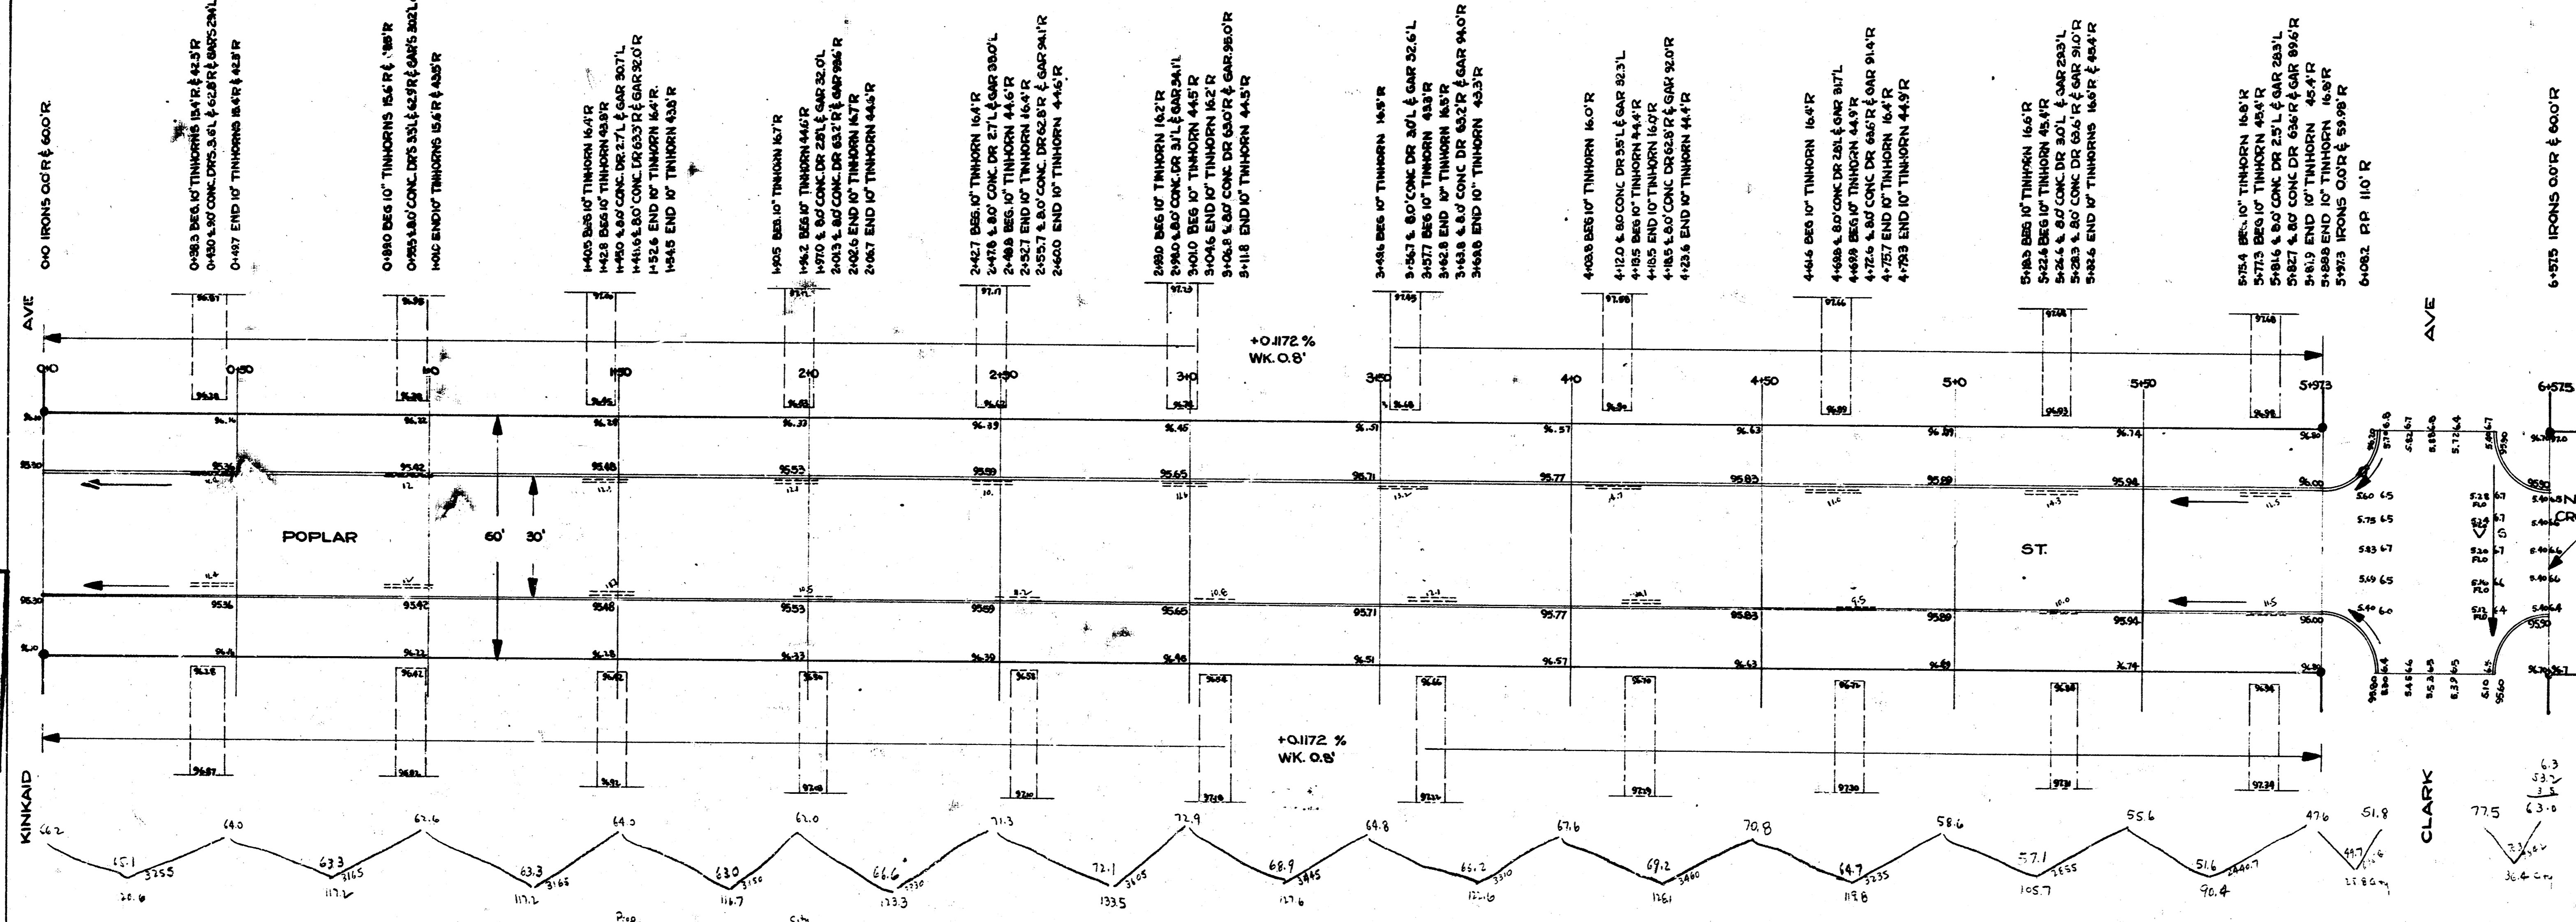

City Engineer
 Plan 3-D
 Checked
 D.L.

NOTE TO CONTRACTOR & FIELD ENGINEER:
 PLACE ENTRANCE PIPE ON OWNERS PROPERTY.
 THE CITY DEPT. WILL REMOVE THIS PIPE
 ON REQUEST OF THE PROPERTY OWNER.

SCALE 1" = 20'



POPLAR ST.
 N.L. KINKAID TO N.L. CLARK
 30' CONC. & CB.
 CITY OF WICHITA, KANSAS
 E. SMITH
 CITY ENGINEER
 MAY 1953
 PROJ. NO. C-15-9

1/2