



NOTE: STAKES TO BE SET BY THIS ELEVATION ONLY!
 B.M. 162.66 "M" in Mueller F. Hyd. NW Cor. Lightner & Morris

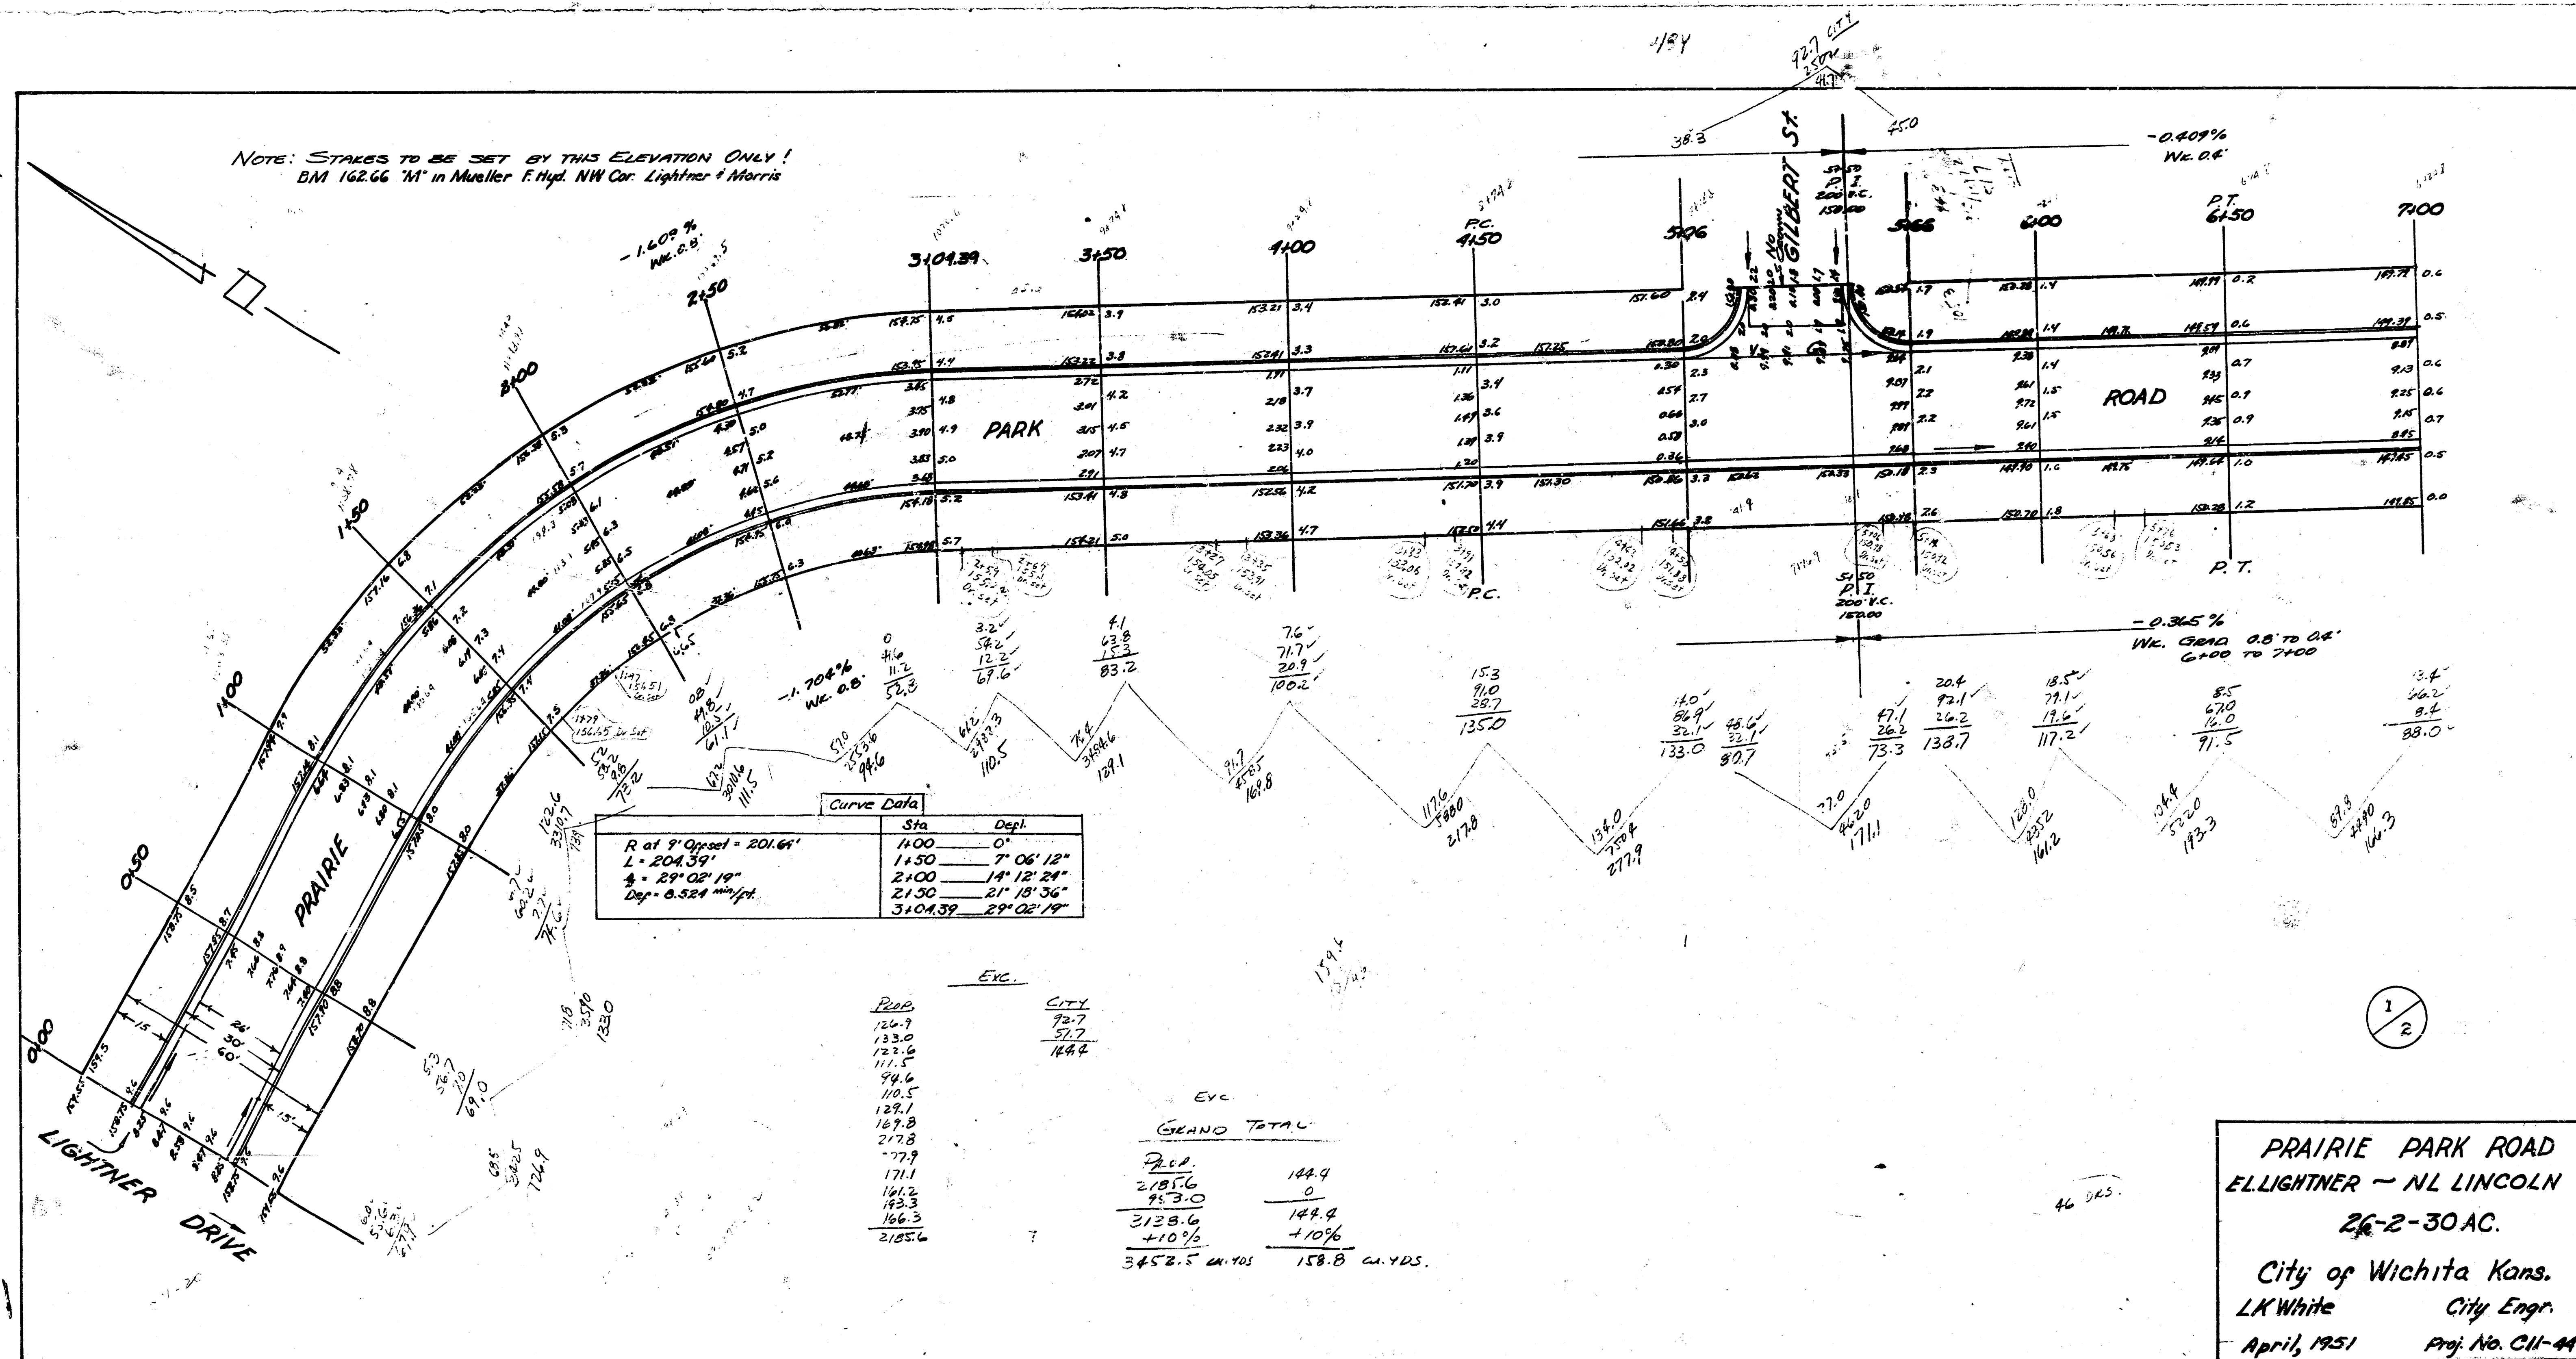

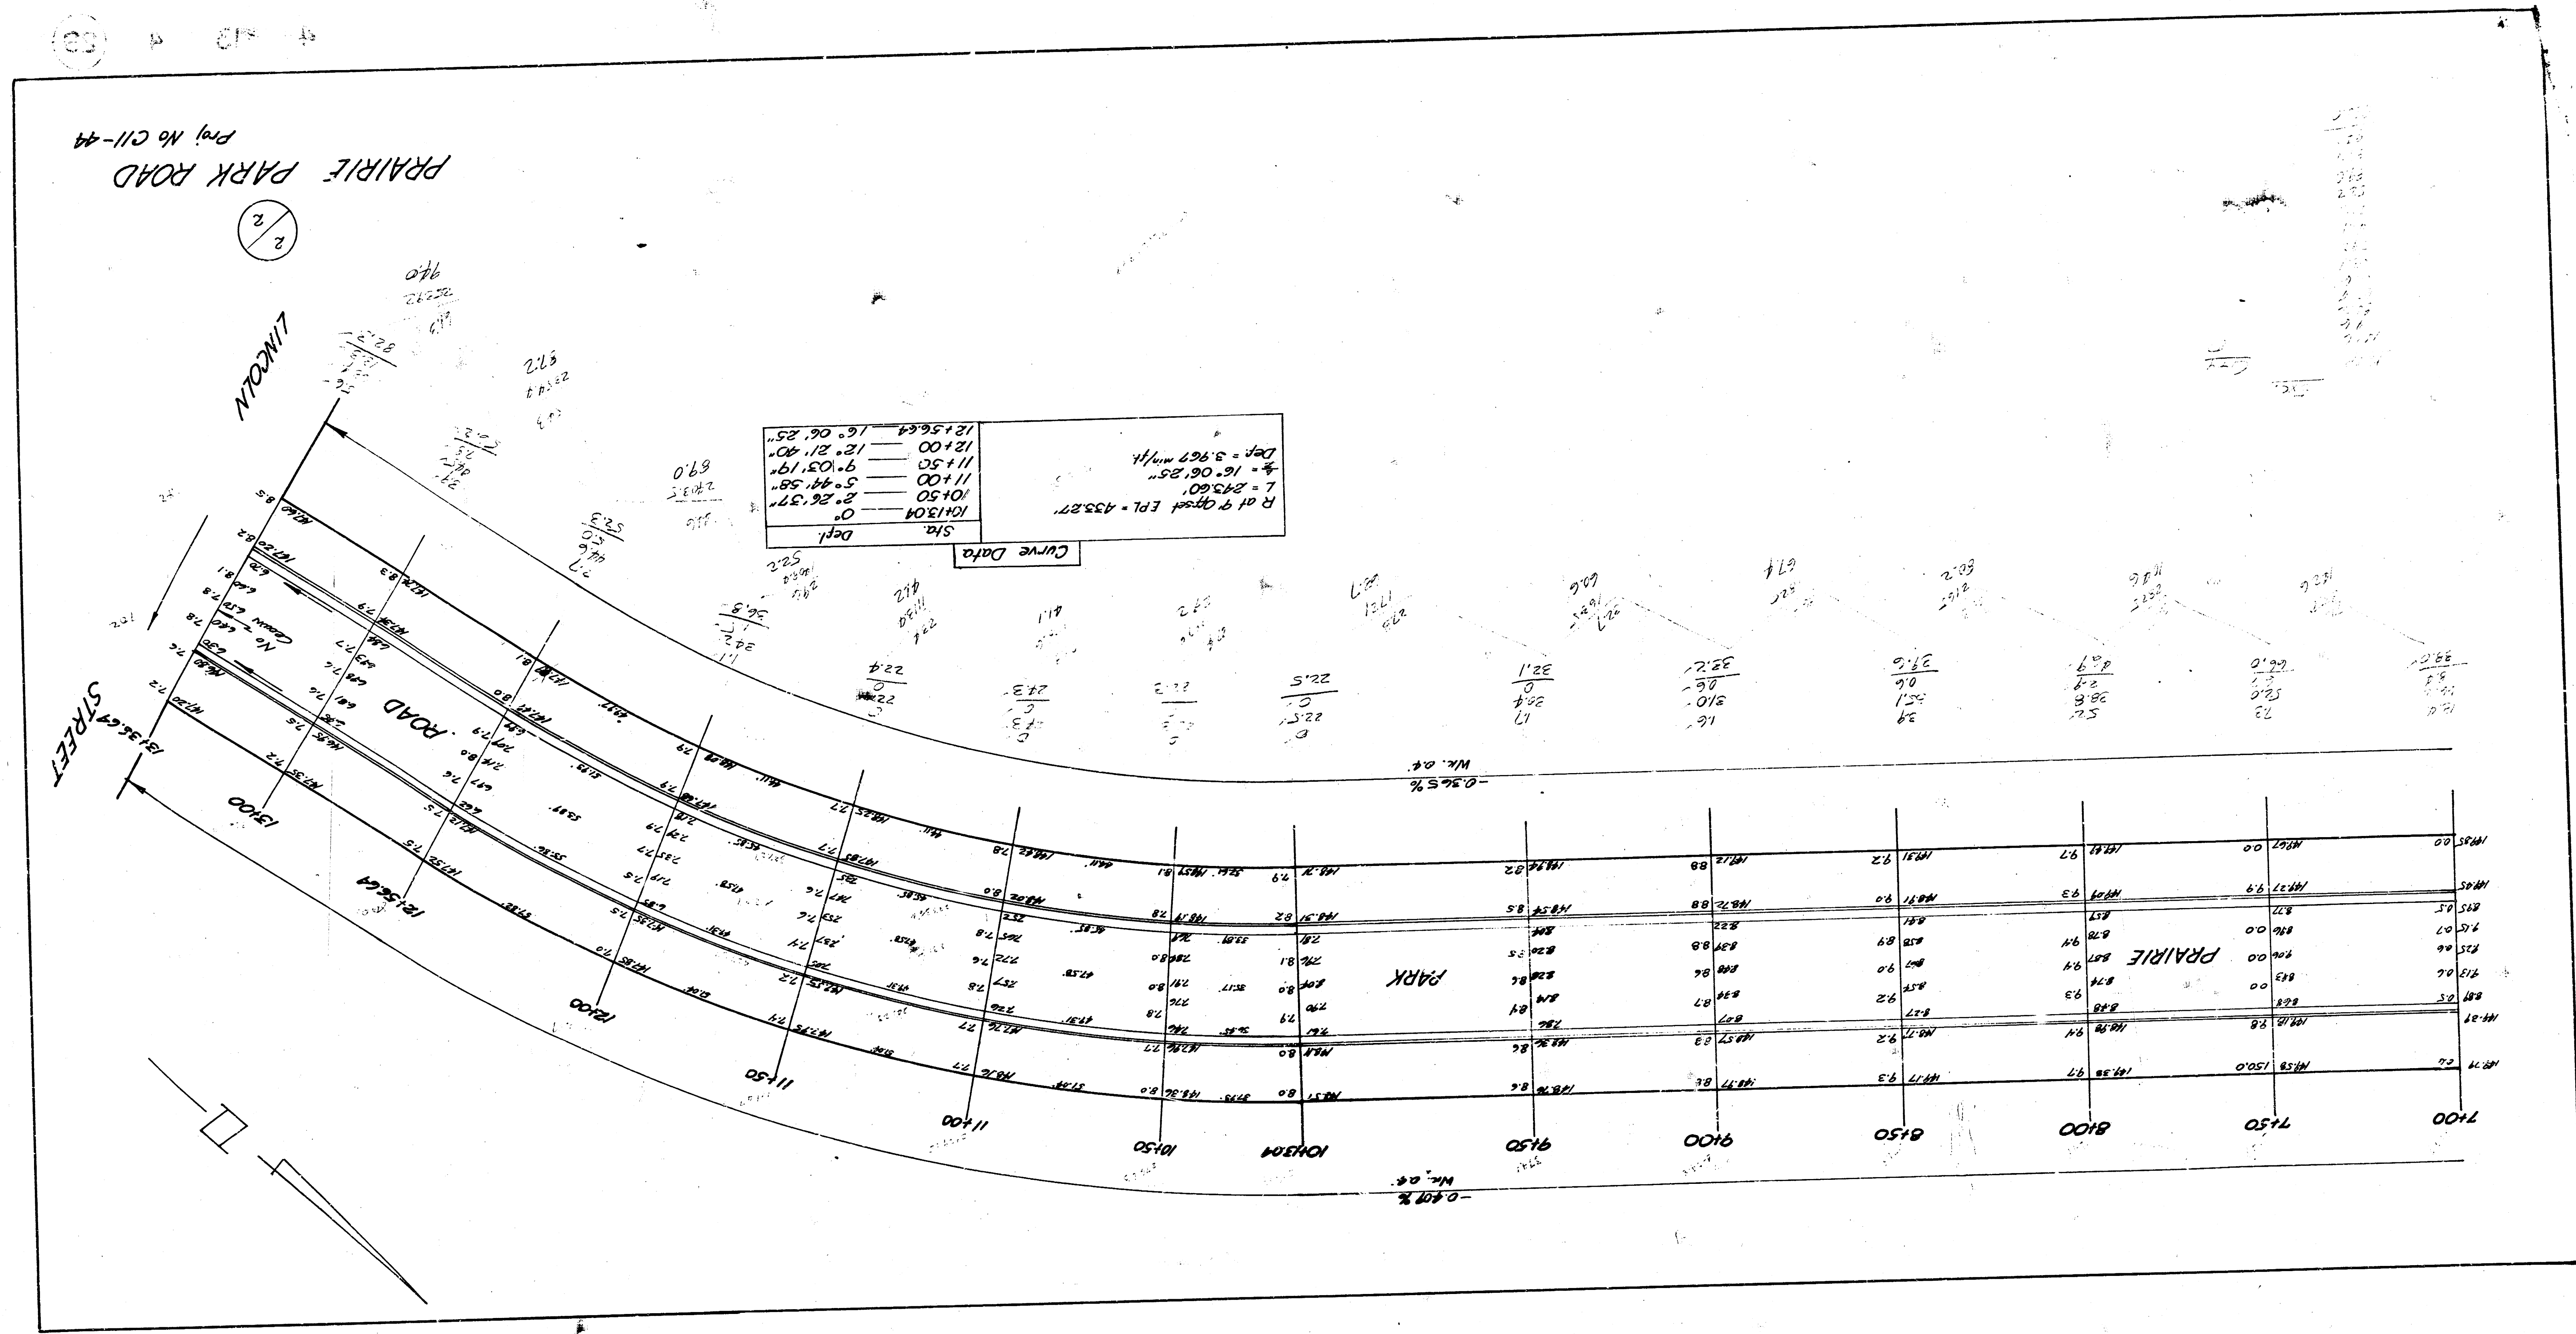

PRAIRIE PARK ROAD
Proj No C11-44

2

184