B.M. 145.94 "M" in Mueller on Fire Hyd. Grand & Waverly

Sta. on WR

Prop	Prop
133.7	137.6
64.3	65.9
24.9	25.6
18.7	17.6
34.5	35.3
43.1	44.2
54.6	59.2
100.7	103.3
130.6	132.7
160.8	162.4
79.9	71.7
85.8	841.0 cu. yds
1,269.1	
889.6	

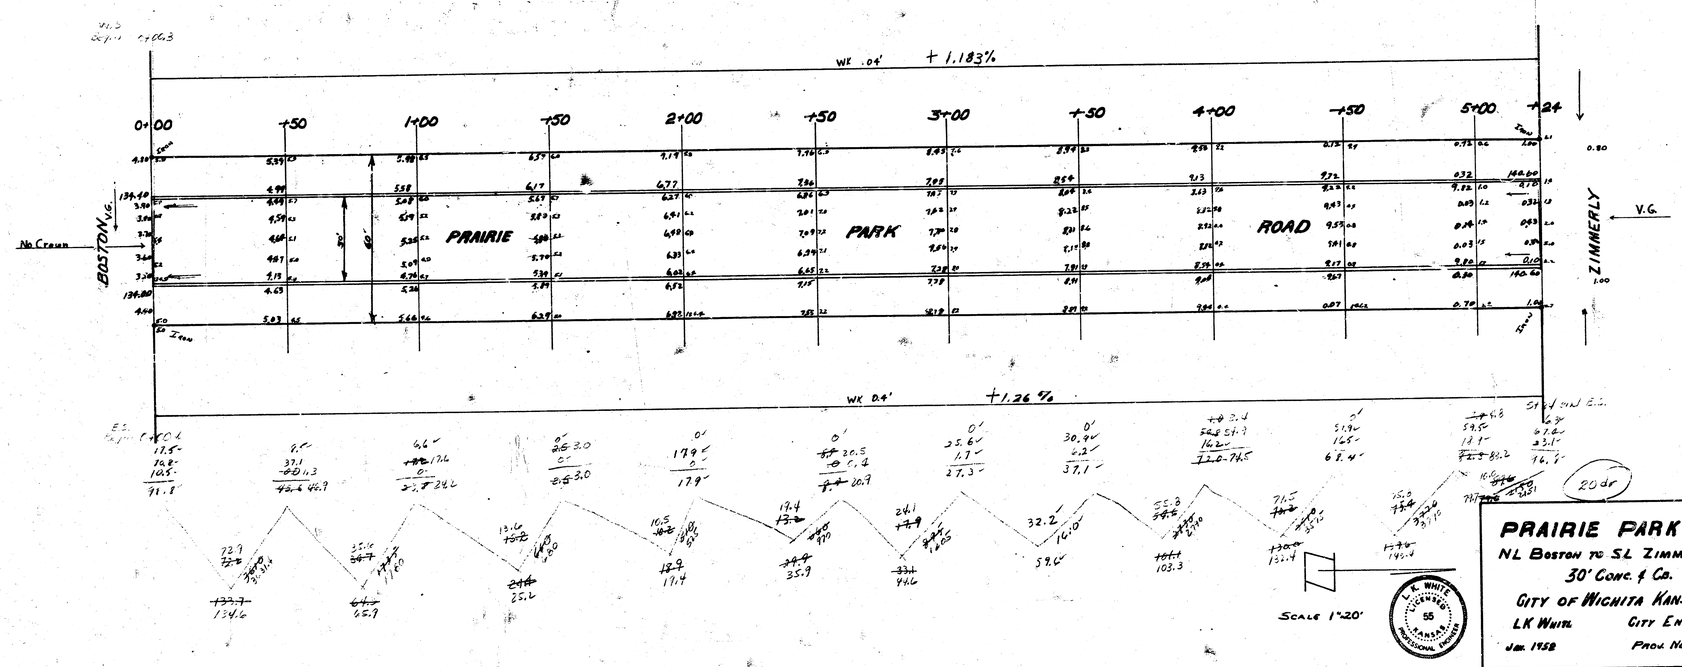

Survey GY 60Y
Plant Mix 3.5 1.14.52
Excavation 73.5 1.14.52

PRAIRIE PARK RD.
NL BOSTON TO SL ZIMMERLY
30' CONC. & CO.
CITY OF WICHITA KANSAS
L.K. WHITE — CITY ENGINEER
JAN. 1958 — PROJ. NO. CII-275

L. K. WHITE LICENSED 55 KANSAS PROFESSIONAL ENGINEER

4 15 5 (18)