



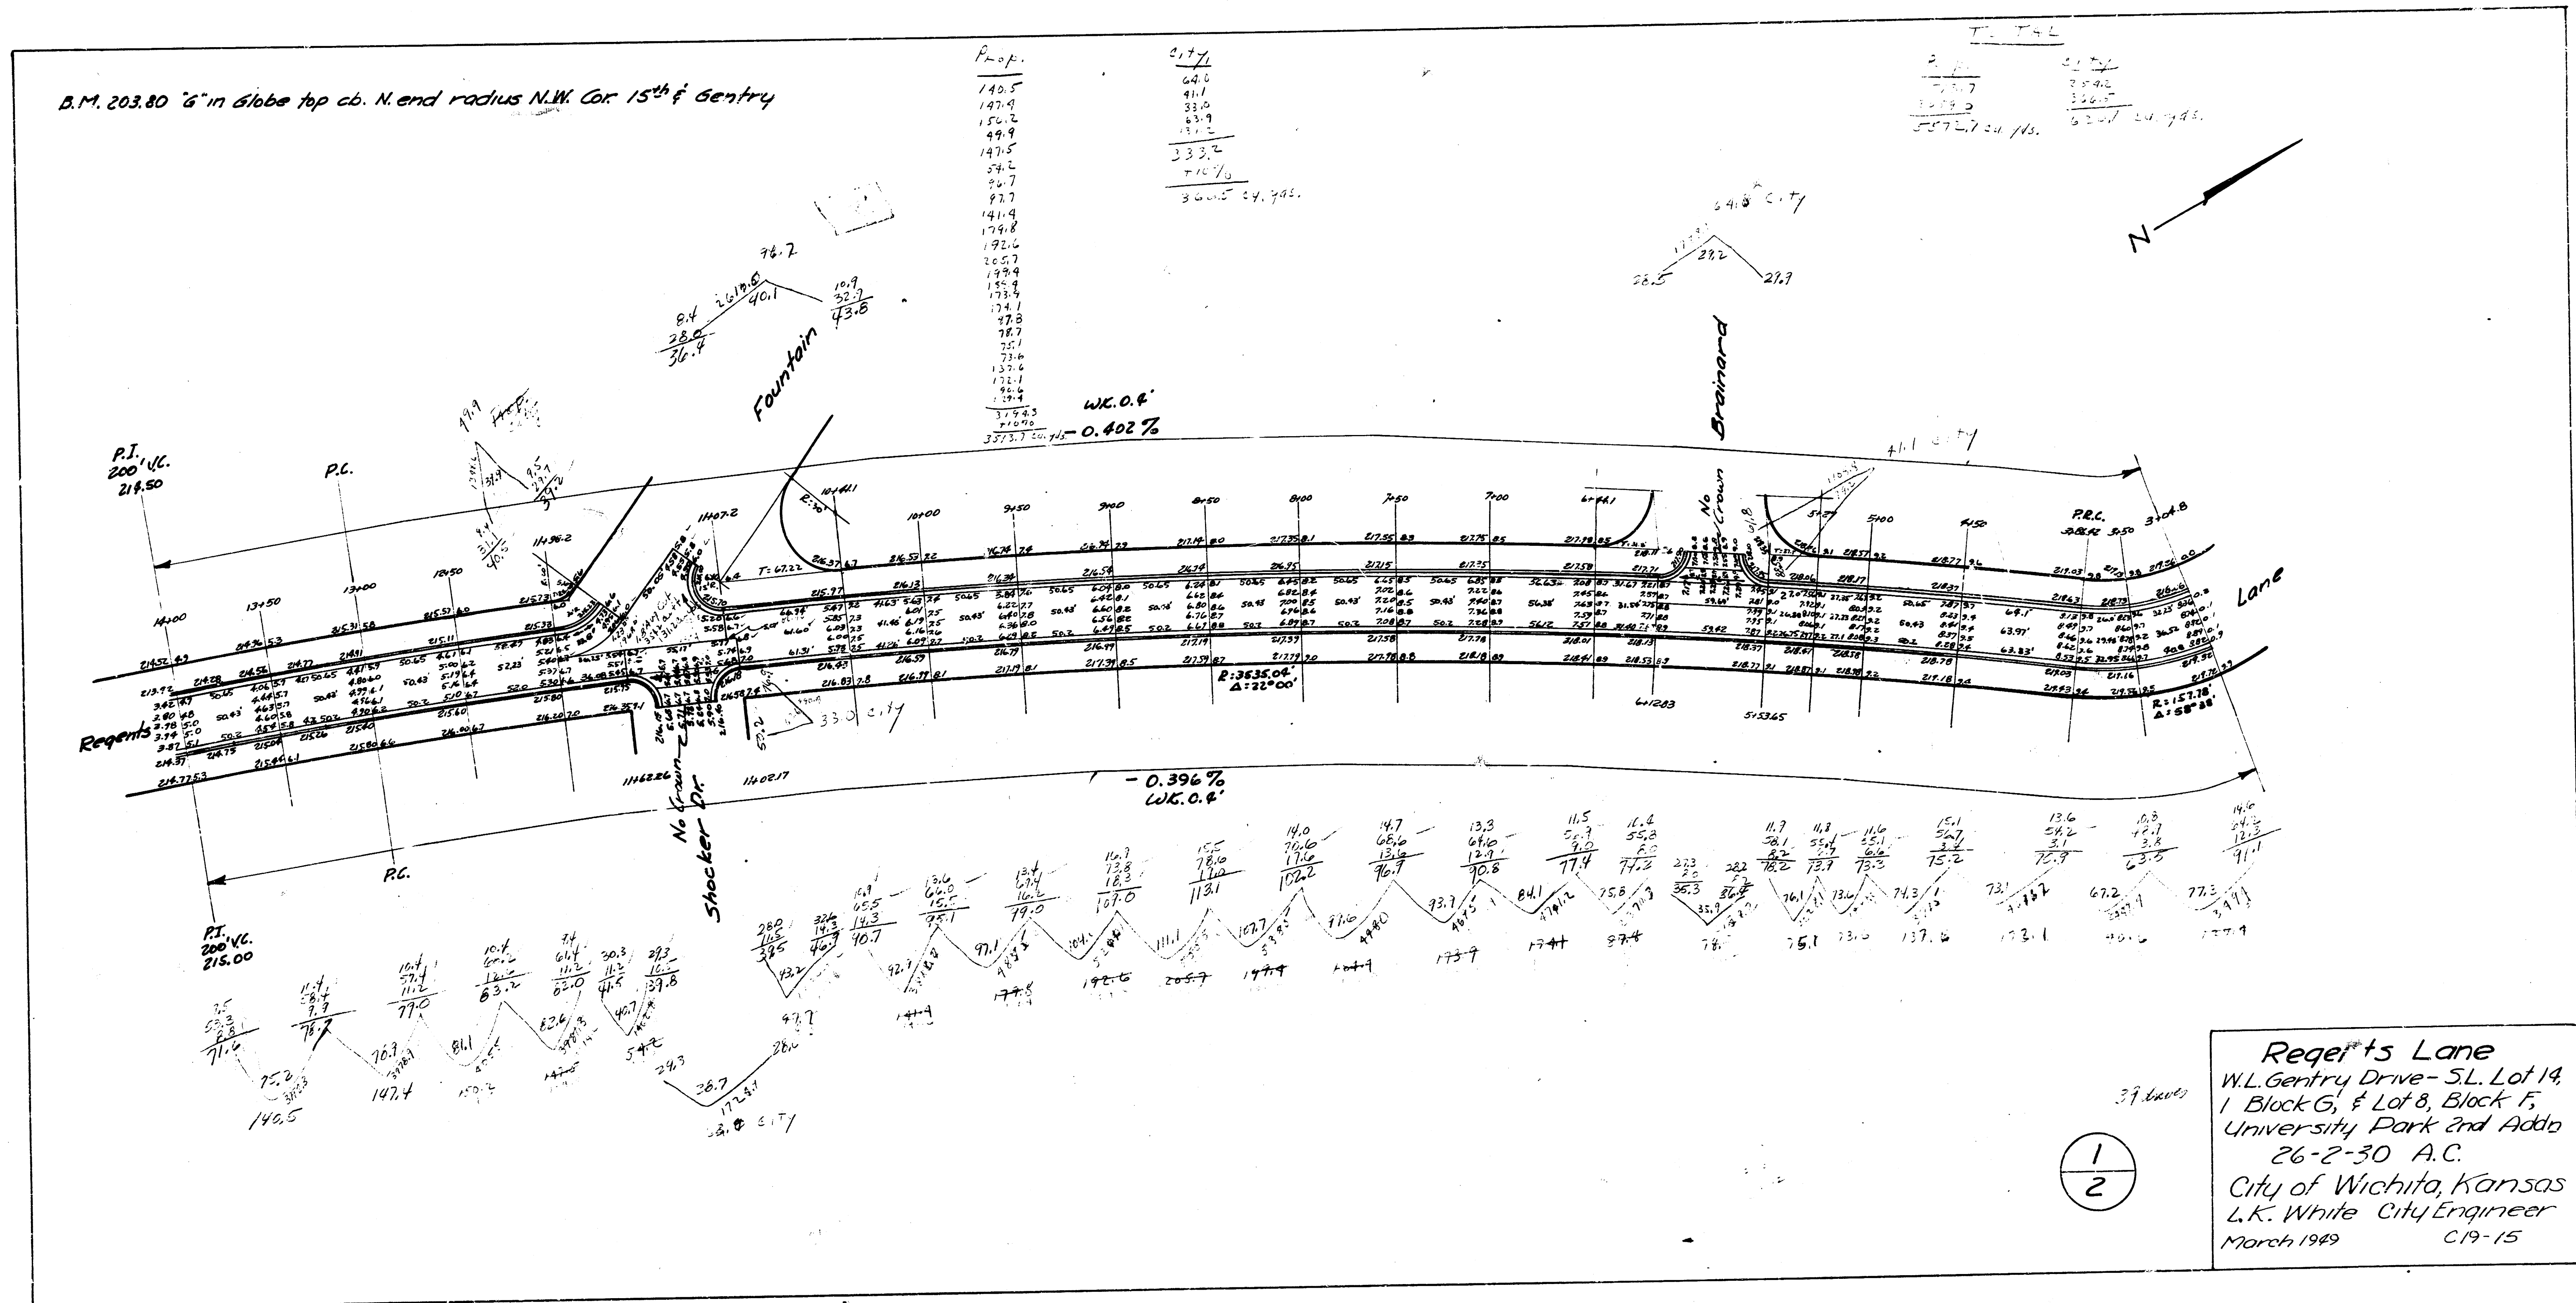

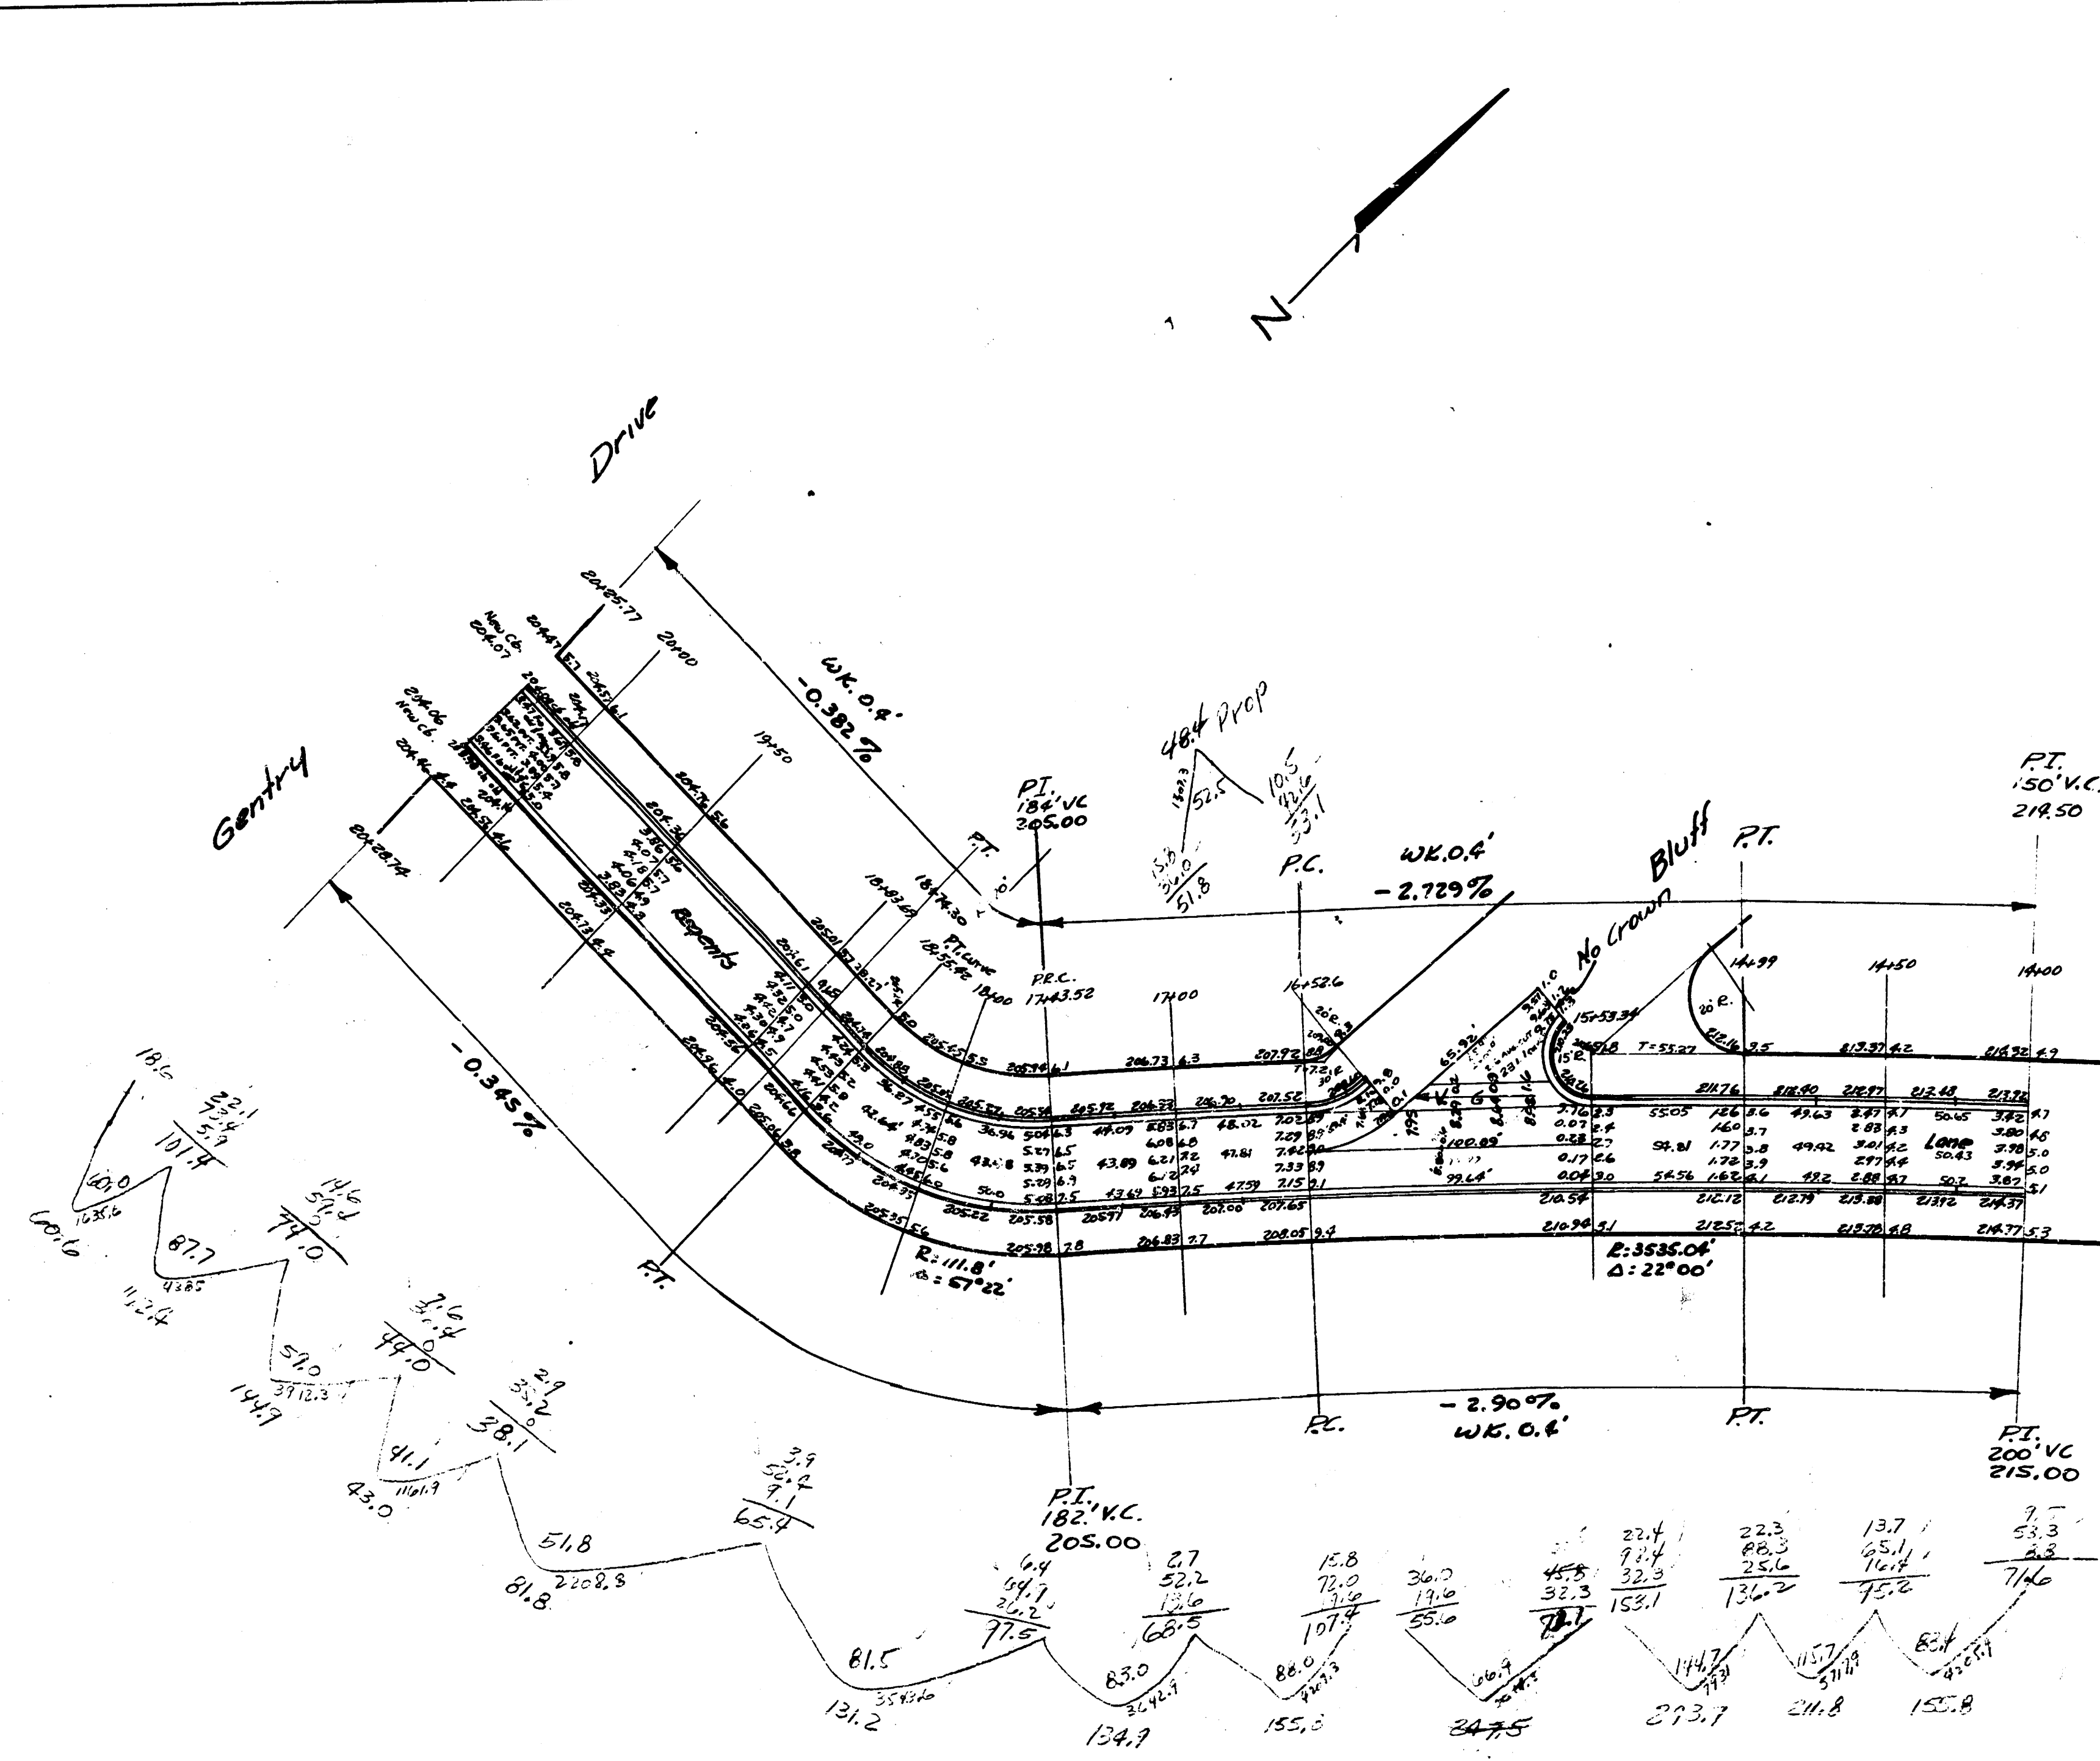

2.1	5.1
2.2	231.1
2.3	+10.76
2.4	254.2
2.5	264.96
2.6	
2.7	
2
2