


X-SECTIONS
Book 45

B.M. 172.0. South end of creek on west side of Ridge wood N.S. English?

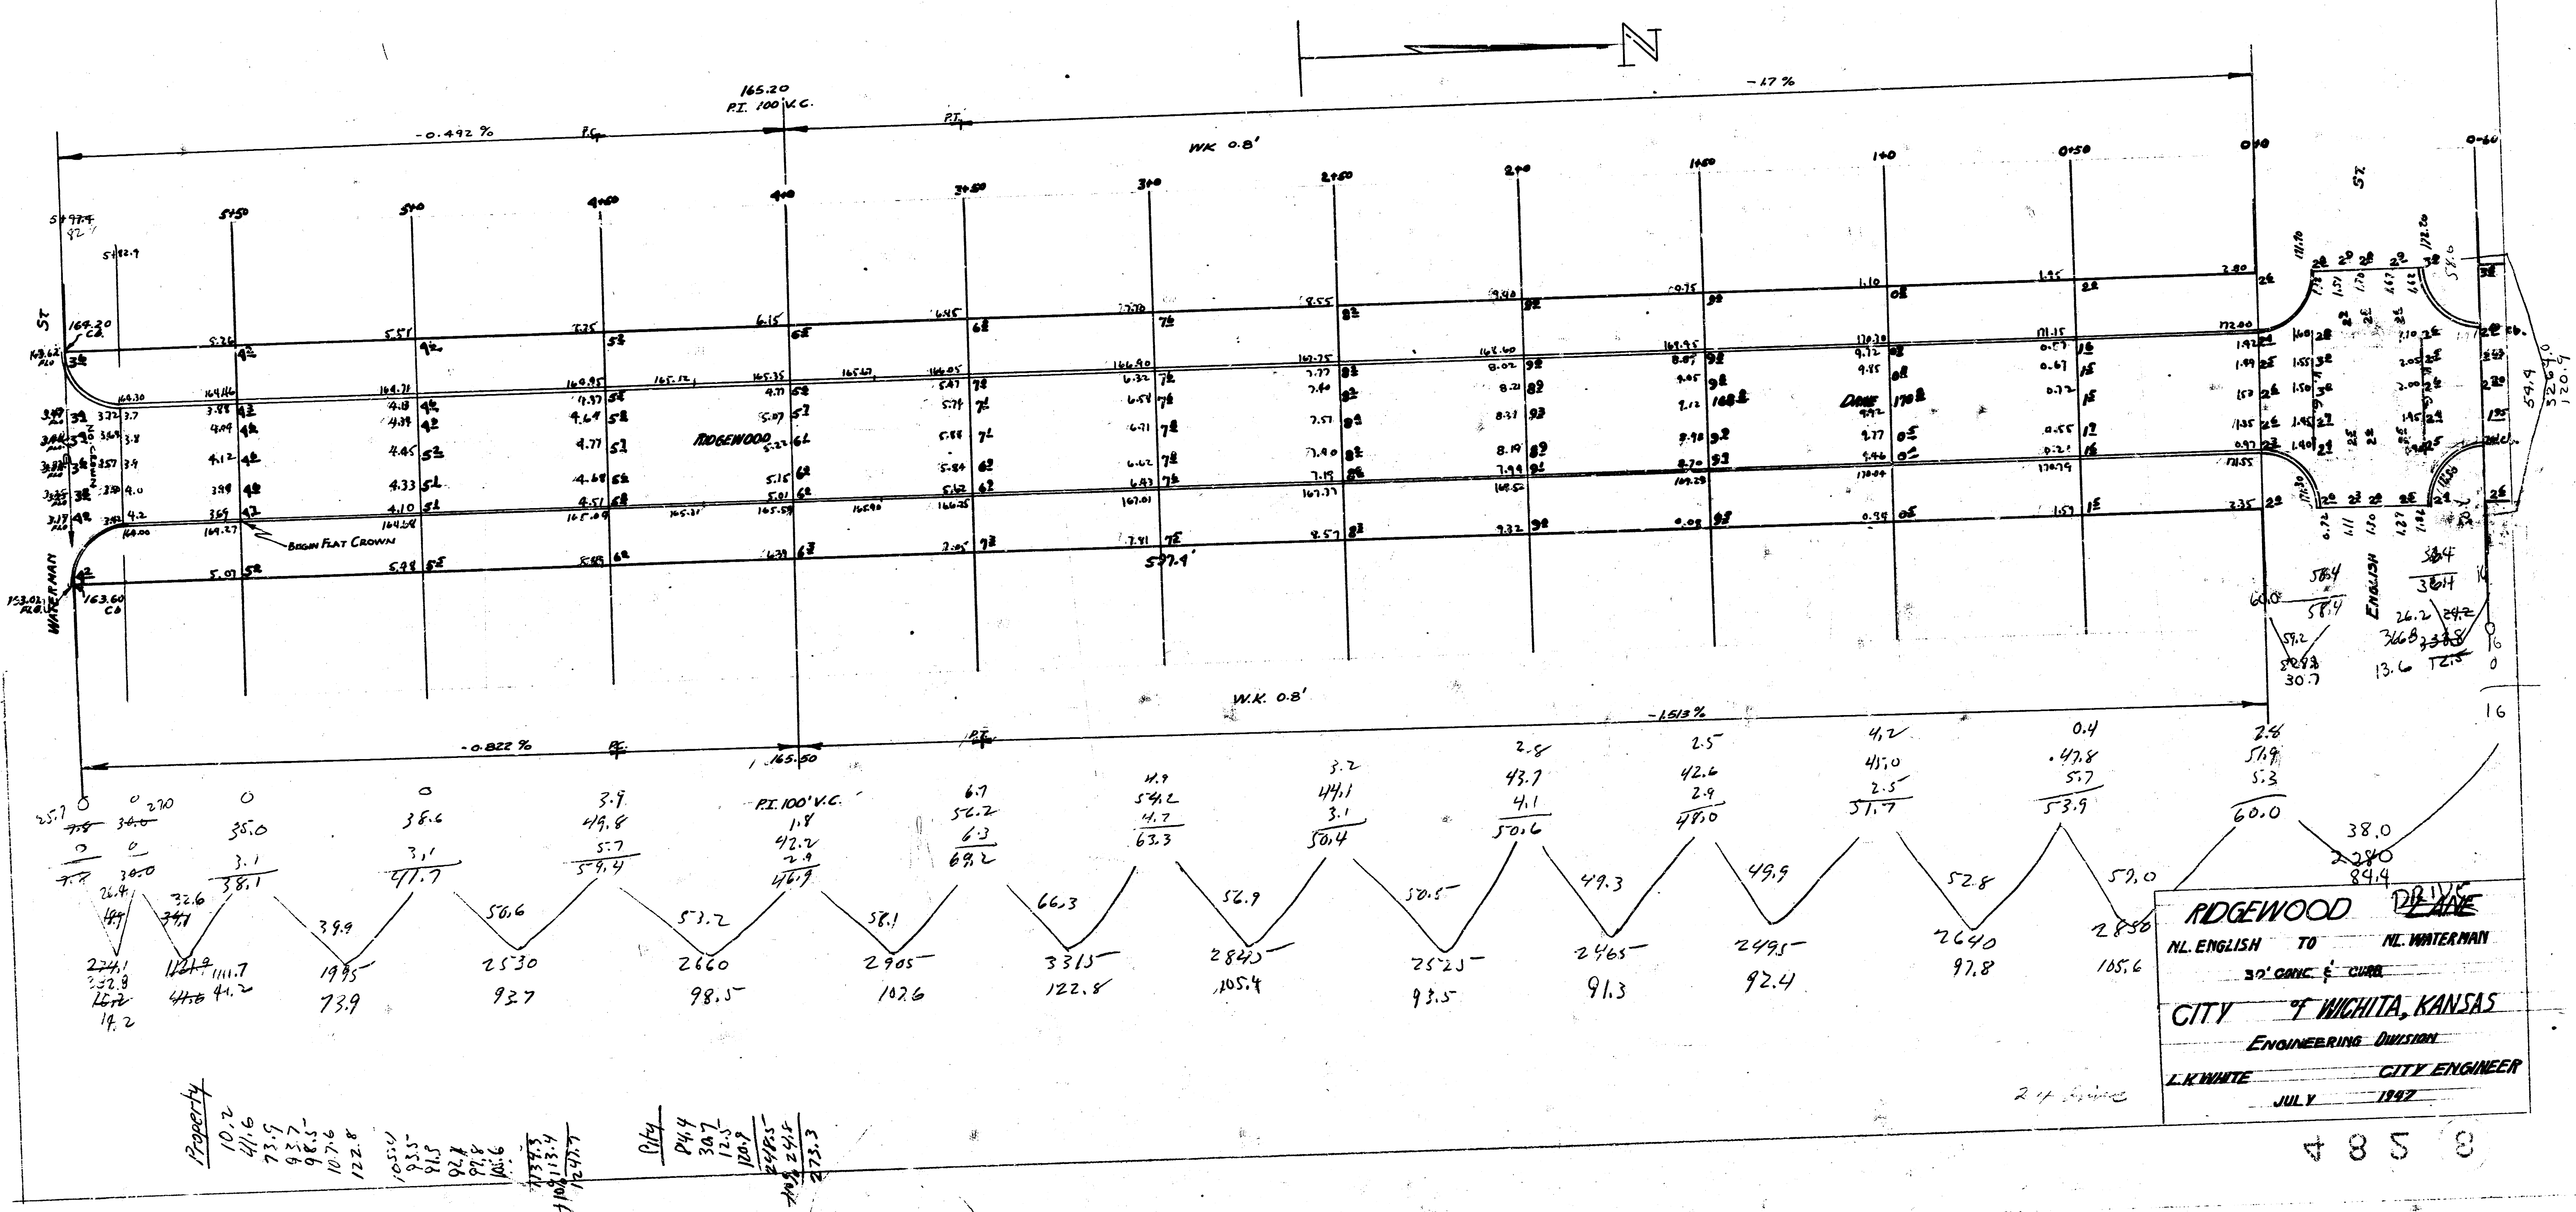

N.L. ENGLISH TO N.L. WATERMAN
30' CONC. & CURB
CITY OF WICHITA, KANSAS
ENGINEERING DIVISION
L.K. WHITE CITY ENGINEER

4858