




4-18-74

D.F.S.

Signature: D.E.S.

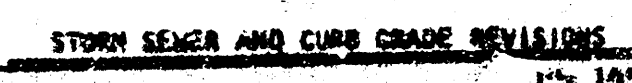

RELOCATION OF RIVERVIEW STREET NORTH
OF SECOND STREET.


