



ROCHESTER AVENUE

N.L. 14TH ST. TO S.L. 15TH ST.

PROJ. NO. C12-232

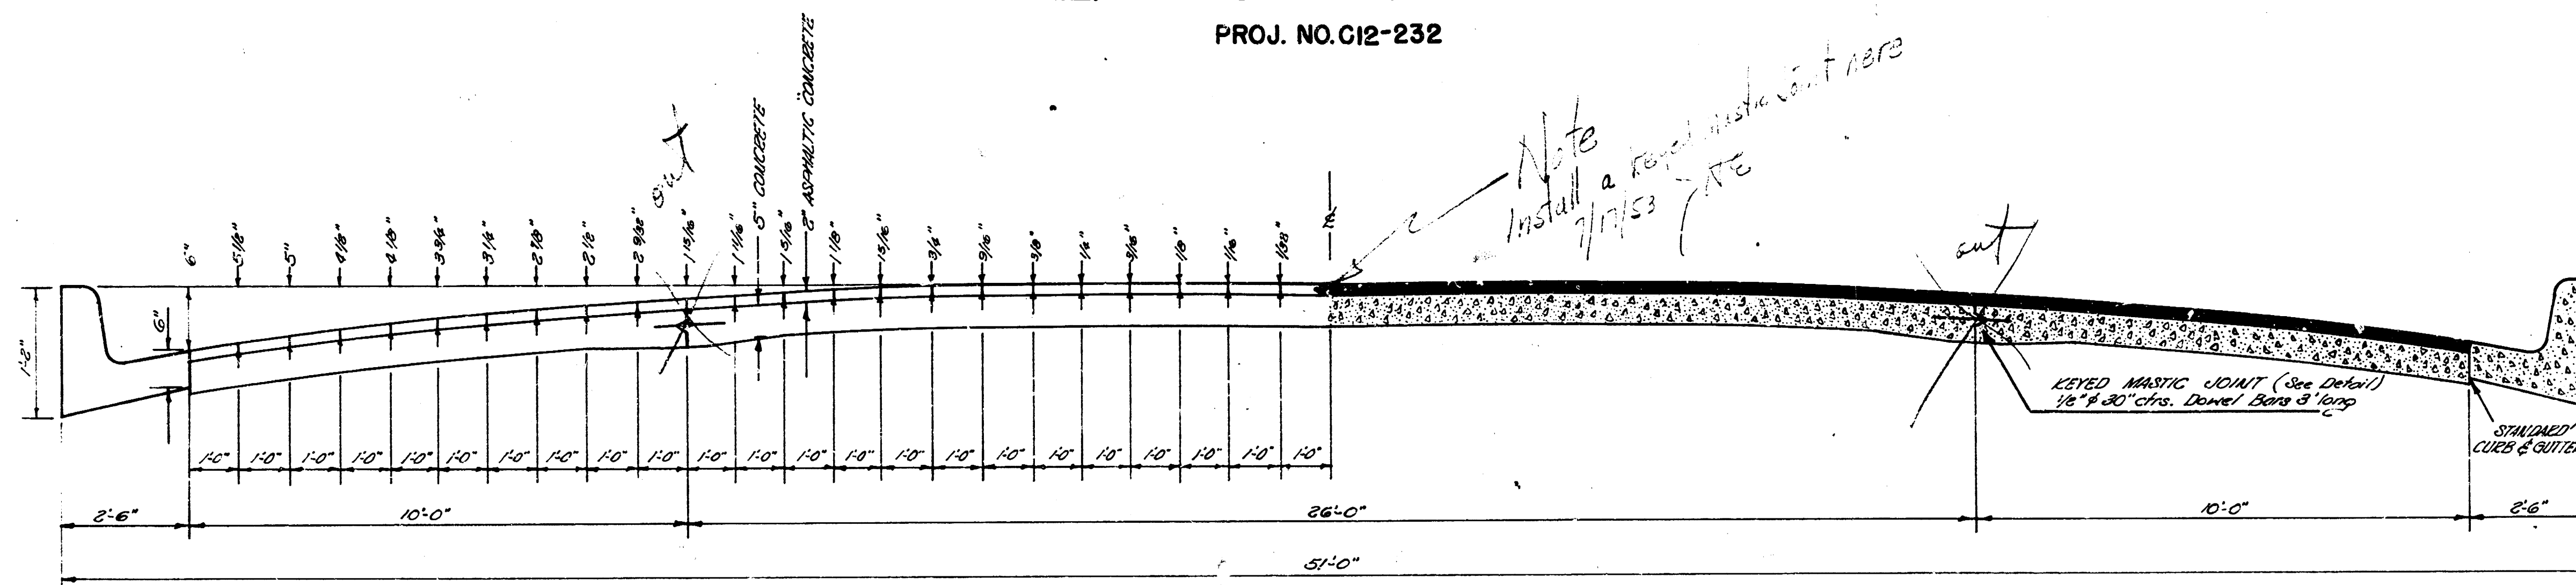


TYPICAL SECTION
NOT TO SCALE

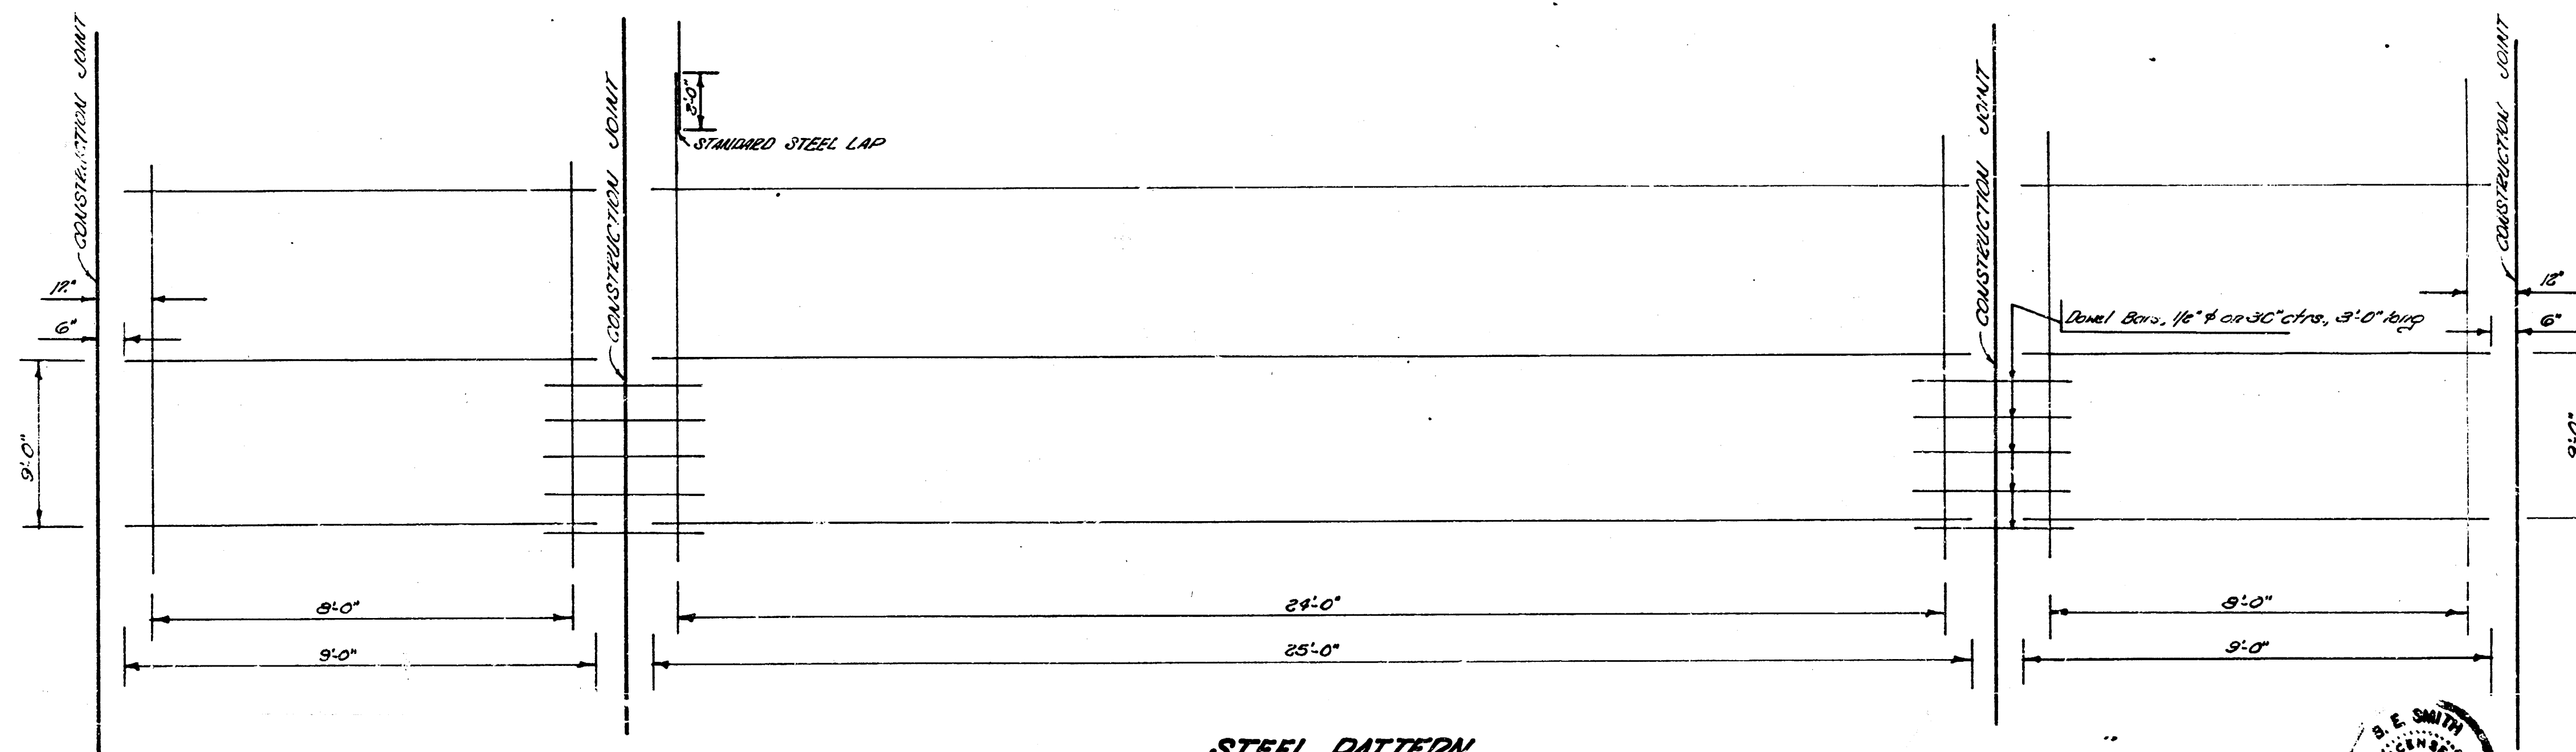

STEEL PATTERN
NOT TO SCALE

USE 3/4" ϕ BARS EXCEPT WHERE OTHERWISE NOTED

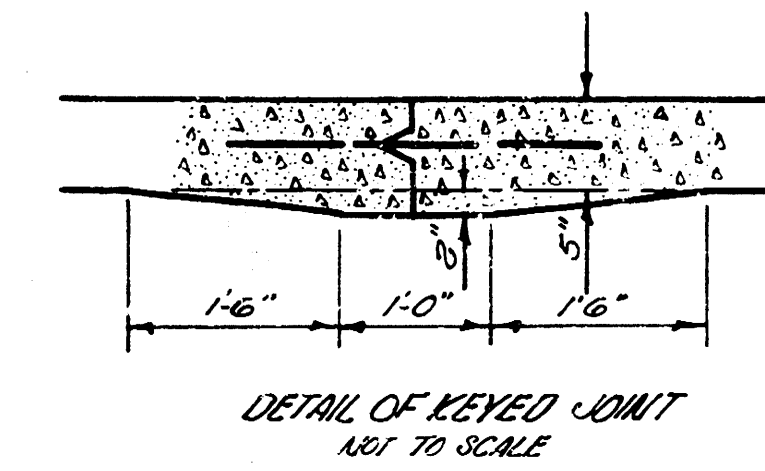

Survey Record
Plan and
Profile
Checked

