


PAVING PLANS FOR DECELERATION LANE ON ROCK ROAD

DECELERATION LANE


ON ROCK ROAD FROM A POINT 115.00 FT. NORTH OF THE NORTH LINE OF THE
S.W. 1/4, SEC. 5, T27S, R2E, 6TH P.M. TO THE SOUTH LINE OF LOT 1, BLOCK 1,
SILVERLEAF

PROJECT NO.
472-76-245-81363-000-000-001

CITY OF WICHITA, KANSAS
MIKE LINDBERGH, CITY ENGINEER
JULY, 1984

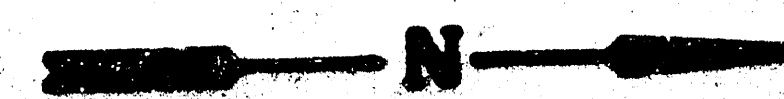

SCALE: 1" = 150'

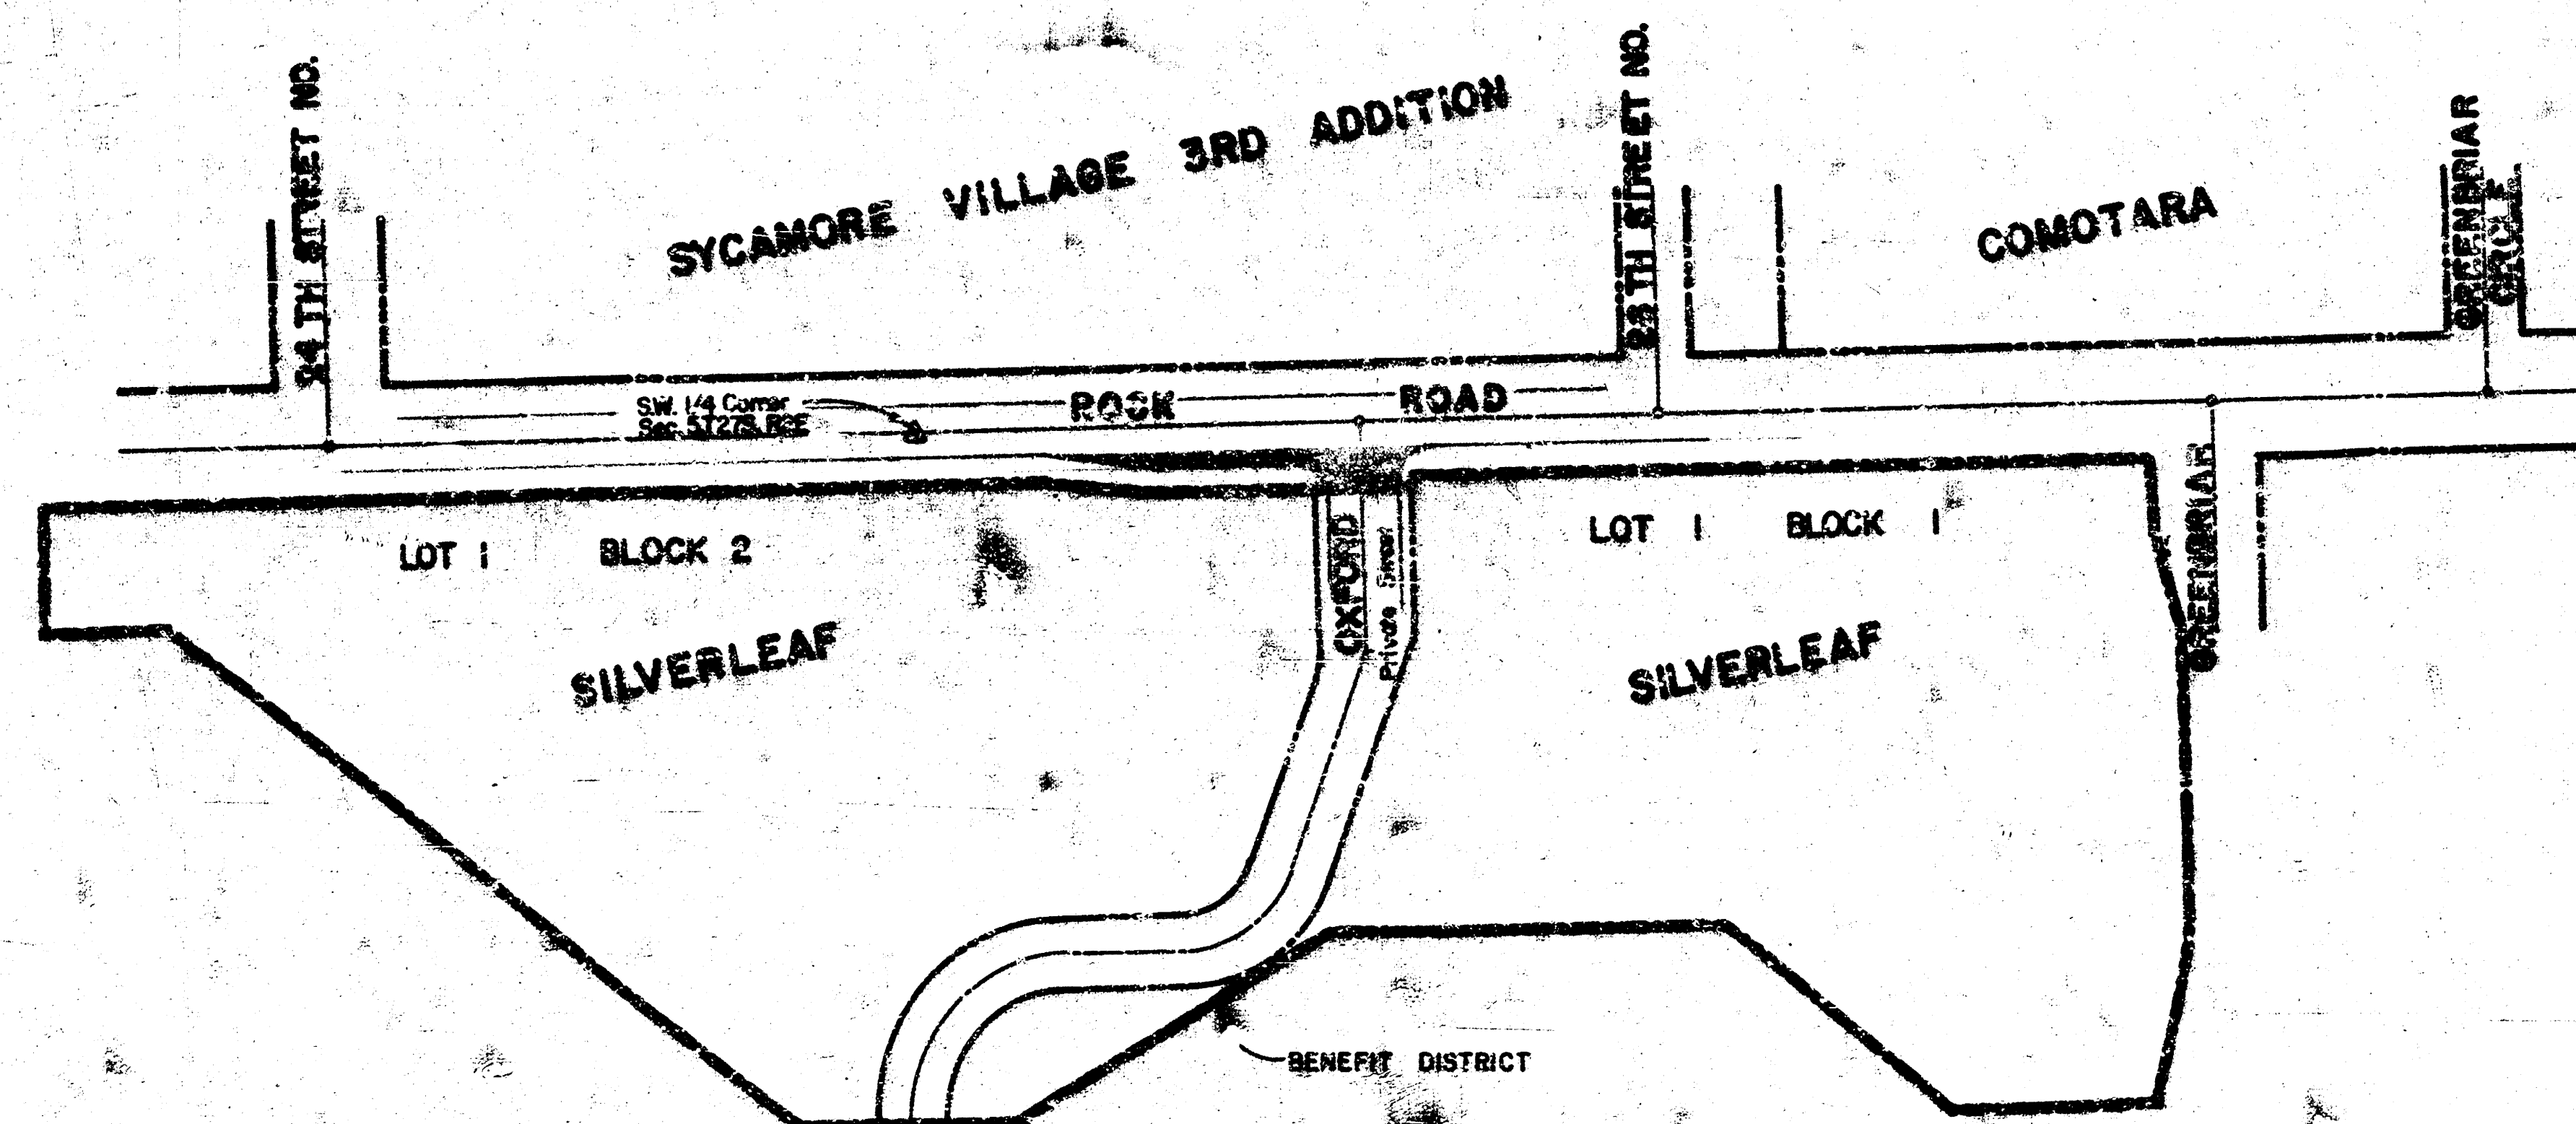

BENCH MARKS

B.M. 1 City Sd. 21st & Rock, 45' N.
& 46' E. of C. of both.
Elevation = 214.57


B.M. 2 City Sd. S.E. cor. Rock Road & 29TH
ST. N., 44' S. & 48' W. of C. of both
Elevation = 213.20

INDEX TO SHEETS

SHEET	REFERENCE	DESCRIPTION
1	8/48	Decal Lane Paving
2	9/48	Decal Lane Paving
3	19/48	Drainage Plan & Profile
4	40/48	Cross Sections



	PAVING PLANS FOR DECELERATION LANE ON ROCK ROAD		RMS Drawn by PZ Checked by JULY '84
	MIP-KANSAS ENGINEERING CONSULTANTS PA 240 NORTH ROCK ROAD SUITE 100 WICHITA, KANSAS 67206		682-6561 5 of 4

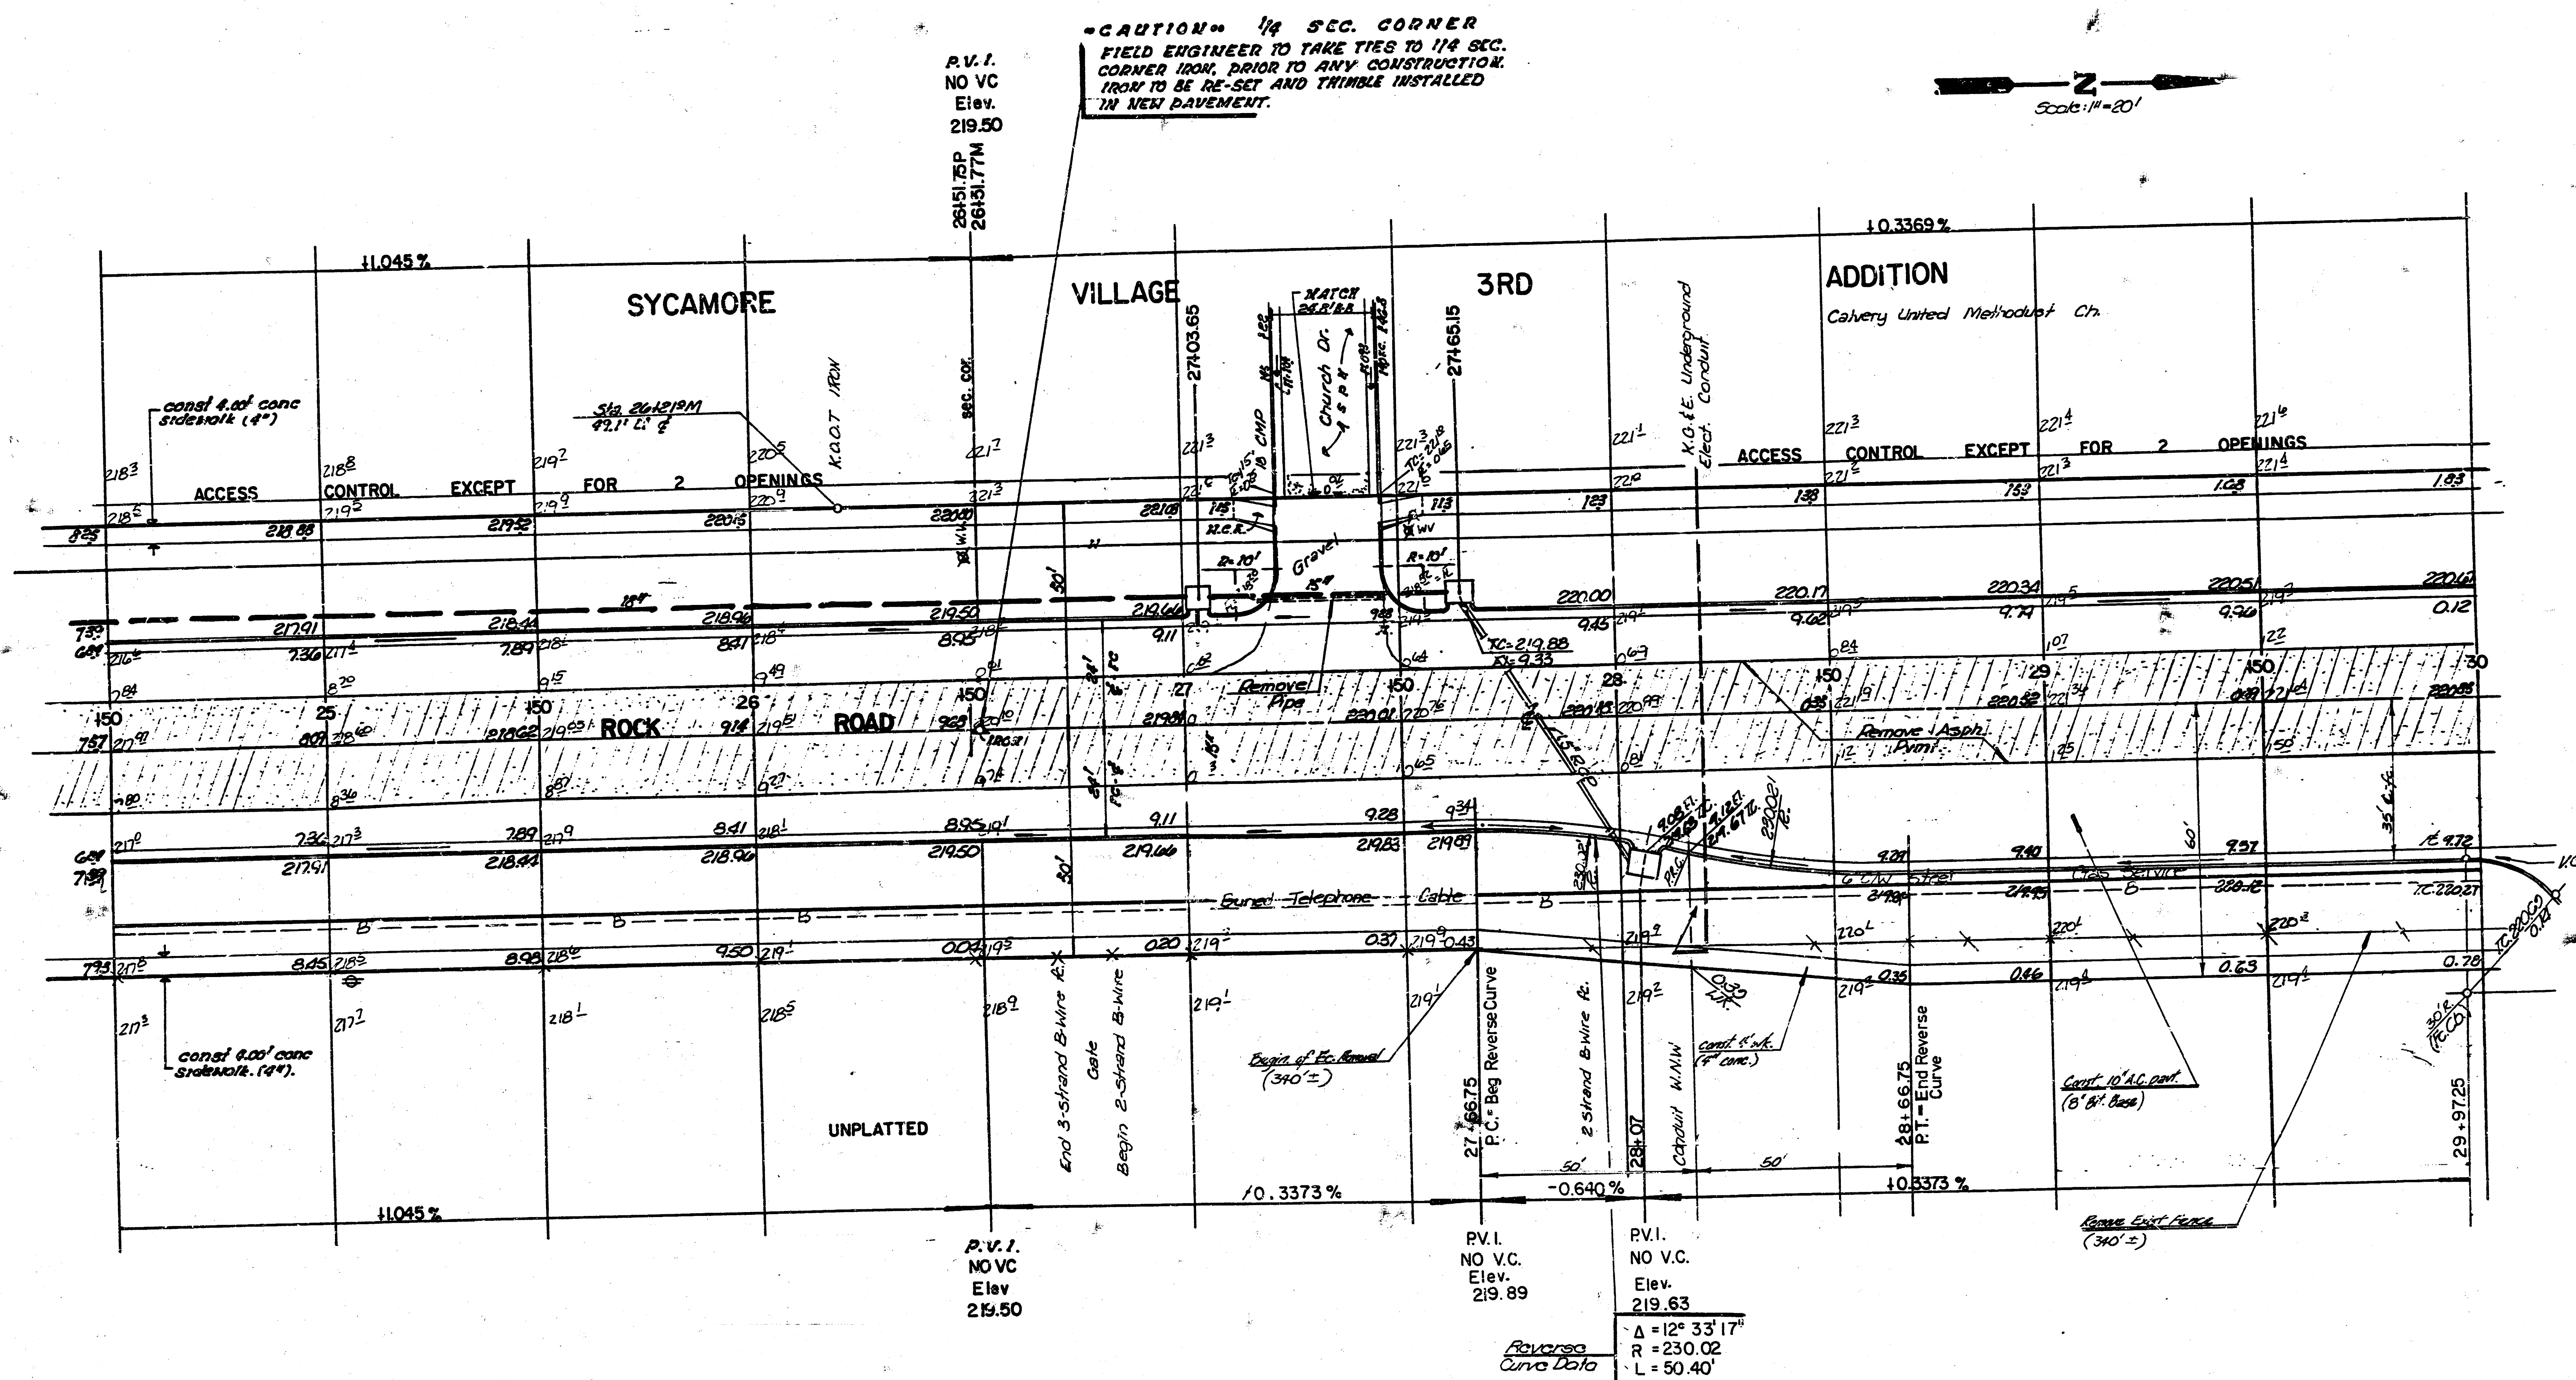



NOTE: DECEL LANE IS A SEPARATE
PROJECT: 472-76-245-81383-000-000-001

DECL LANE - Sta. 27+66.75 to Sta.
31+26.25 - By M.K.E.C.
REVISED 12 JULY 81 - MKEC
PROJECT DESCRIPTION

ROCK ROAD-from NL 22nd st North to NL
30th st North


PROJECT NUMBER
472-76-245-~~81248~~-000-000-001

REVISED _____²

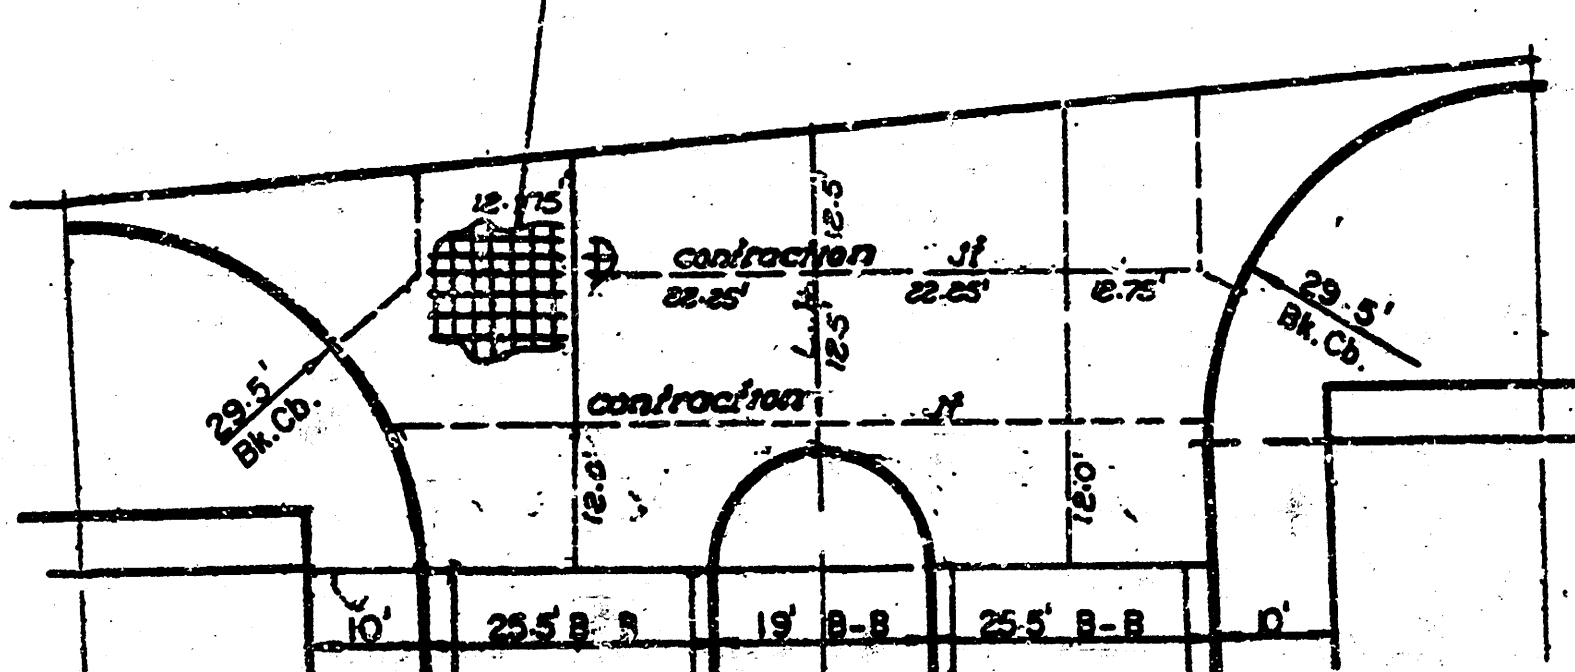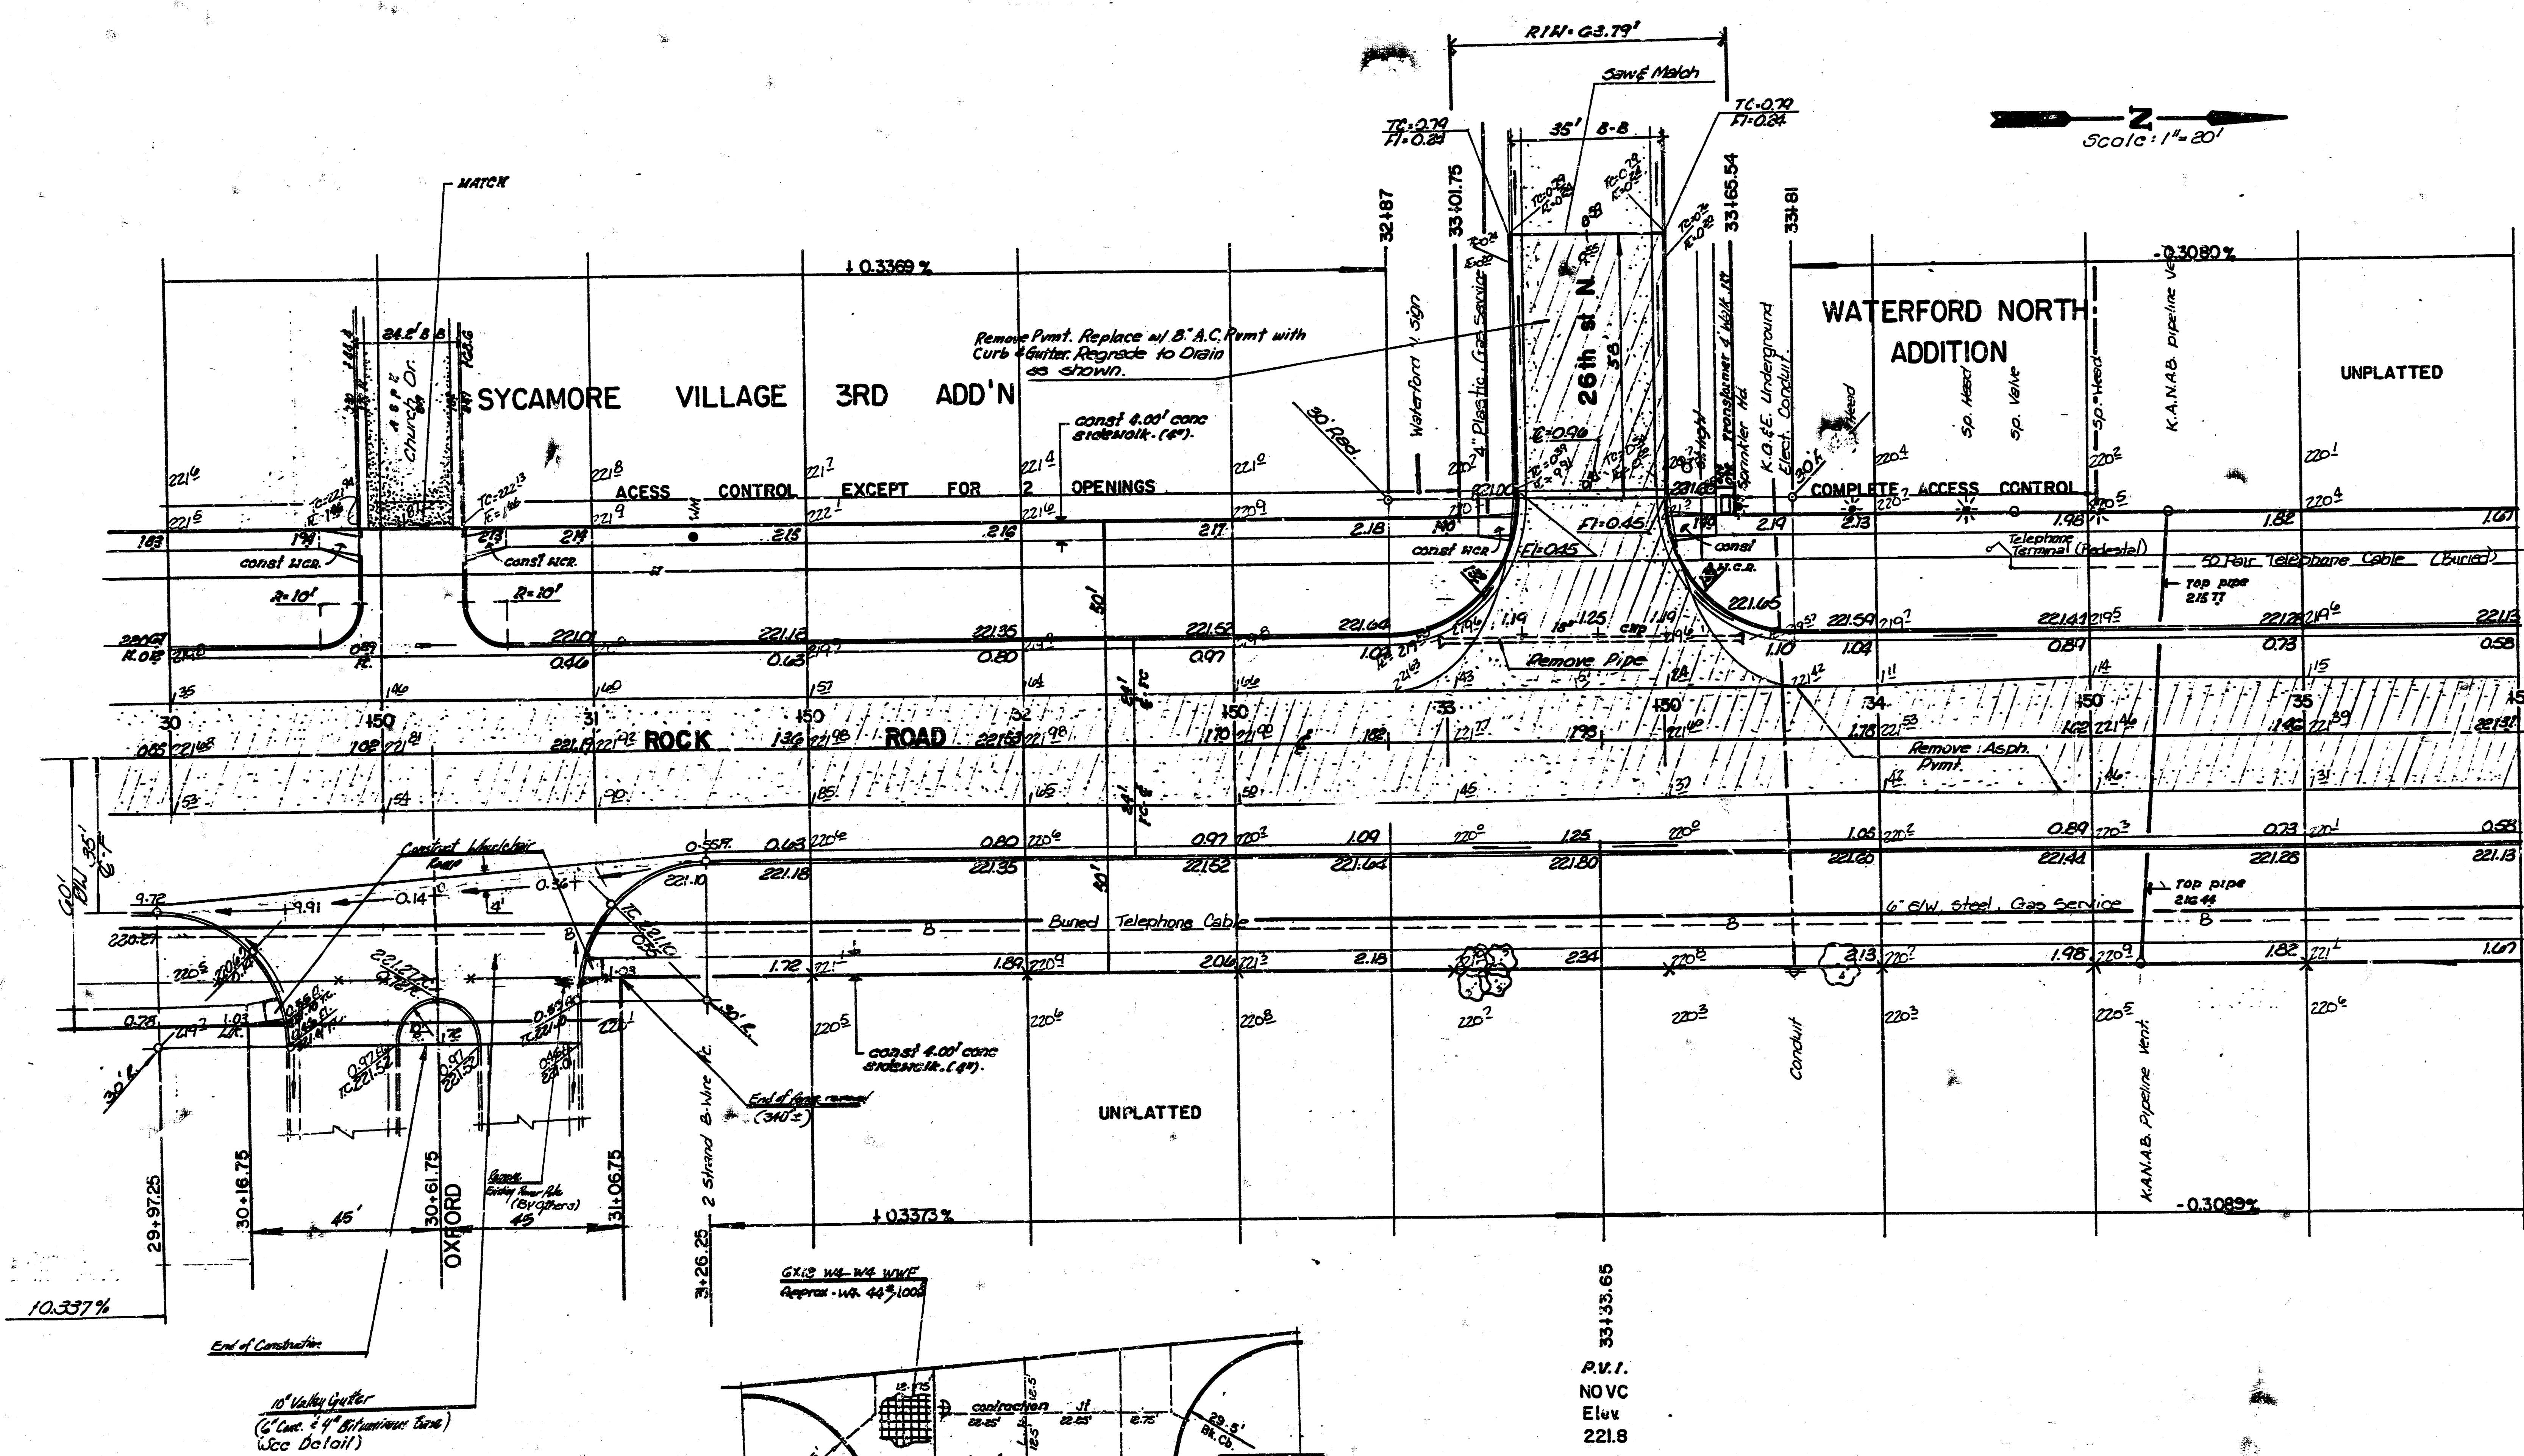

10" Valley Gutter Detail
(6" Conc. & 4" Bit. Base)

NOTE: DECEL LANE IS A SEPARATE PROJECT: 472-76-245-81383-000-000-001

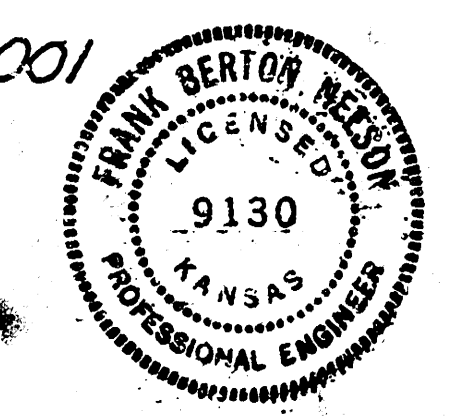


DECEL LANE - Sta. 27+66.75 to Sta. 31+26.25 - By M.K.E.C.
REVISED 12/1/84 - MKEC.
PROJECT DESCRIPTION
ROCK ROAD - from N. 22nd St North to N. 30th St North
PROJECT NUMBER
472-76-245-81383-000-000-001

REVISED


198/48

Scale:
1" = 20' Horiz.
1" = 5' Vert.

PLAN
DATE: _____
BY: _____
CHECKED: _____
NO. _____

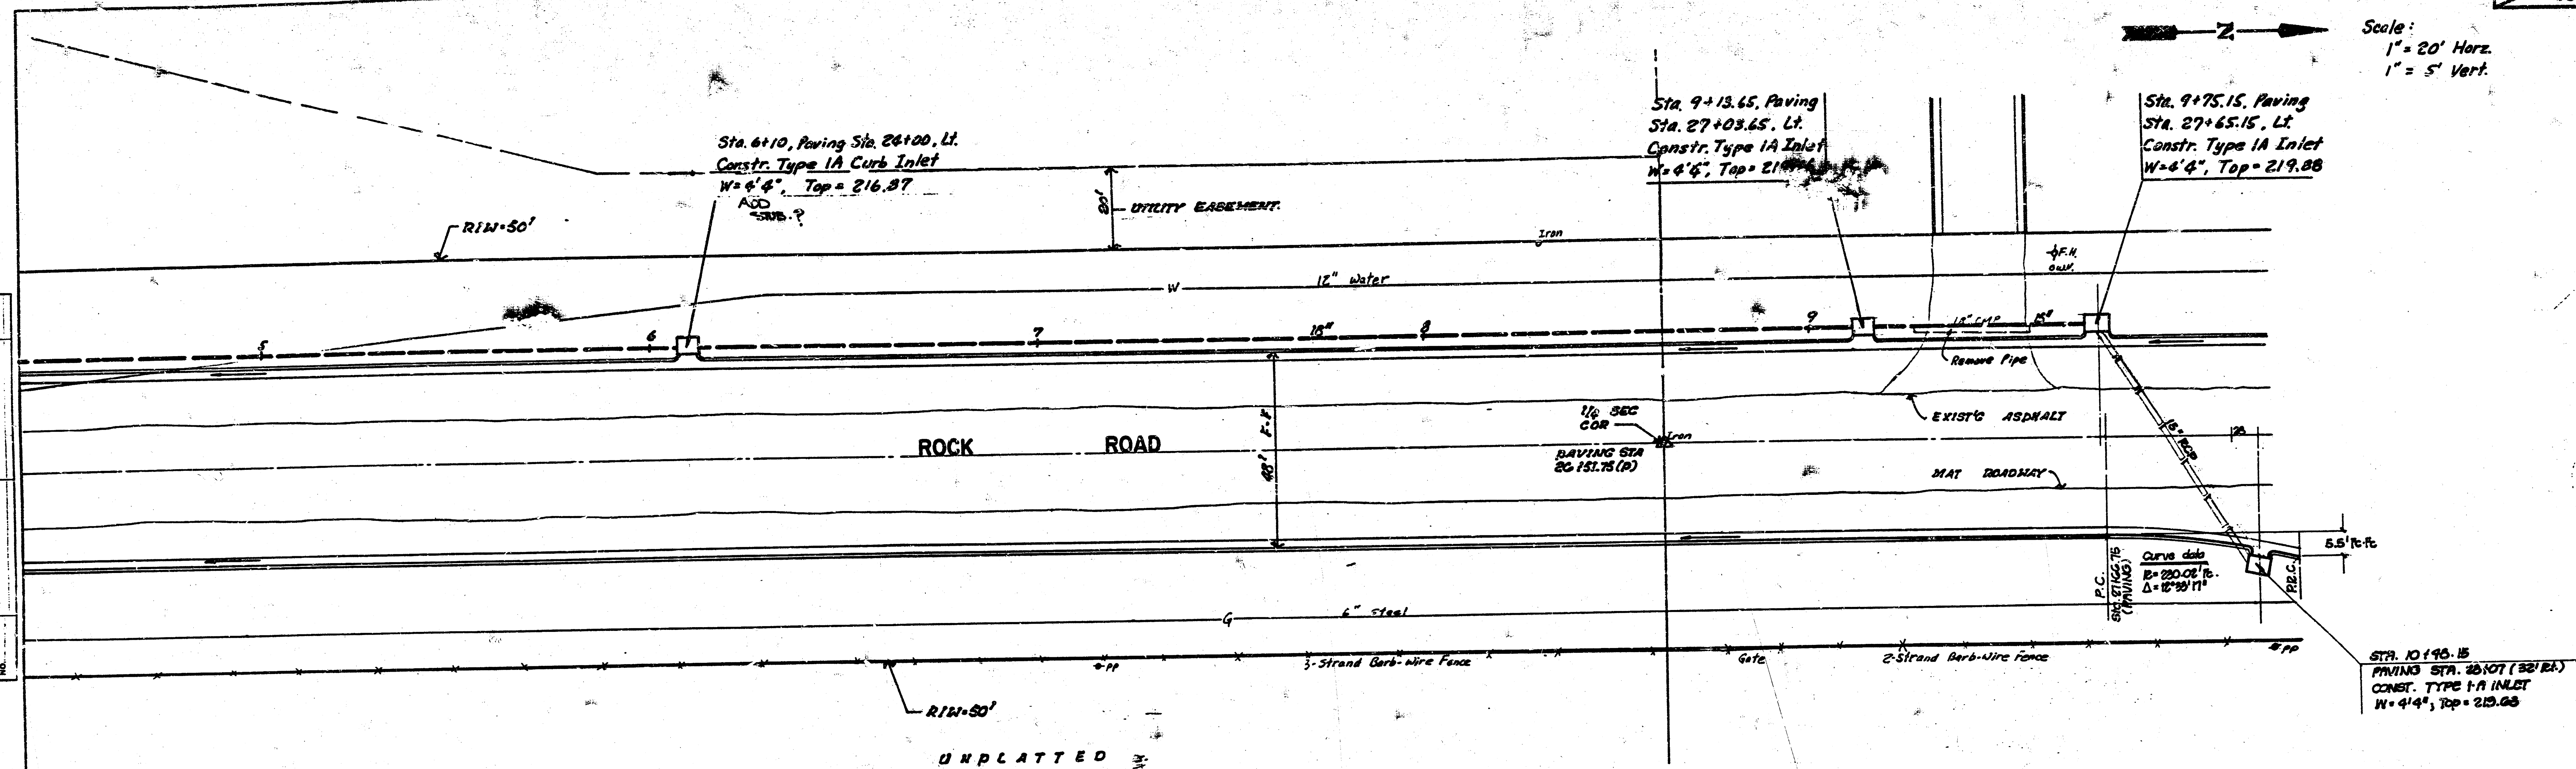


PROFILE
DATE: _____
BY: _____
CHECKED: _____
NO. _____

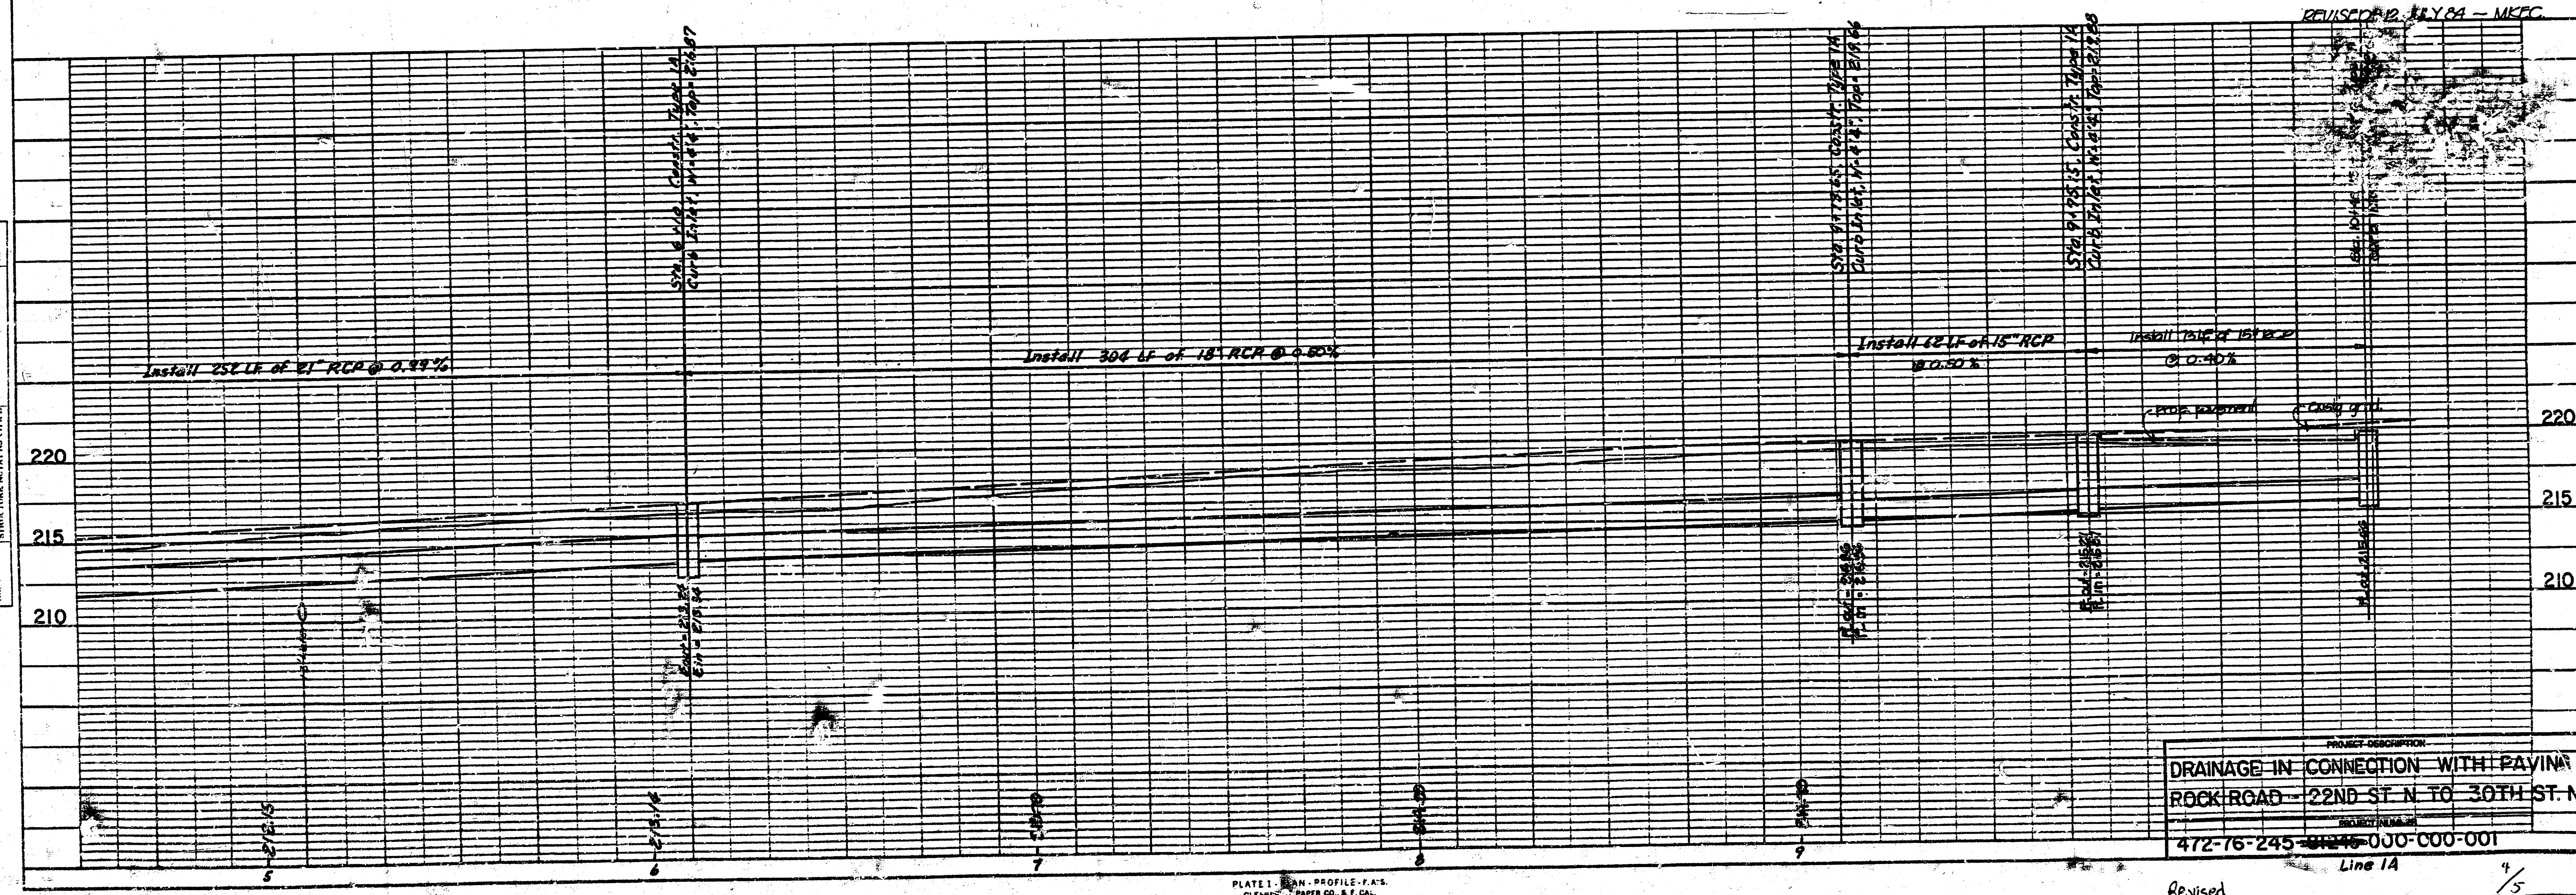

PROJECT DESCRIPTION
DRAINAGE IN CONNECTION WITH PAVING
ROCK ROAD - 22ND ST. N TO 30TH ST. N.
472-76-245-000-000-001
Line 1A


Revised
4/5

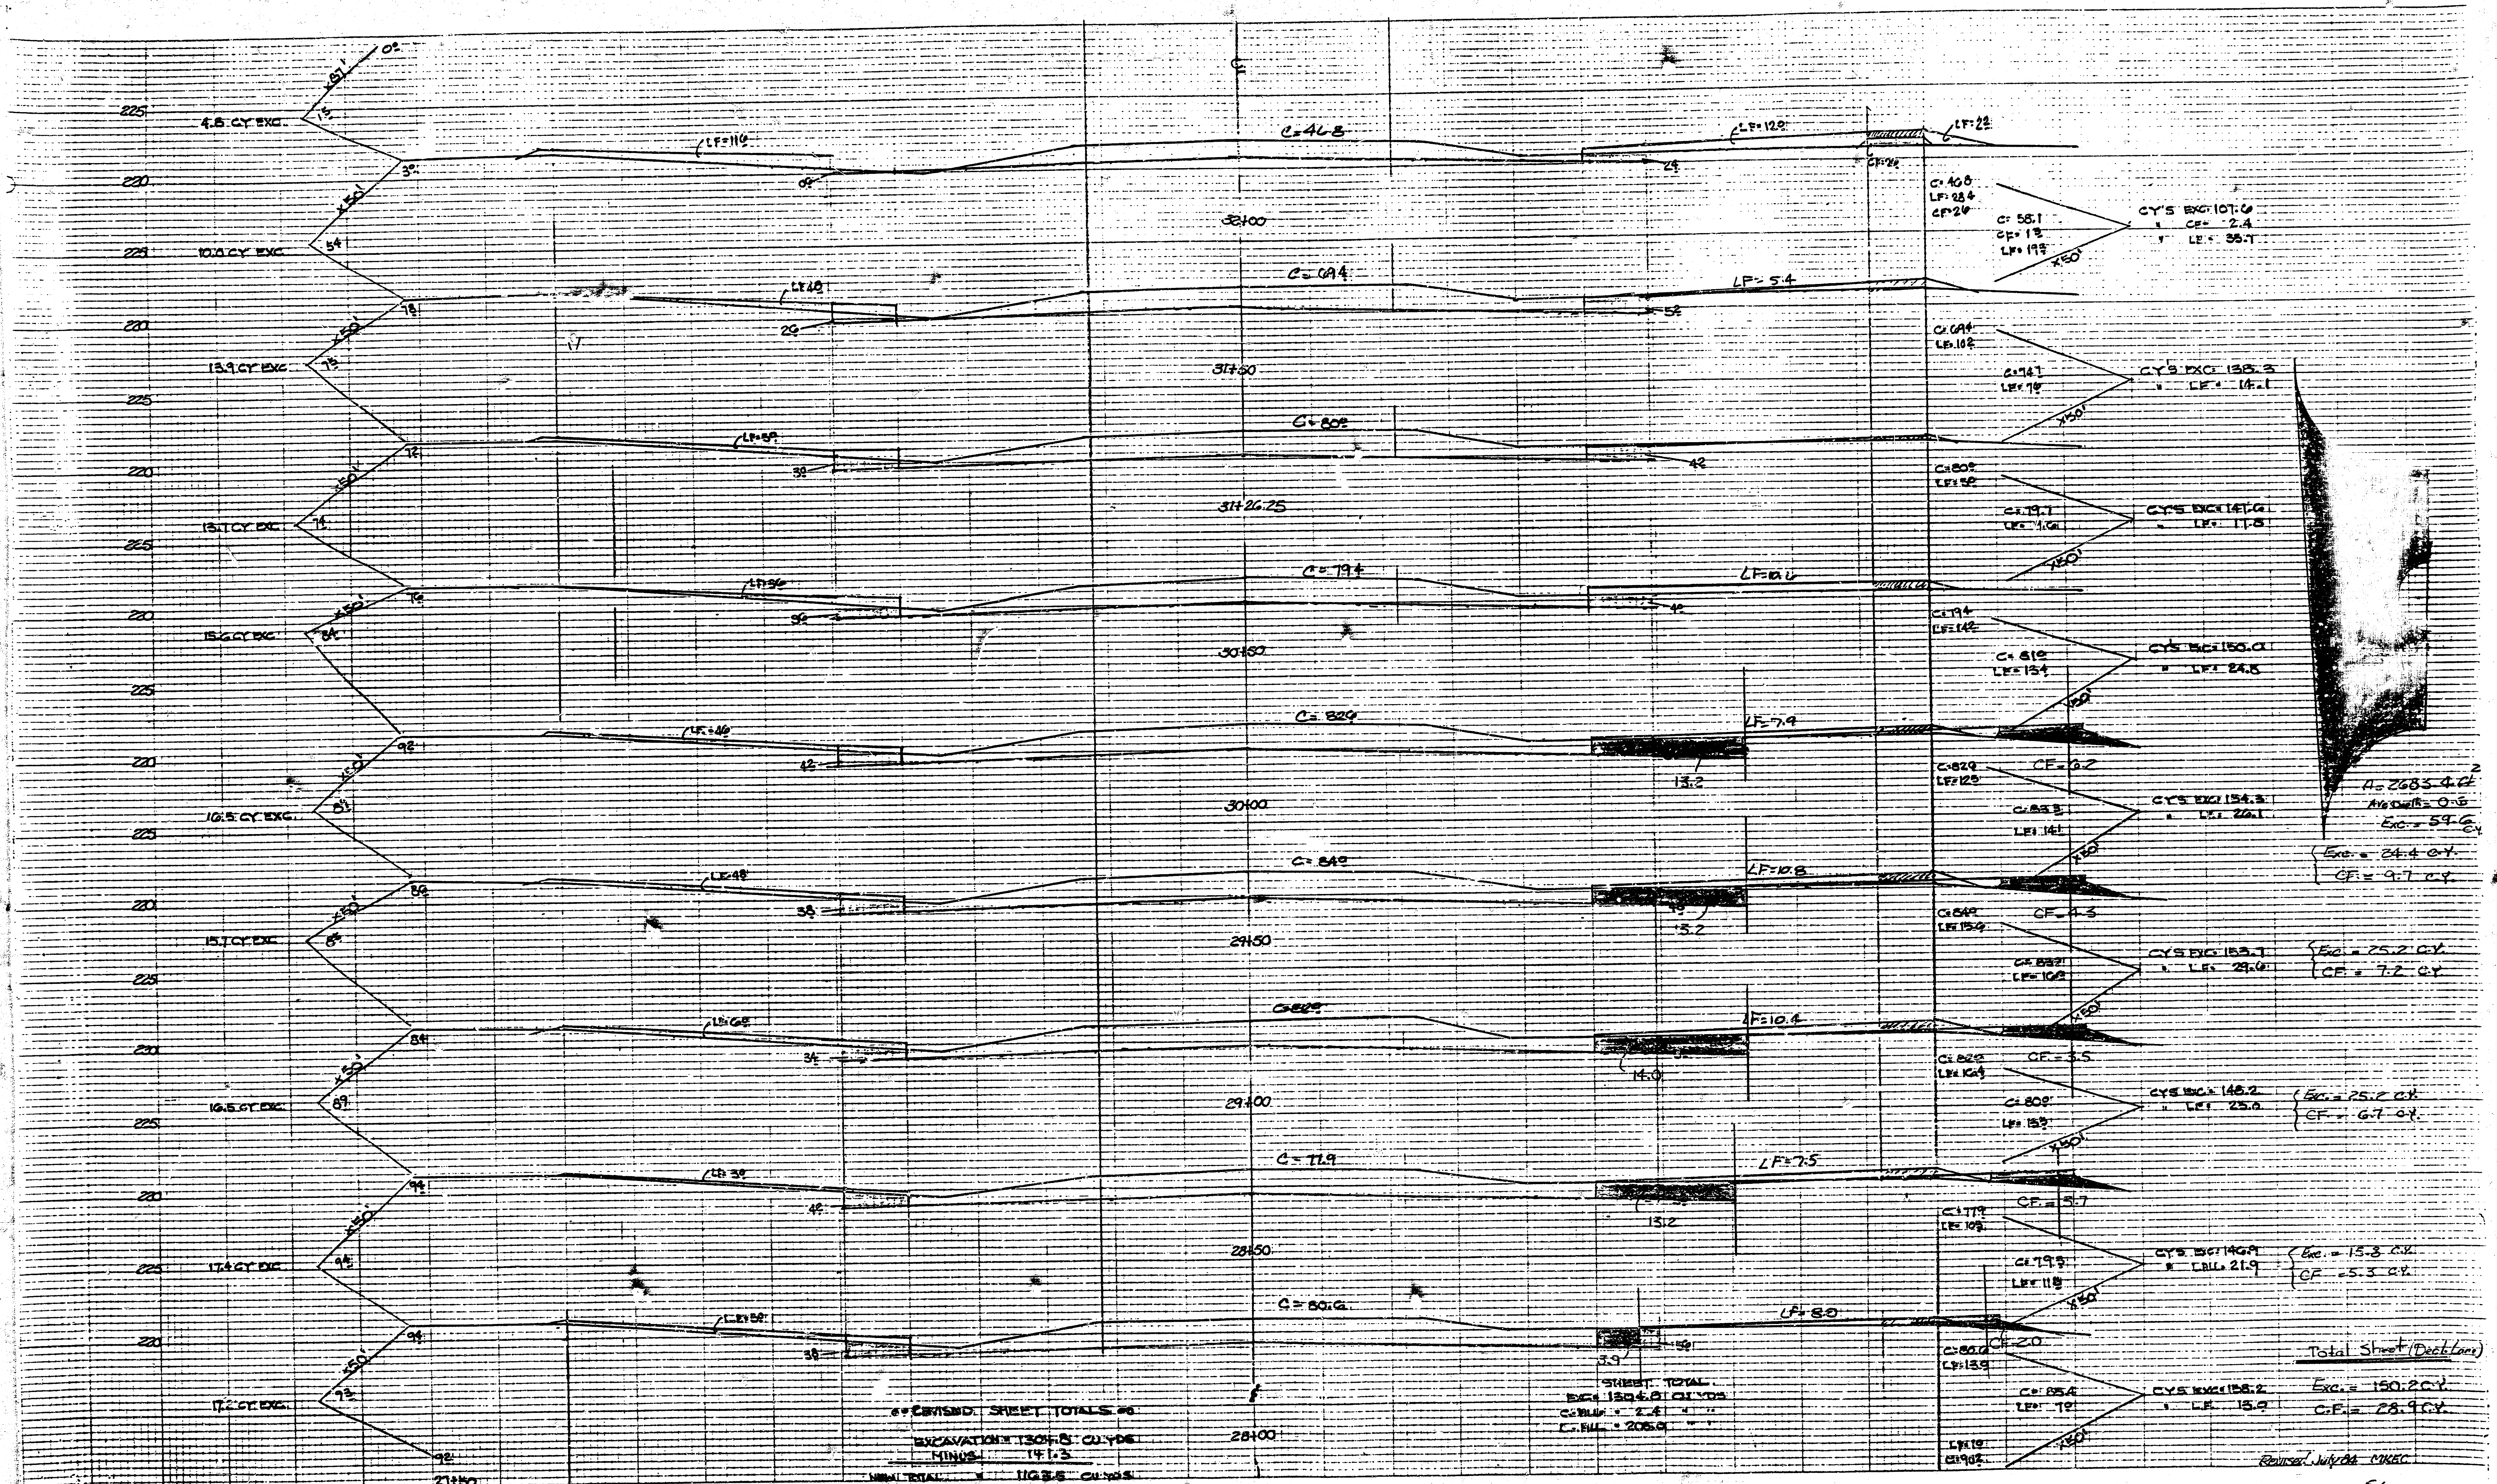

REVISED SHEET TOTALS TO
EXCAVATION 1304.8 CY'S
MINUS 141.3
NET TOTAL 1163.5 CY'S

SHEET TOTAL
EXC 1304.8 CY'S
C.BILL = 2.41
C.FILL = 205.9

Total Sheet (Deck Lane)
Exc. = 150.2 CY
C.F. = 28.9 CY