




NOTE: CHAIN N. ON E

<u>Grand Total Excav</u>	
<u>Prop.</u>	<u>City</u>
1826.8	287
+10% 182.7	+10% 2.9
Total 2009.5 Cu. yds.	Total 31.6 Cu. yds.

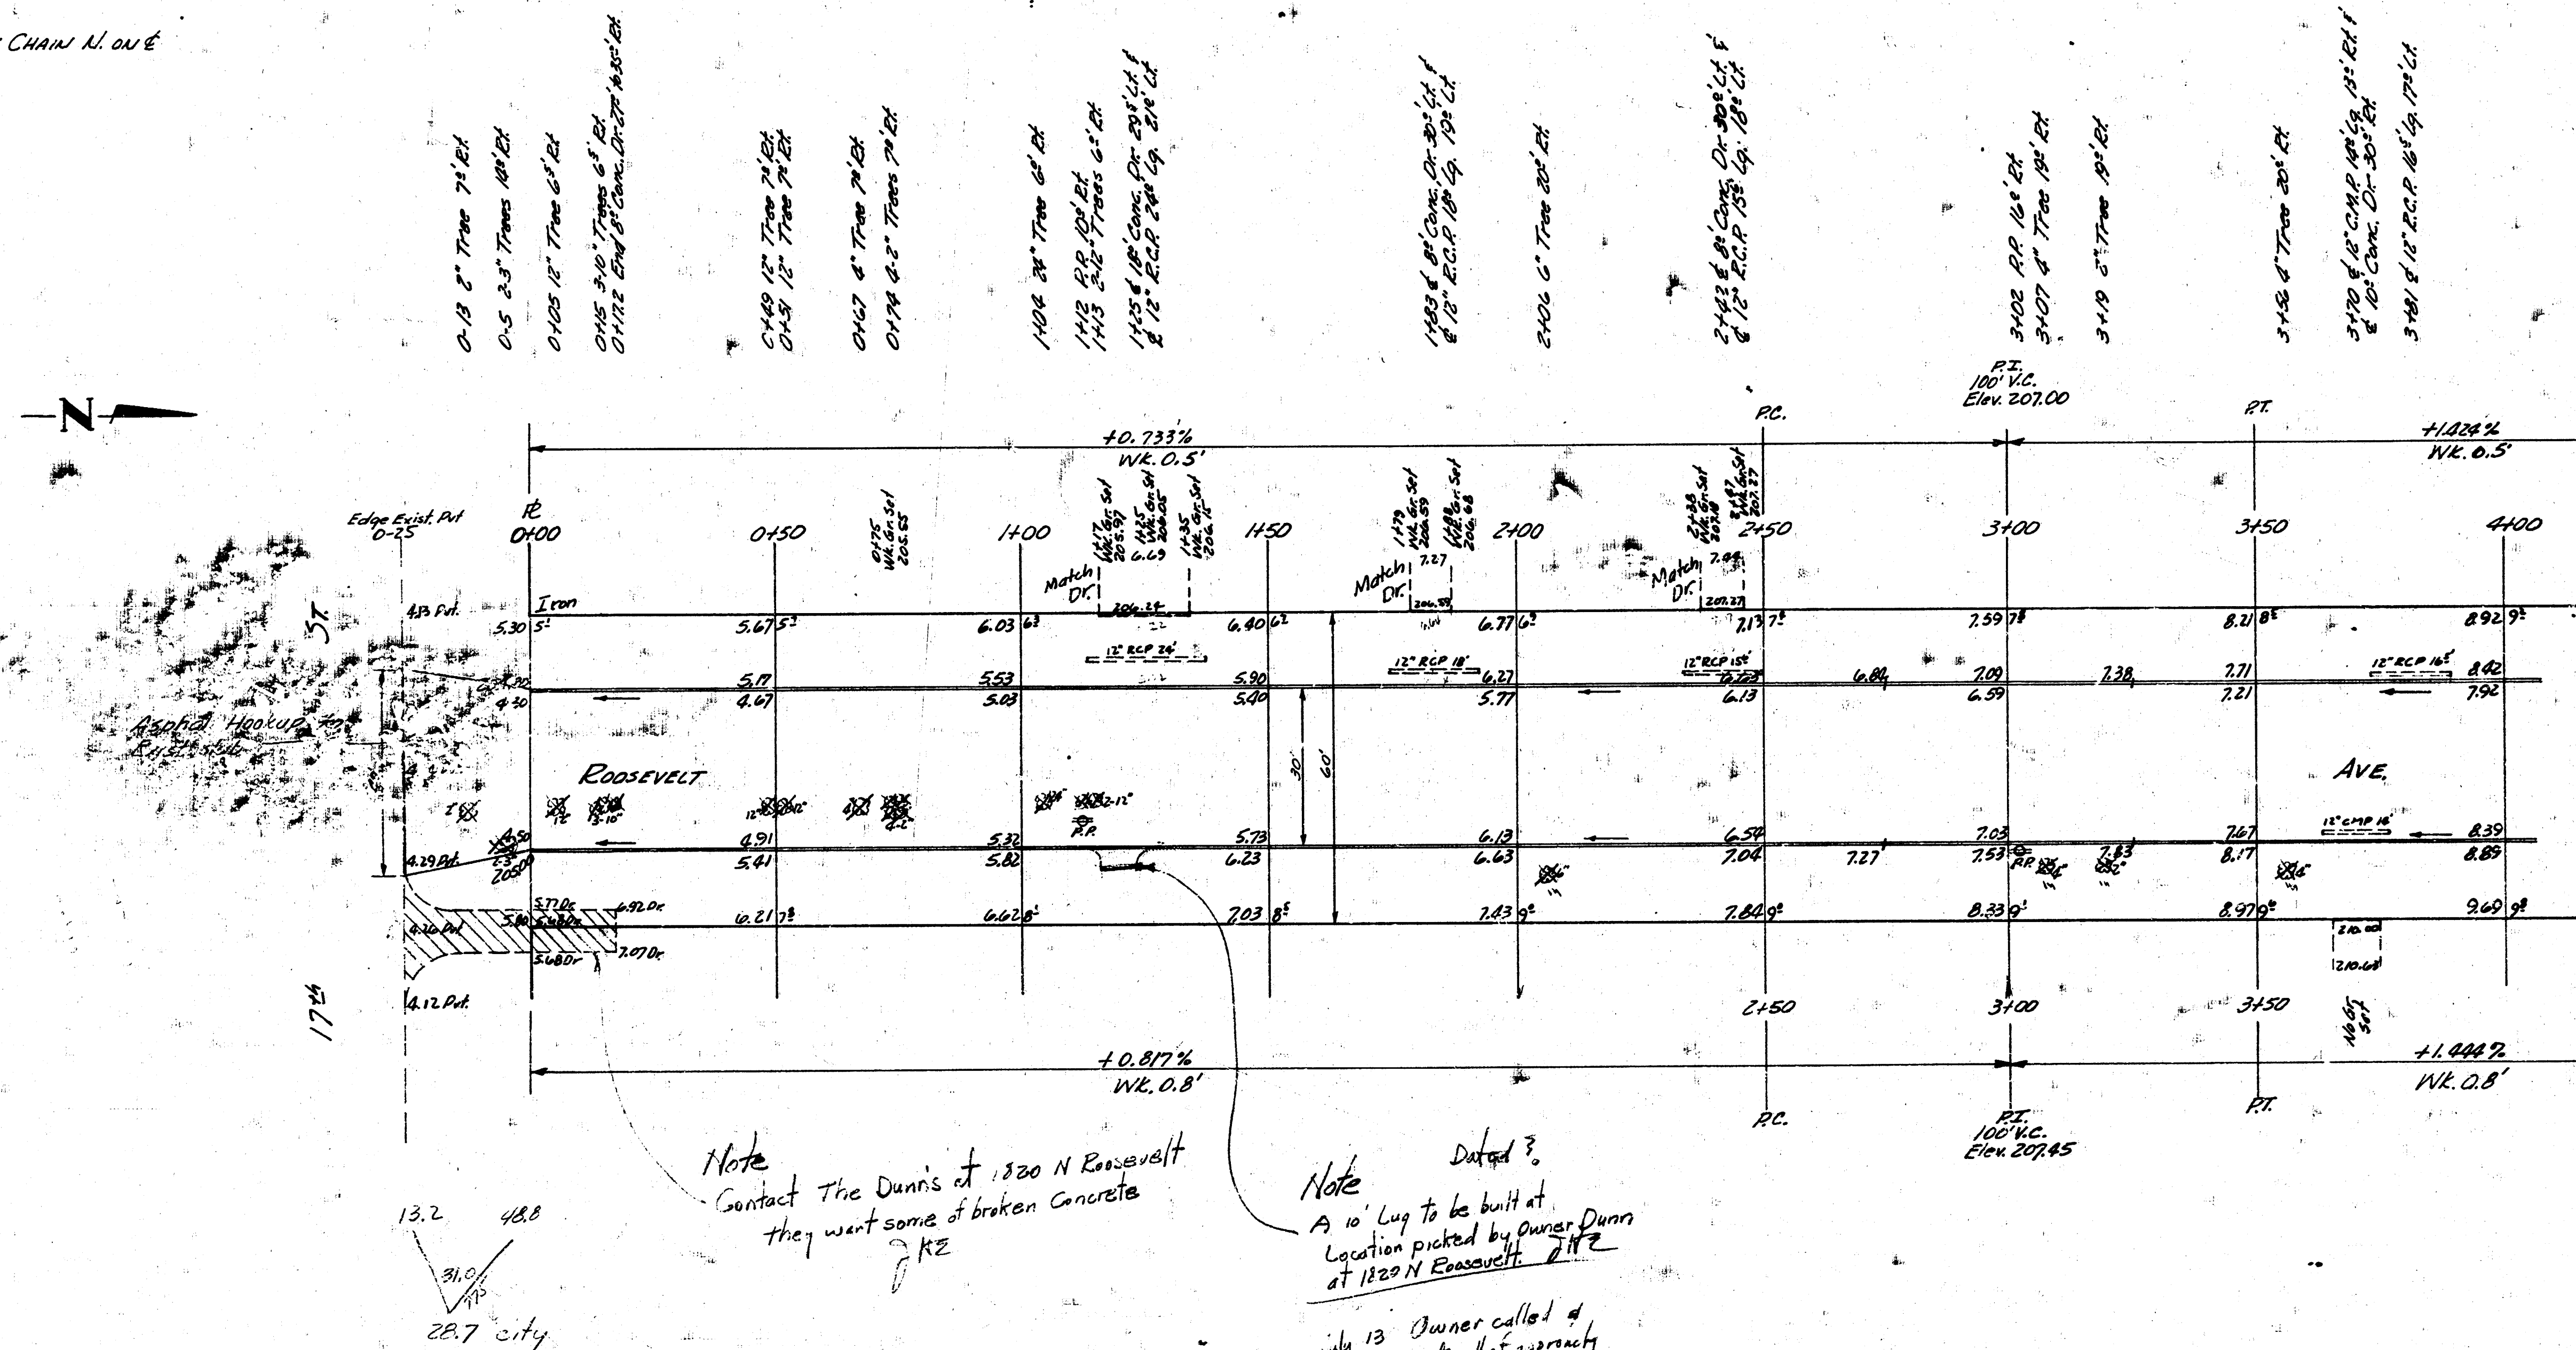

ROOSEVELT AVE.
N.L. 17th TO S.L. 18th
30' CONC. & CB.
CITY OF WICHITA, KANSAS
B.E. SMITH CITY ENGINEER
MAY 1954 PROJ. NO. C14-103

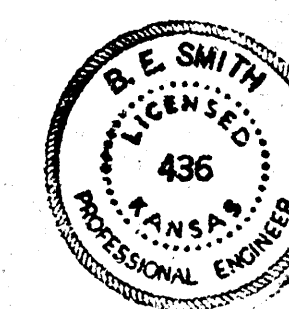

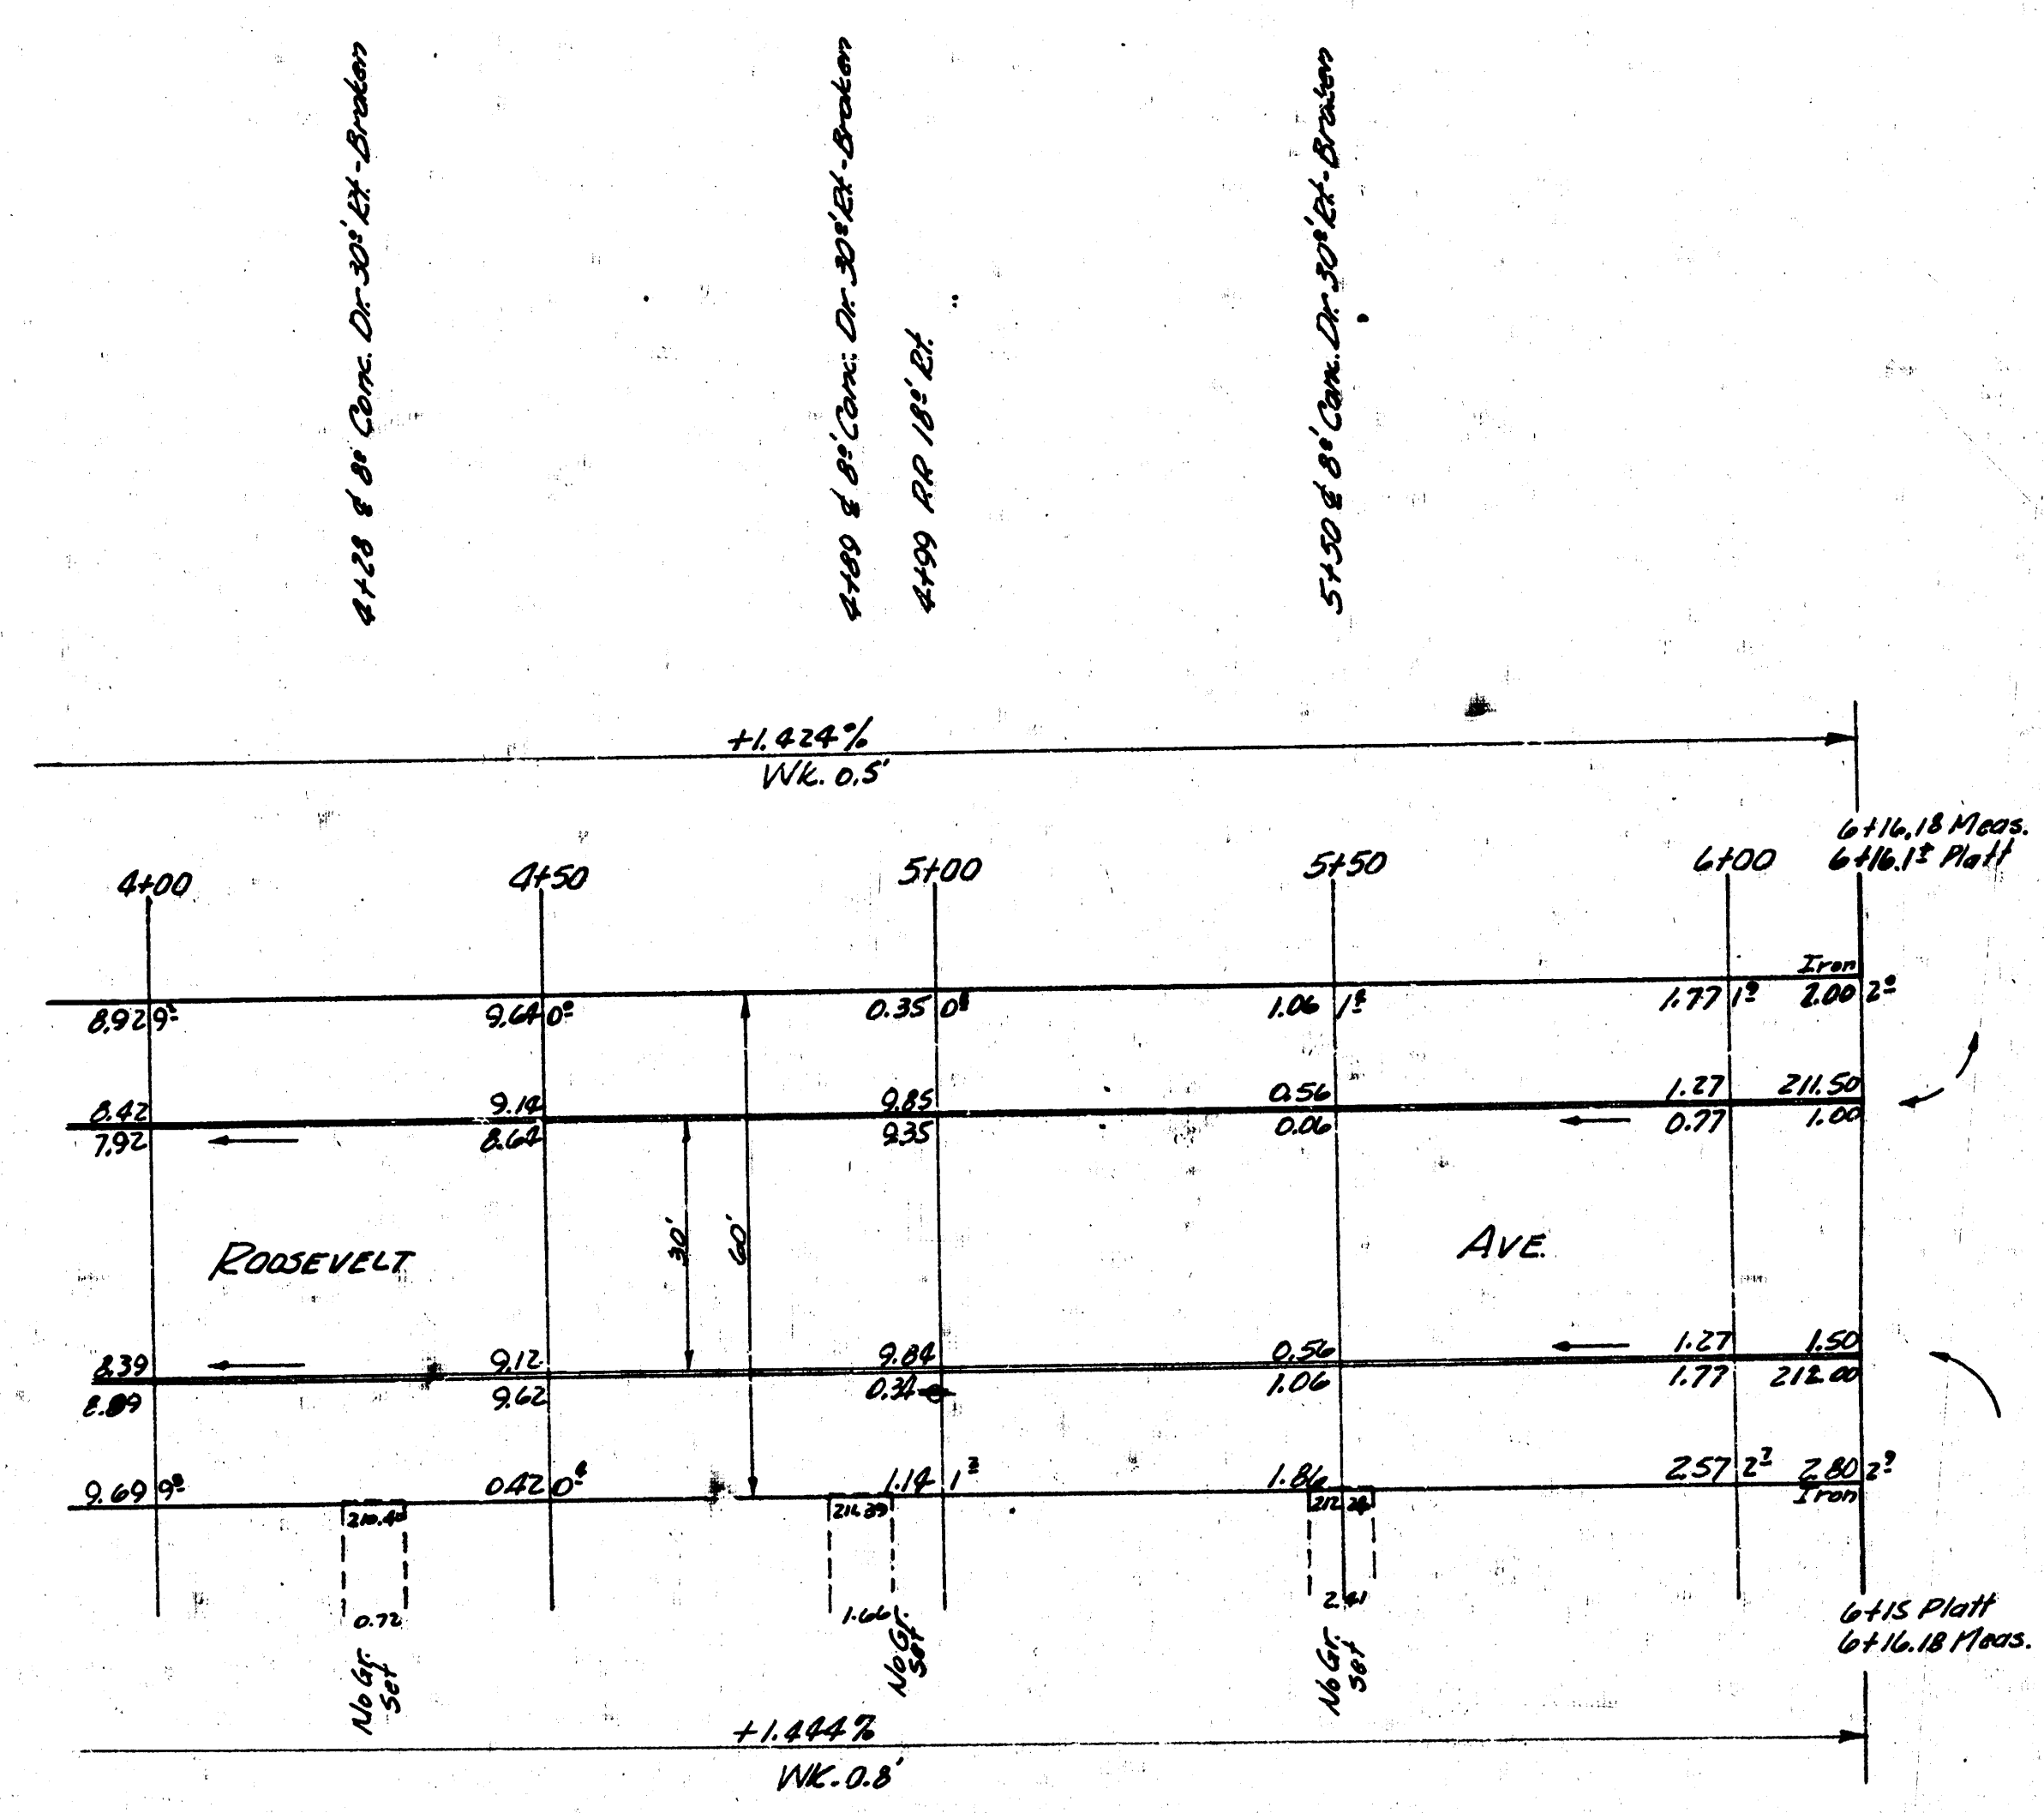

18' 57'