


2 prelim. survey - E St. Louis Avenue.

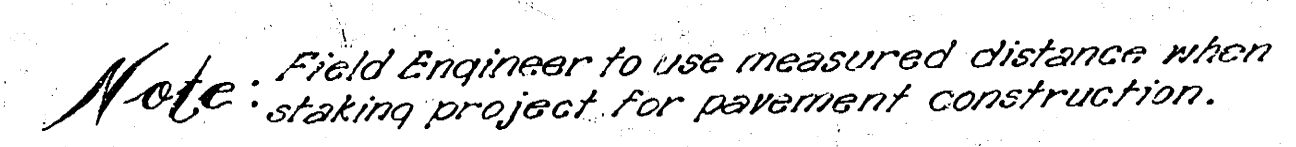

 = Removal Area

Compacted Fill
prop.
~~354.7~~ 150.4
35.5 + 10%

390.8 c.y.

30' of 6" Concrete and Cur'b

City of Wichita, Kansas

B.E. Smith — City Engineer

Date: June 1963 Proj. No. G12-76 Sheet 1/8

