


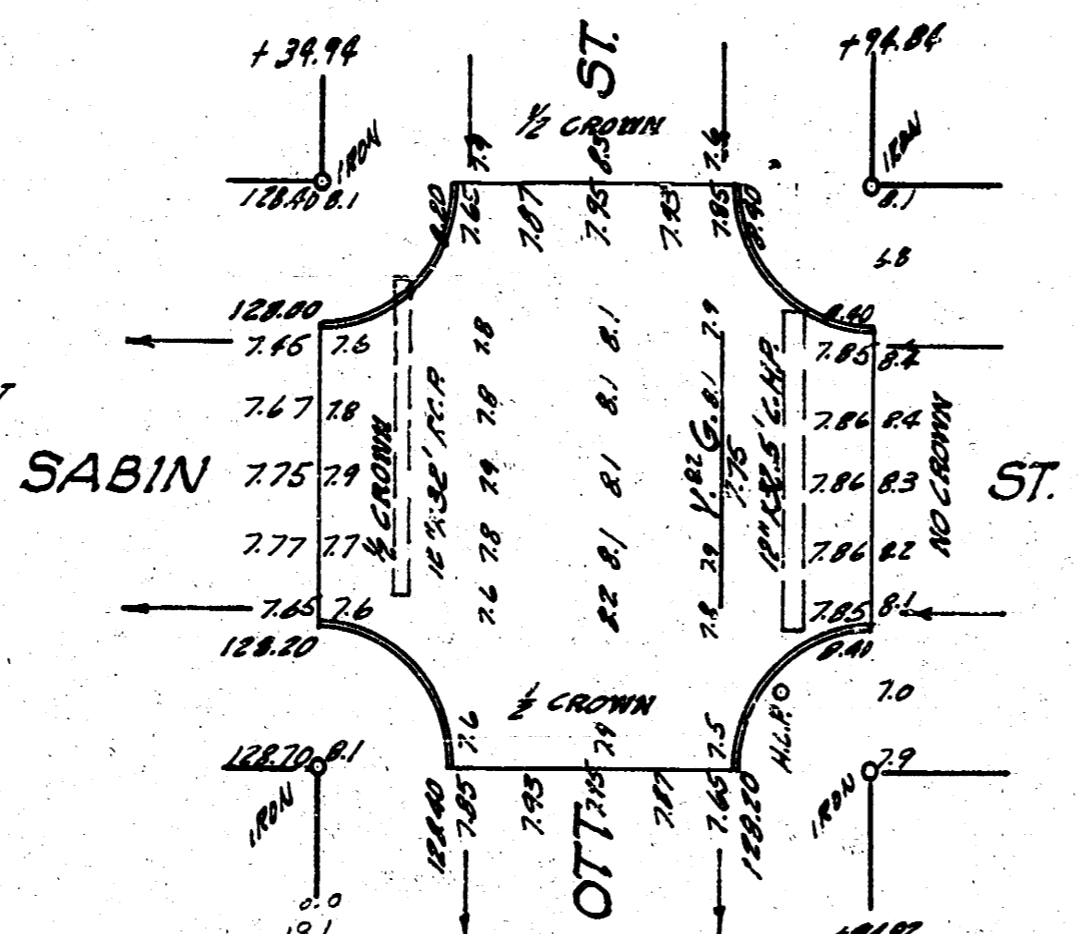

AM. 18851 RR SPUR E.S. N.P. NW QTT. LYNNHURST

NOTE: INSTALL 1" PERMANENT EXPANSION JOINTS PER AT  
 RE. OF CURVE AND AT 40' INTERVALS THROUGH CURVE




EARTHWORK QUANTITIES

ITEM	QUANTITY	UNIT
PREP		
616.94	1472	C.Y.
1472		
746.1	1619	C.Y.
		86.5

DEFLECTION PER FOOT OF CURVE = 40.1818"/M

STATION	ARC LENGTH	CHORD LENGTH S.O.E.C.B.	CHORD LENGTH S.O.W.C.B.	DEFLECTION	TOTAL DEFLECTION
5+18.87					
175	16.55	16.90	16.53	0° 31' 26"	0° 31' 26"
6+00	43.40	27.72	24.99	1° 41' 28"	2° 32' 54"
700	43.40	27.72	24.99	1° 41' 28"	19° 27' 34"
765	16.55	16.90	16.53	0° 31' 26"	20° 09' 02"

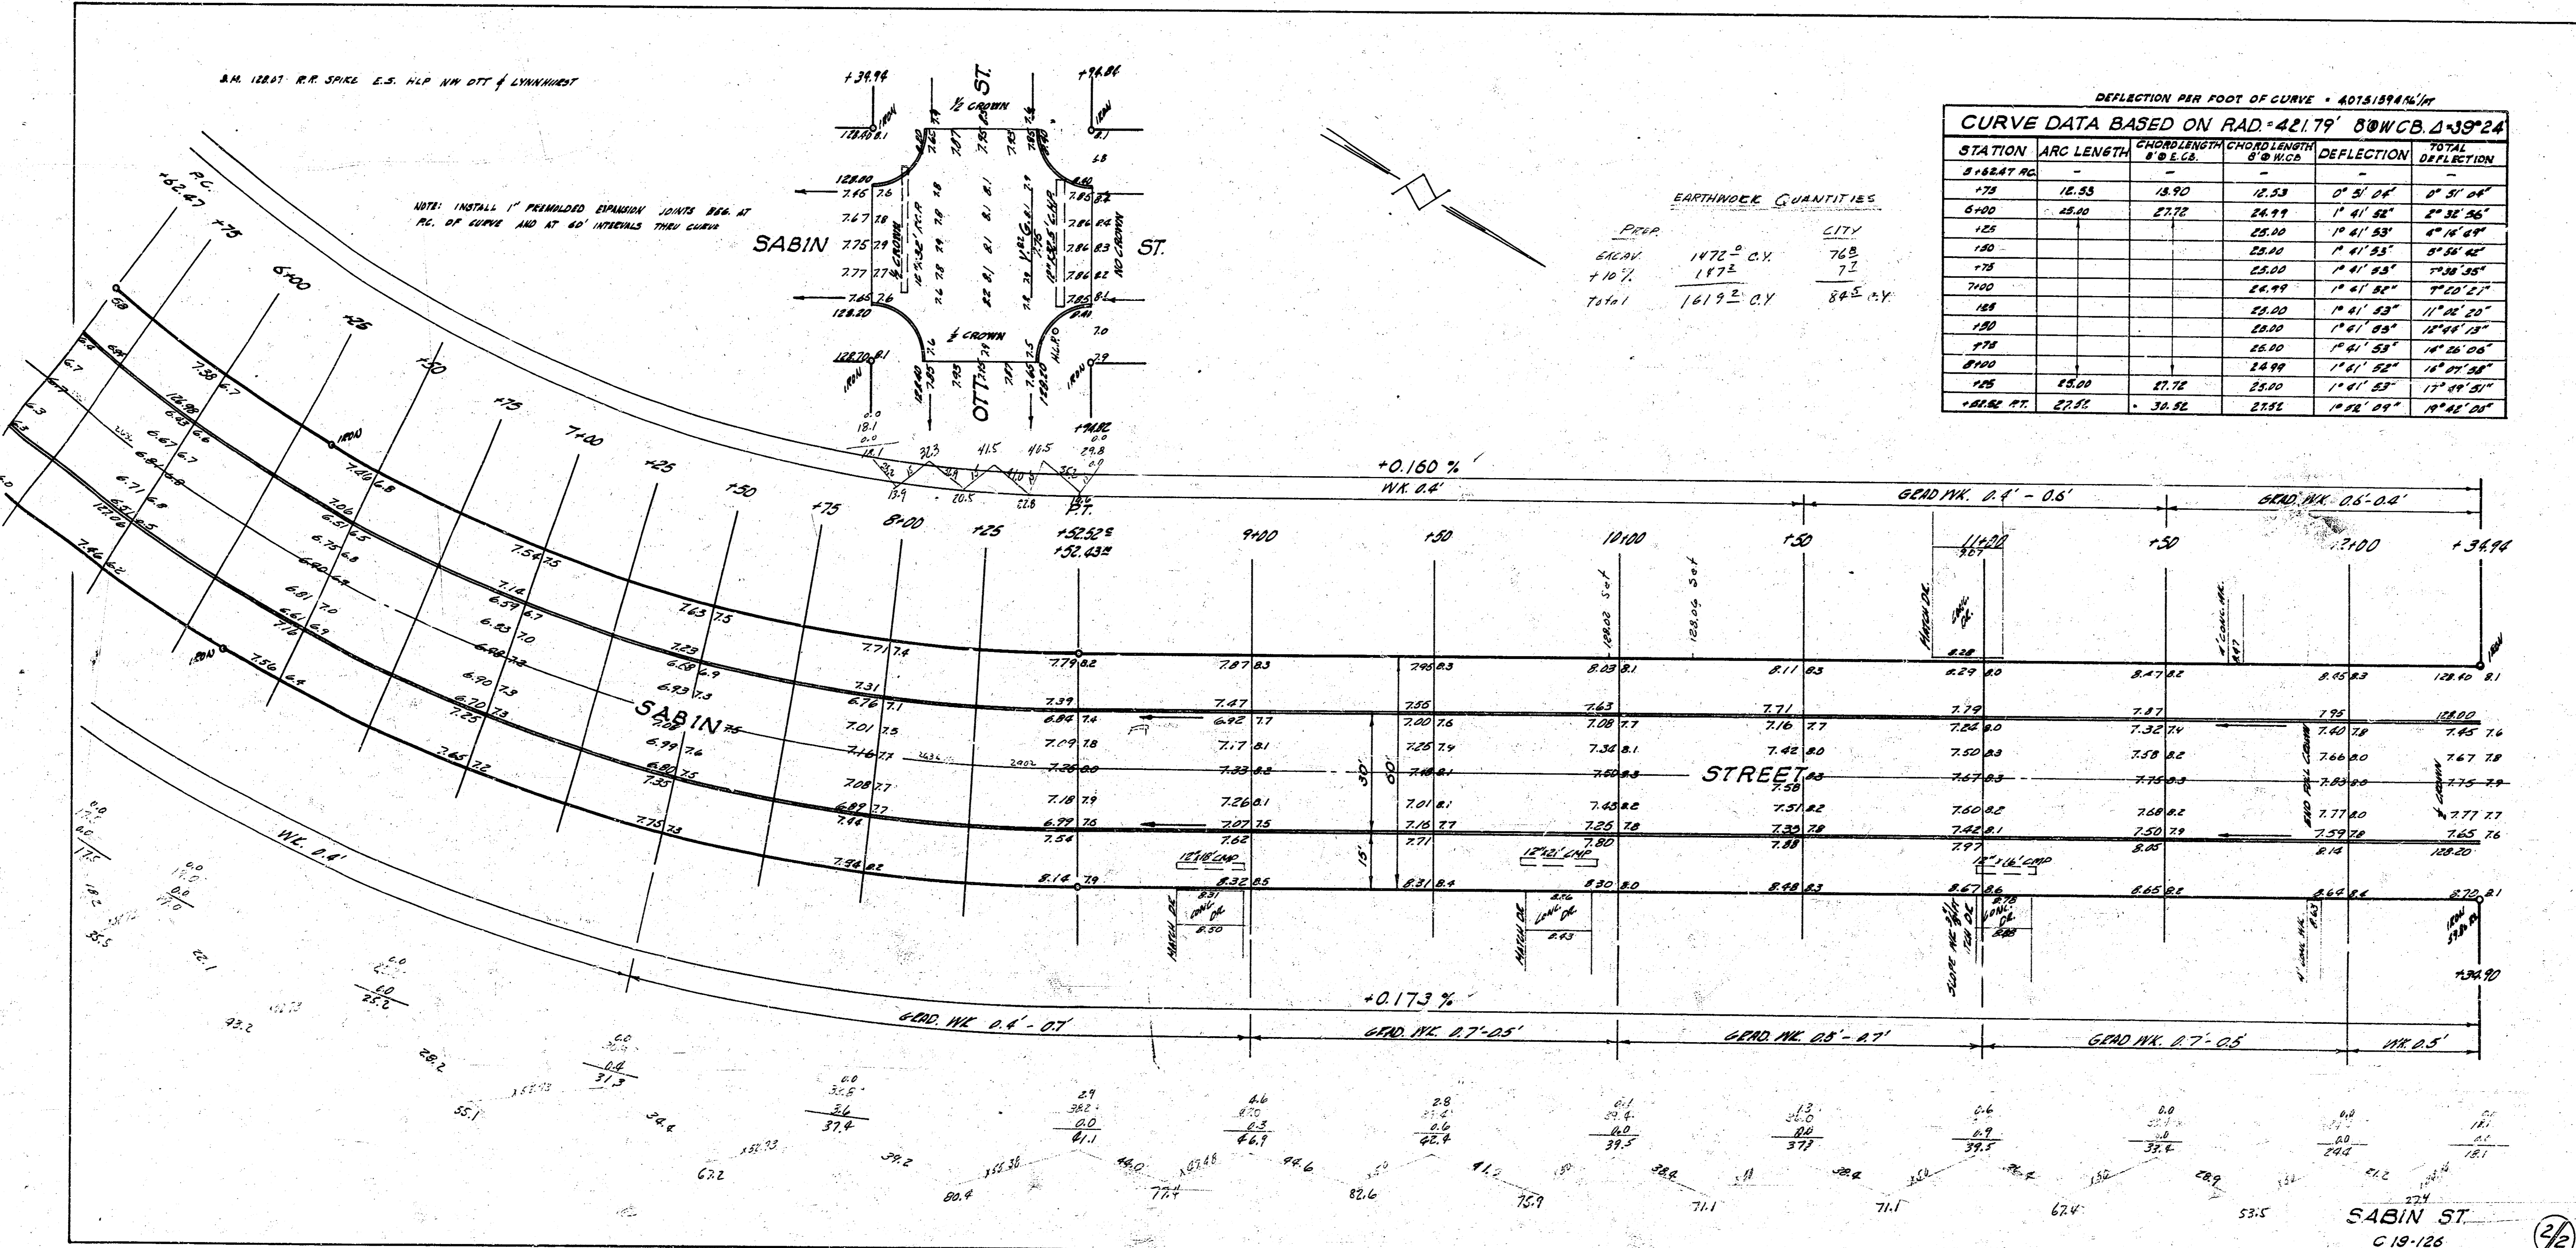

SABIN ST.  
 C 19-126