


184 x
125



63 ✓

H.P.

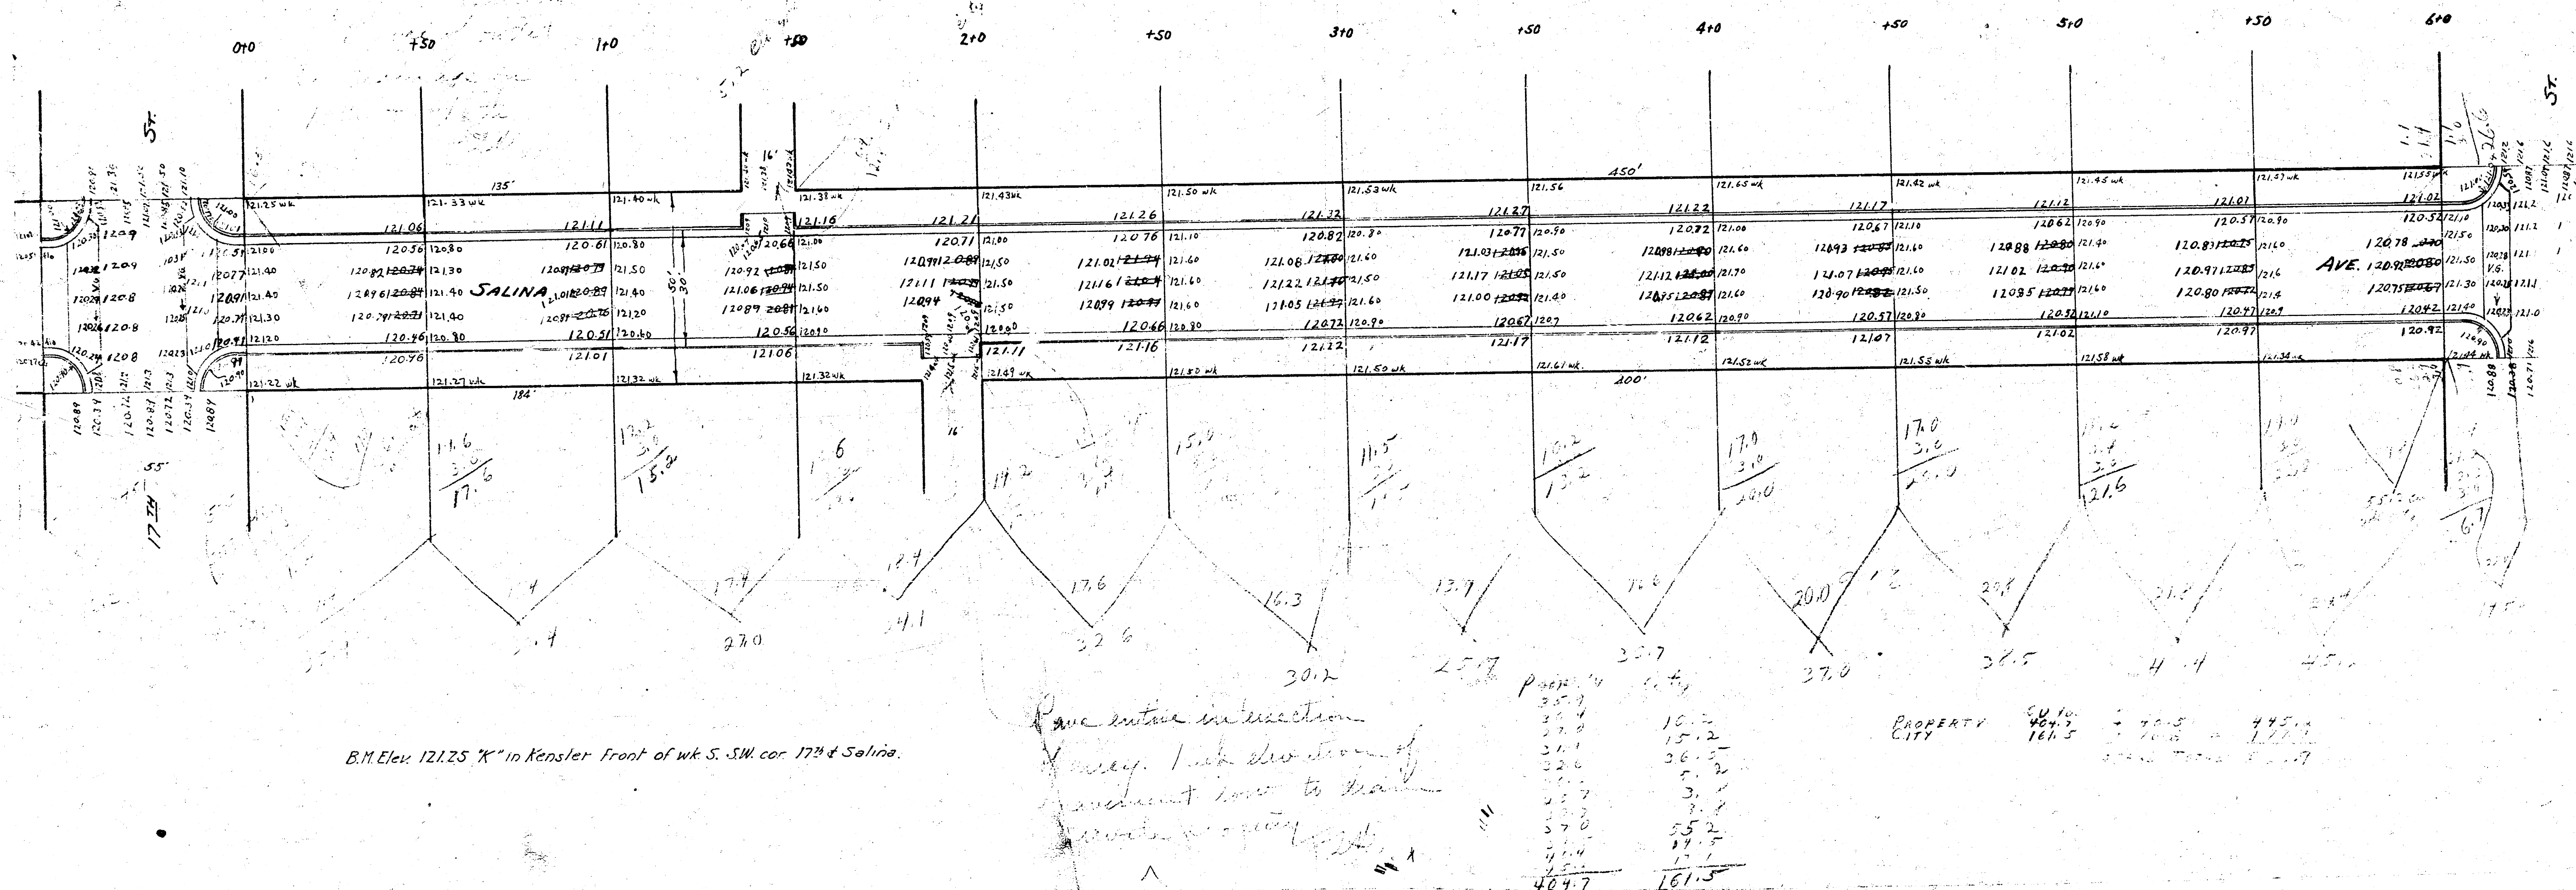


B. M. 121.41 "G" in Globe E.S. Int. S.E. Cor. 17th & Salina

Chain N. on &

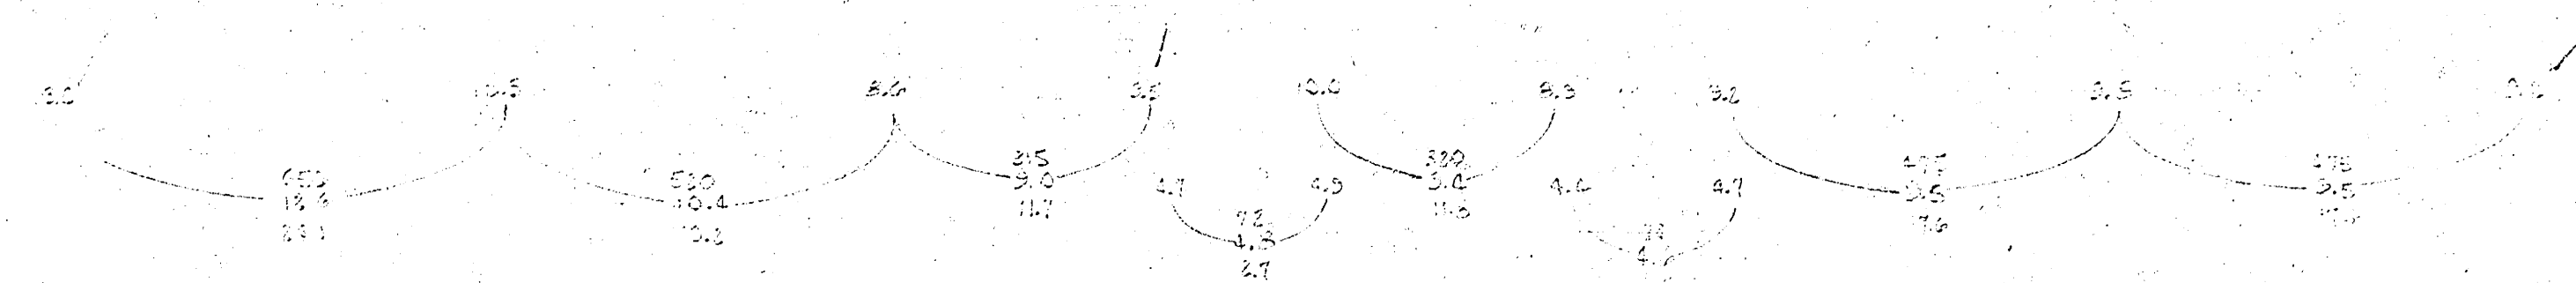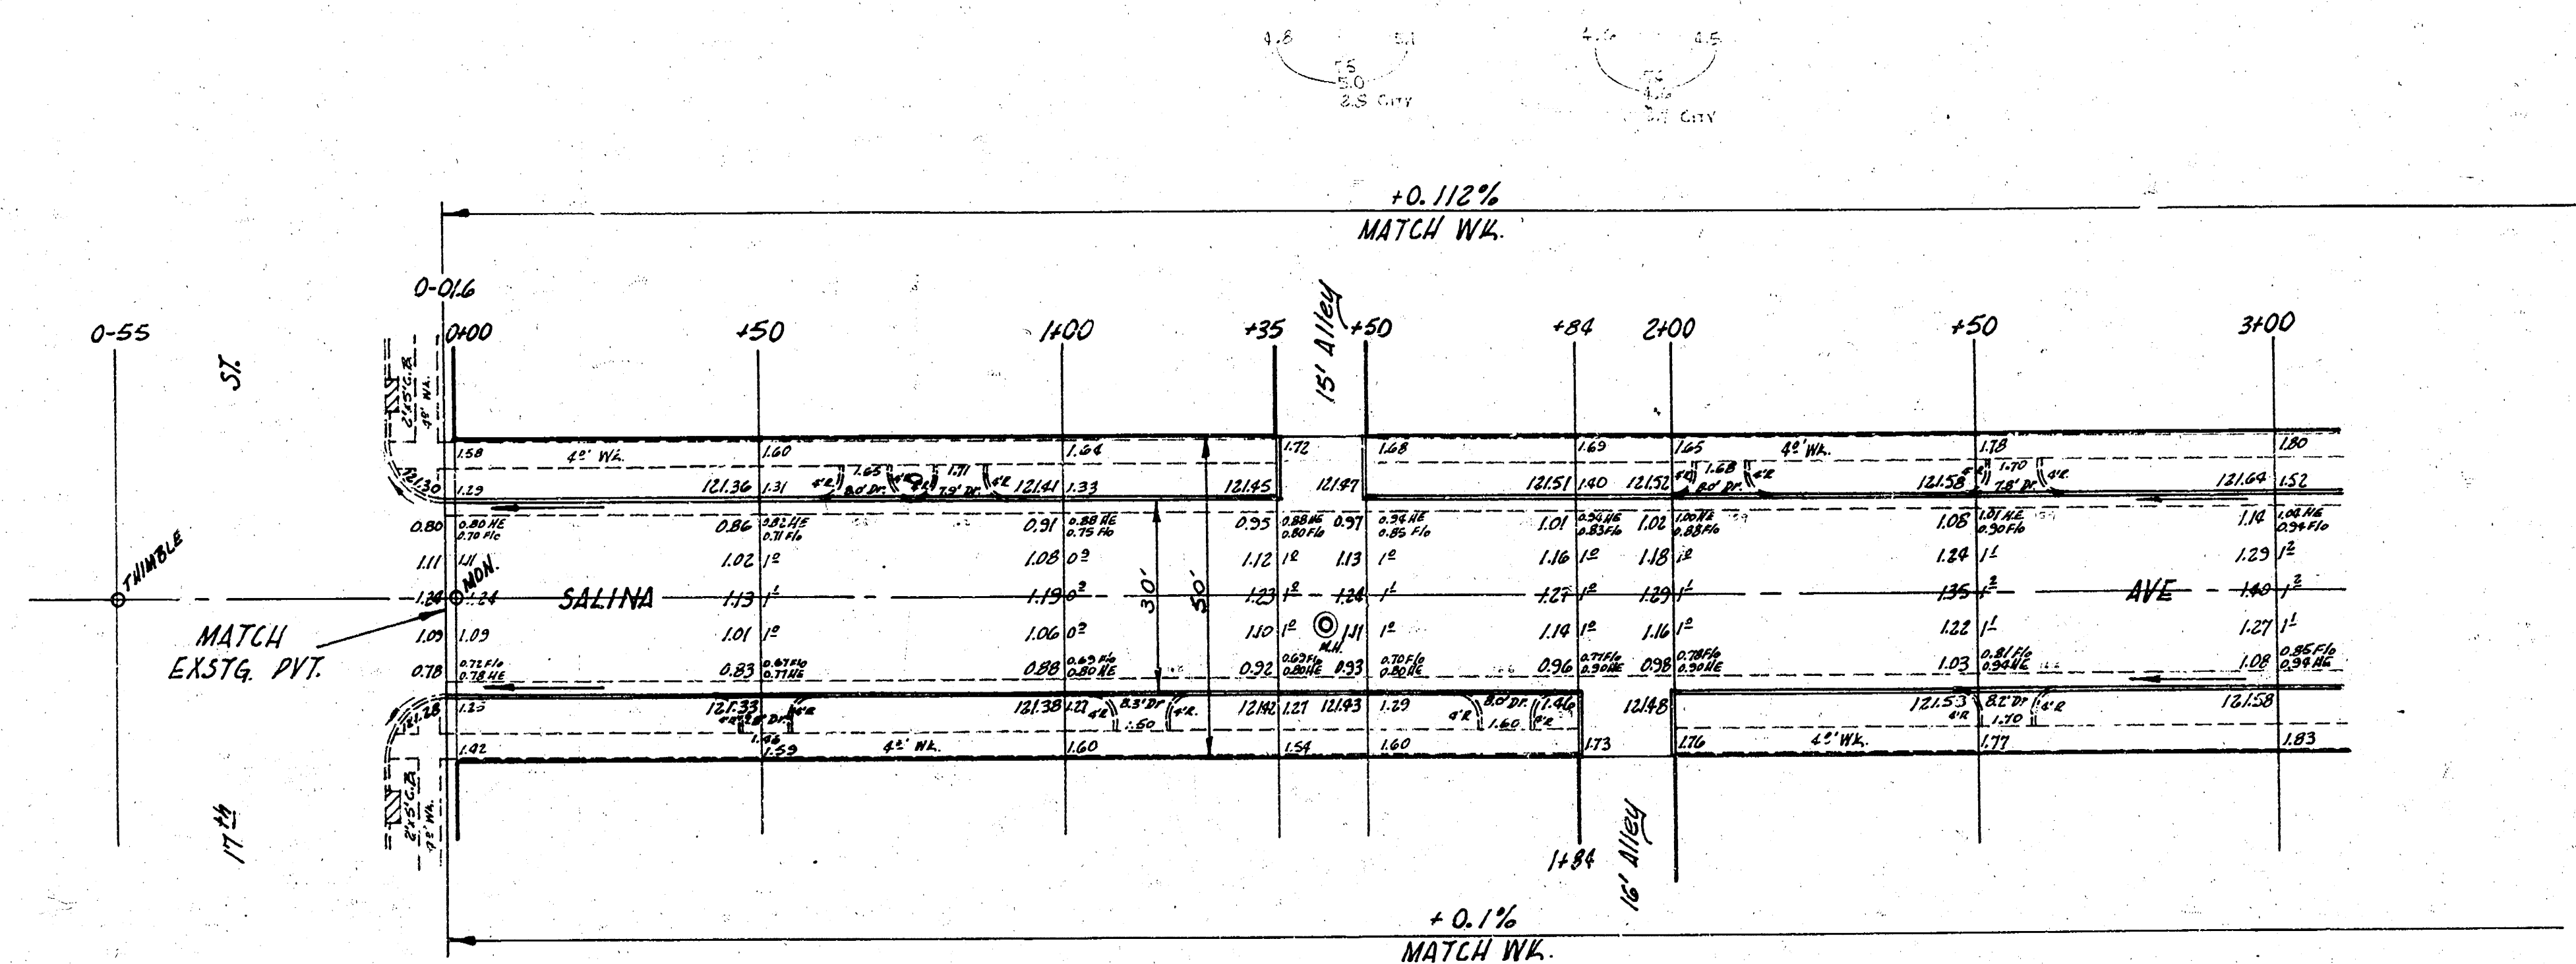

1/2

SALINA AVE.
N.L. 17th - S.L. 18th
30' CONC. & C.B.
CITY OF WICHITA, KANS.
B.E. SMITH CITY ENGINEER
OCT., 1954 PROJ. NO. C14-266

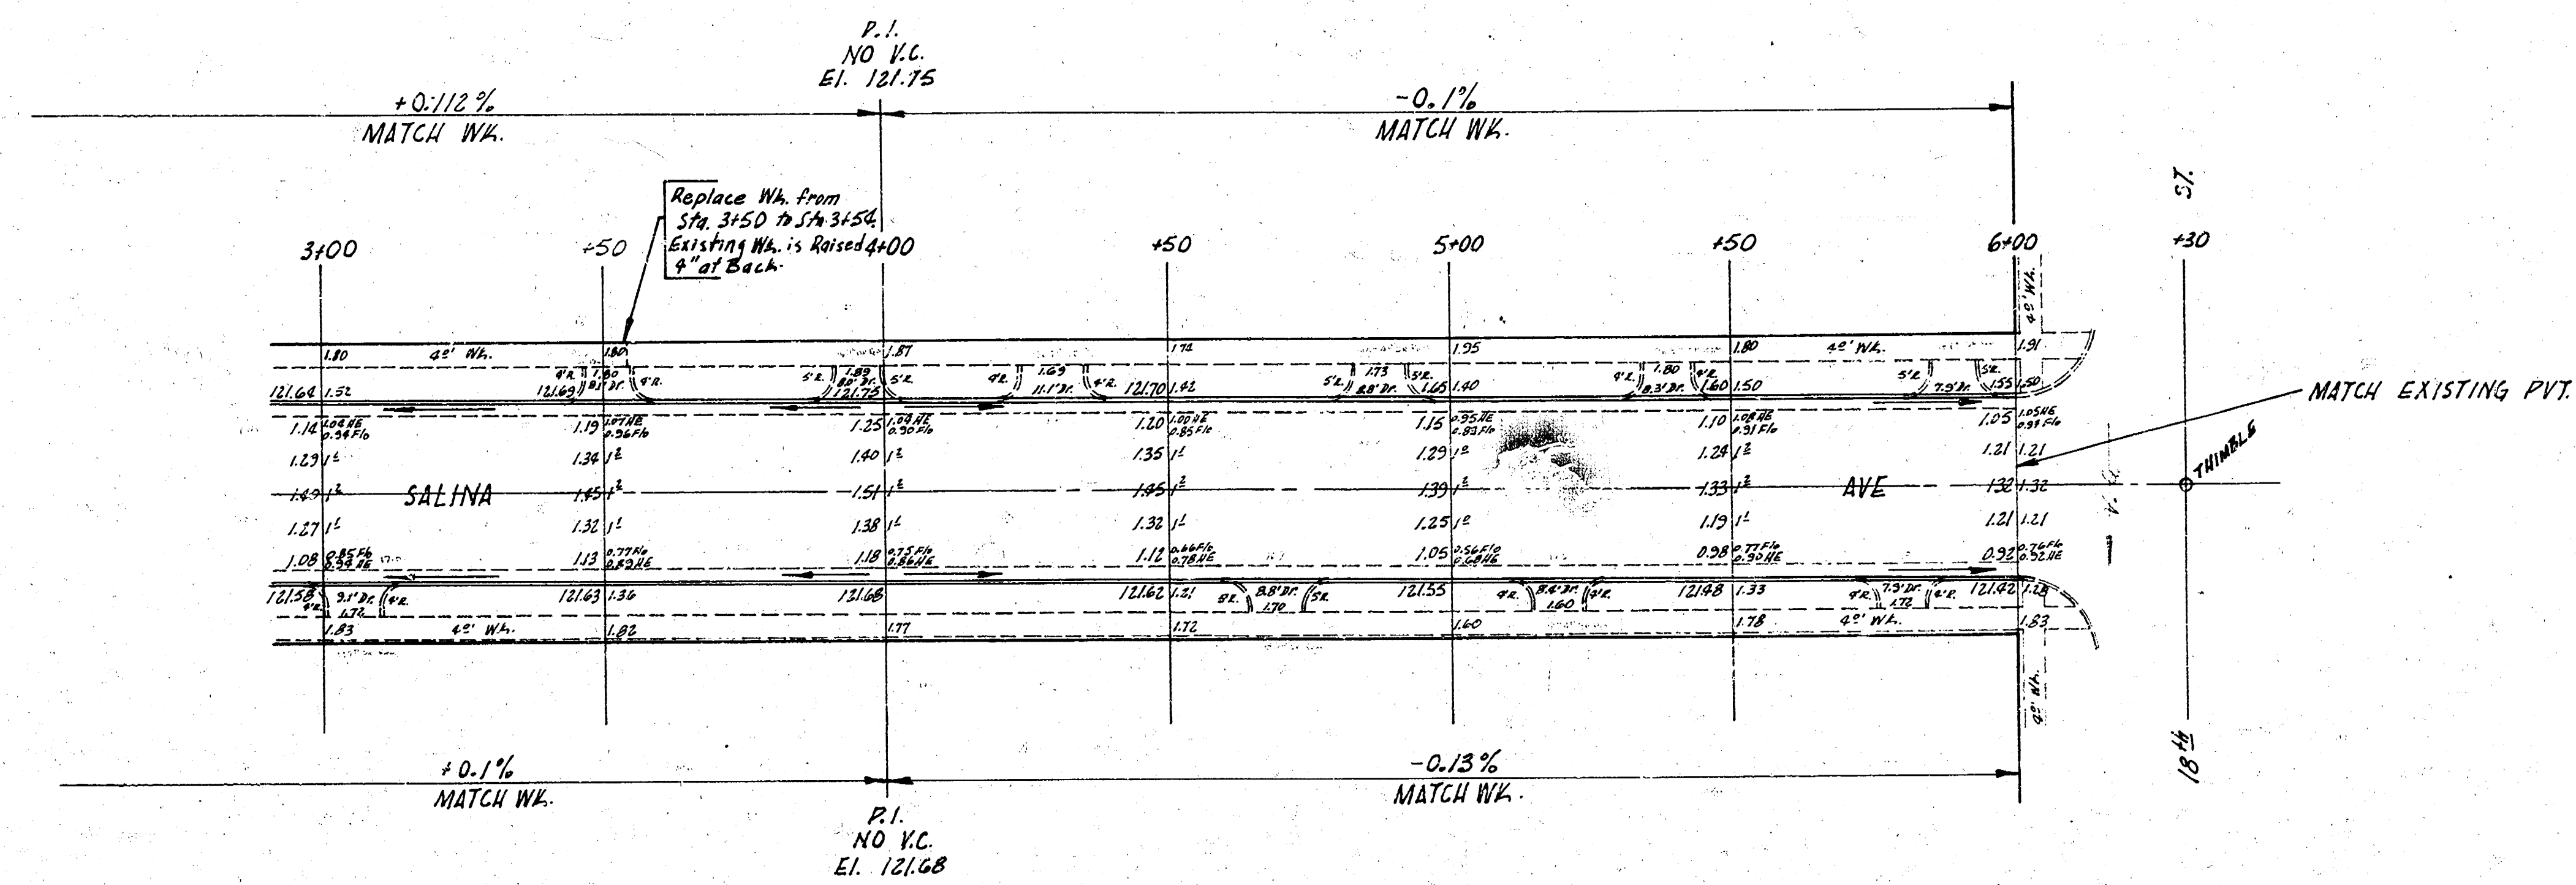

2/2

SALINA AVE.
PROJ. NO. C14-266