SALINA AVE N.L. 14TH to S.L. 17TH 30' Conc. Int. cb.4

B.M. Elev. 118.45 "D" in Mixed Conc Co. N.W. 14TH & Burns
" " 119.72 "G" in Globe N.L. 14TH @ Salina.

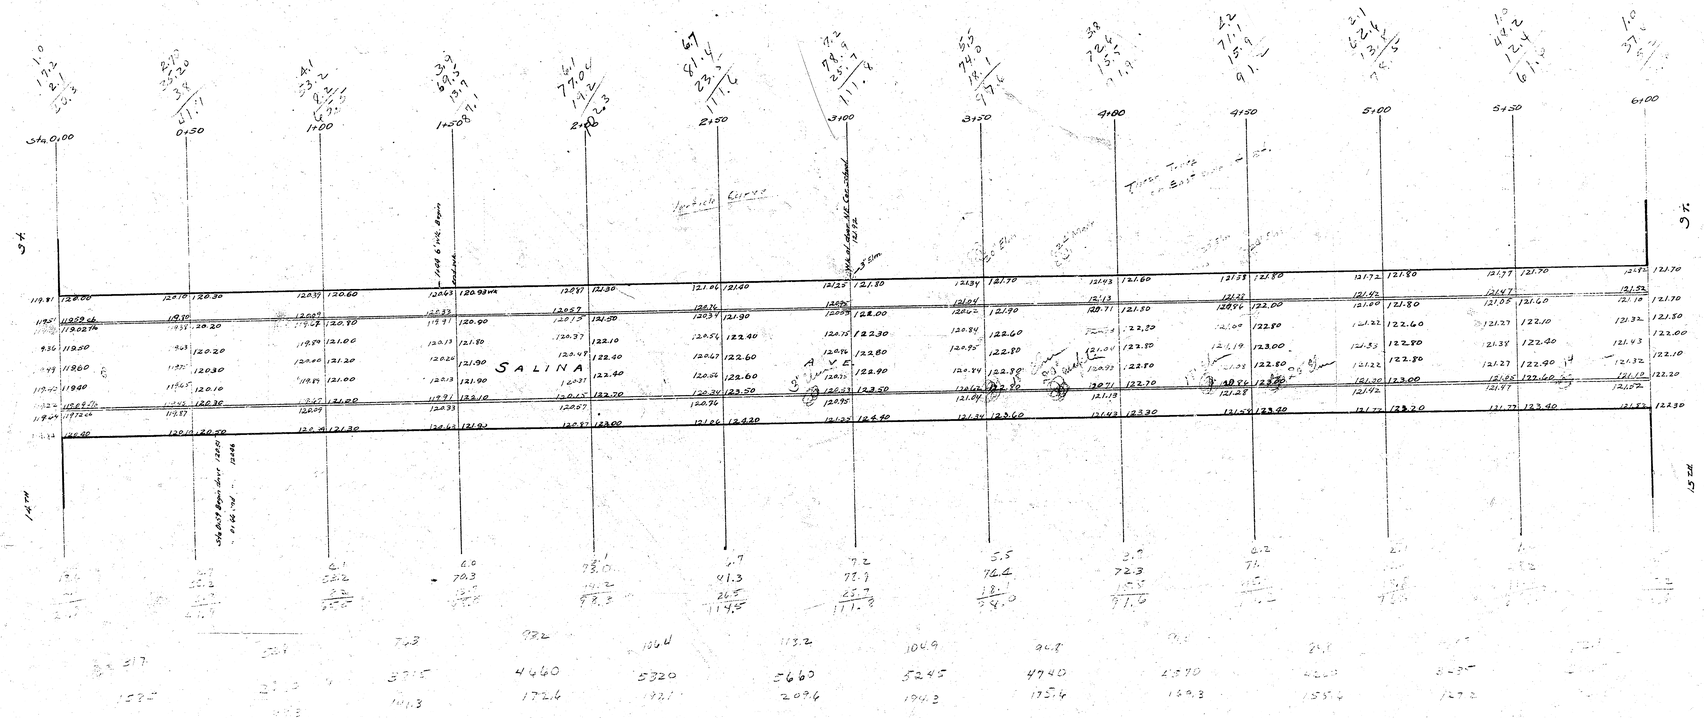

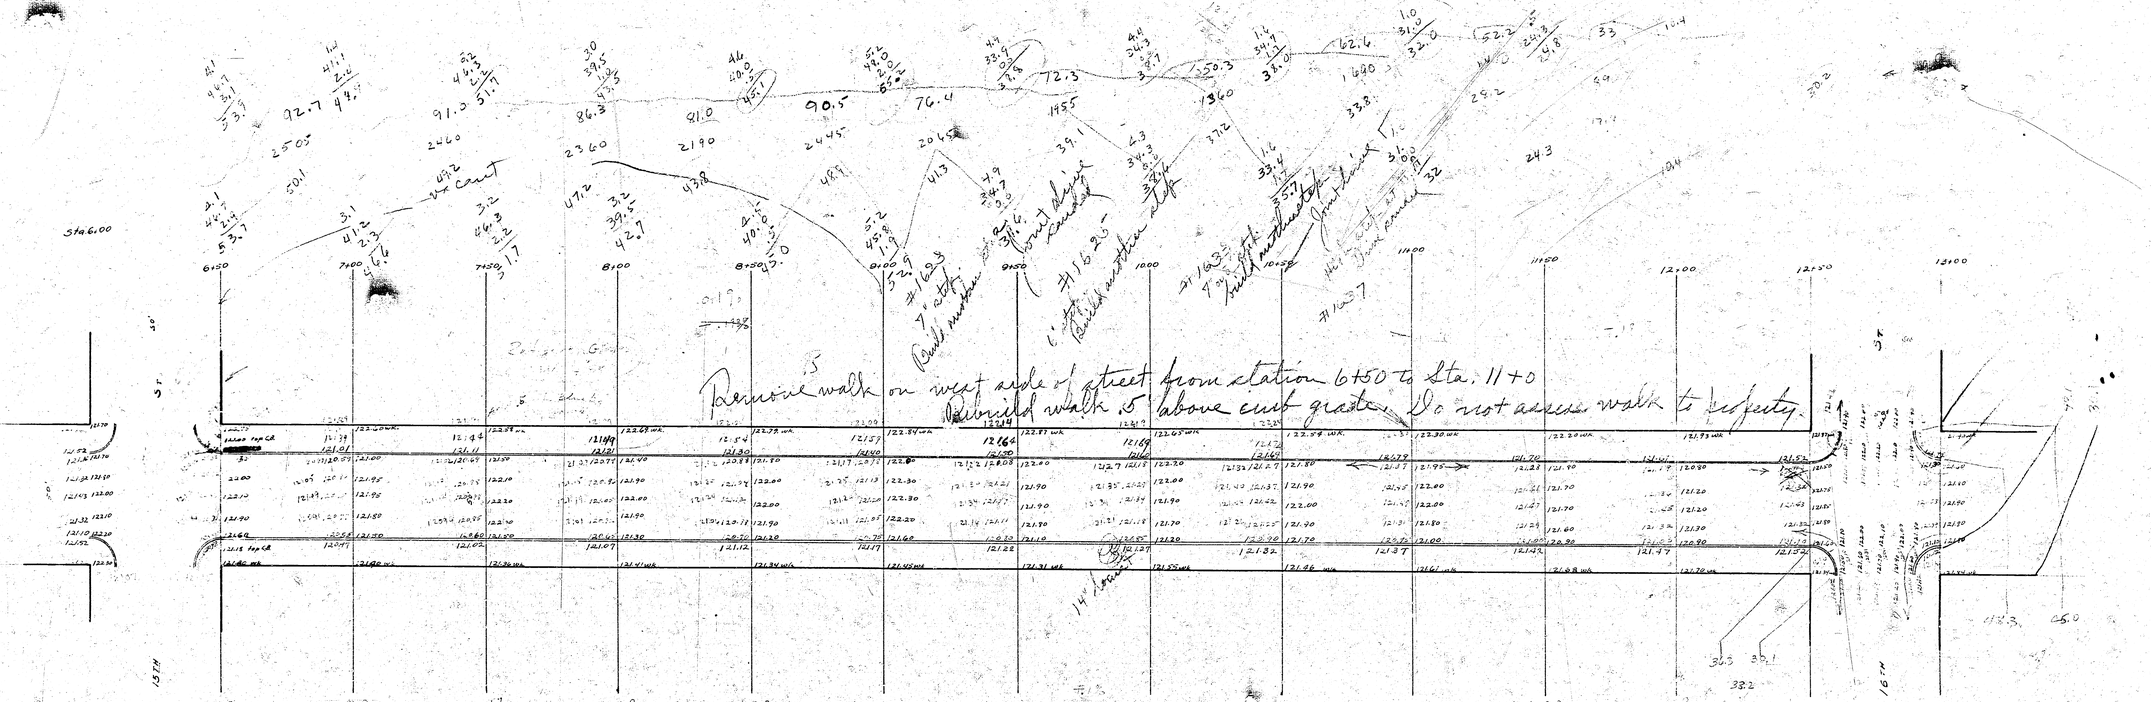
Remove walk on west side of street from station 6+50 to Sta. 11+0
Rebuild walk .5' above curb grade. Do not assess walk to property.
Sta 6.00
6+50
7+00
7+50
8+00
8+50
9+00
9+50
10+00
10+50
11+00
11+50
12+00
12+50
13+00

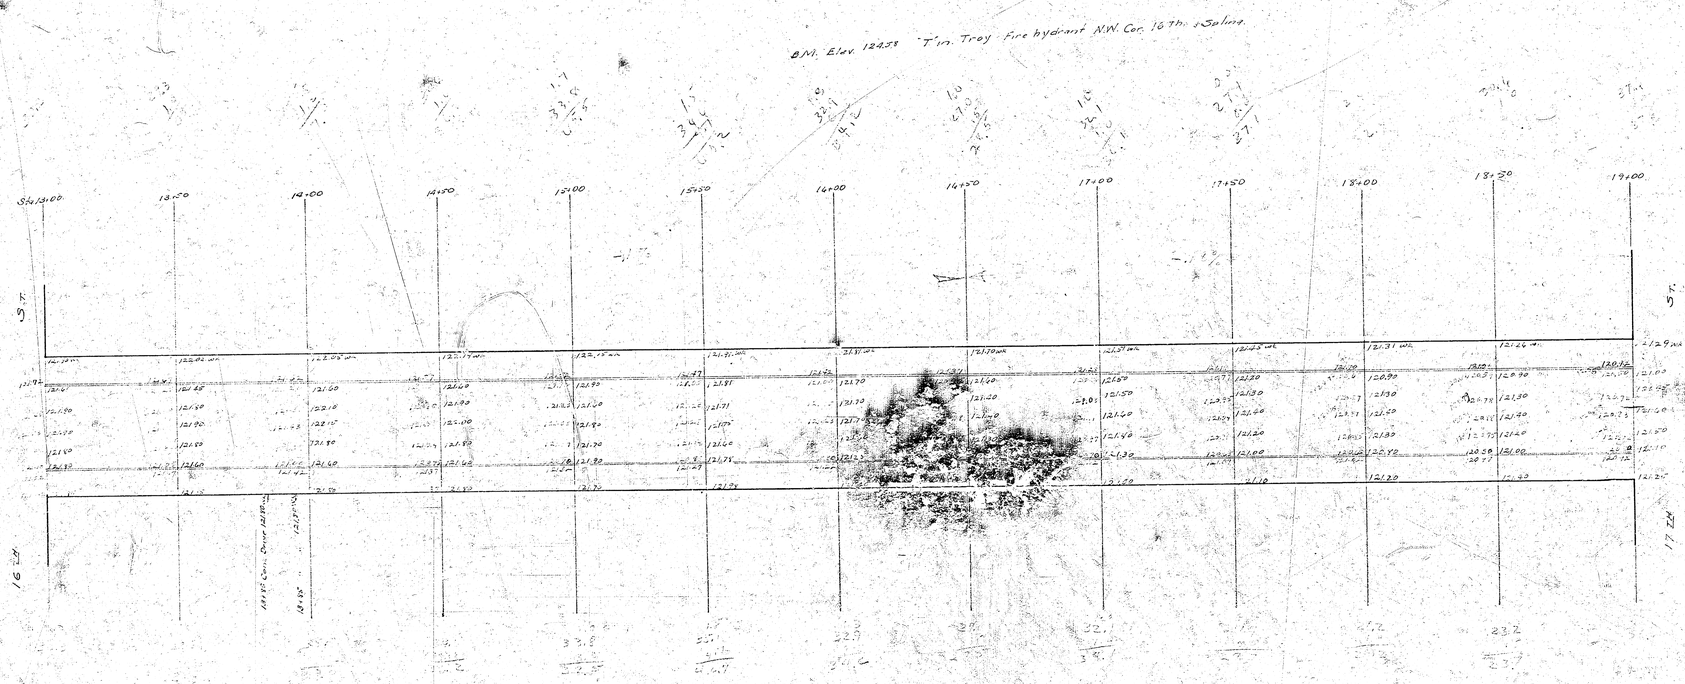
B.M. Elev. 124.38 T'in. Troy Fire hydrant N.W. Cor. 16th. & Salina.
13+00
13+50
14+00
14+50
15+00
15+50
16+00
16+50
17+00
17+50
18+00
18+50
19+00
16 St.
17 St.