




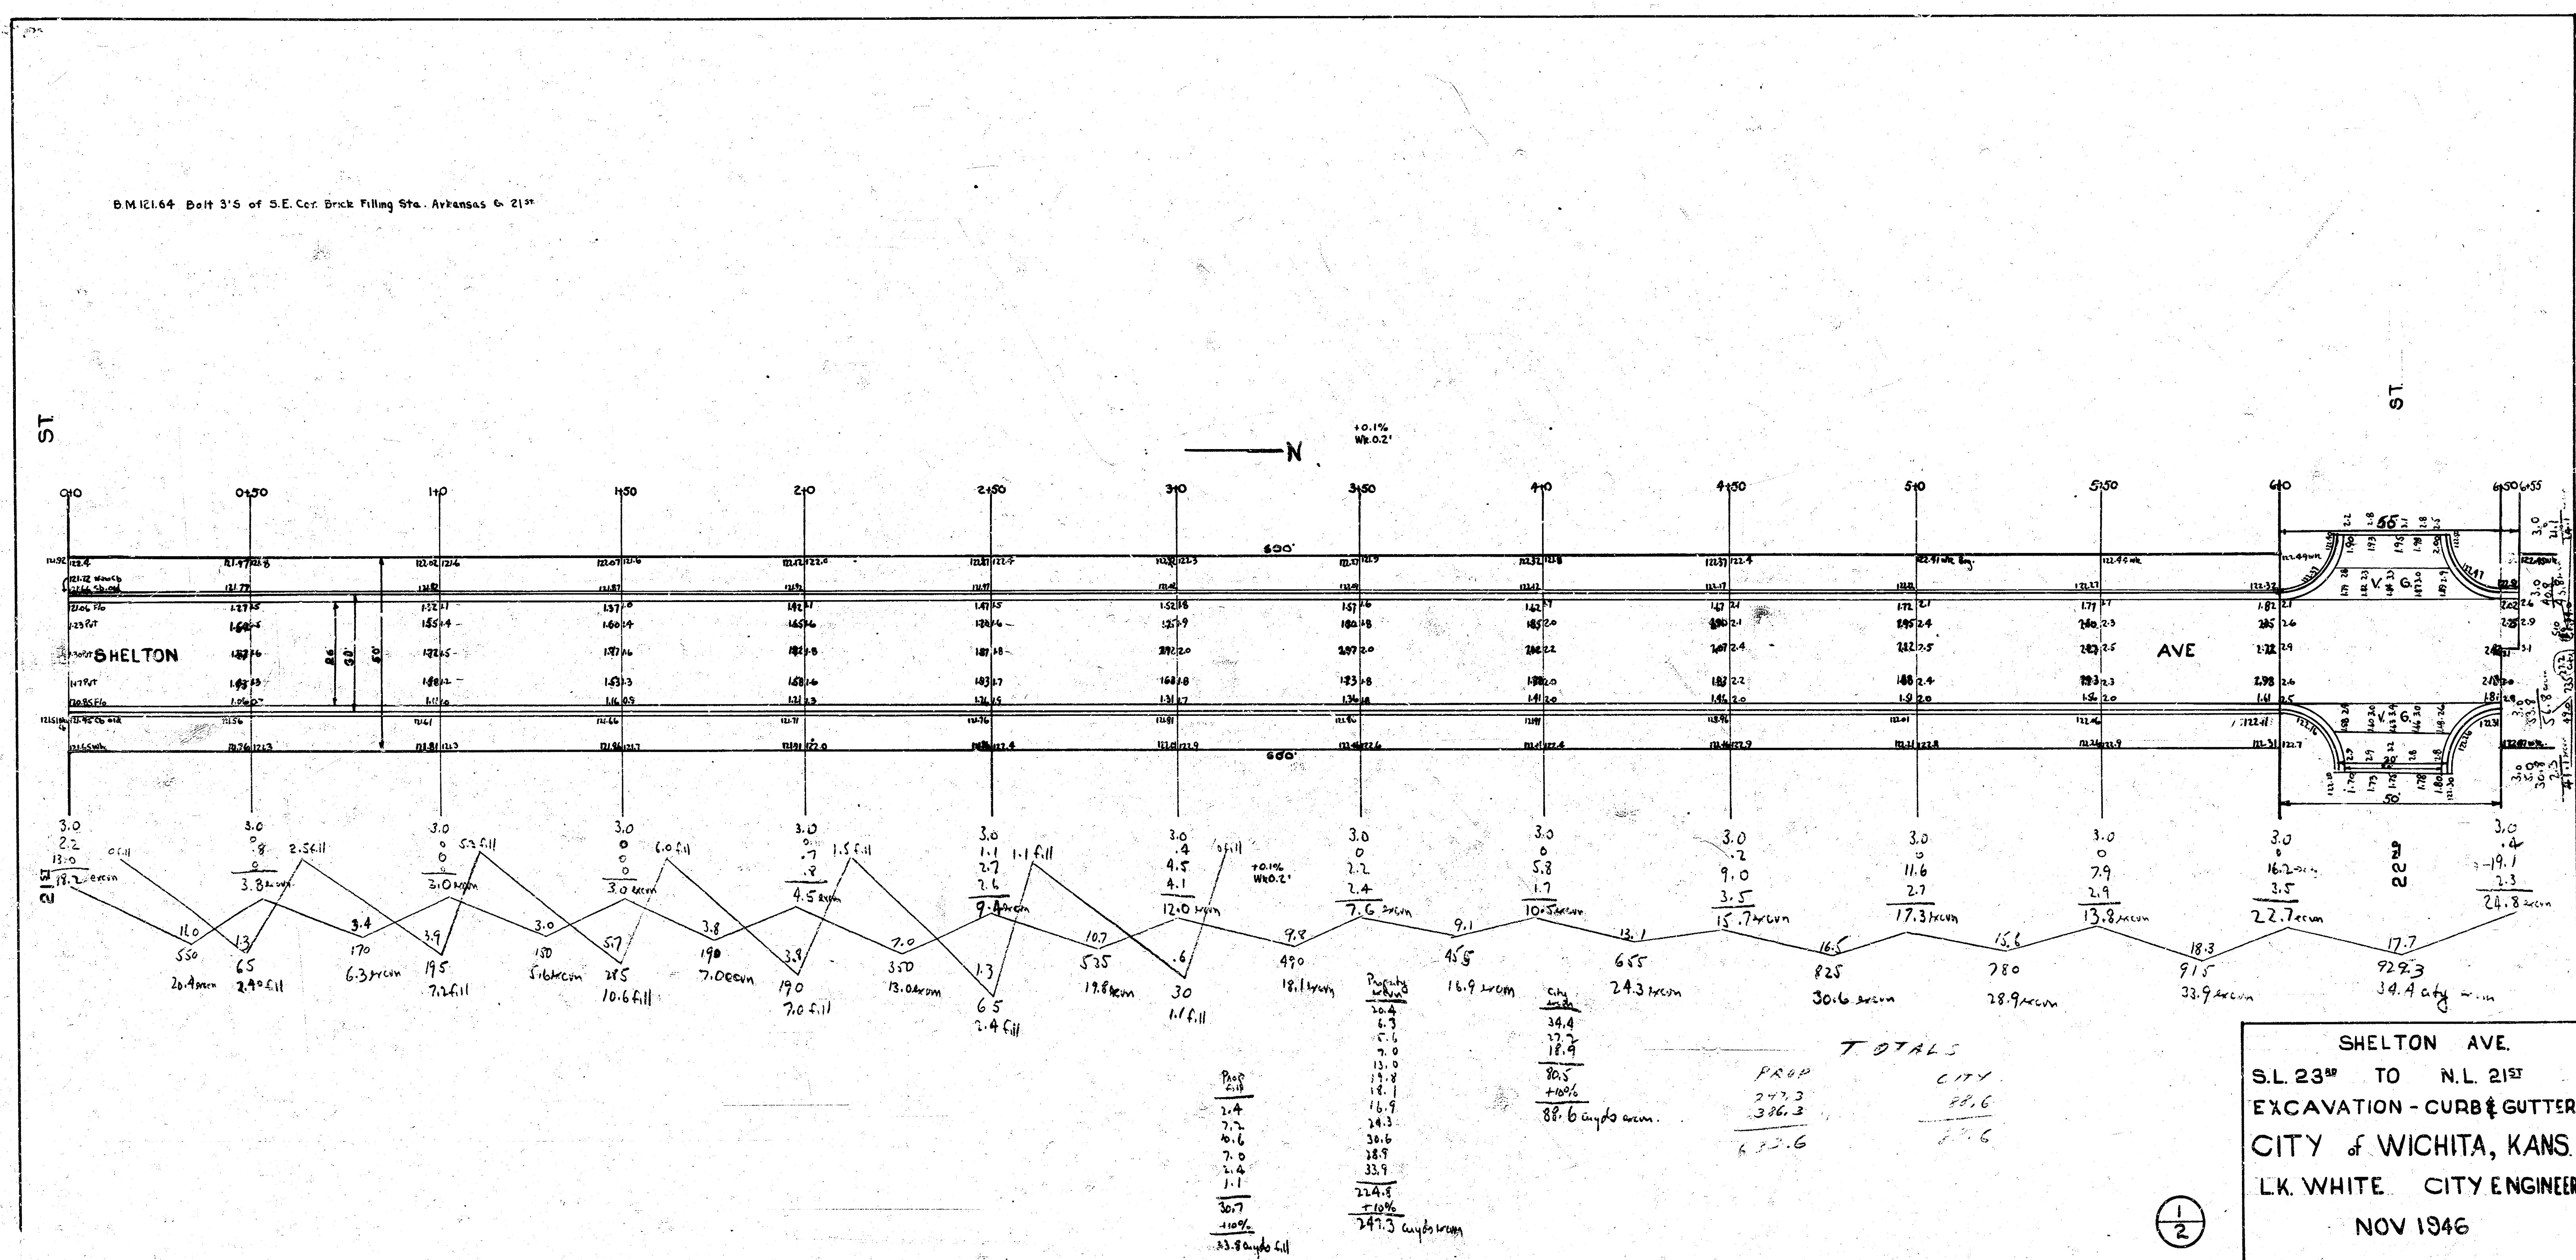

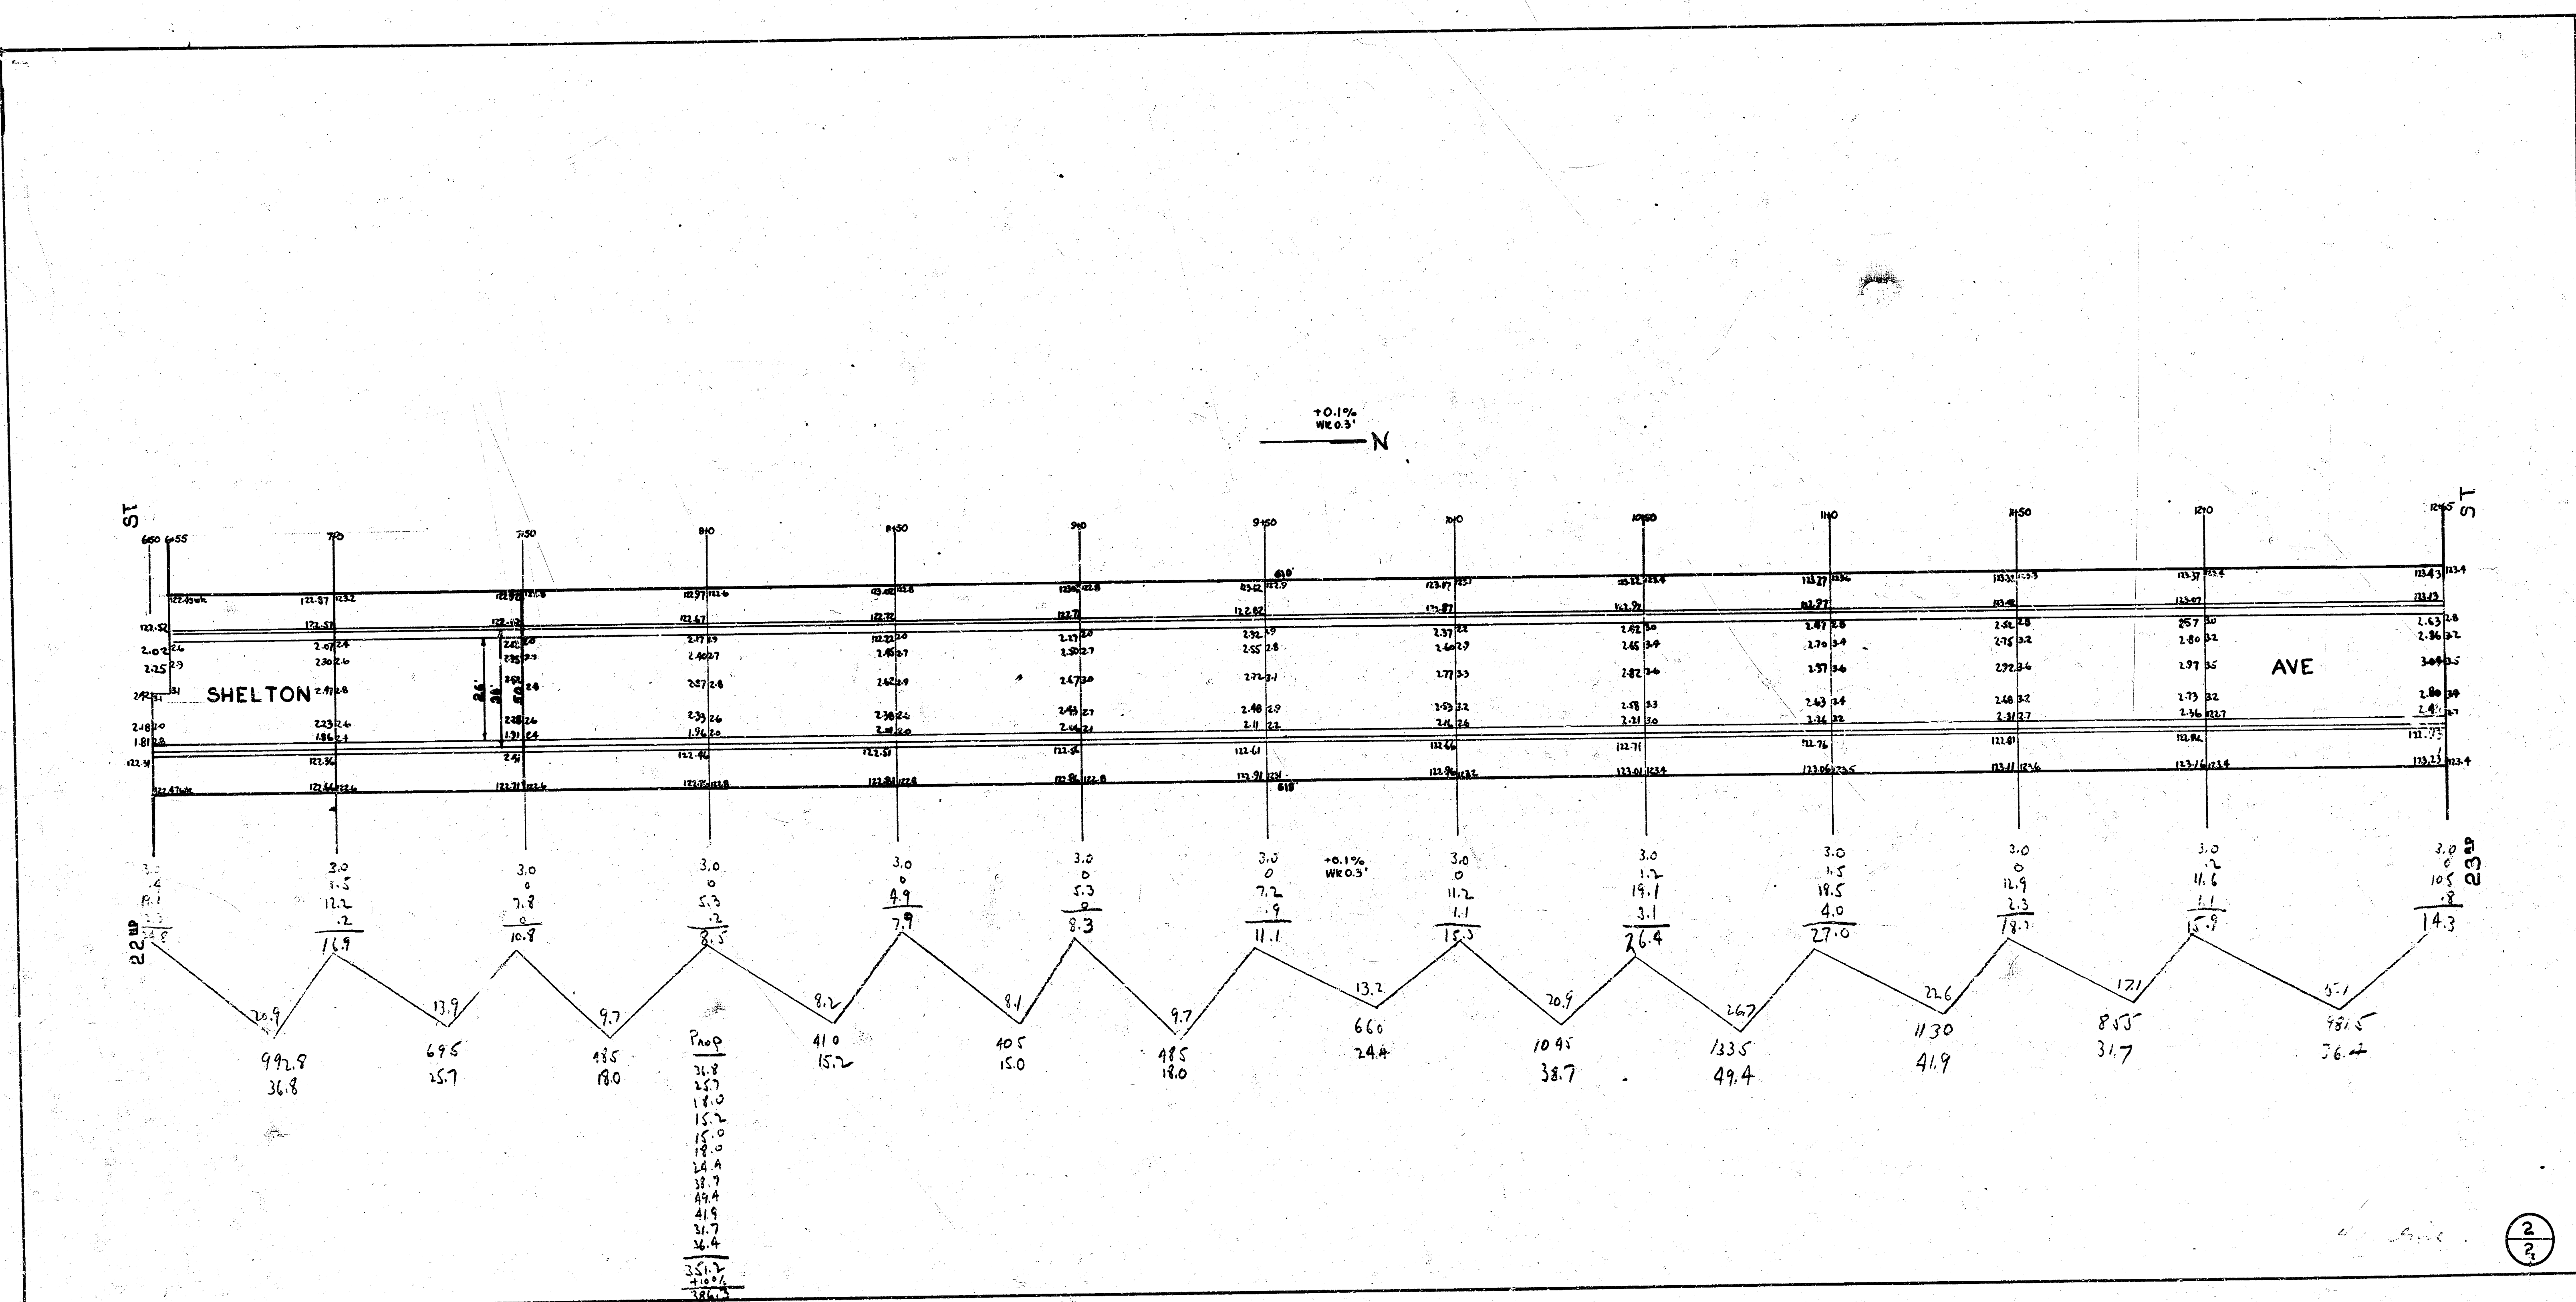

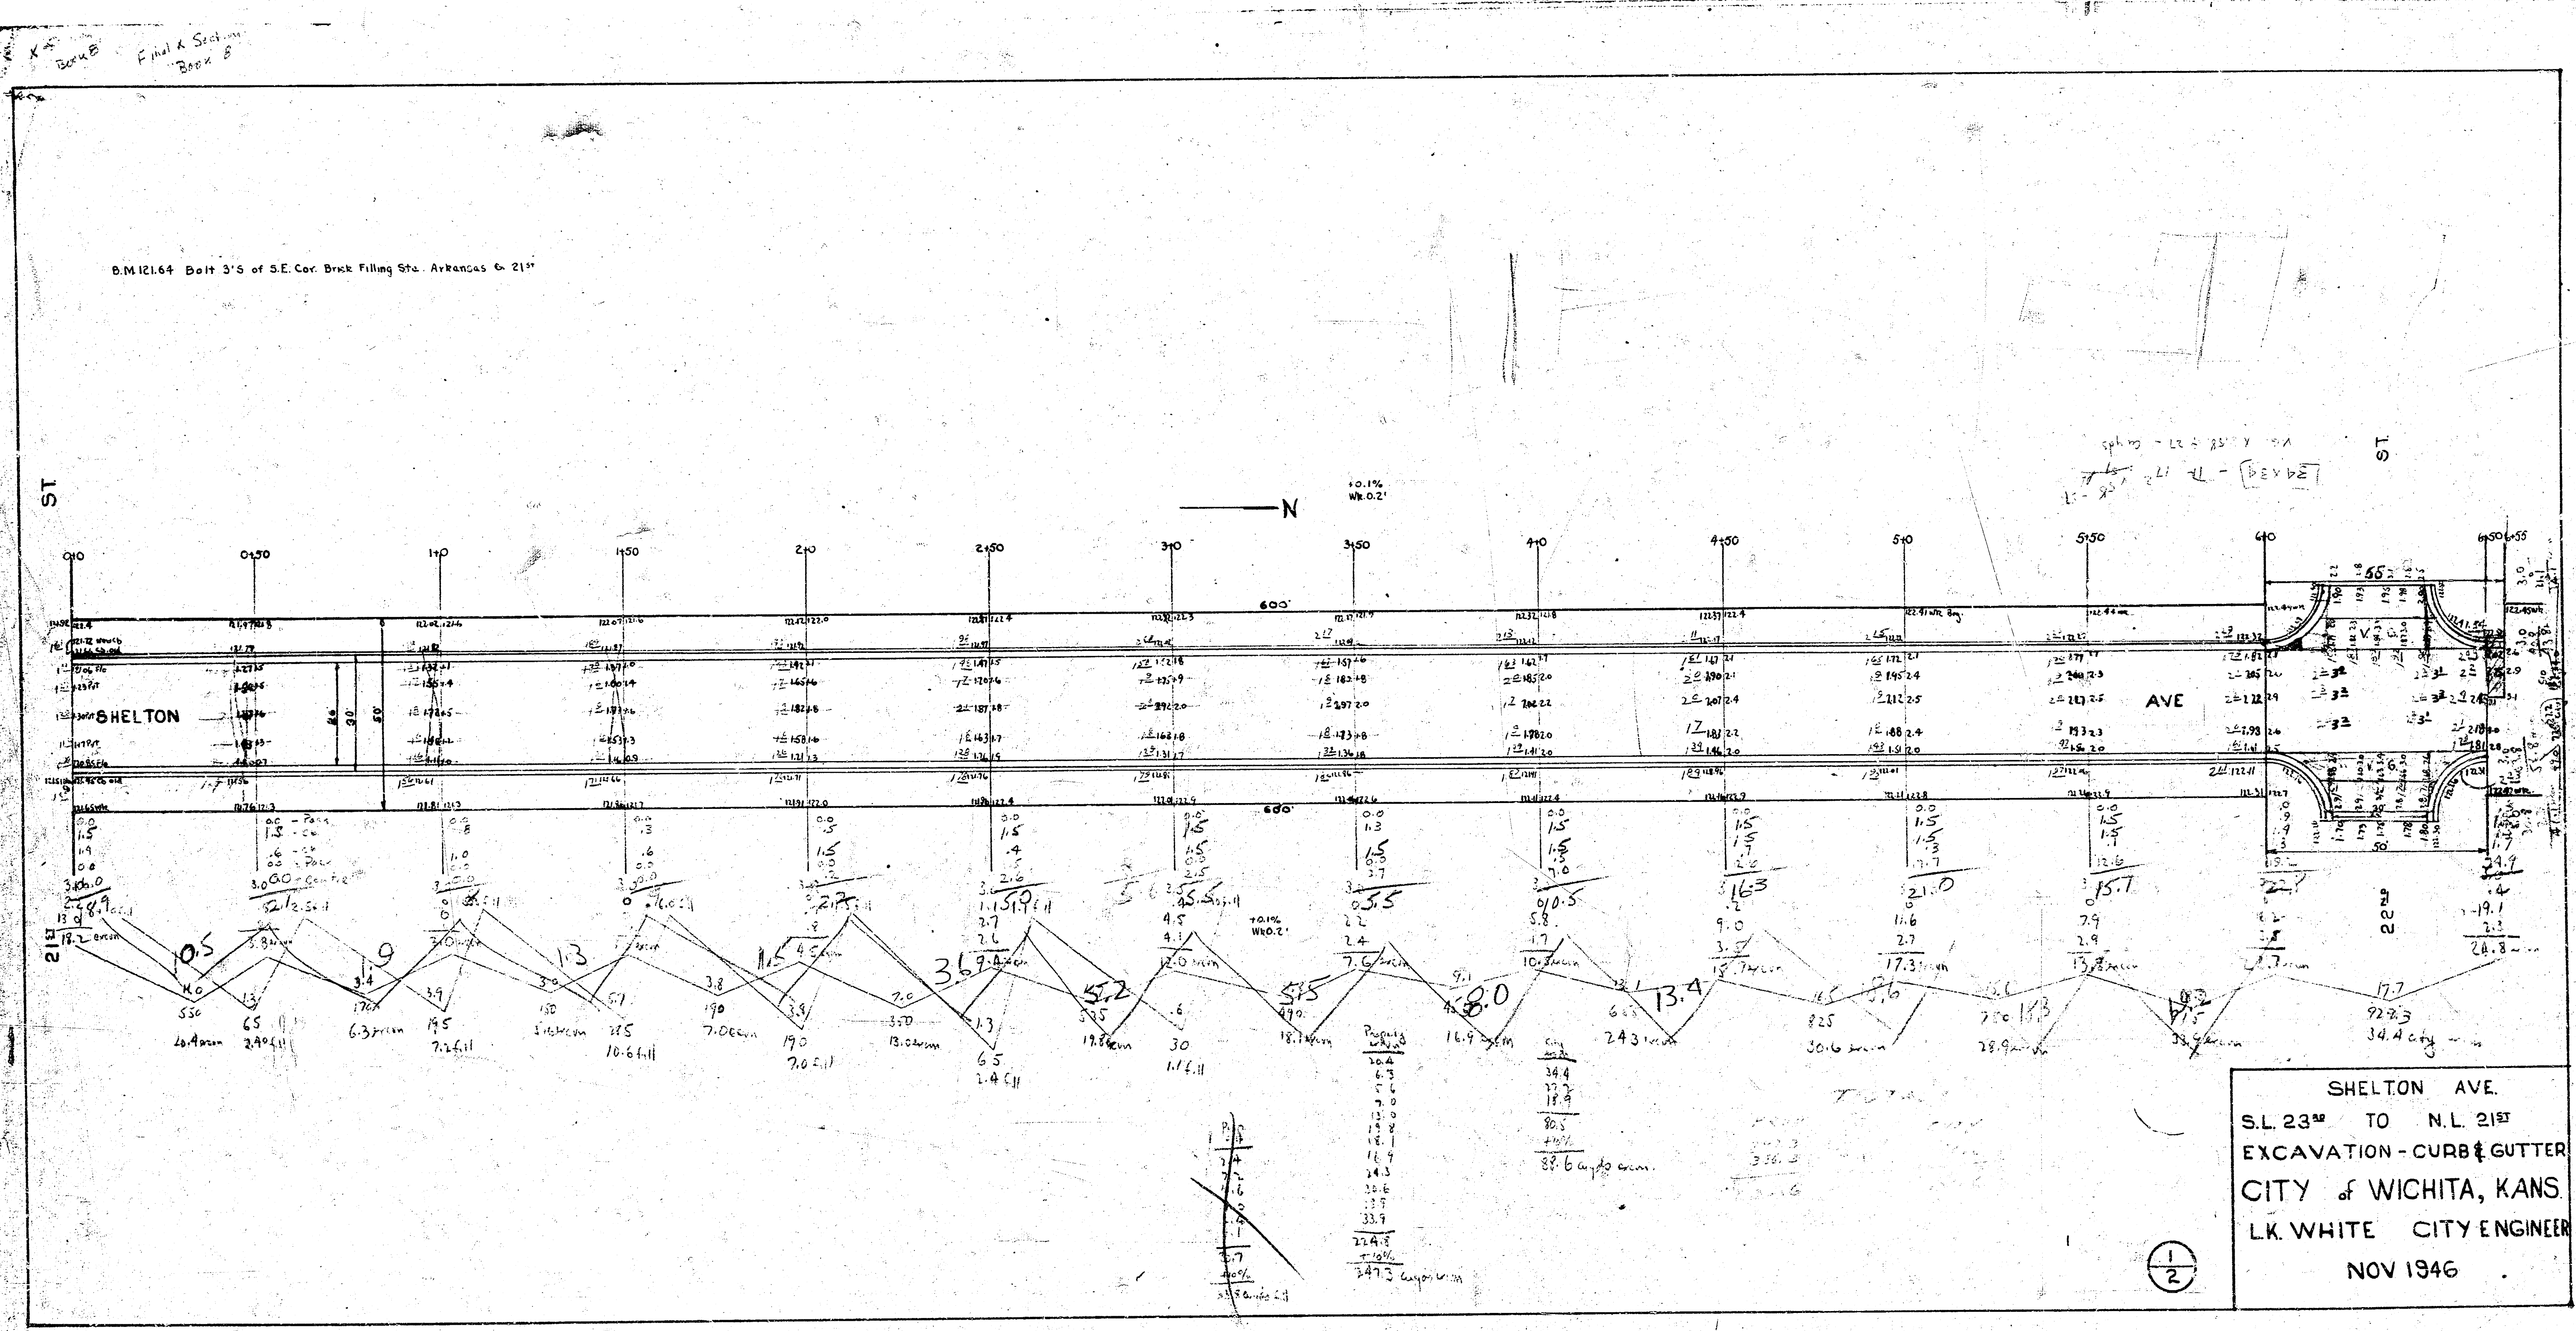


10.1%
WE 0.3'

