





B.M. 123.89 "X" Top ch. W.S. Shelton S.L. 24"

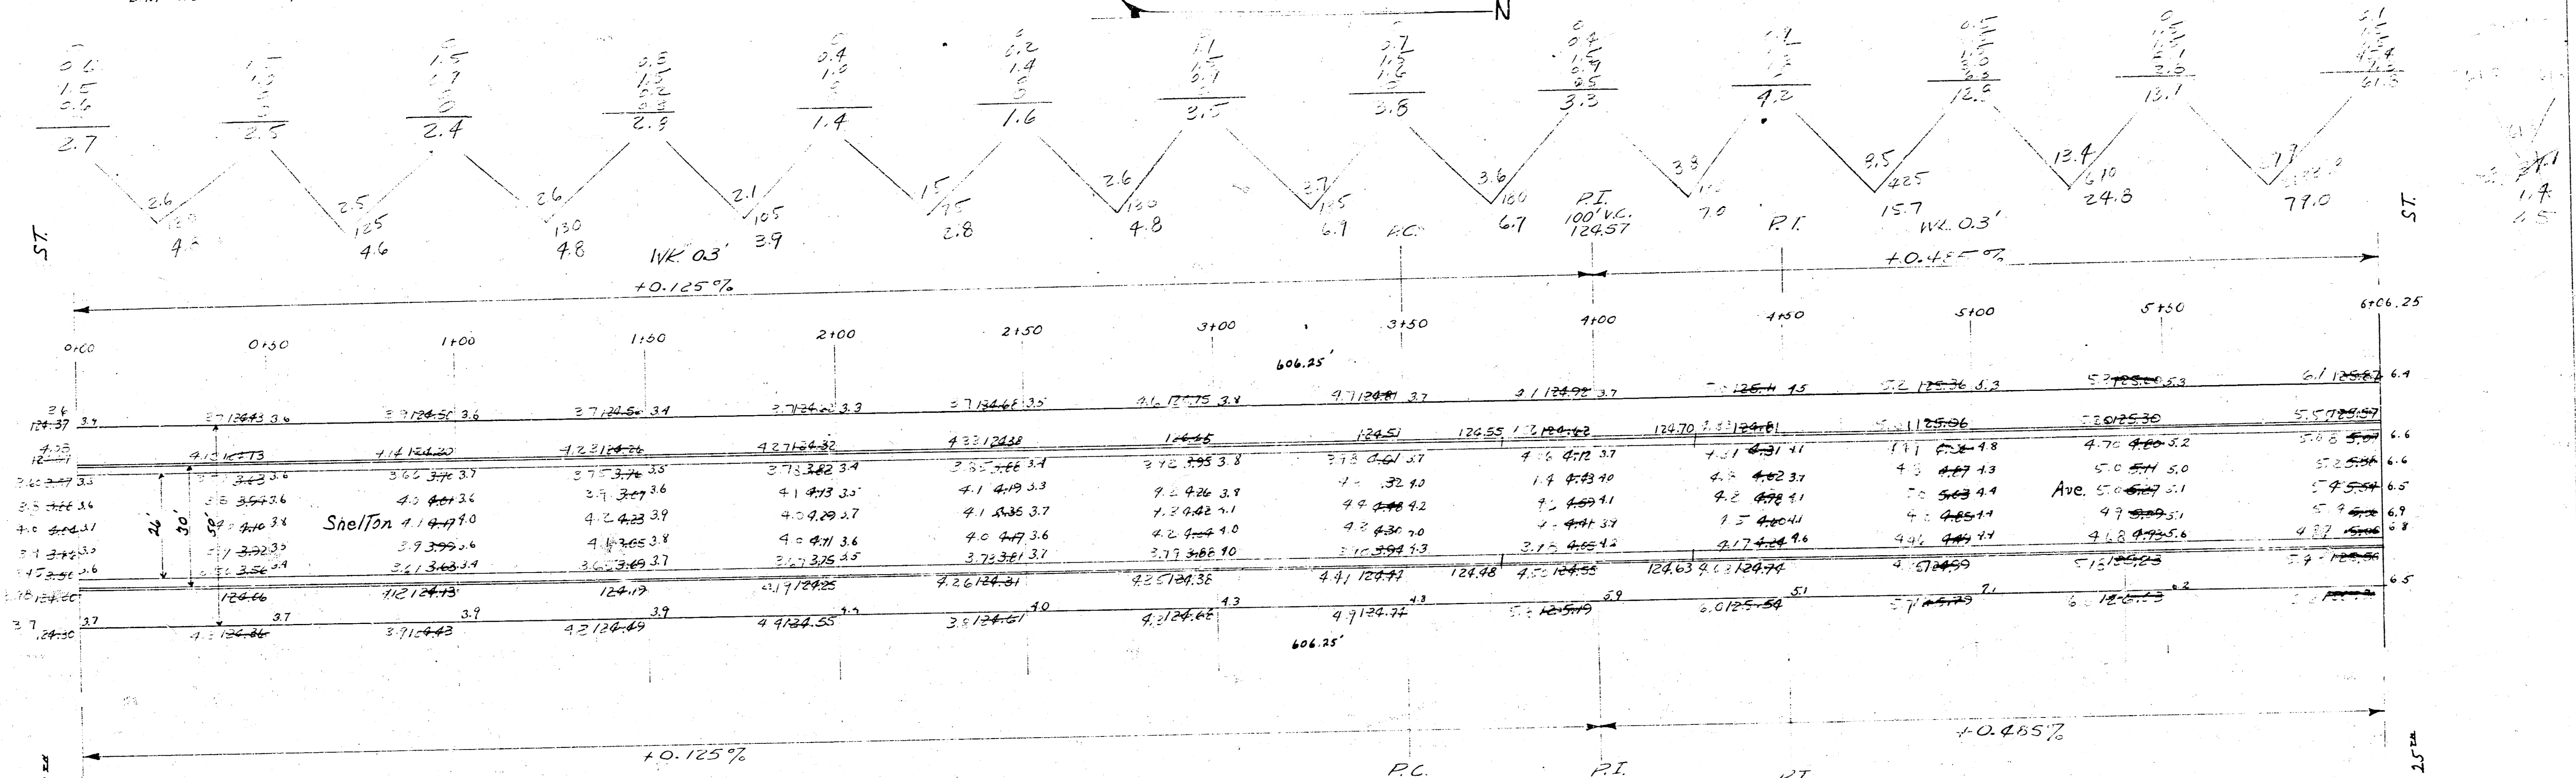


Shelton Ave.  
 N.L. 24" S.L. 25"  
 Comb Ch & Gtr.  
 City of Wichita, Kansas  
 L. M. White City Engineer  
 July 1948 Project C18-94

B.M. 123.89 "X" Top of W.S. Shelton S.L. 24<sup>th</sup>

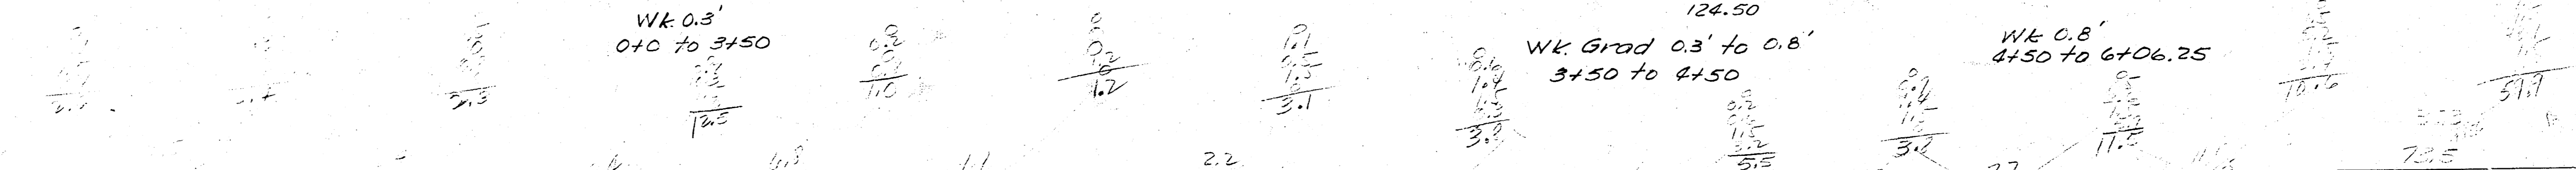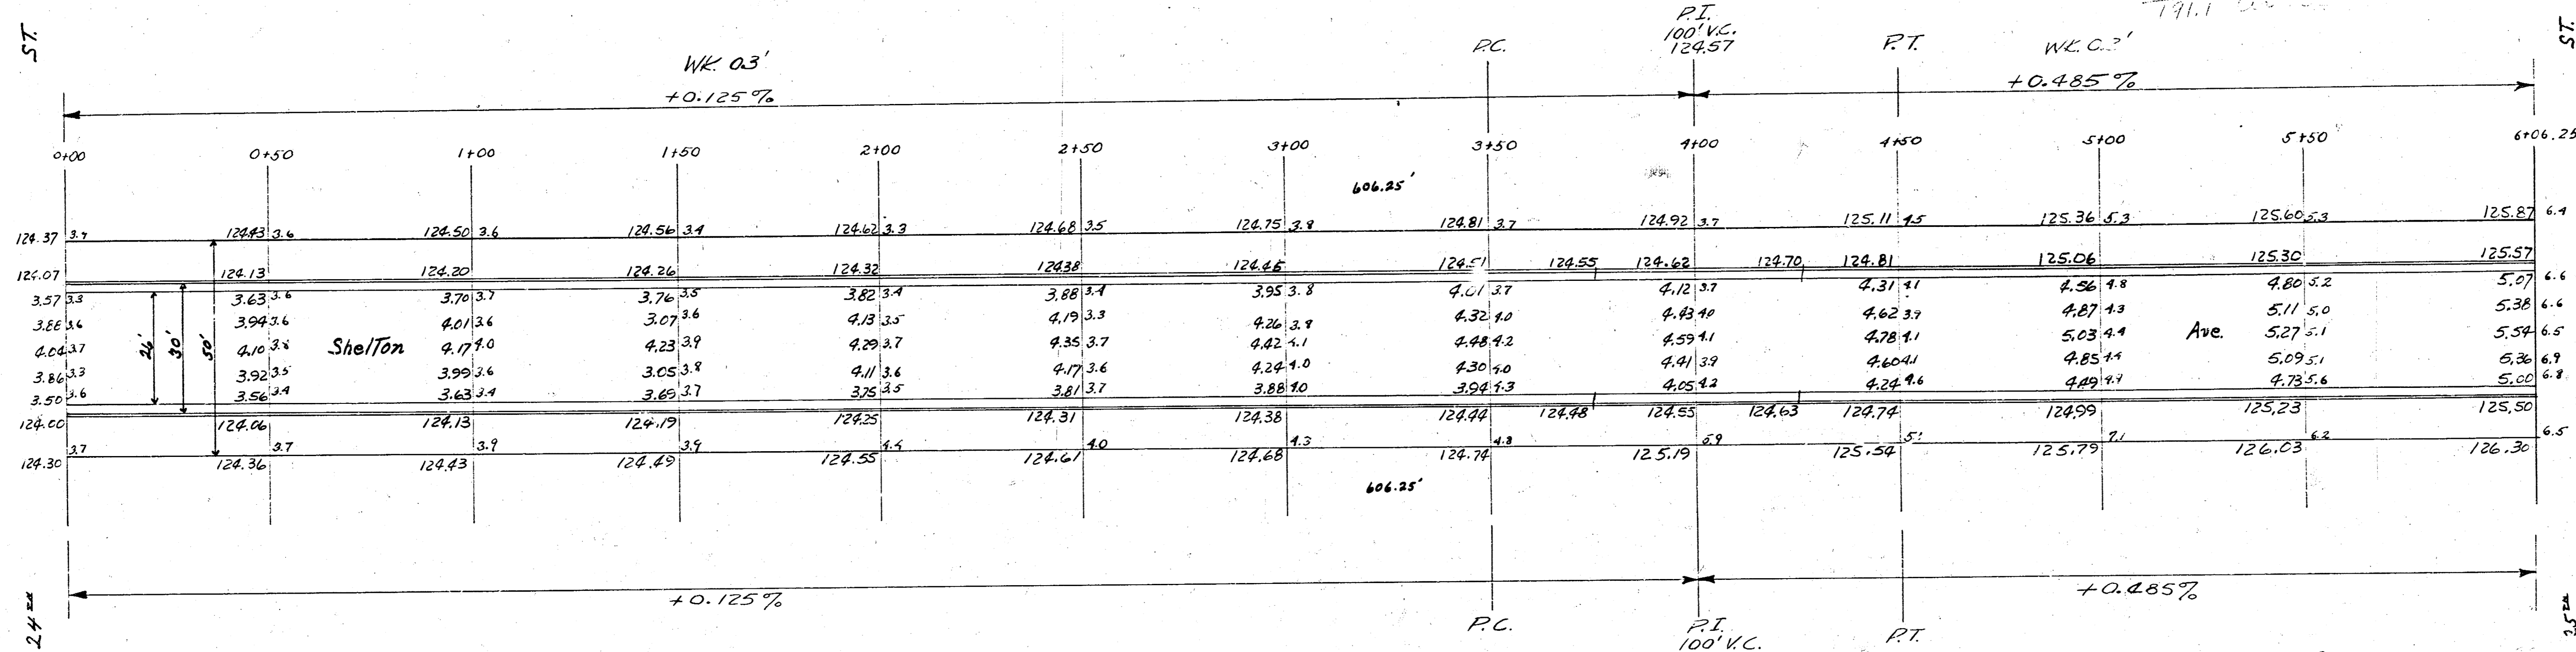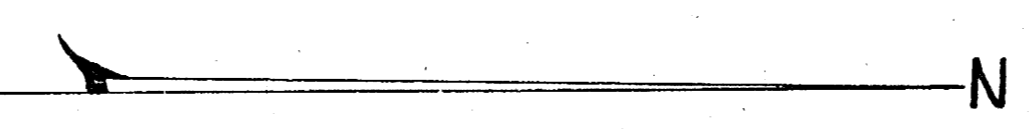

Shelton Ave.  
 N.L. 24<sup>th</sup> SL. 25<sup>th</sup>  
 Comb. Cb. & Gtr.  
 City of Wichita, Kansas  
 L.K. White City Engineer  
 July 1948 Project C18-94