




B.M. 103.55 N.W. Cor. Conc. Pave. Ho. # 302 S. EMPORIA
CHAINING E. ON E

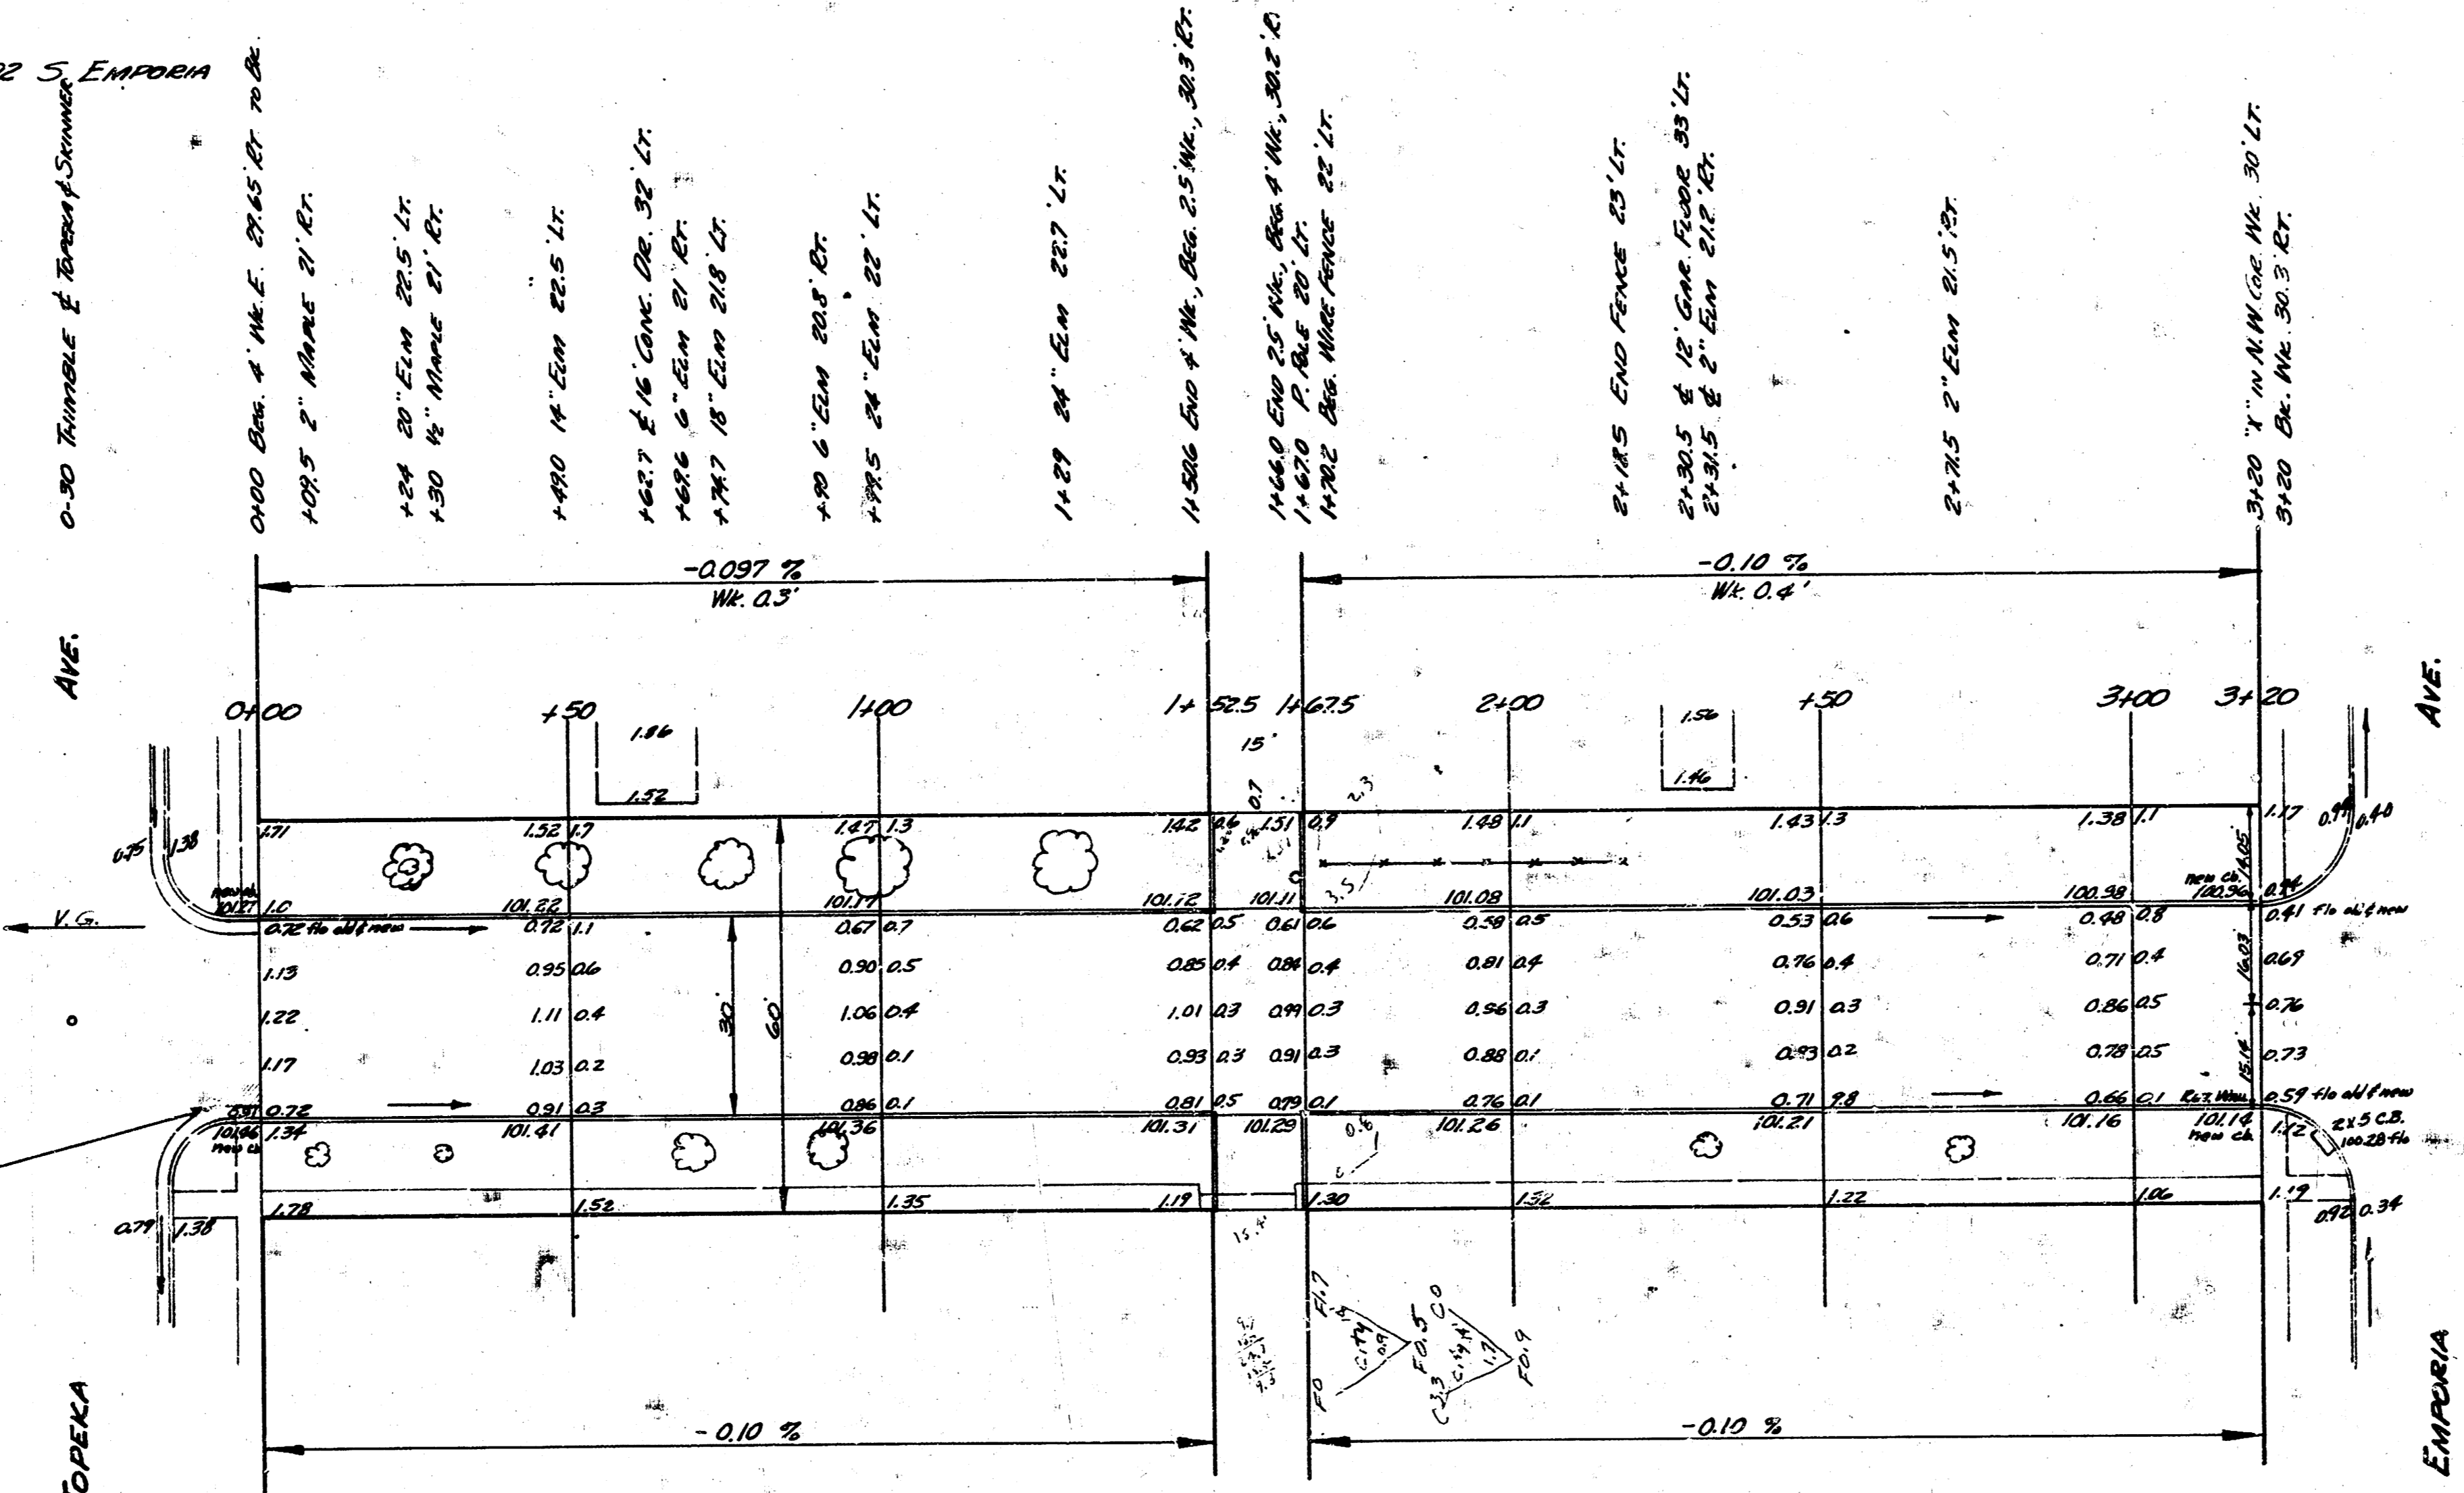

NOTE
REMARKS NECESSARY
AMOUNT OF FINISH
TO BEING TO GROUND

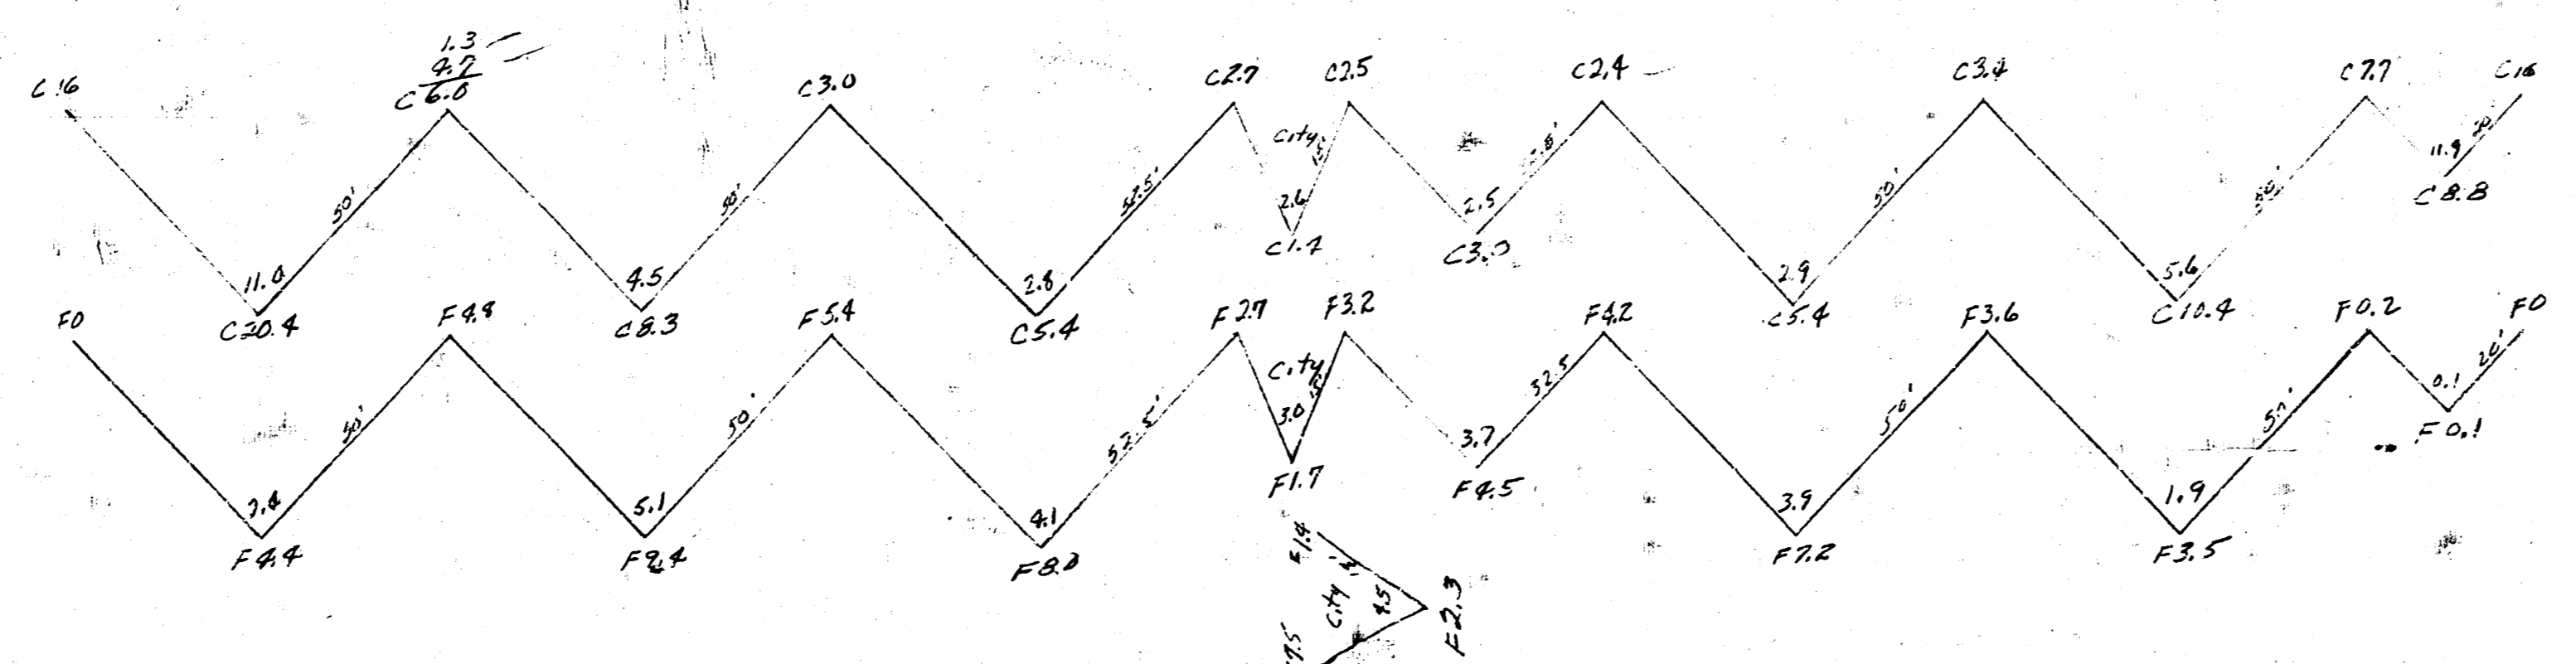

Prop	Excavation	City	EA
6.7	1.5	1.5	4.9
6.7	3.7	3.7	5.5
6.7	16.8	2.1	5.4

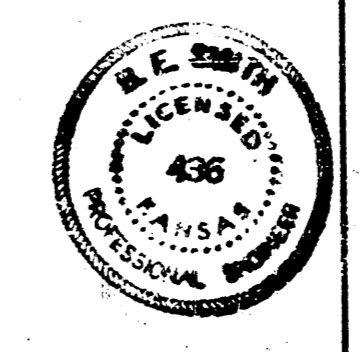

SKINNER
E.L. TOPEKA TO W.L. EMPORIA
30' CONC. & CB.
CITY OF WICHITA, KANSAS
B.E. SMITH - CITY ENGINEER
MARCH, 1954 PROJ. C.13-274