B.M. 11360 "G" in Globe wk. E. E.S. of Sheridan & N. of Maple

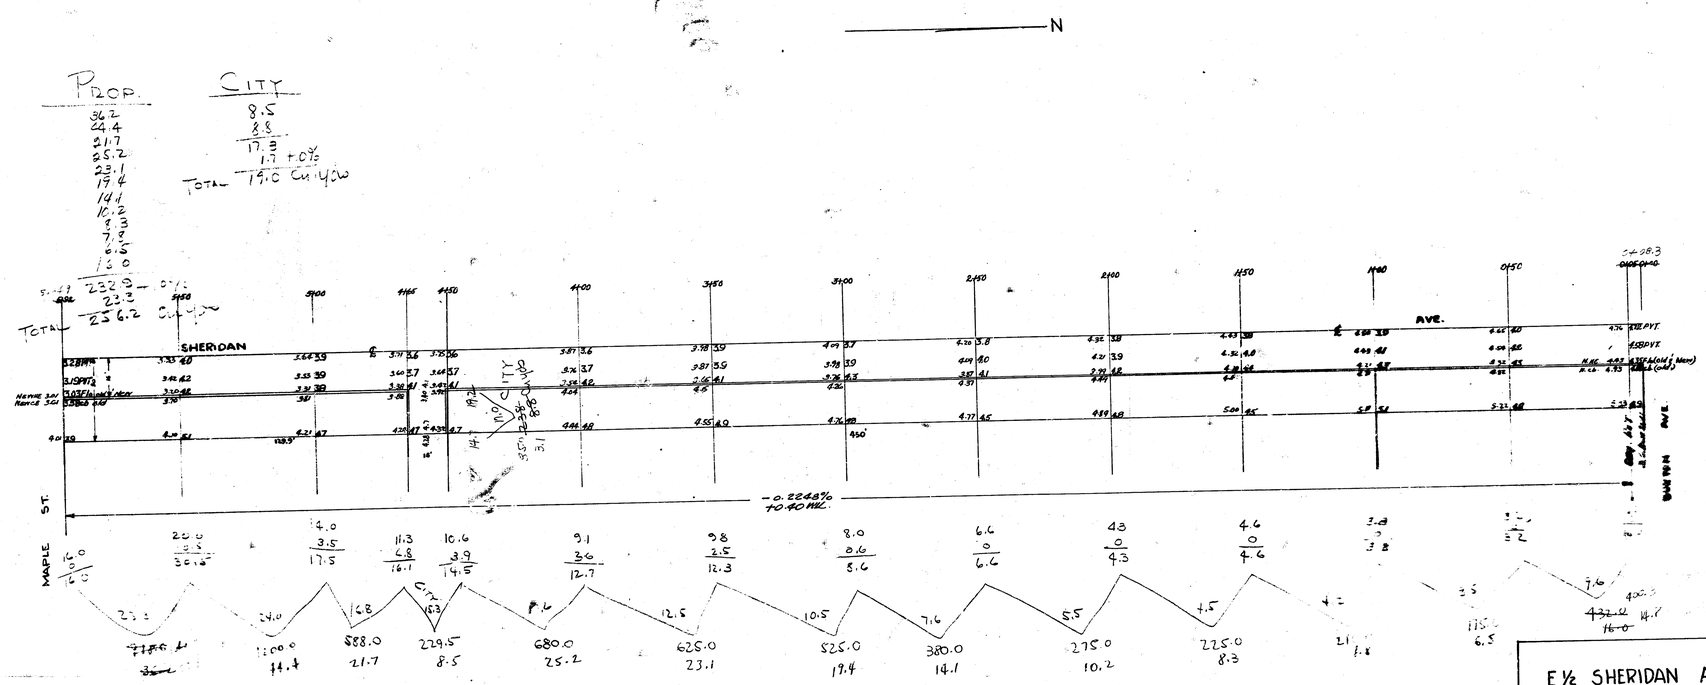

E ½ SHERIDAN AVE

S.L. BURTON to N.L. MAPLE

15' CONC. & C.B.

CITY of WICHITA, KANS.

L.K. WHITE — CITY ENGINEER

APRIL 1949 — PROJ. NO. C-19-60

4 1 3 (51)