


Survey: J.C.A. Book: D.L.K.13
 Plan: Sedgwick
 Ex.: on
 Check: Study

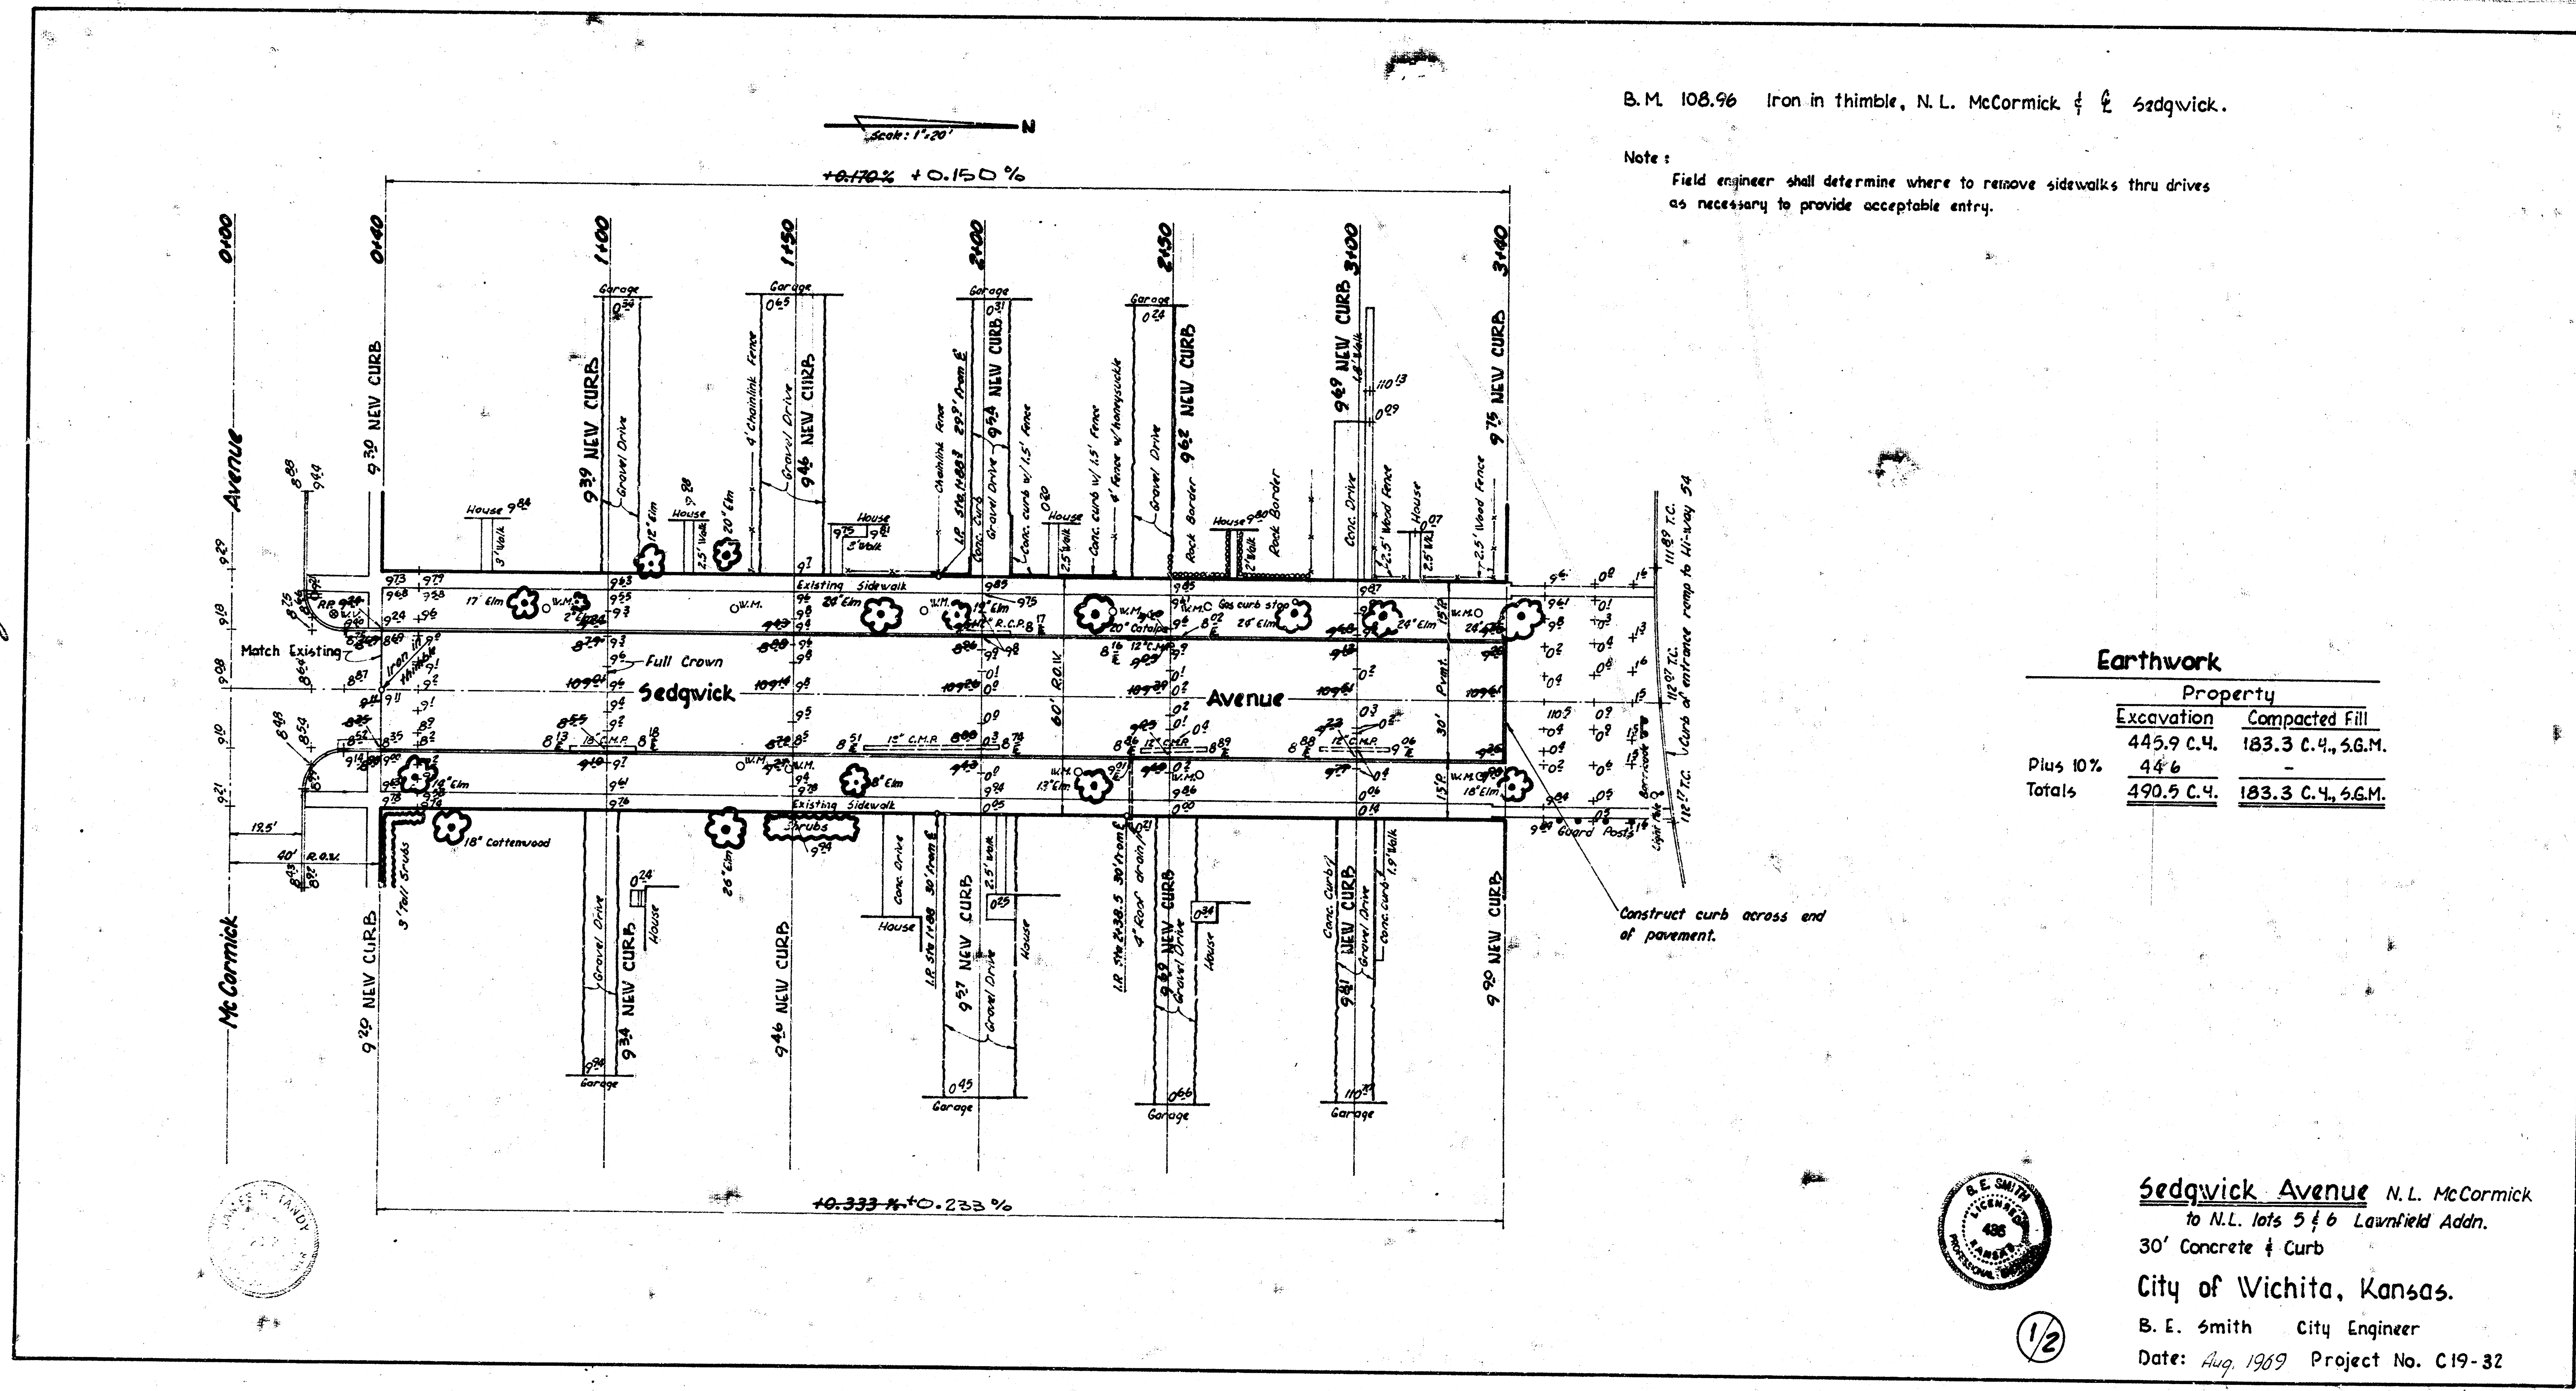

B.M. 108.96 Iron in thimble, N.L. McCormick & Sedgwick.

Note:
 Field engineer shall determine where to remove sidewalks thru drives
 as necessary to provide acceptable entry.

Earthwork

	Property	
	Excavation	Compacted Fill
Plus 10%	445.9 C.Y.	183.3 C.Y., 5.6 M.
Totals	490.5 C.Y.	183.3 C.Y., 5.6 M.



Sedgwick Avenue N.L. McCormick
 to N.L. lots 5 & 6 Lawnfield Addn.
 30' Concrete & Curb
 City of Wichita, Kansas.
 B. E. Smith City Engineer
 Date: Aug. 1909 Project No. C19-32

1/2