
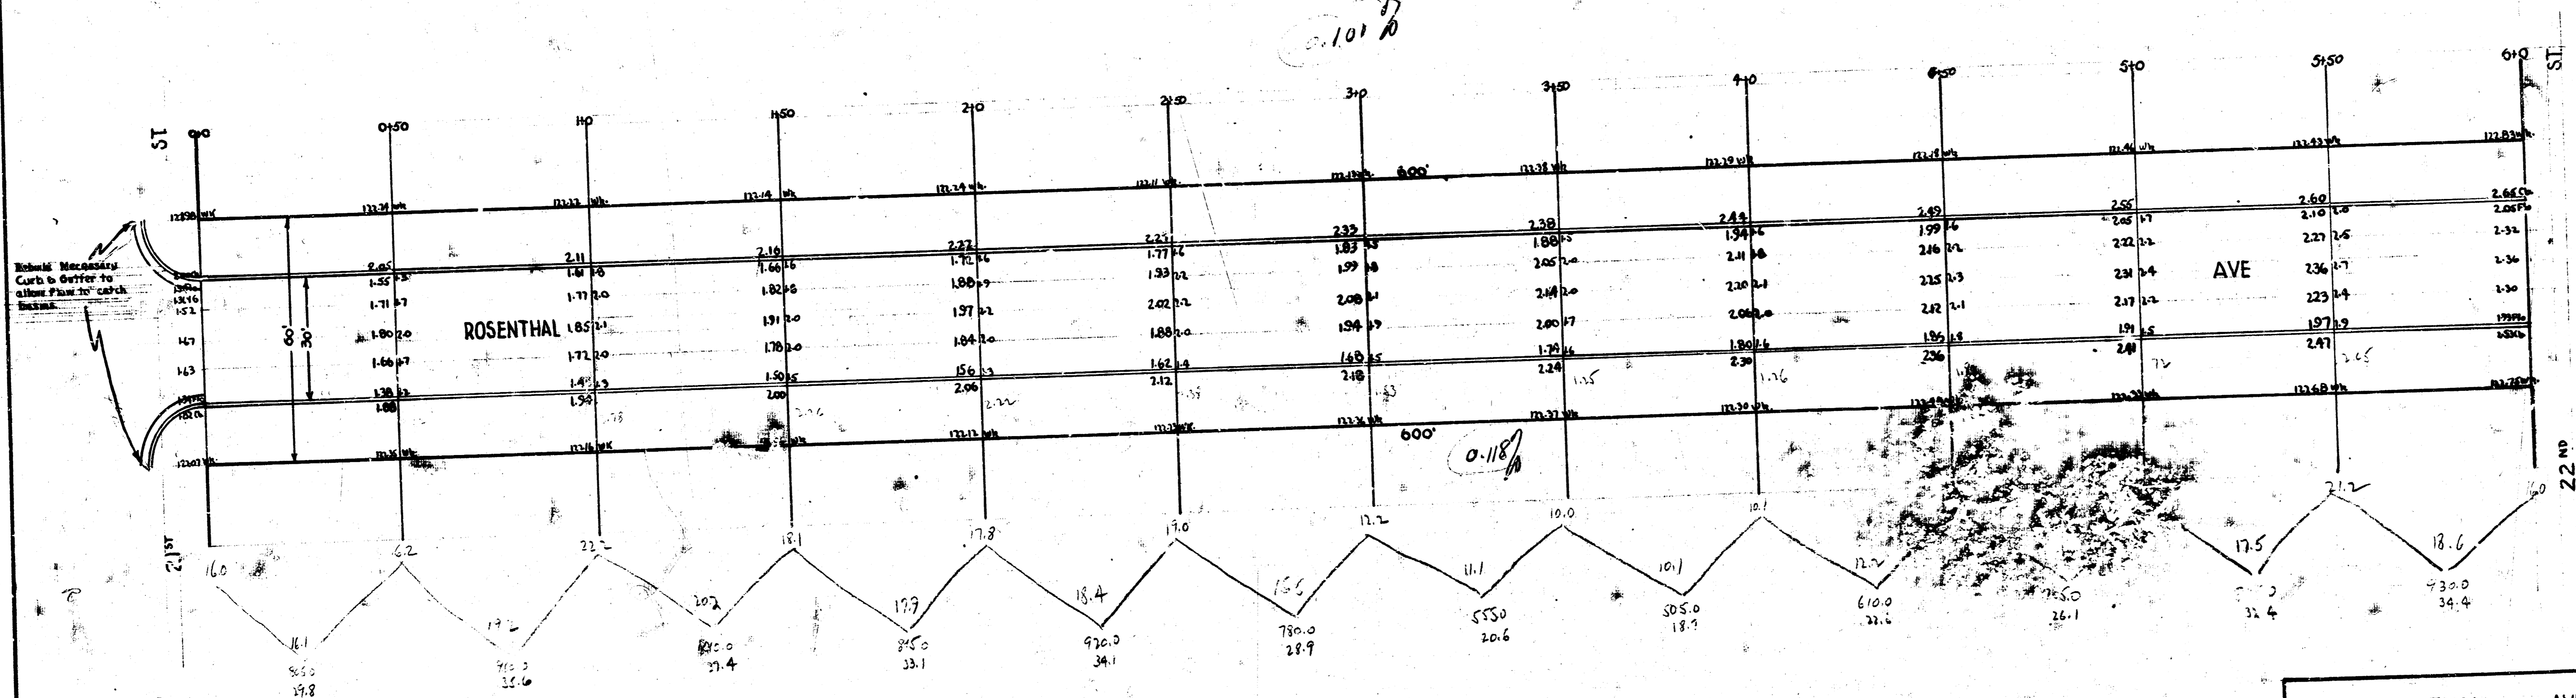


D.M. 12104 - Dalt 3'5.61 S.E. Cor. Brack Piling Str. N.E. Cor. Arkansas & 21<sup>st</sup> St  
 D.M. 12100 - 10' in Globe C. W. N. N.W. Cor 21<sup>st</sup> & Rosenthal

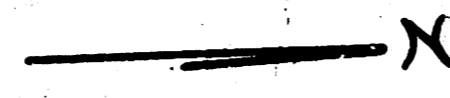

*Property*  
 $\frac{353.7 \text{ angle}}{35.3}$   
 $\frac{389.0 \text{ angle}}{110^\circ}$

ROSENTHAL AVE  
 N.L. 21<sup>st</sup> TO S.L. 22<sup>nd</sup>  
 30' CONCRETE & CB.  
 CITY OF WICHITA, KANSAS  
 LK WHITE CITY ENGINEER  
 JUNE 1946

4853