



B.M. = 175.82 R.R. Spike N Side 1/4 Sec. 200 1/2 mi. 150' west, SW cor. Armour + Rockwood.  
 T.P. = 177.175 "M" in Mueller Top Fire hyd. on NE cor. Rutland + Rockwood.

Base-line = North Property Line ROCKWOOD ROAD.

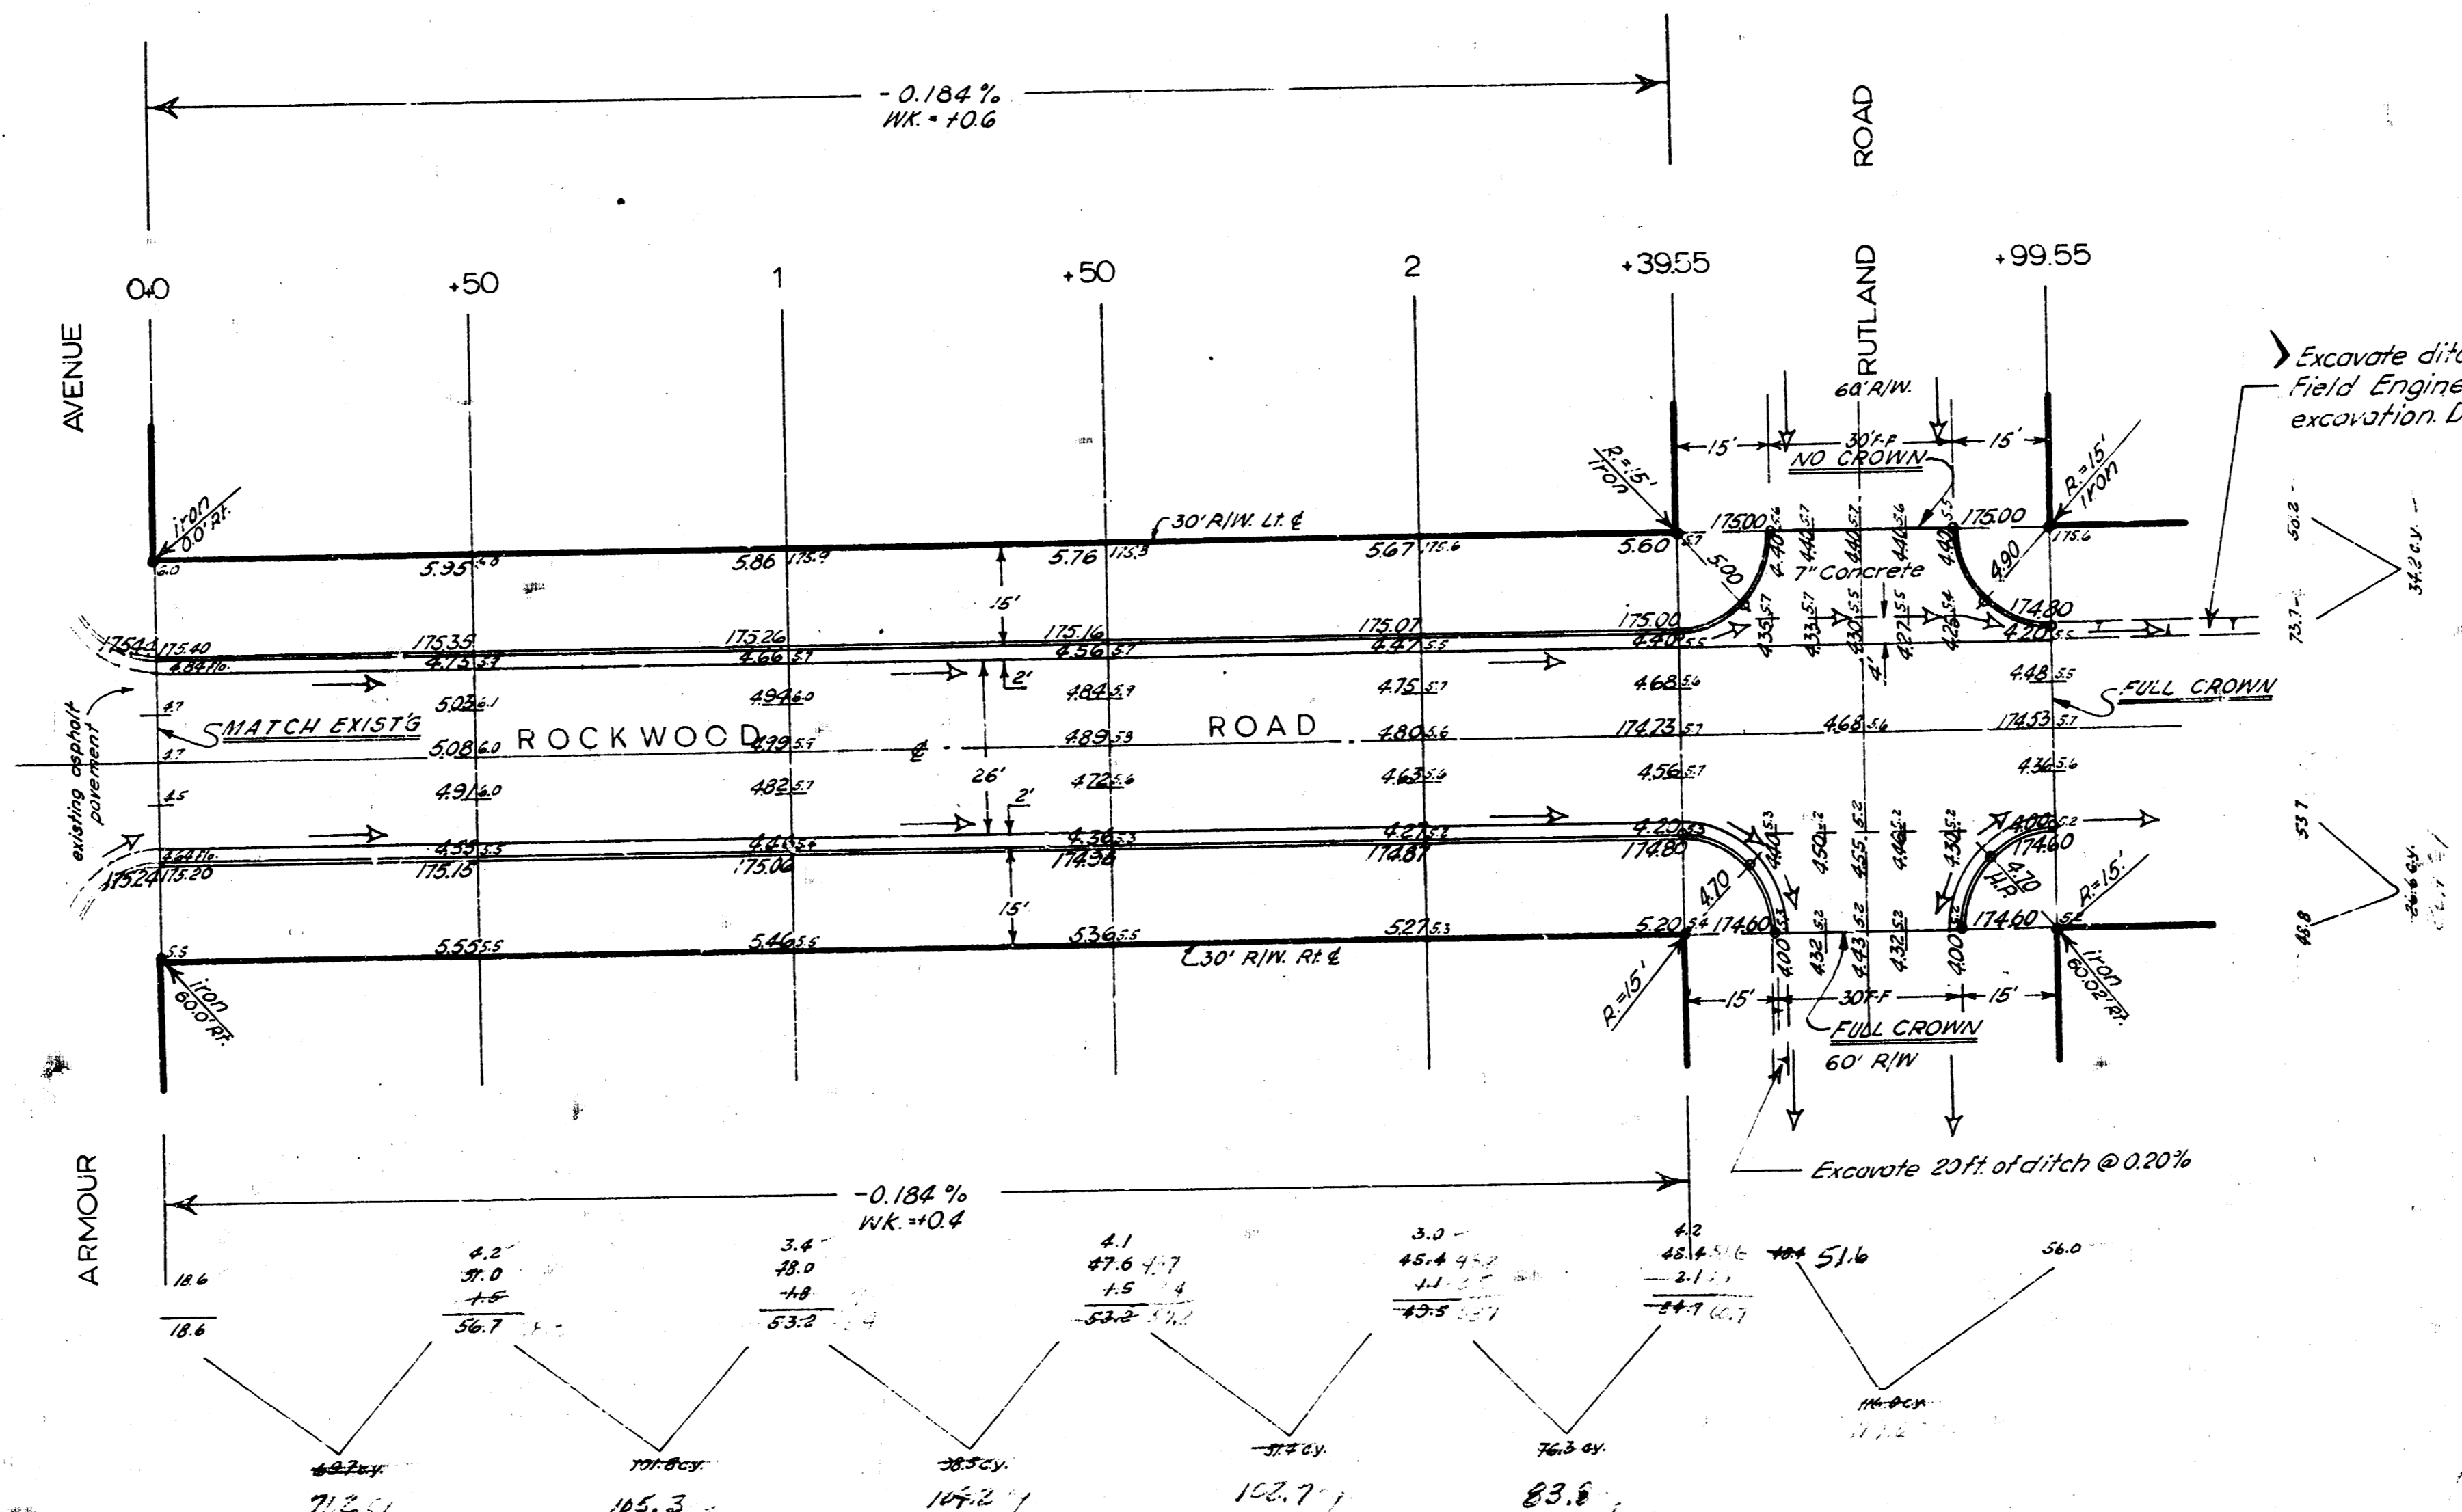

132012 1/16/22  
 15 5 5000  
 177  
 177

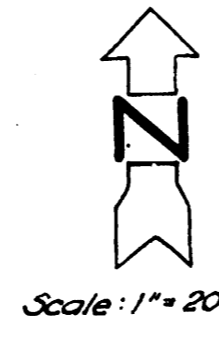

EARTHWORK QUANTITIES  
(EXCAVATION)

|             |             |
|-------------|-------------|
| PROP.       | CITY        |
| 387.7       | 176.6       |
| 382.8 @ 10% | 177.7 @ 10% |
| 437.5 cu.   | 194.3 cu.   |

| ROCKWOOD ROAD                         |                   |
|---------------------------------------|-------------------|
| E.L. Armour Ave. to E.L. Rutland Road |                   |
| 26'-2'-30' Asphaltic Concrete         |                   |
| City of Wichita, Kansas               |                   |
| B.E. Smith                            | City Engineer     |
| Date: July 11, 1922                   | Design - S. Secl  |
|                                       | Proj. No. C/12-22 |