



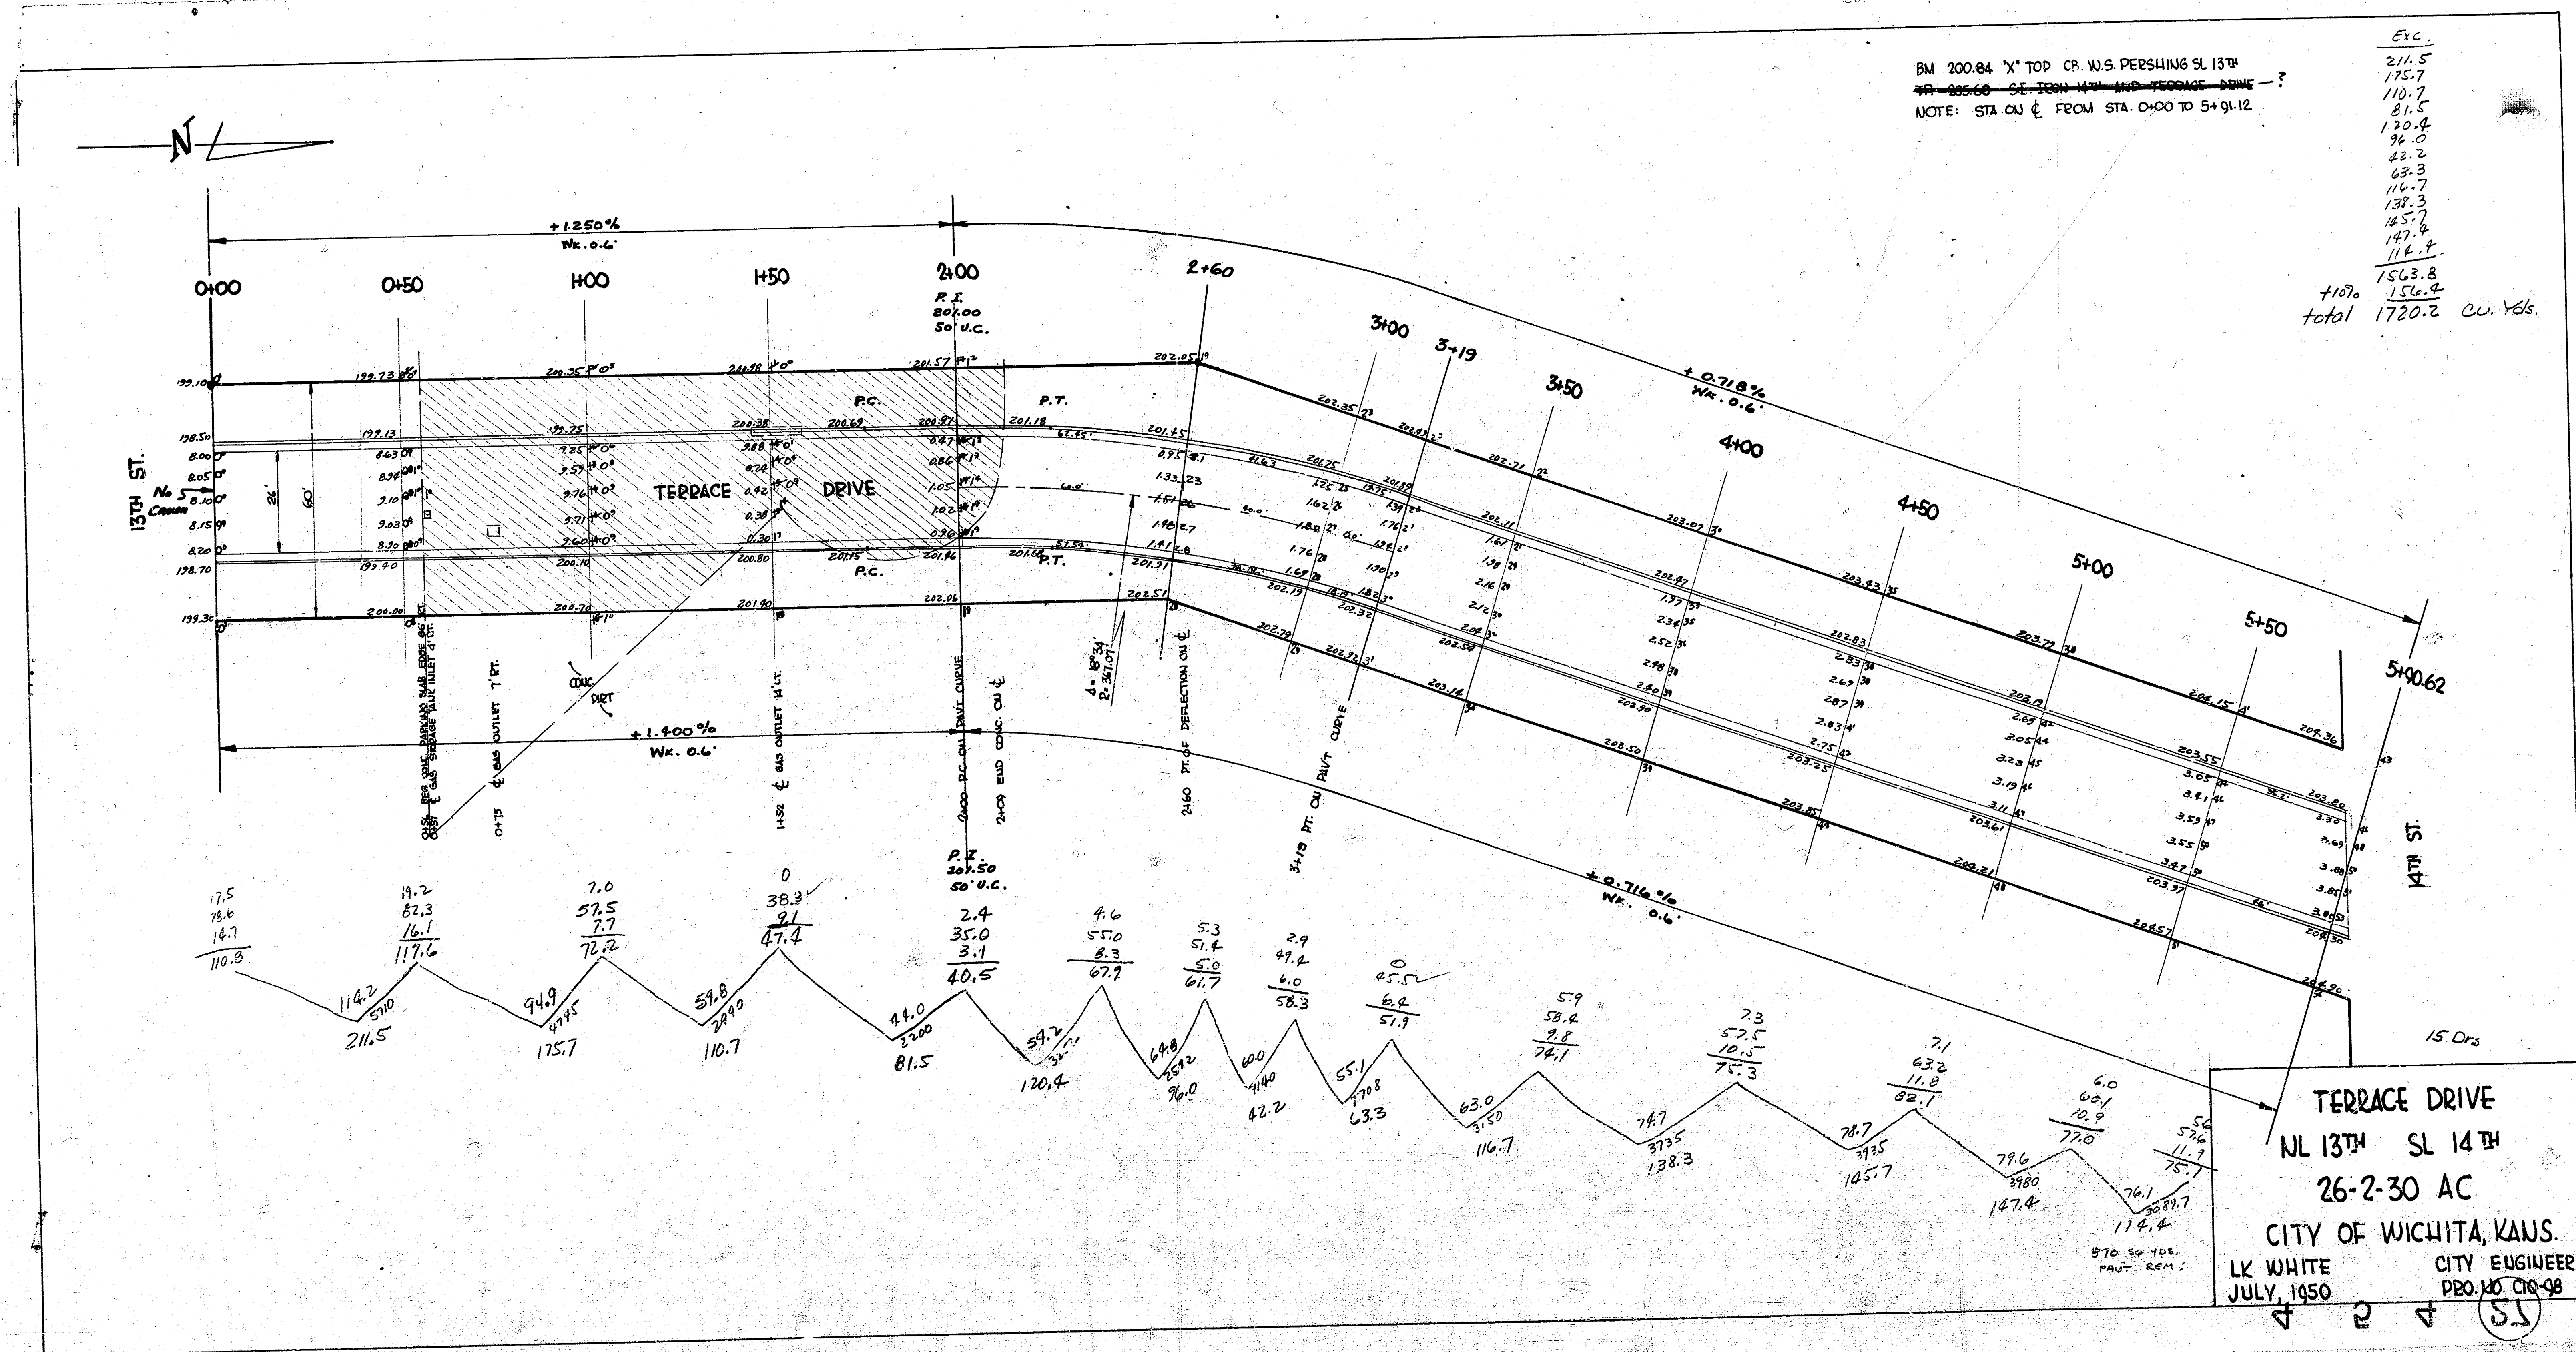


Bl # H-2 X Sections after Fill
Bl # 439 X Sections before filling

B.M. 206.63 "M" in Mueller Fire Hydrant S.E. cor. 14th & Pershing.

FIELD ENGR

1-section shall be taken
after exc of loose fill

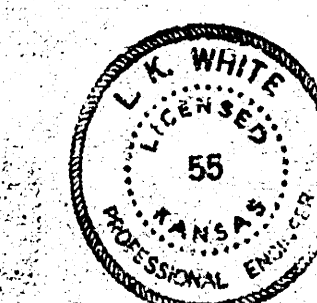
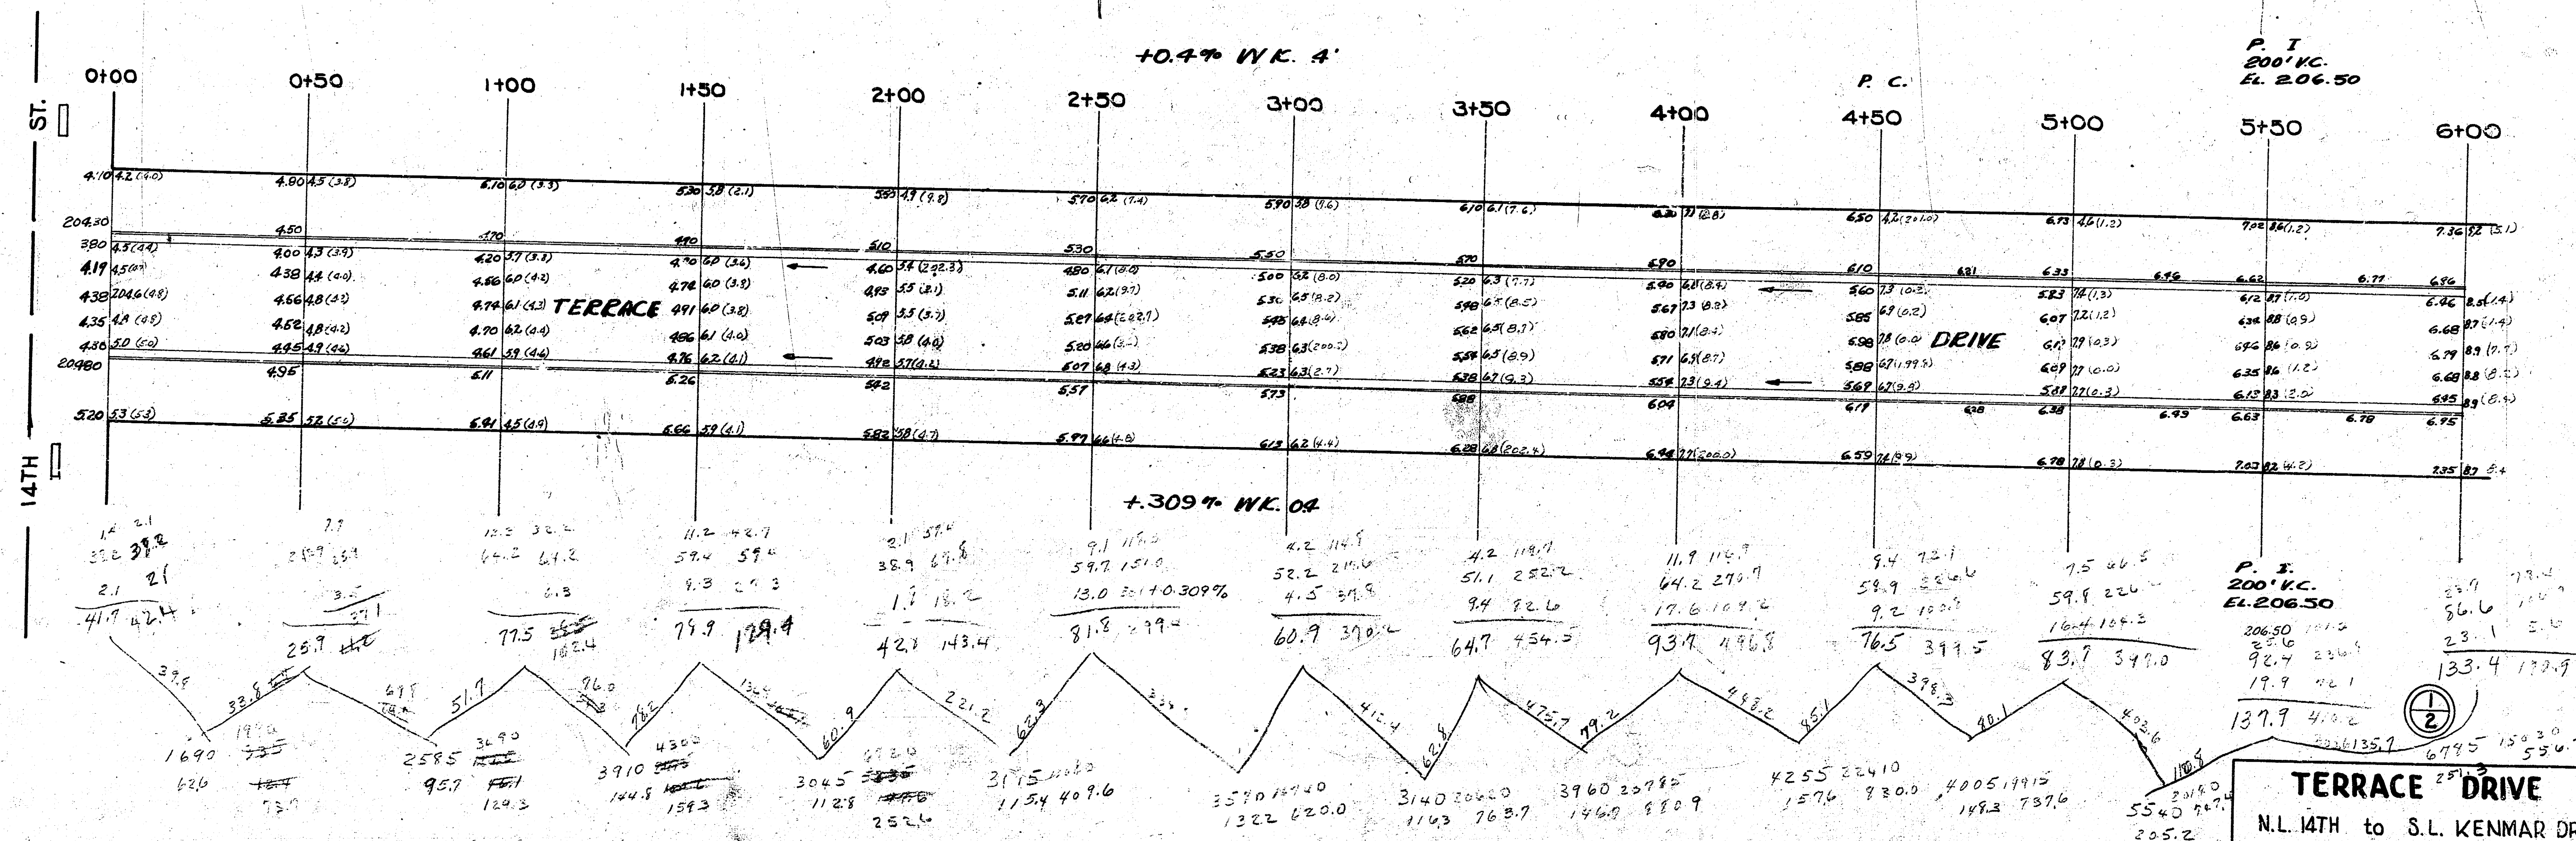


TERRACE DRIVE
N.L. 14TH to S.L. KENMAR DR.
26'-2'-30" A.C.
CITY OF WICHITA, KANSAS
L.K. WHITE CITY ENGINEER
OCT. 28, 1951, PROJ. NO. CII-260

Bk # H-2

B.M. 215.57 S.E. cor. conc. Patch Ho. 1651 Jan 7/77

NOTE: Stationing on 3" offset E. R. L. E.I.C. 1270 7/24/47 Sta 1+00 to 10+91.60

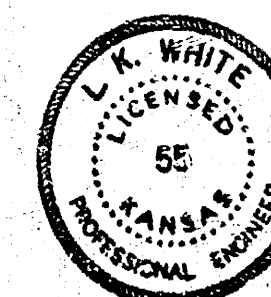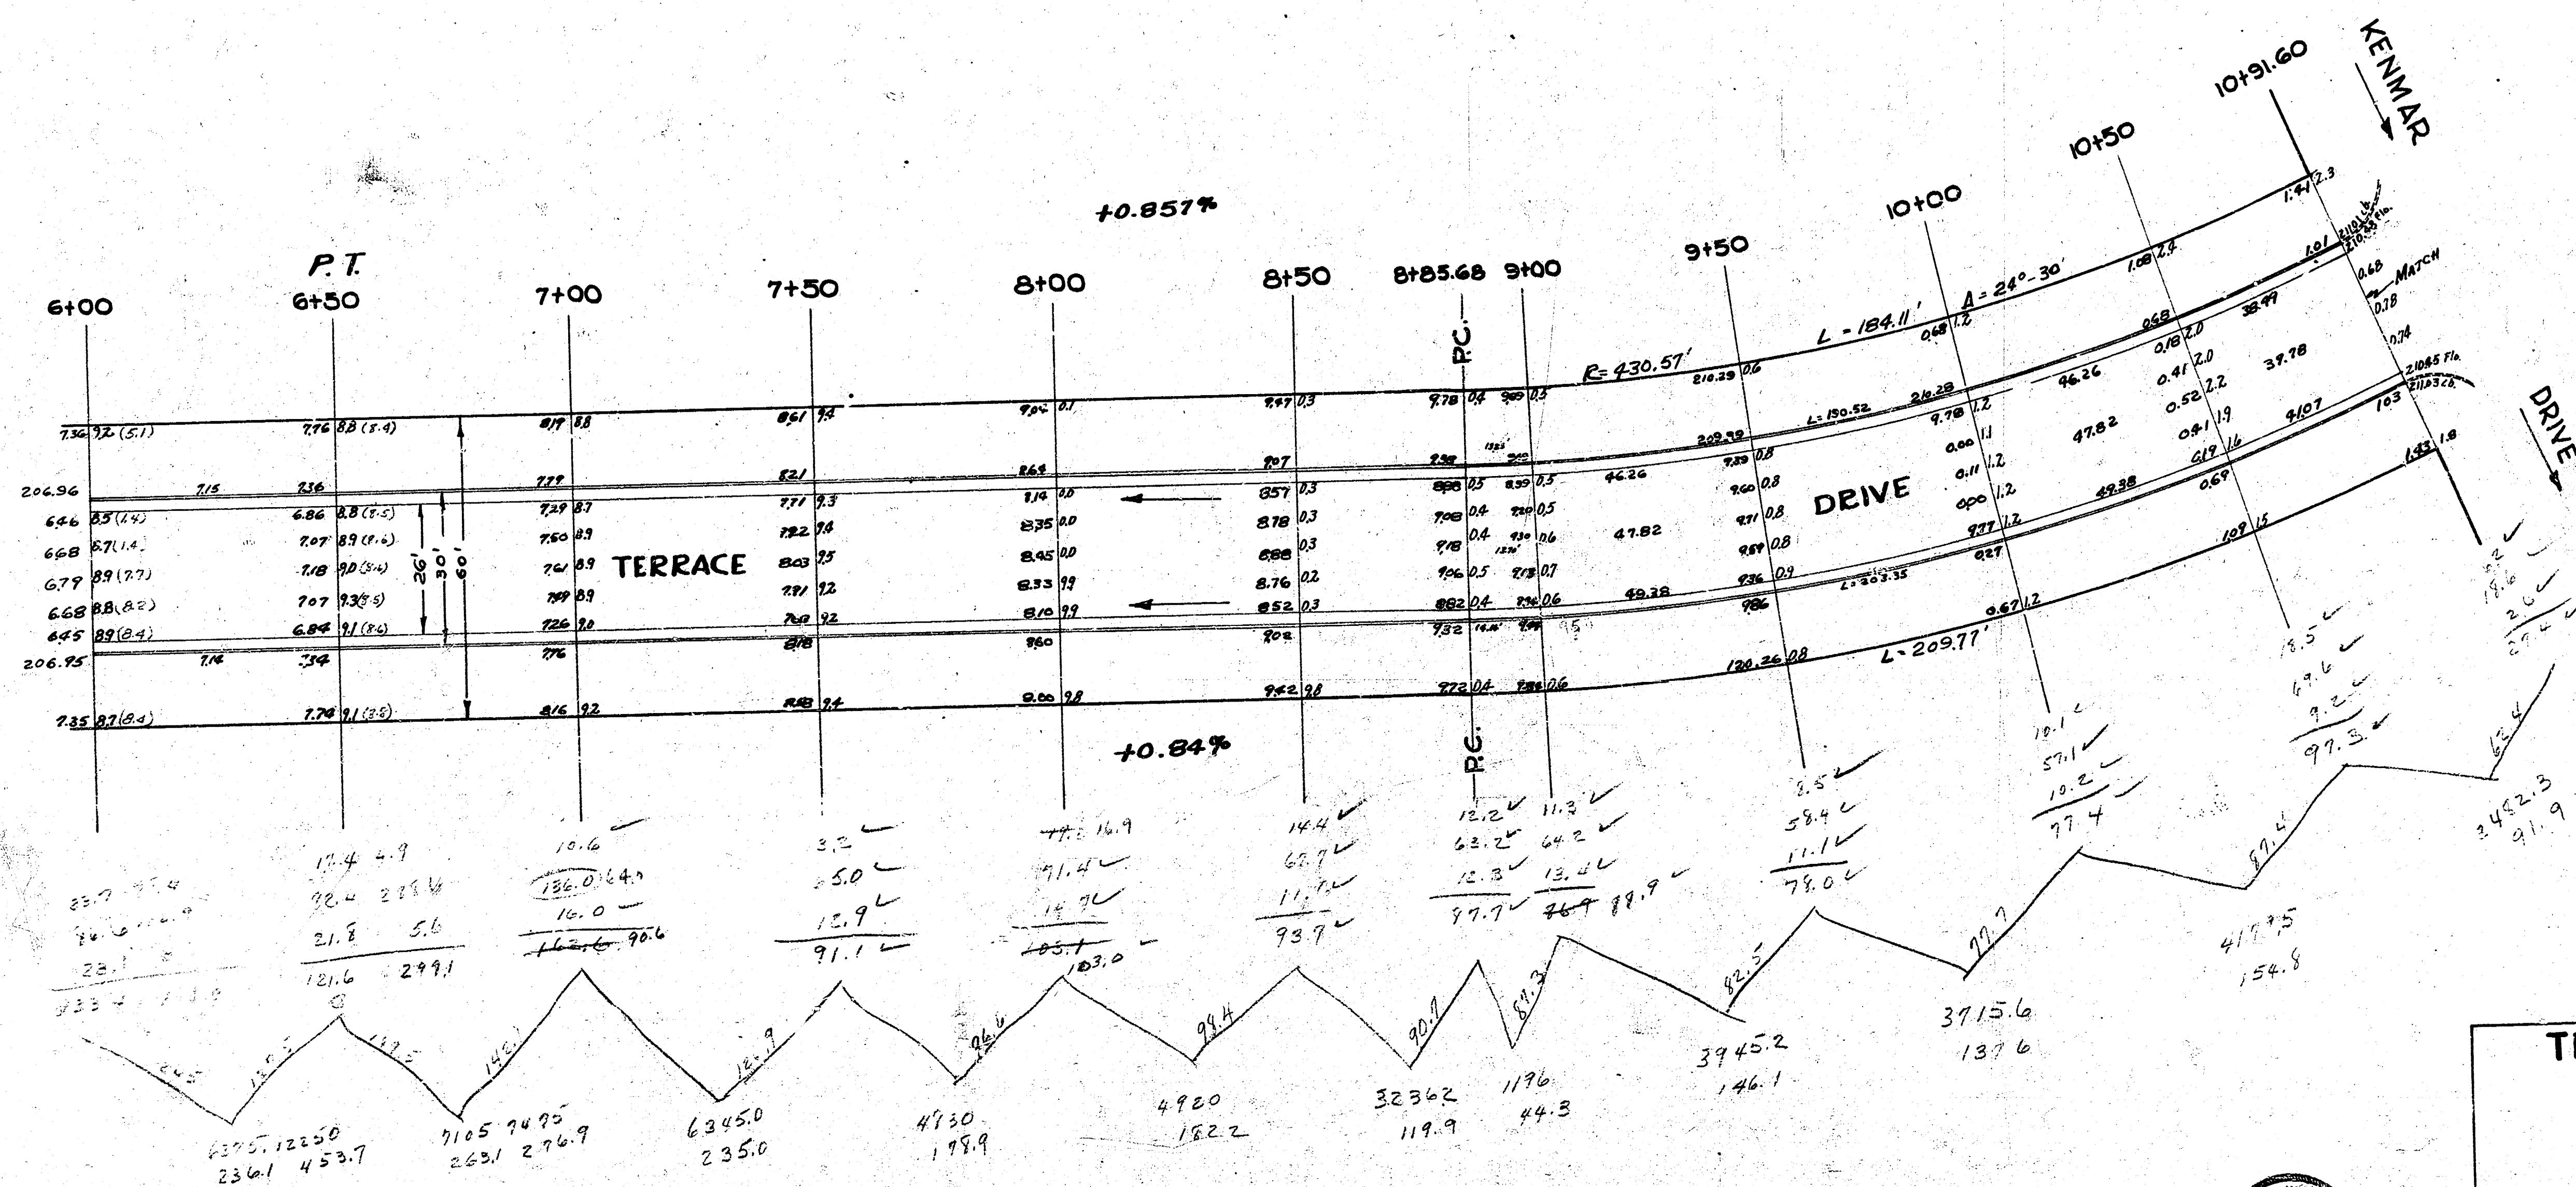

TERRACE DRIVE

PROJ. NO. C11-260

4 2 4 (S)