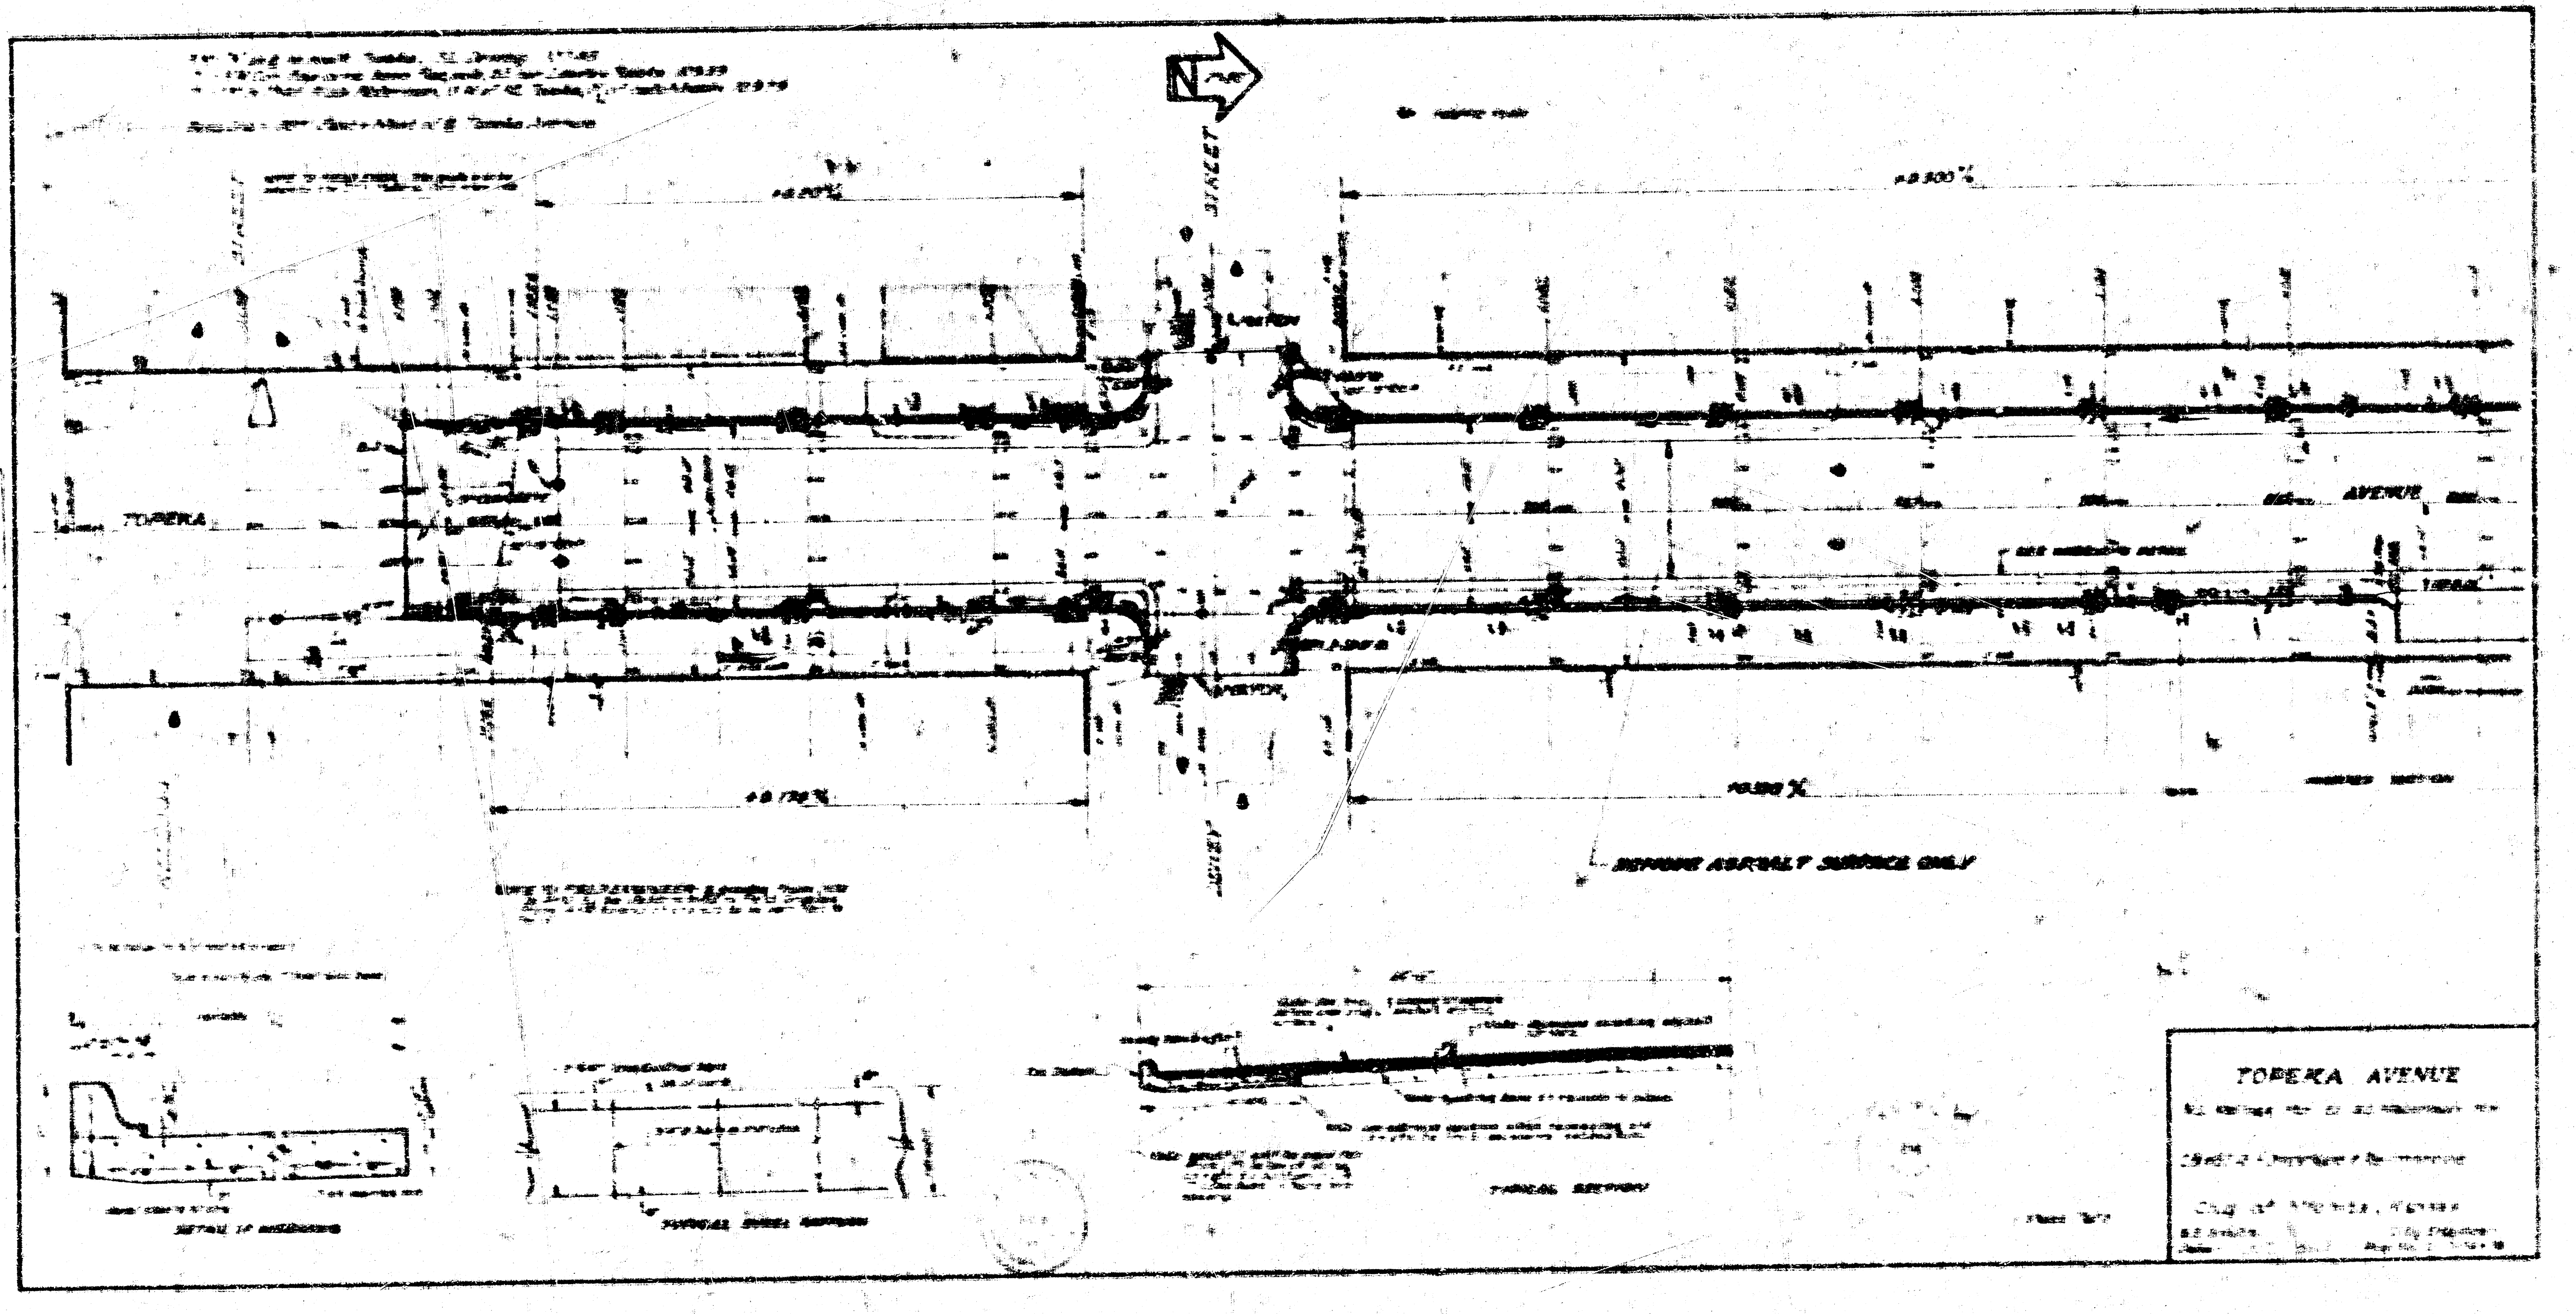
N
STREET
TOPEKA
AVENUE
STREET
REMOVE ASPHALT SURFACE ONLY
TYPICAL SECTION
TOPEKA AVENUE
City of Wichita, Kansas

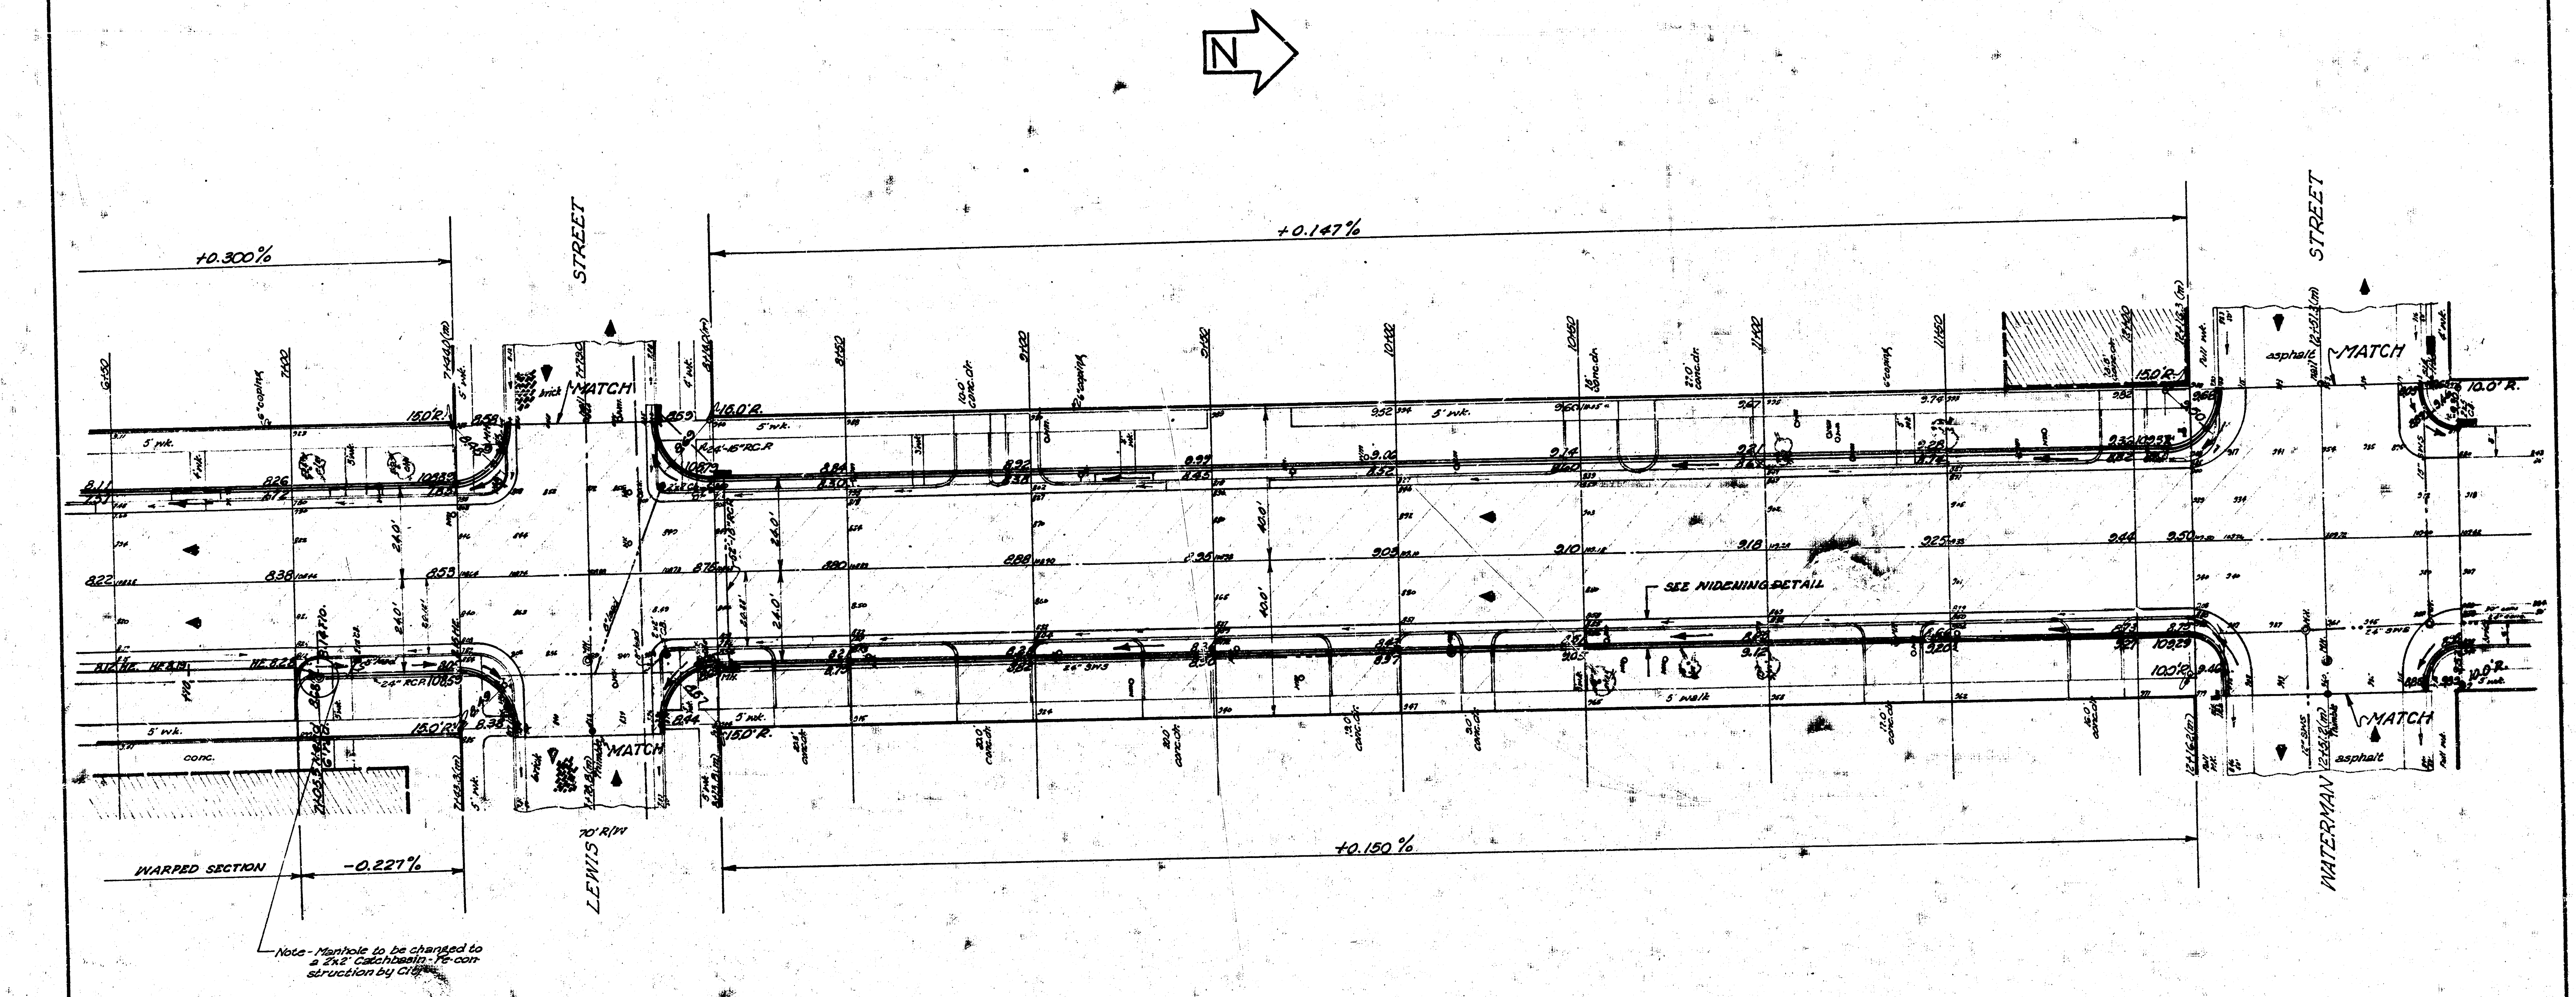
N
+0.300%
+0.147%
STREET
LEWIS
70' R/W
WATERMAN
STREET
MATCH
MATCH
MATCH
MATCH
brick
asphalt
asphalt
15.0' R.
16.0' R.
15.0' R.
15.0' R.
15.0' R.
10.0' R.
10.0' R.
10.0' R.
5' wk.
4' wk.
6" coping
conc.
24.0'
24.0'
24.0'
24.0'
24" RCP
24"-15" RCP
2'x2' CB
24" SWS
12" SWS
15" SWS
SEE WIDENING DETAIL
5' walk
WARPED SECTION
-0.227%
+0.150%
6+50
7+00
7+44.0 (m)
7+43.3 (m)
8+14.0 (m)
8+50
11+50
12+00
12+16.3 (m)
12+51.3 (m)
12+51.2 (m)
12+16.2 (m)

Note - Manhole to be changed to a 2x2' Catchbasin - Re-construction by City.

Sht. 2 of 2

Survey C.H. Mills Bk 125+95
Plan Seal
Exc
Checked

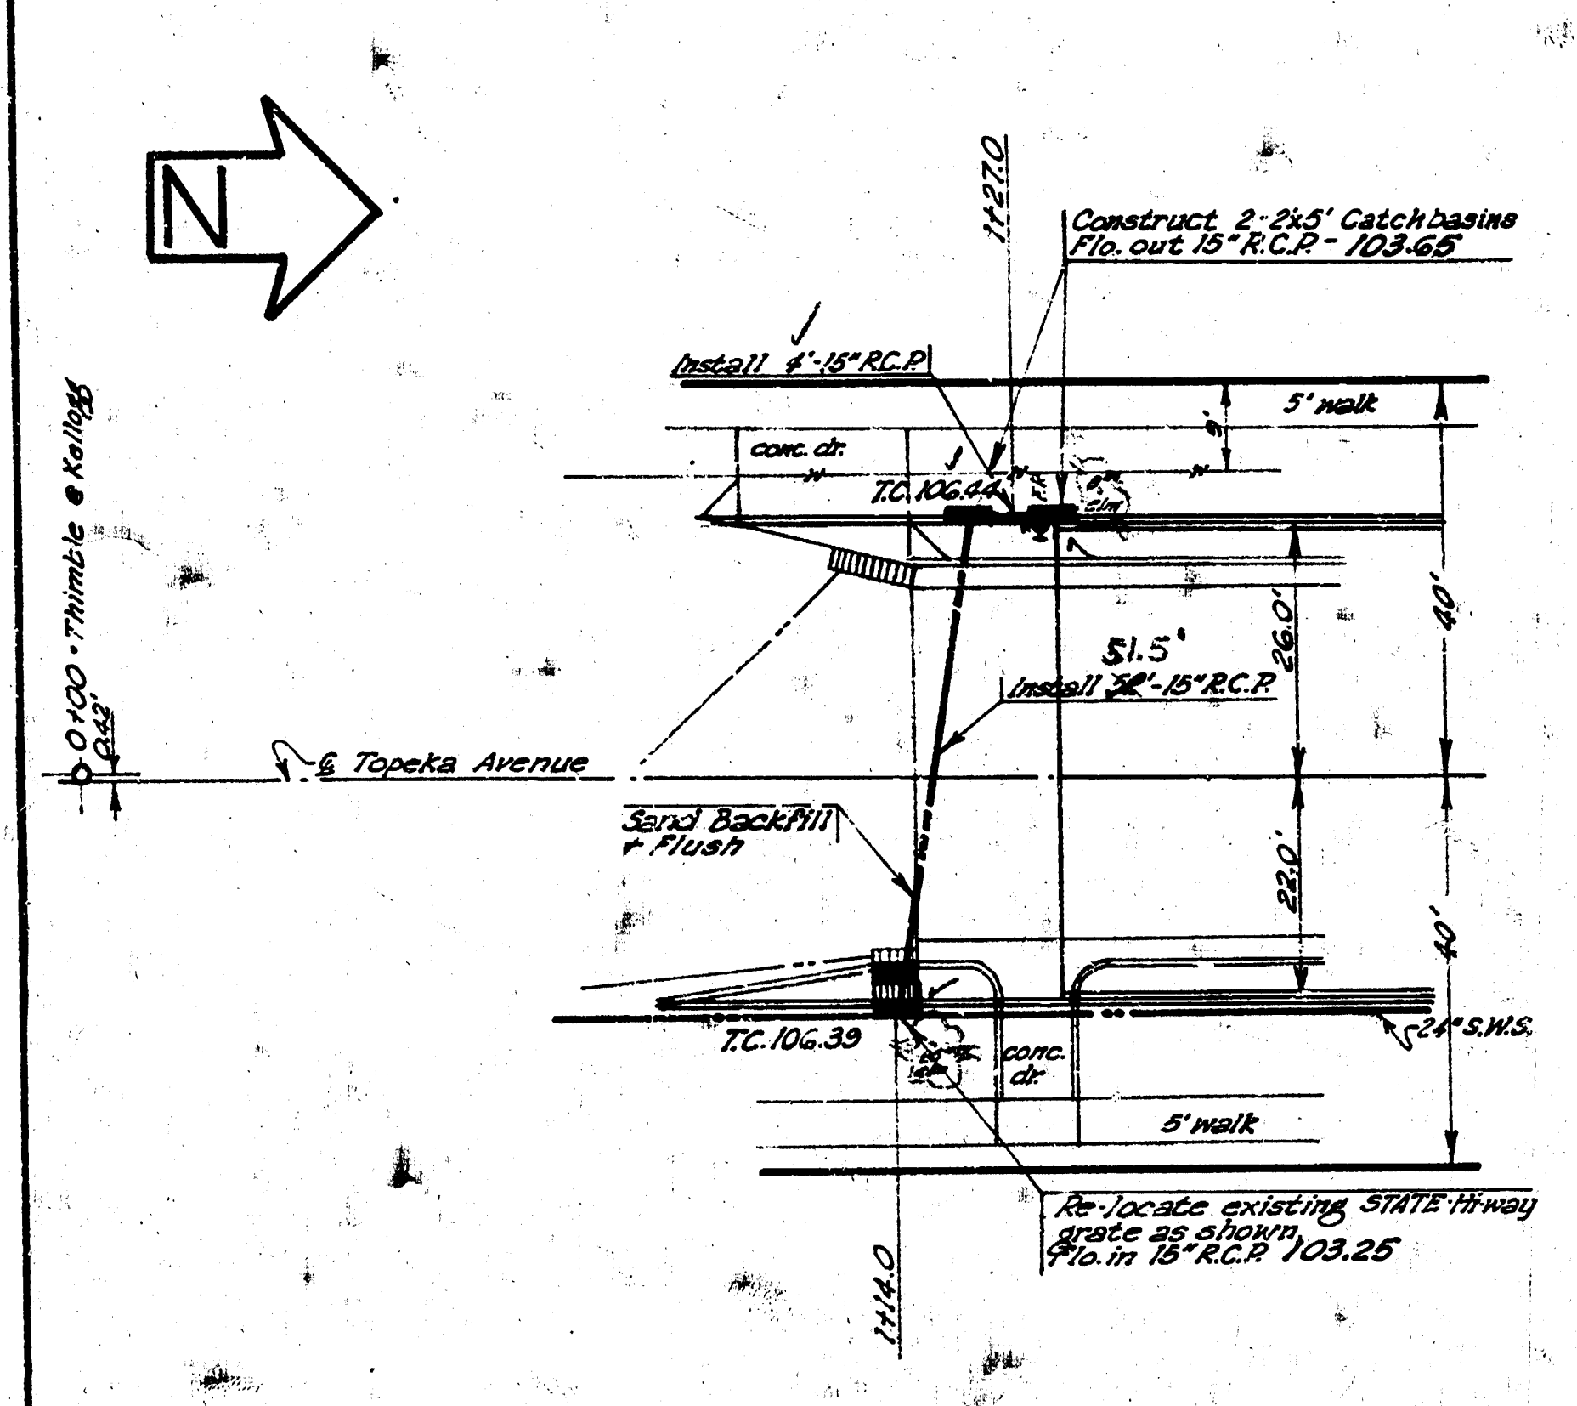
N
0+00 • Thimble @ Kellogg
0.42'
℄ Topeka Avenue
1+27.0
Construct 2-2x5' Catchbasins Flo. out 15" R.C.P. - 103.65
Install 4'-15" R.C.P.
5' walk
conc. dr.
T.C. 106.44
51.5'
Install 52'-15" R.C.P.
26.0'
40'
22.0'
40'
Sand Backfill + Flush
T.C. 106.39
conc. dr.
24" S.W.S.
5' walk
Re-locate existing STATE Hi-way grate as shown, Flo. in 15" R.C.P. 103.25
1+14.0

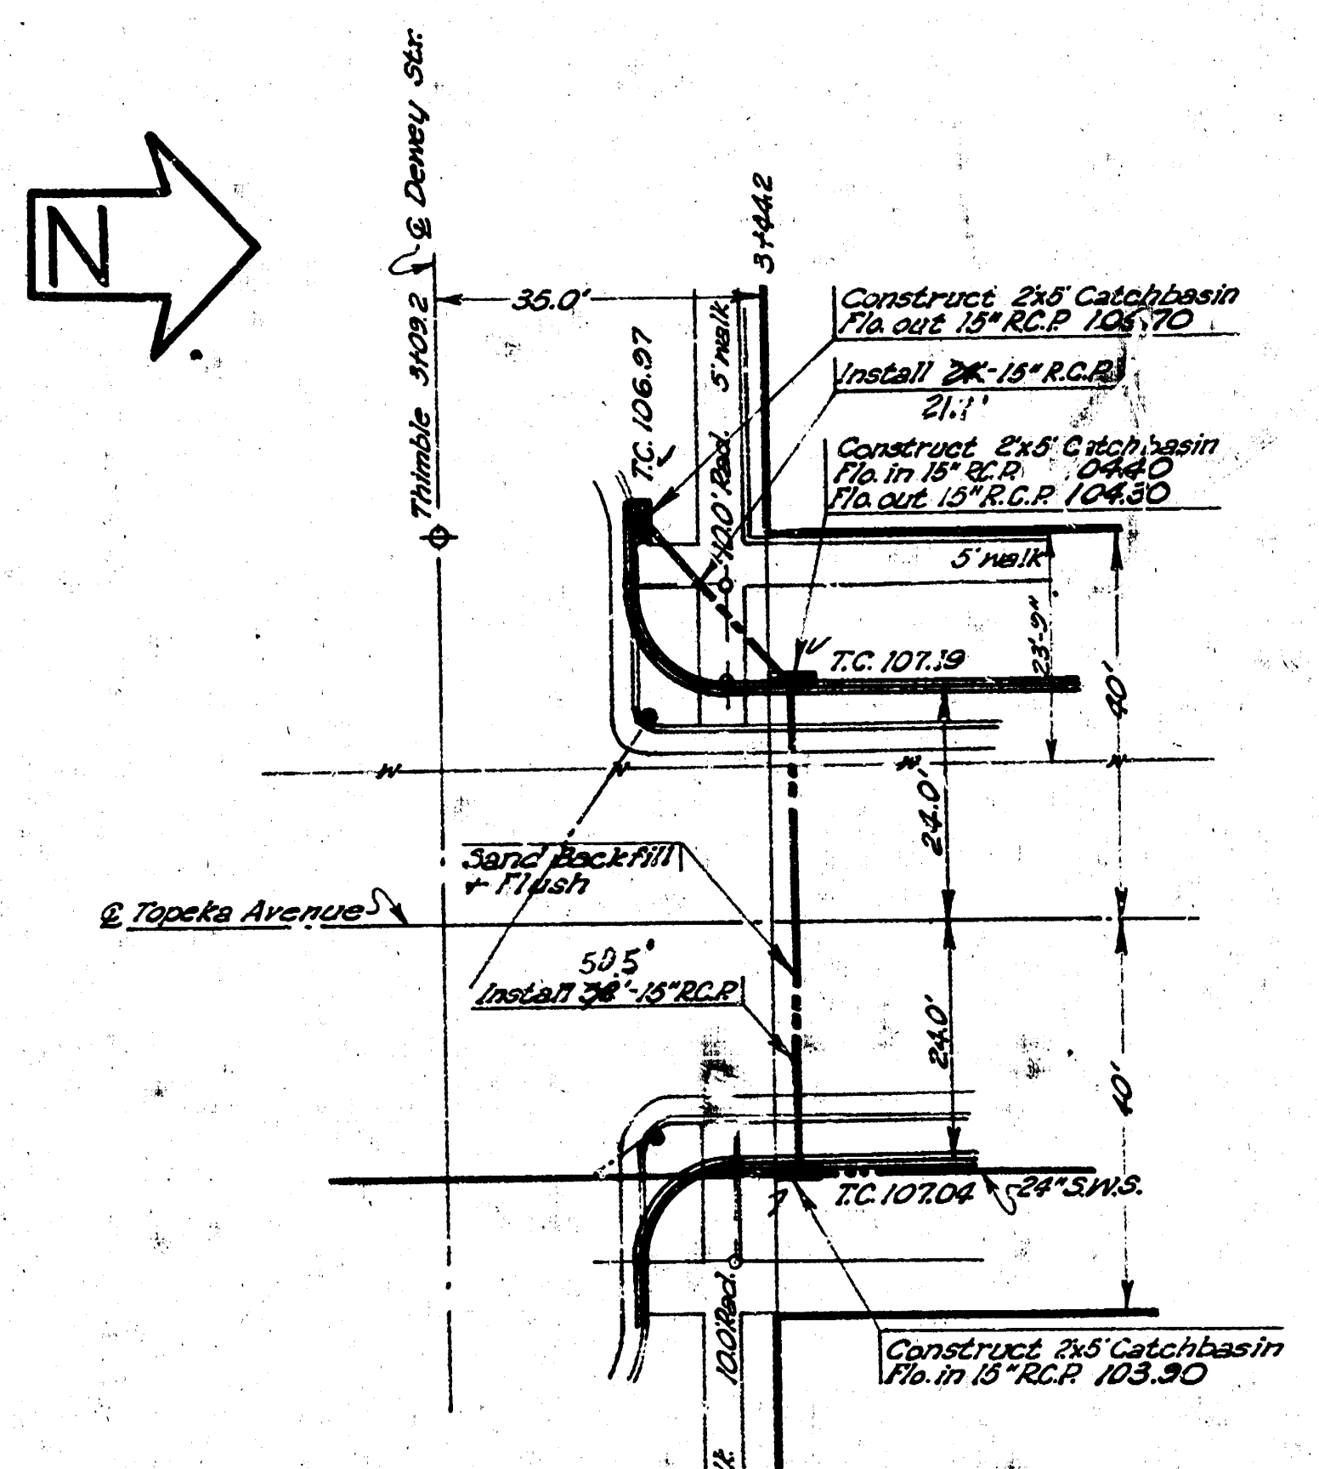
N
℄ Dewey Str.
Thimble 3+09.2
35.0'
3+44.2
5' walk
T.C. 106.97
10.0' Rad.
Construct 2x5' Catchbasin Flo. out 15" R.C.P. 106.70
Install 21.1'-15" R.C.P.
Construct 2'x5' Catchbasin Flo. in 15" R.C.P. 104.40 Flo. out 15" R.C.P. 104.30
5' walk
T.C. 107.19
23'-9"
40'
24.0'
Sand Backfill + Flush
℄ Topeka Avenue
50.5'
Install 50.5'-15" R.C.P.
24.0'
40'
T.C. 107.04
24" S.W.S.
10.0' Rad.
4' walk
Construct 2x5' Catchbasin Flo. in 15" R.C.P. 103.90

BM-"*" on ℄ west walk Topeka, S.L. Dewey 107.45

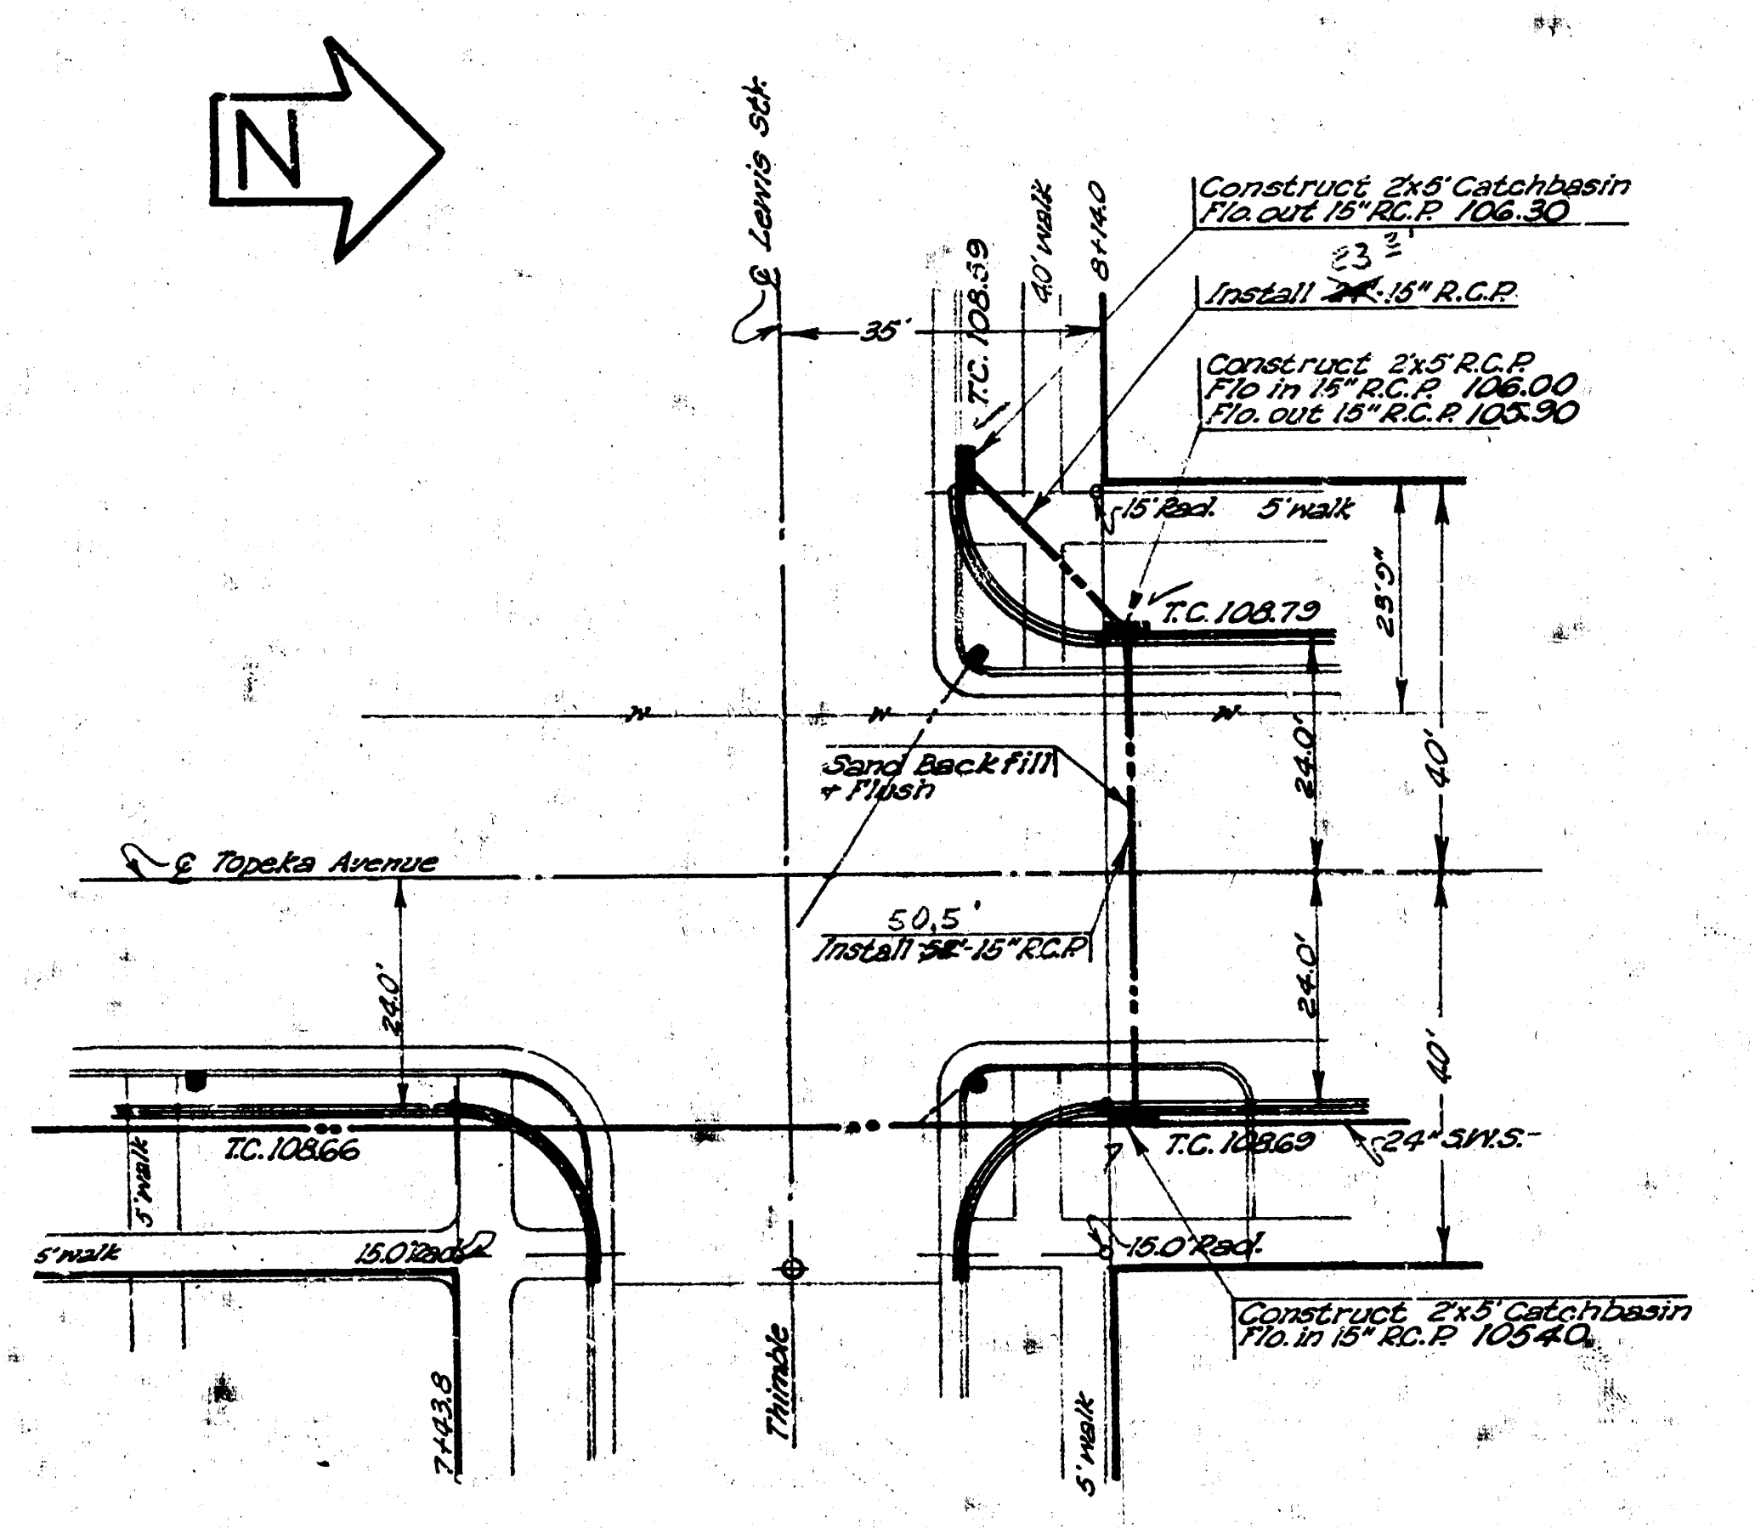
N
℄ Lewis Str.
35'
T.C. 108.59
40' walk
8+14.0
Construct 2'x5' Catchbasin Flo. out 15" R.C.P. 106.30
Install 23.3'-15" R.C.P.
Construct 2'x5' R.C.P. Flo in 15" R.C.P. 106.00 Flo. out 15" R.C.P. 105.90
15' Rad.
5' walk
T.C. 108.79
23'9"
40'
24.0'
Sand Backfill + Flush
℄ Topeka Avenue
50.5'
Install 50.5'-15" R.C.P.
24.0'
24.0'
40'
T.C. 108.66
5' walk
5' walk
15.0' Rad.
T.C. 108.69
24" S.W.S.
15.0' Rad.
Construct 2'x5' Catchbasin Flo. in 15" R.C.P. 105.40
7+43.8
Thimble
5' walk

B.M - N.W. cor. top conc. base, flag Pole - S.E. cor. Lewis + Topeka 109.39

B.E. SMITH
436

TOPEKA AVE.

N.L. Kellogg Street - N.L. Waterman Street

INCIDENTAL DRAINAGE

City of Wichita, Kansas

B.E. Smith City Engineer
Date - Oct. 1940 Proj. No. C 10-74 + 75

10 2 3 8