B.M. 126.77 'G' IN GLOBE N. CB. WEAVER E. END RAD. N.E. WEAVER & PERRY

STA. ON & 20' W. OF MON. E.L. WOODROW COURT 65' S. OF S. CB WEAVER

MON. TIES: 4.6' W. TO BACK OF E. CB WOODROW COURT & 62.95' N.E. TO BACK OF S. CB. WEAVER

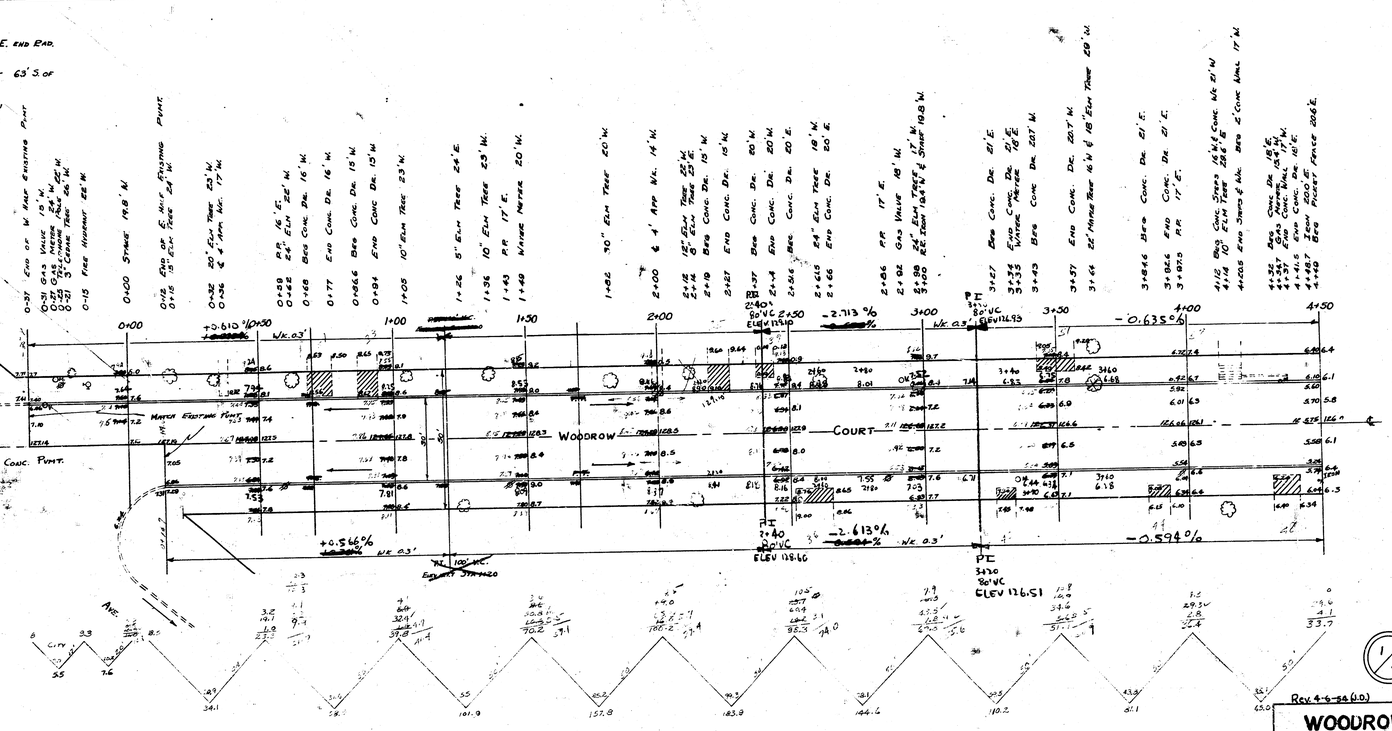

NOTE TO FIELD ENGINEER & CONTRACTOR:
ALL ENTRANCE PIPES & CULVERTS TO BE DISPOSED OF AS PER DIRT CHECKERS INSTRUCTIONS.

CONSOLIDATED GAS CO. TO BE NOTIFIED WHEN EXCAVATION IS STARTED.

EXCAVATION

PROP		CITY	
C 164.4	F 379.6	C 5.5	F 101.5
+10% 16.4	+10% 37.9	+10% .6	+10% 10.2
180.8	417.1	6.1	111.7

Rev. 4-6-54 (J.O.)

WOODROW COURT

N.L. PERRY TO N.L. 16TH

30' CONC. & C.B.

CITY OF WICHITA KANSAS

B.E. SMITH CITY ENGINEER

OCT. 1953 PROJ. NO. C-13-10

B. E. SMITH LICENSED 436 KANSAS PROFESSIONAL ENGINEER

Survey B.M. Bk. 80
Plan
Esc.
Checked

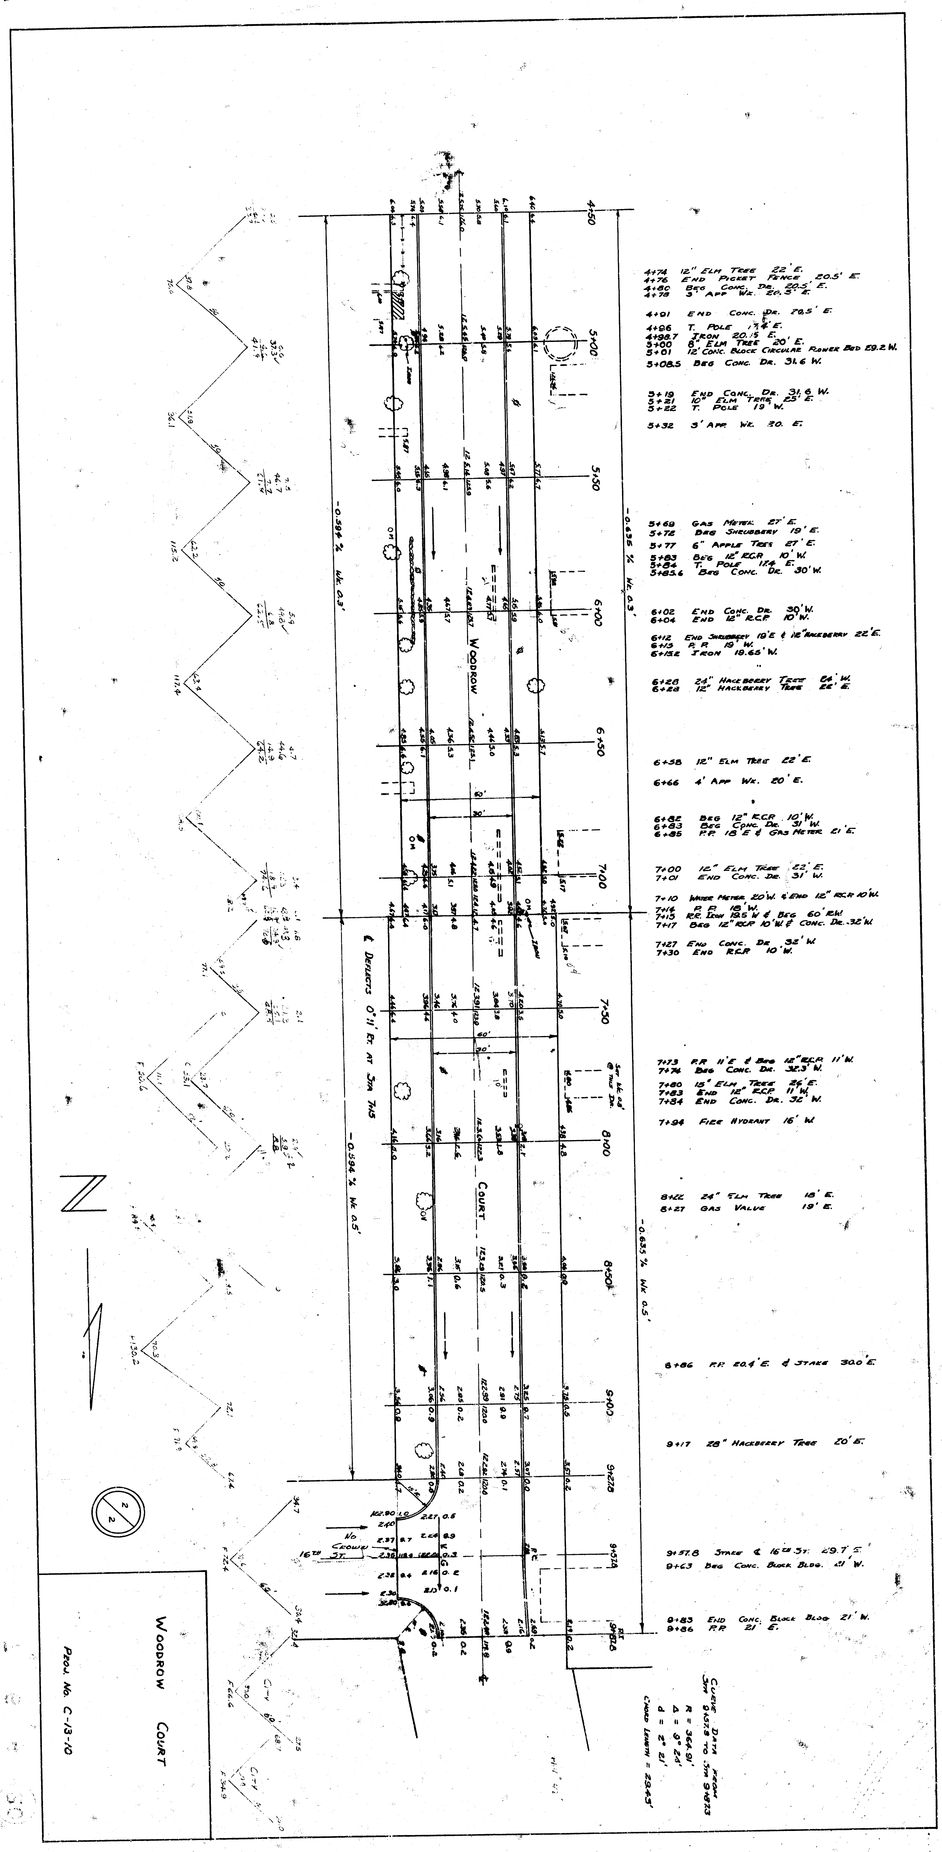
4+74 12" ELM TREE 22' E.
4+76 END PICKET FENCE 20.5' E.
4+80 BEG CONC. DR. 20.5' E.
4+78 3' APP WK. 20.5' E.
4+01 END CONC. DR. 28.5' E.
4+06 T. POLE 1¼ E.
4+98.7 IRON 20.5' E.
5+00 8" ELM TREE 20' E.
5+01 12' CONC. BLOCK CIRCULAR FLOWER BED 29.2' W.
5+08.5 BEG CONC. DR. 31.6' W.
5+19 END CONC. DR. 31.6' W.
5+21 10" ELM TREE 23' E.
5+22 T. POLE 19' W.
5+32 3' APP WK. 20. E.
5+69 GAS METER 27' E.
5+72 BEG SHRUBBERY 19' E.
5+77 6" APPLE TREE 27' E.
5+83 BEG 12" RCP 10' W.
5+84 T. POLE 1¼ E.
5+83.6 BEG CONC. DR. 30' W.
6+02 END CONC. DR. 30' W.
6+04 END 12" RCP 10' W.
6+12 END SHRUBBERY 10' E & 16" HACKBERRY 22' E.
6+13 P.P. 19' W.
6+12.2 IRON 19.65' W.
6+20 24" HACKBERRY TREE 26' W.
6+28 12" HACKBERRY TREE 22' E.
6+58 12" ELM TREE 22' E.
6+66 4' APP WK. 20' E.
6+82 BEG 12" RCP 10' W.
6+83 BEG CONC. DR. 31' W.
6+85 P.P. 15' E & GAS METER 21' E.
7+00 12" ELM TREE 22' E.
7+01 END CONC. DR. 31' W.
7+10 WATER METER 20' W. & END 12" RCP 10' W.
7+16 P.P. 18' W.
7+15 RR. IRON 19.5' W & BEG 60' R.W.
7+17 BEG 12" RCP 10' W & CONC. DR. 32' W.
7+27 END CONC. DR. 32' W.
7+30 END RCP 10' W.
7+73 P.P. 11' E & BEG 12" RCP 11' W.
7+74 BEG CONC. DR. 32.3' W.
7+80 15" ELM TREE 26' E.
7+83 END 12" RCP 11' W.
7+84 END CONC. DR. 32' W.
7+94 FIRE HYDRANT 16' W.
8+22 24" ELM TREE 18' E.
8+27 GAS VALVE 19' E.
8+86 P.P. 20.4' E. & STAKE 30.0' E.
9+17 28" HACKBERRY TREE 20' E.
9+57.8 STAKE ℄ 16TH ST. 29.7' S.
9+63 BEG CONC. BLOCK BLDG. 21' W.
9+83 END CONC. BLOCK BLDG 21' W.
9+86 P.P. 21' E.
CURVE DATA FROM SHT 9+03.8 TO SHT 9+87.3
R = 364.31'
Δ = 9° 24'
d = 2° 21'
CHORD LENGTH = 238.43'
WOODROW COURT
℄ DEFLECTS 0°11' RT. AT STA 7+15
-0.594 % MK. 0.5'
-0.595 % MK. 0.3'
-0.683 % MK. 0.5'
16TH ST.
WOODROW COURT
PROJ. NO. C-13-10