



BM 143.78 "M" IN 1ST x FIRE HD W5 WATERLY 50' N. NL BOSTON
BM 145.94 "M" IN MUELLER FIRE HD. WATERLY & GRAND
BM 145.98 "M" IN MUELLER FIRE HD. NW COR WATERLY & ZIMMERLY

PROPERTY	CITY
33.0	477
40.4	773
42.6	<u>125.0</u>
55.0	
49.0	
112.6	
54.9	
311.5	
373.5	
400.5	
249.3	
135.7	
94.4	
46.3	
<u>2675.3</u>	

PROPERTY	CITY
2075.3	125.0
377.8	27.8
<u>411.9</u>	<u>452.4</u>
210	200.0
3366.0	<u>577.4</u>
335.6	30.6
<u>3702.6</u>	<u>577.4</u>
200.0	635.1
50.0	avg 56.0

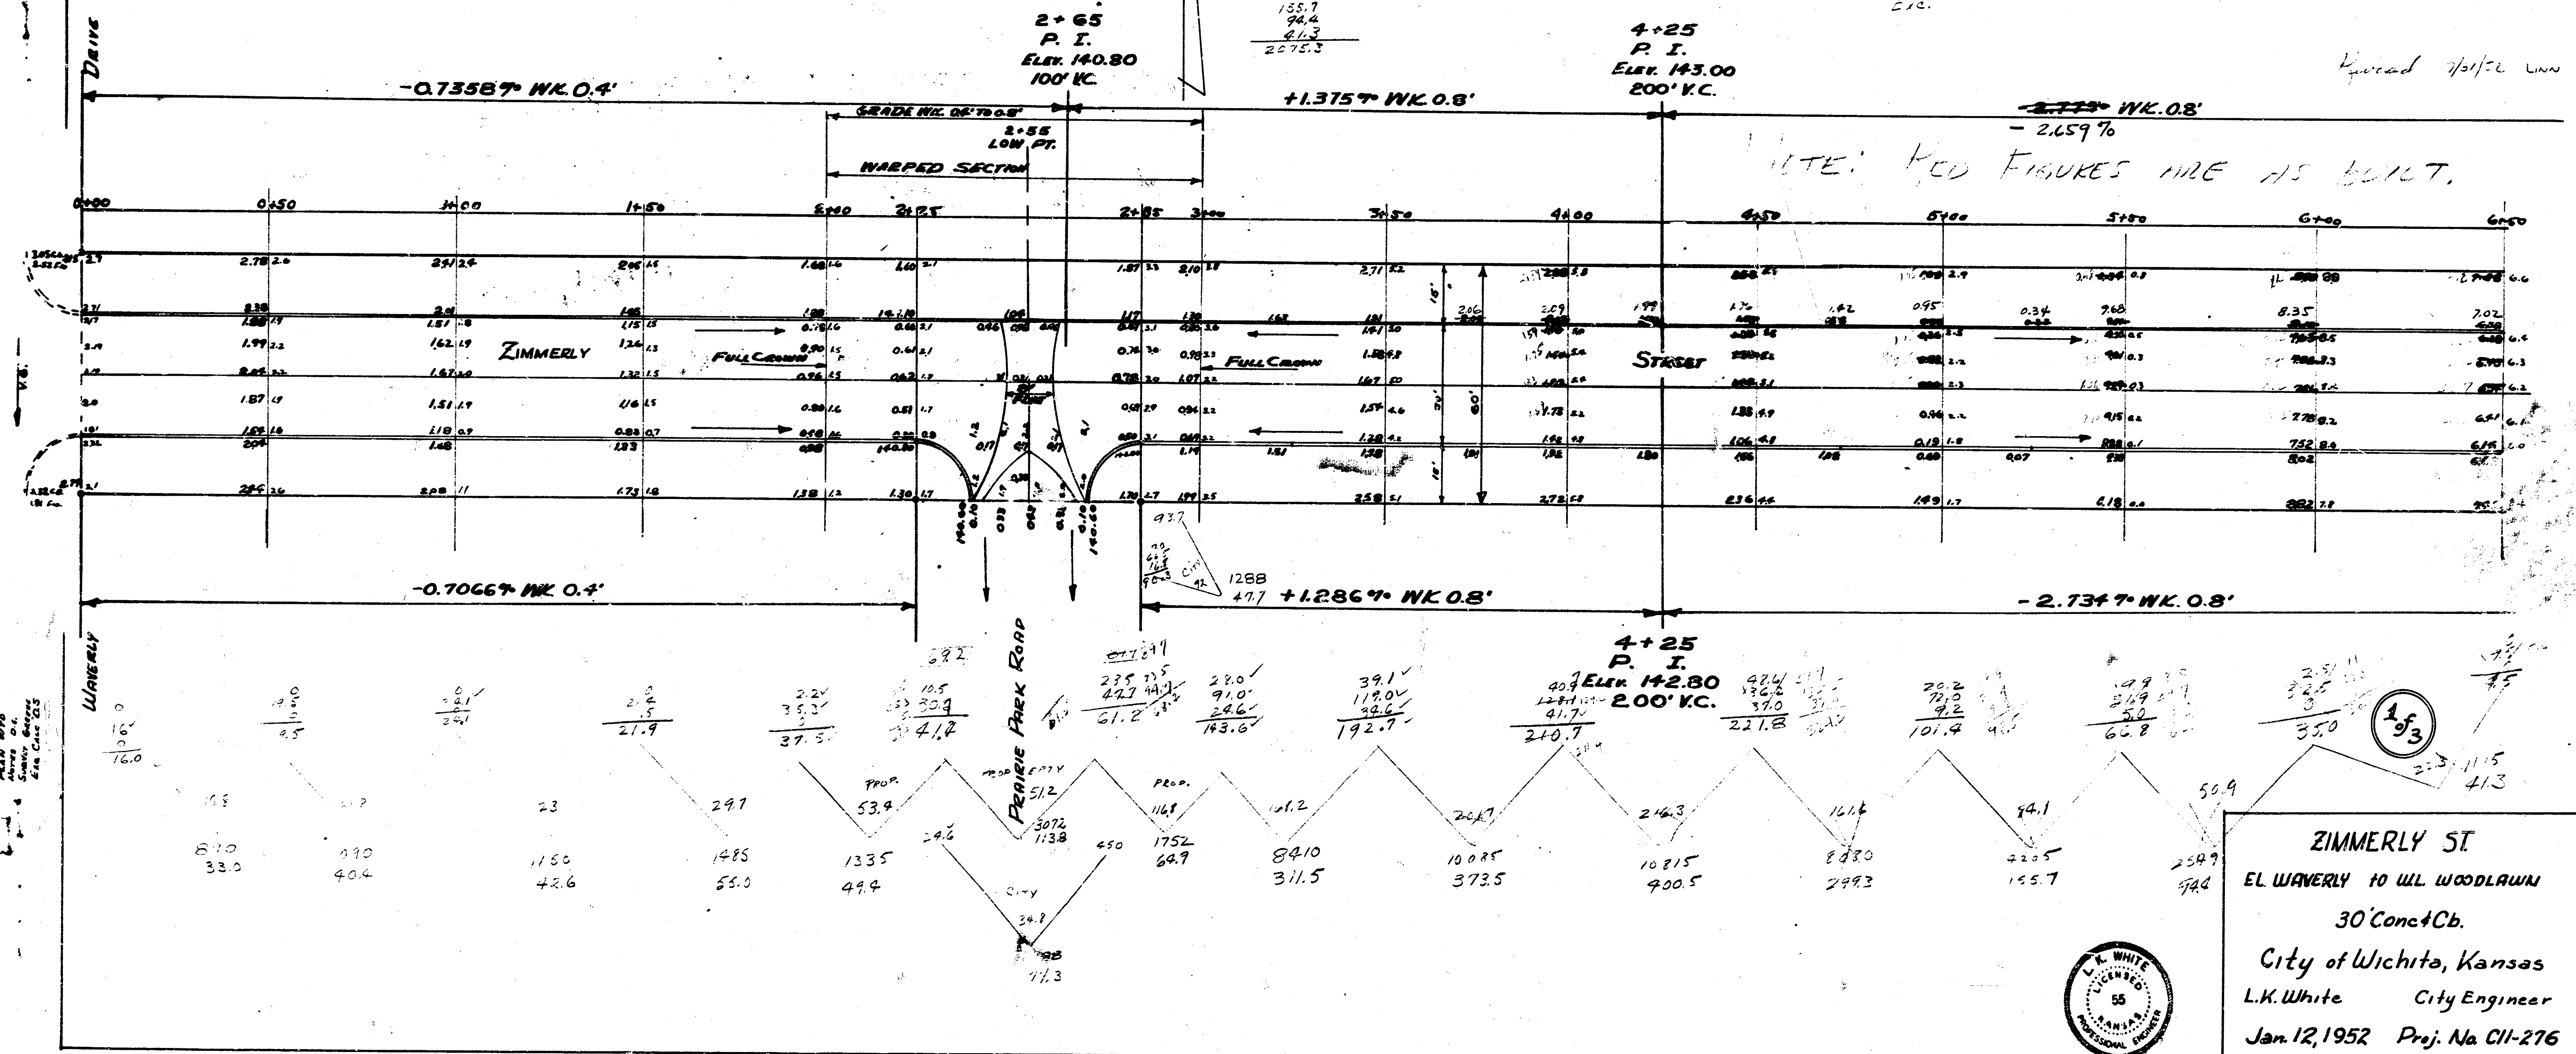


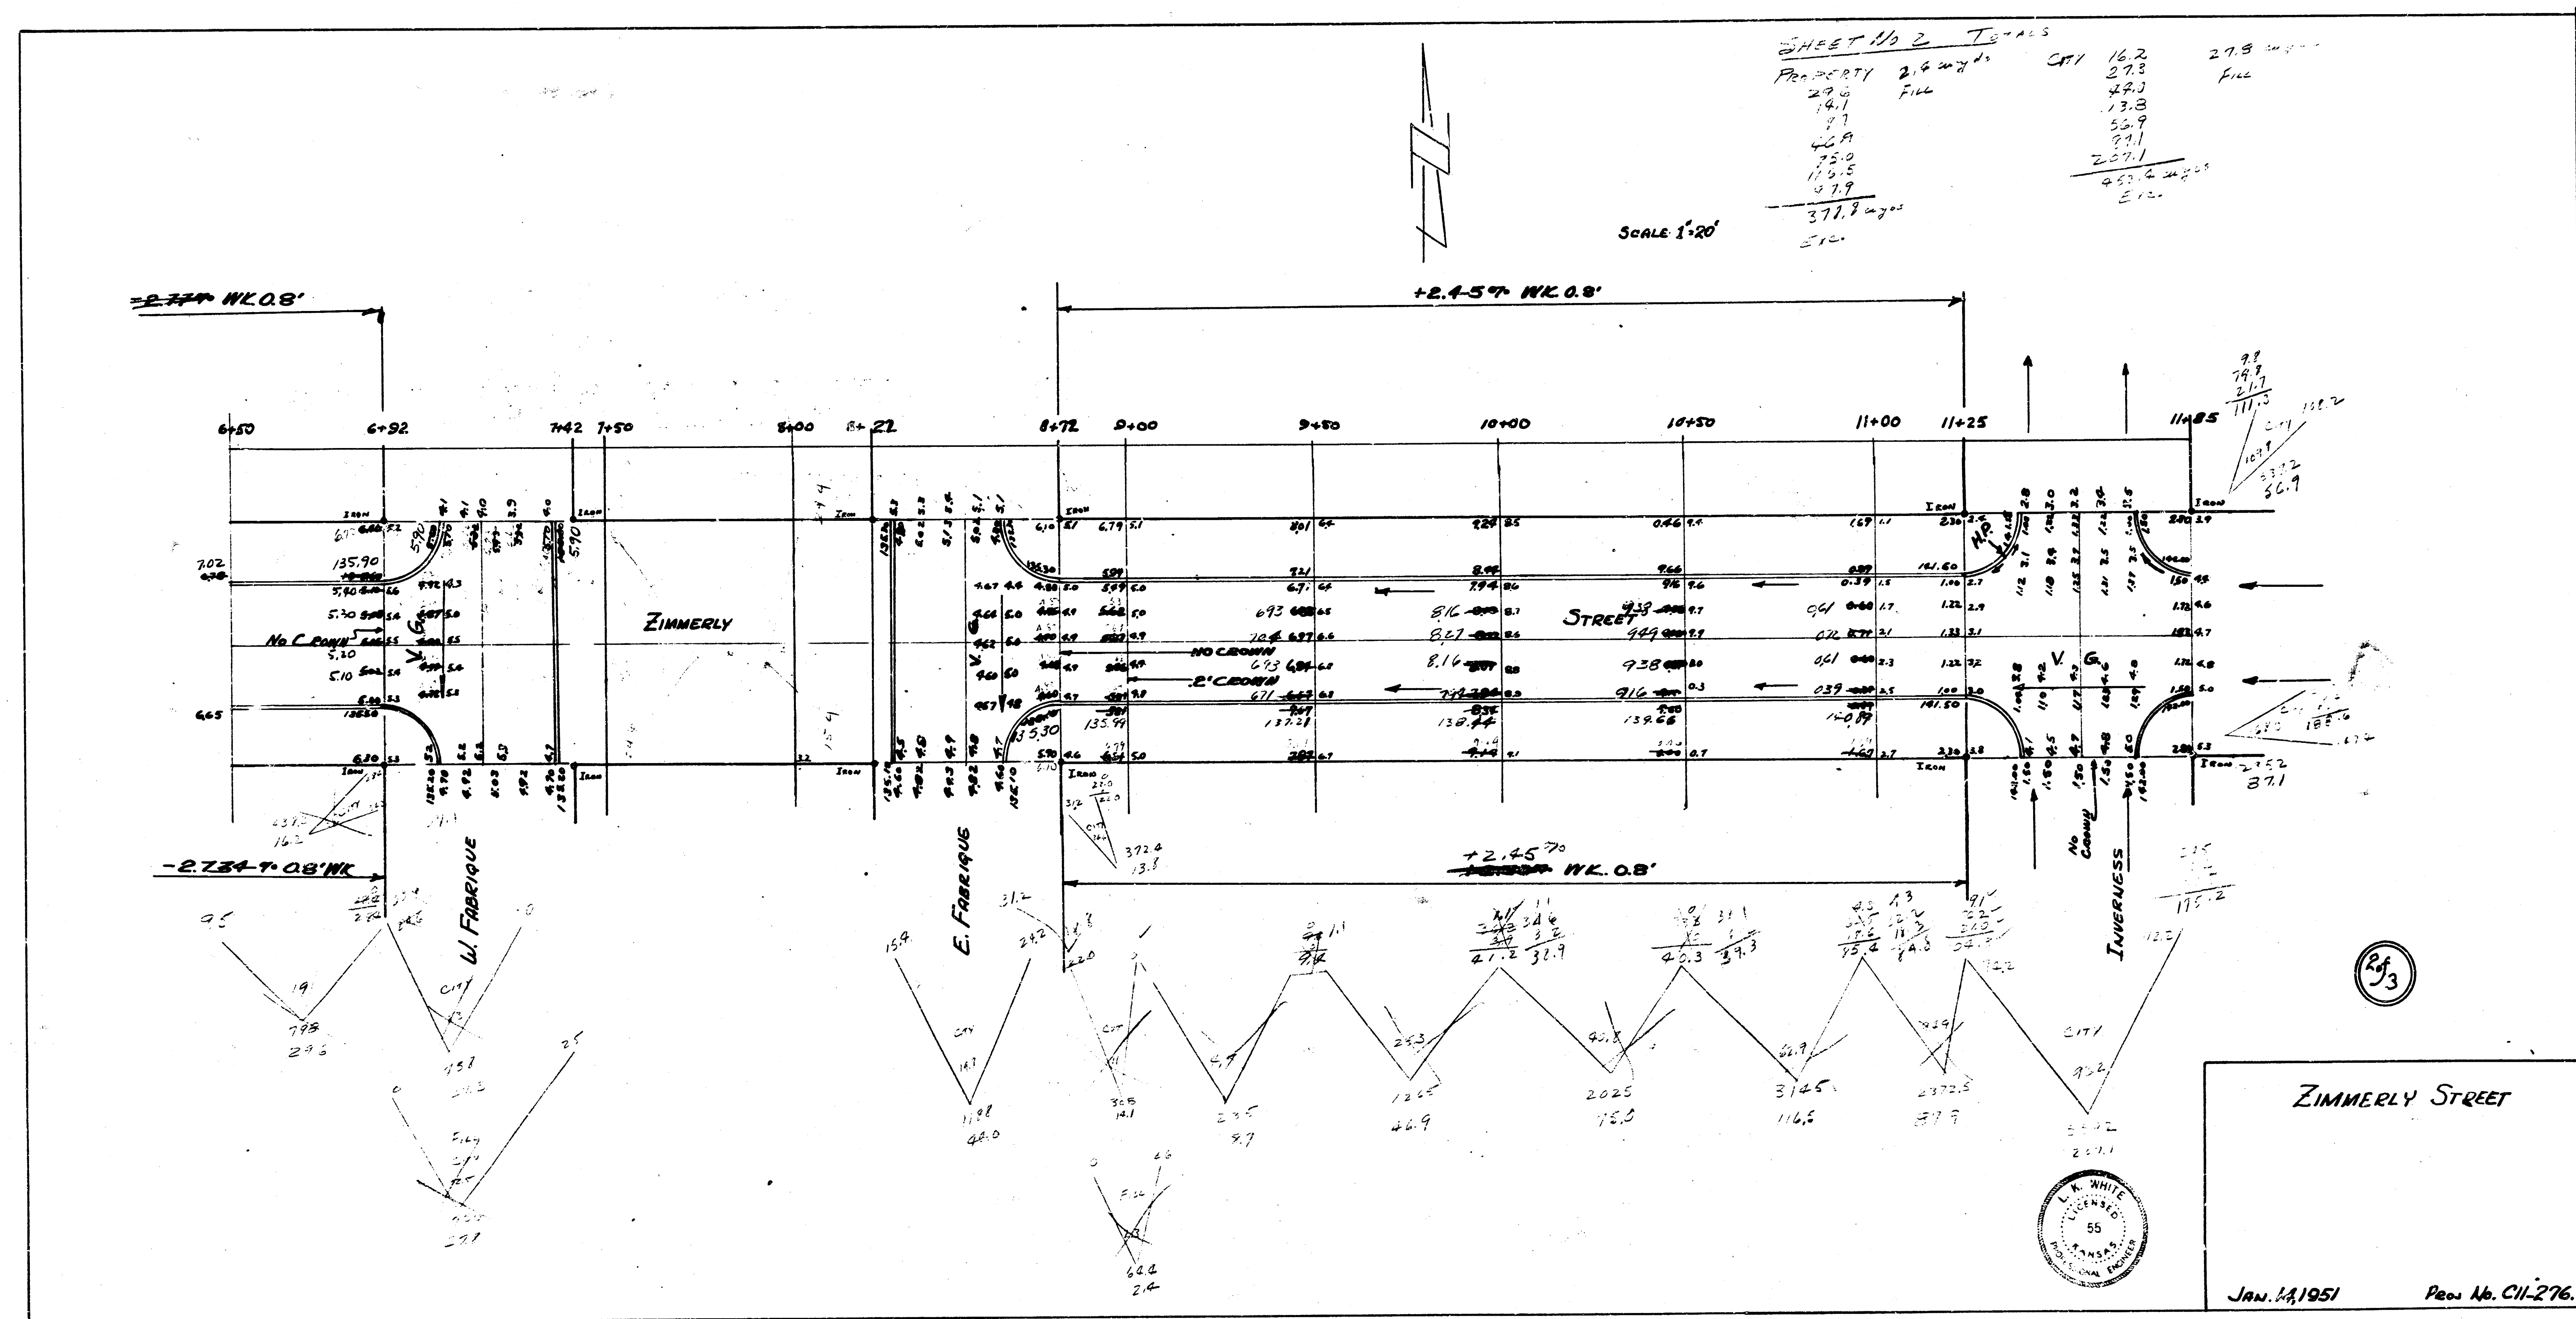



SCALE 1"=20'

SM. 8
PROPERTY
102.8
272.8
179.3
127.3
711.9 CHANGES ETC.

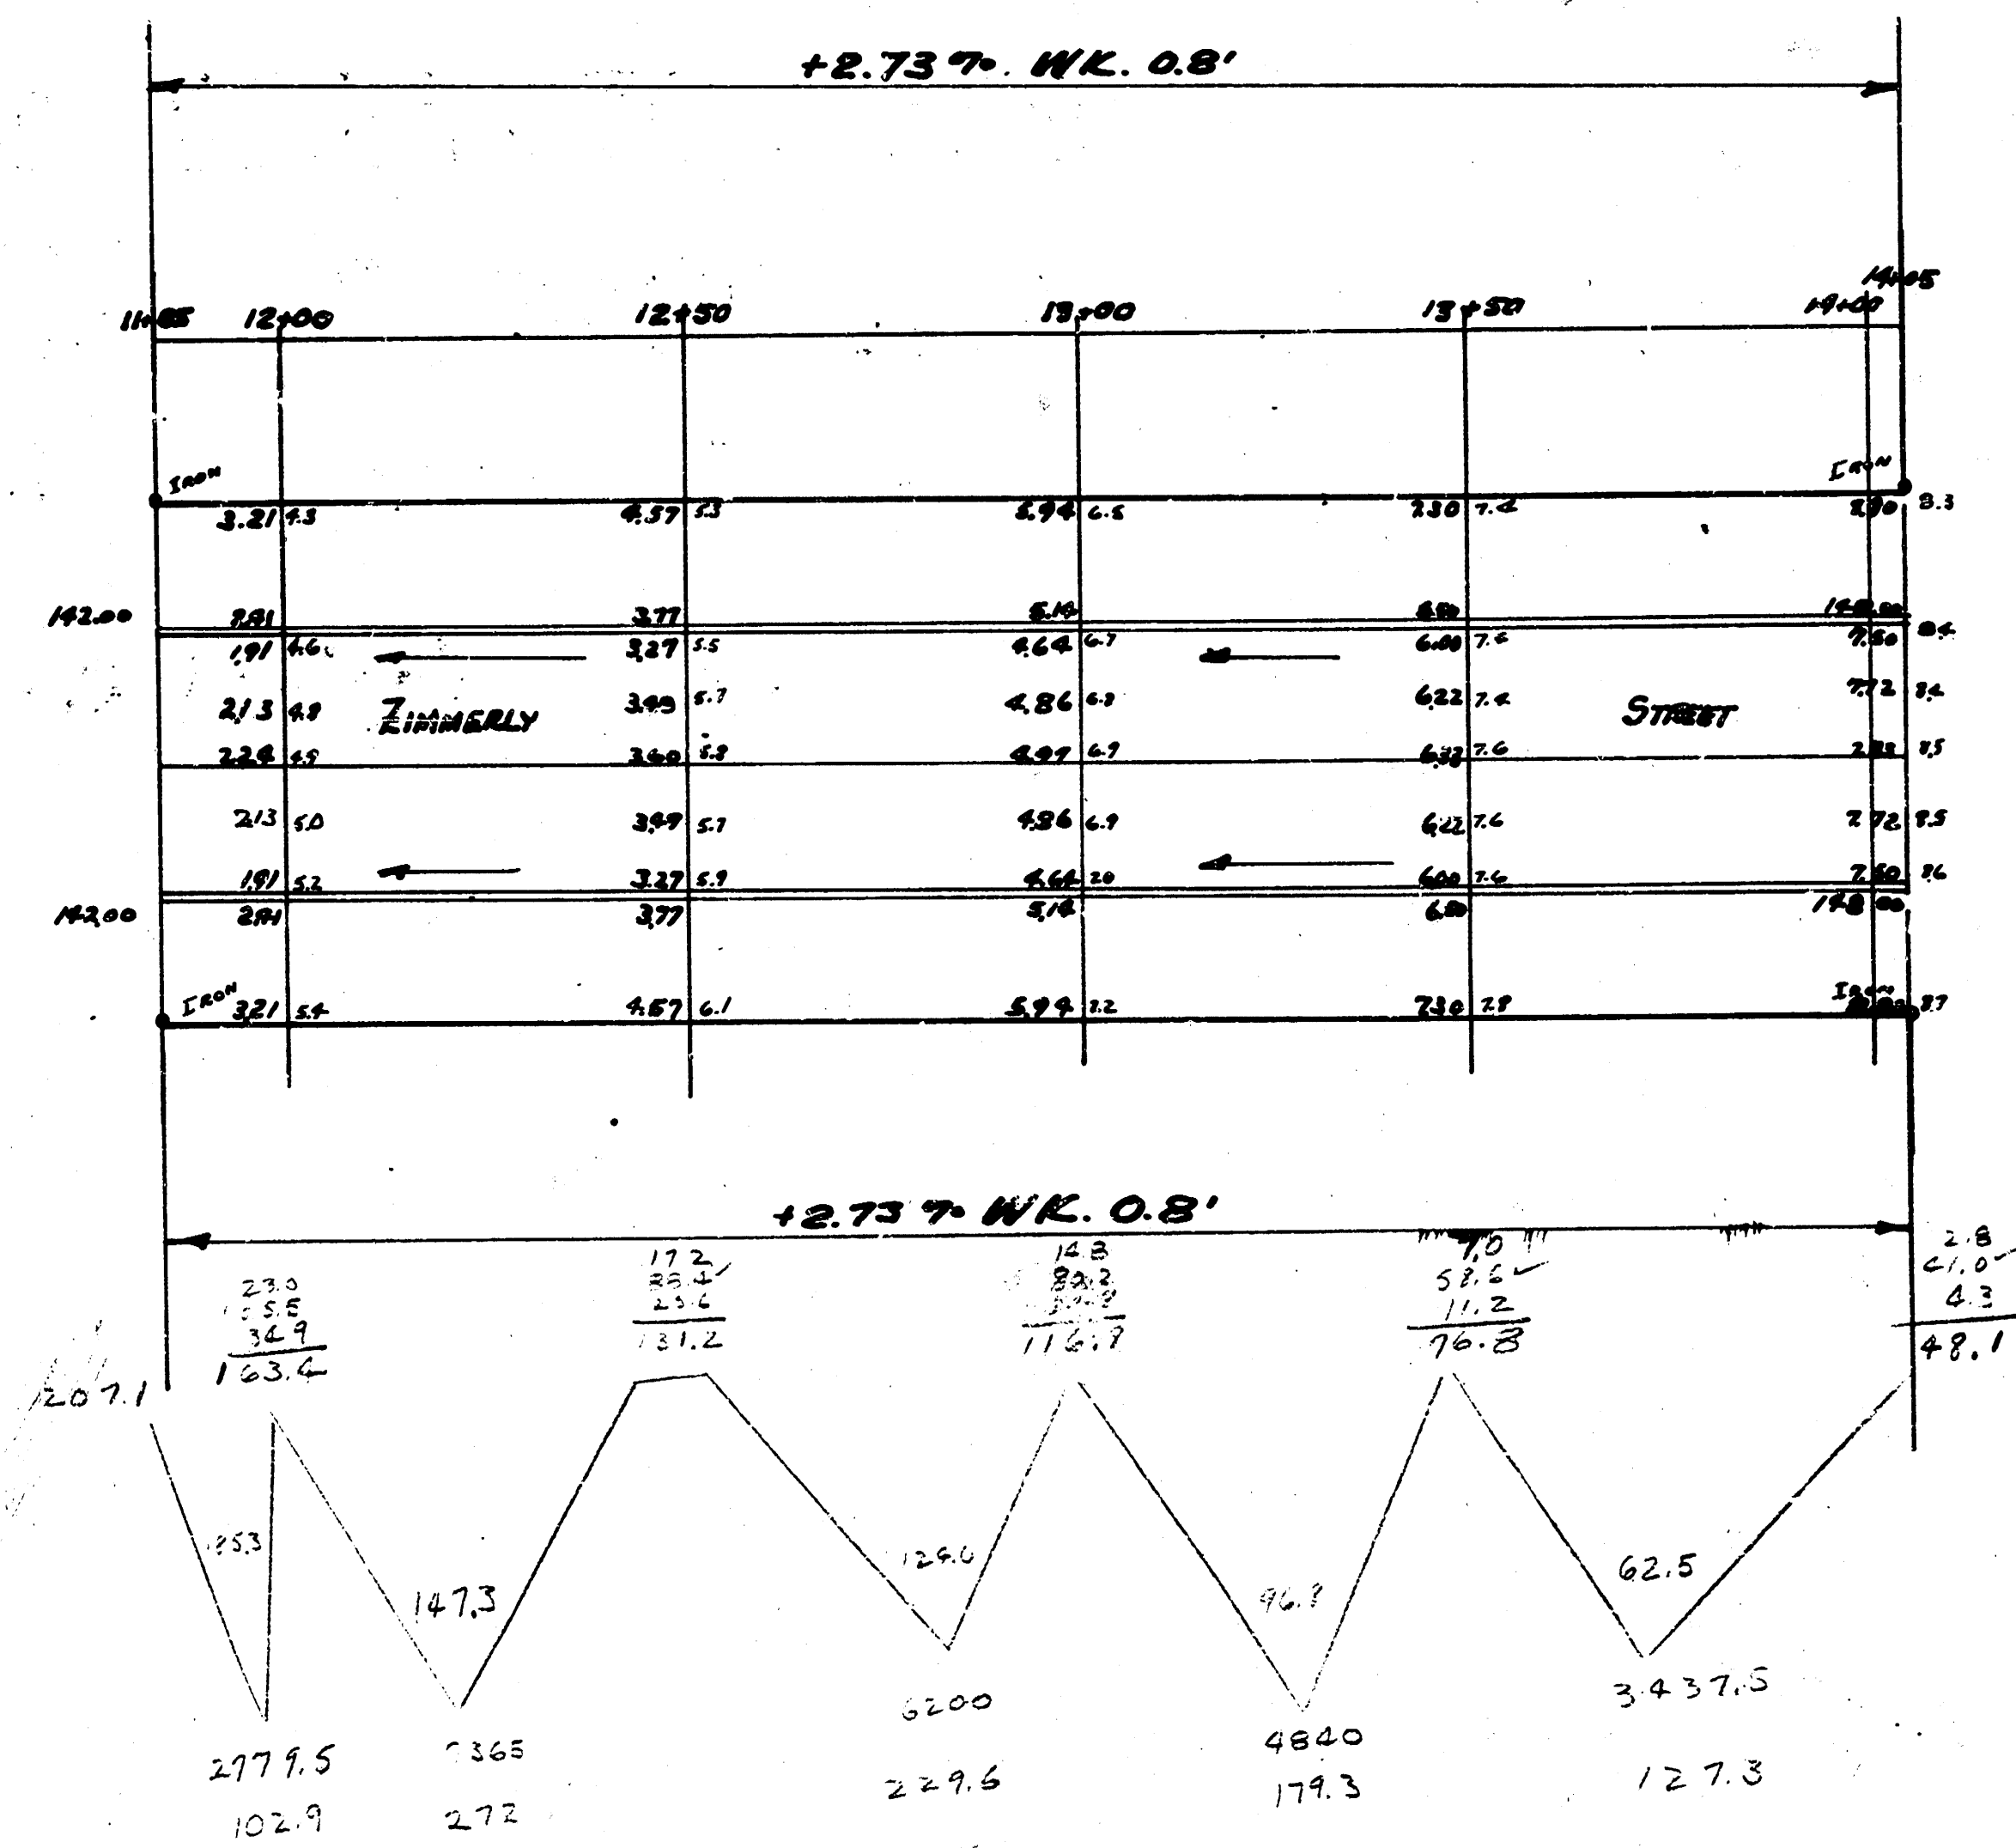

WOODLAWN BLVD

3/3

ZIMMERLY STREET



JAN. 14, 1951

Proj. No. C11-276

4 15 3 55