



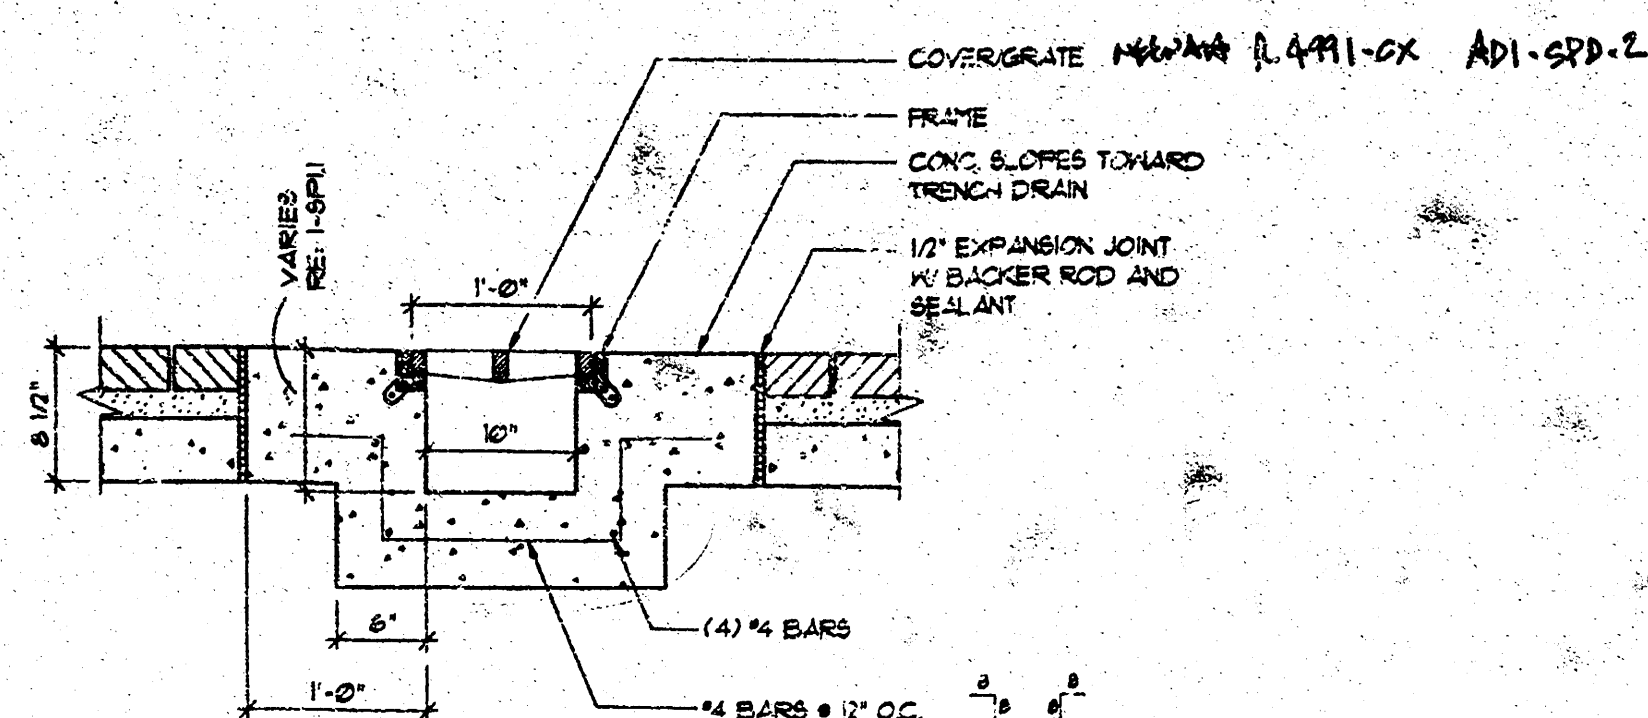

(B) SECTION

2 SECTION B-B

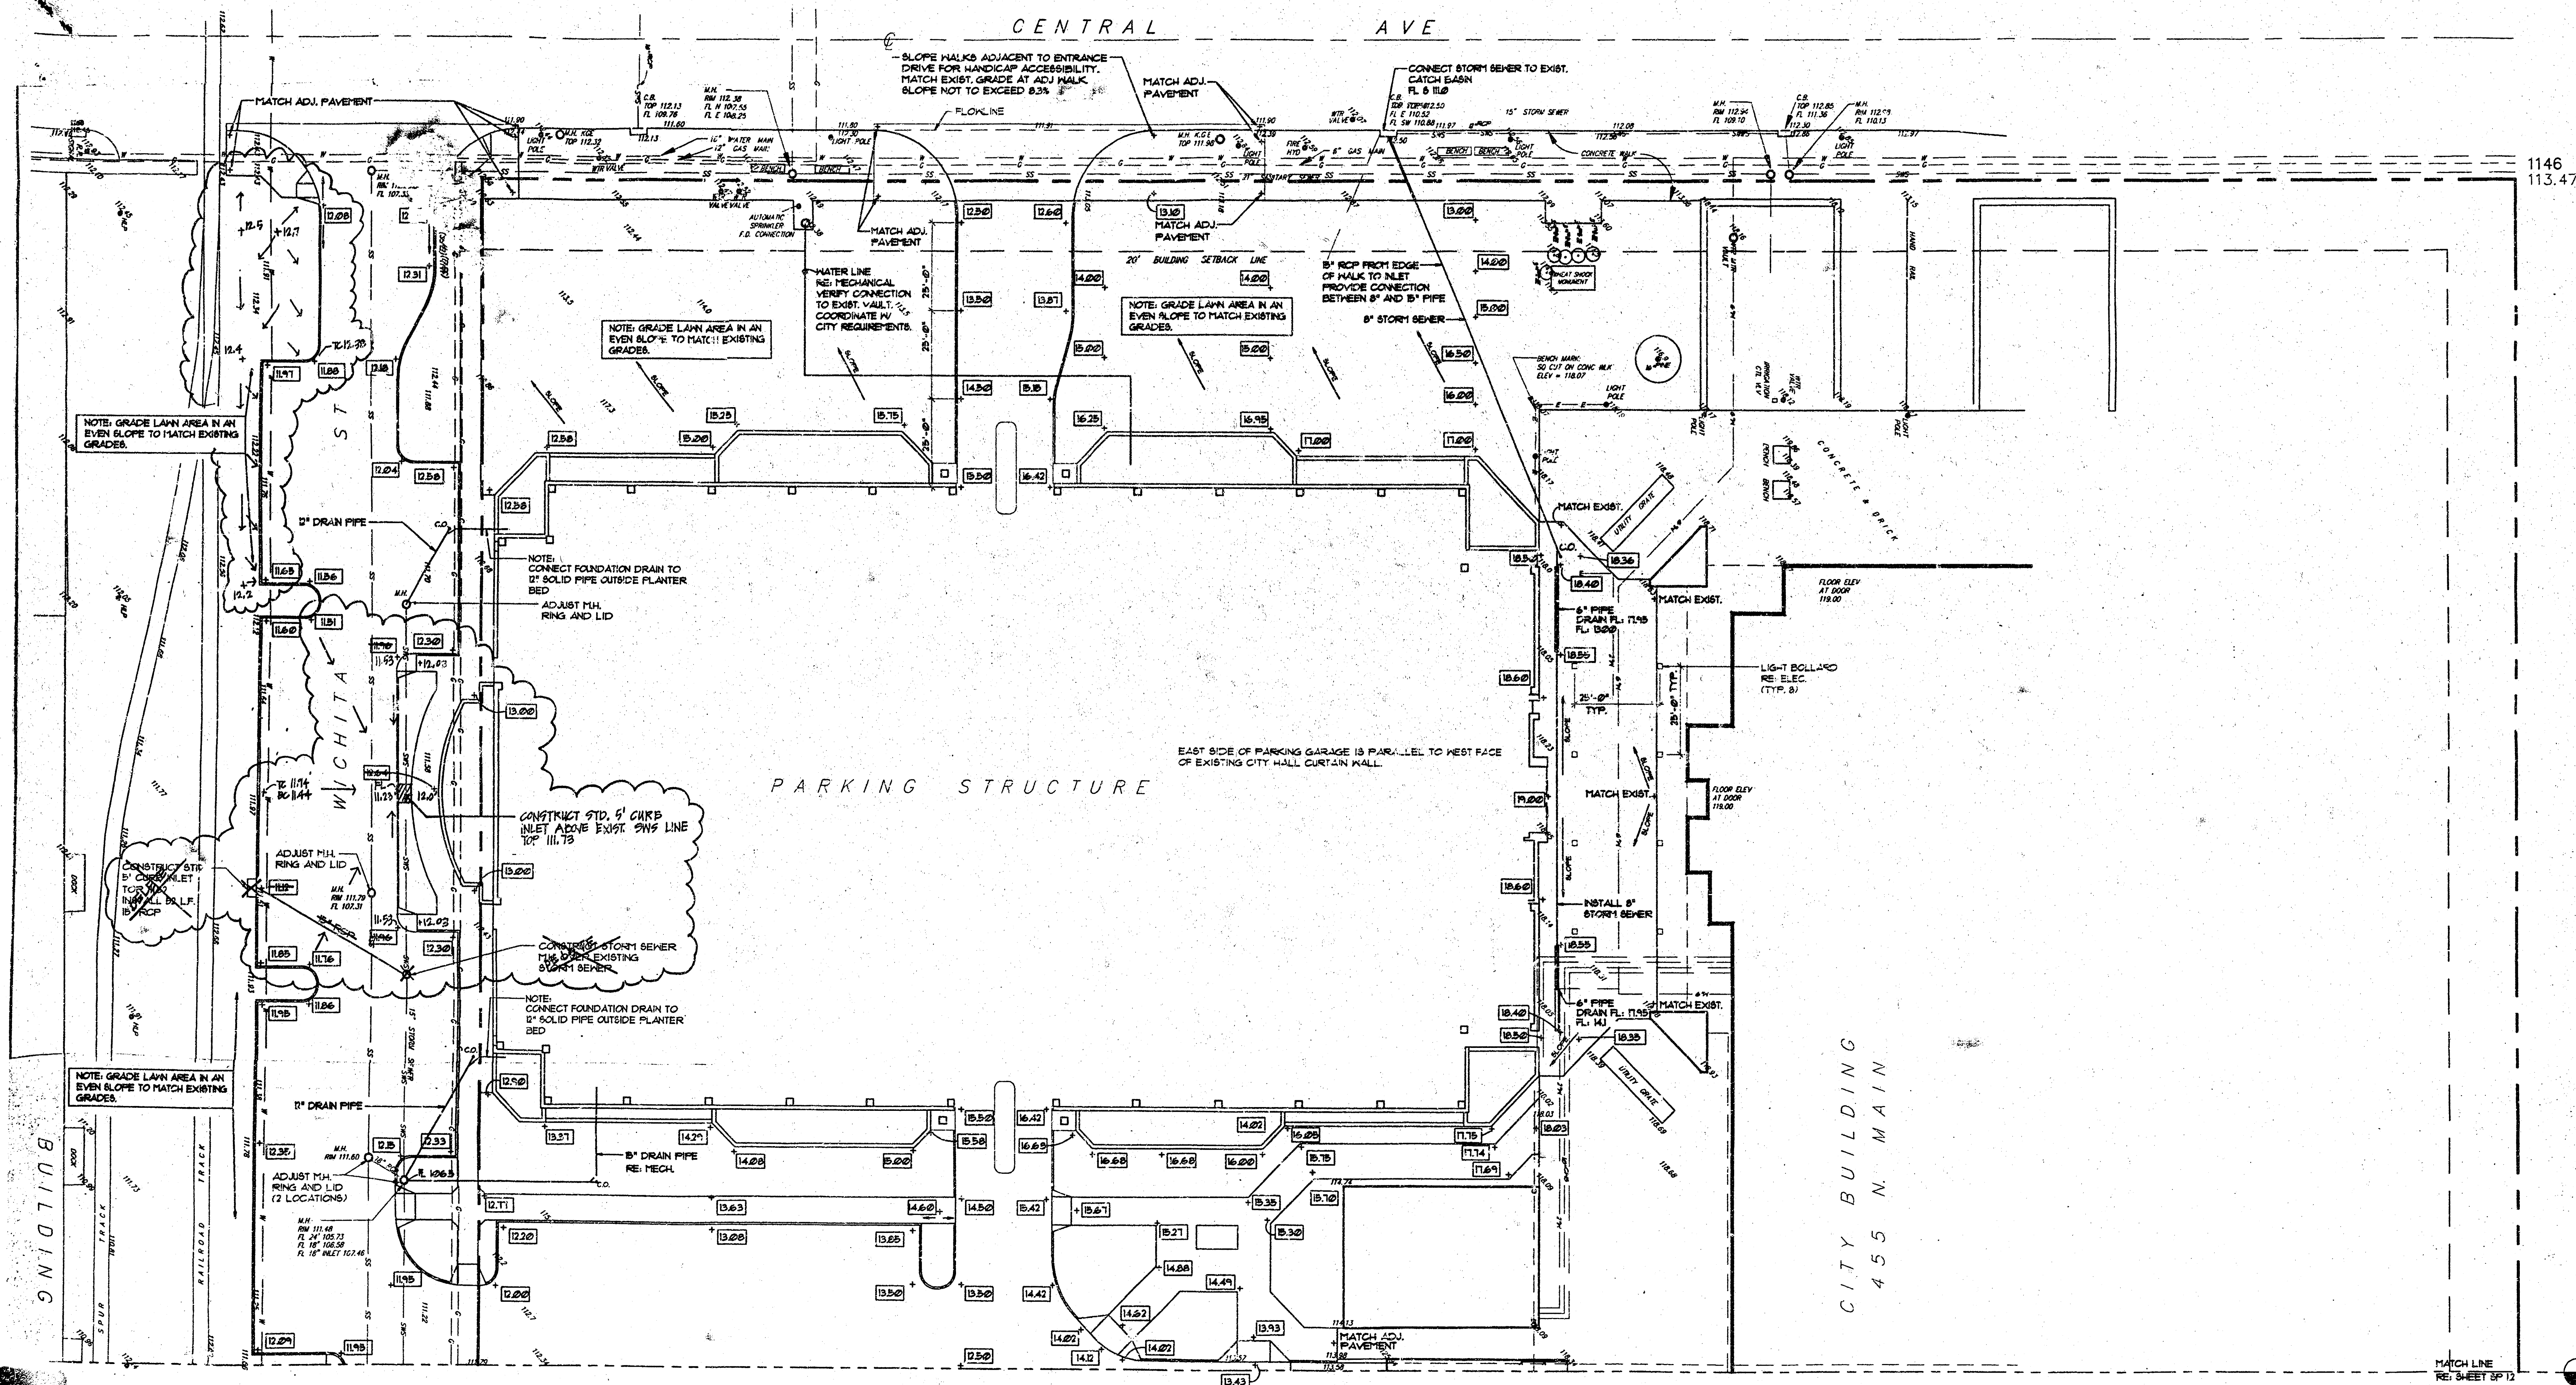


UTILITY/GRADING PLAN

OBLINGER
MASON
McCLUGGAGE
& VAN SICKLE
CORPORATION

Architectural Plans Landscape Architects
P.O. Box 3843
Wichita, Kansas 67201
123 S. Washington
Wichita, Kansas 67202
316 262-0451
316 262-0455 FAX

CITY HALL PARKING STRUCTURE
CITY OF WICHITA
WICHITA, KANSAS

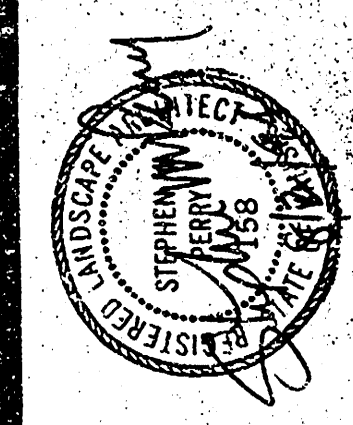


PROJECT NO. 9223
DATE: AUGUST 2, 1974
REVISED:

SHEET

SP1.1

OF SHEETS

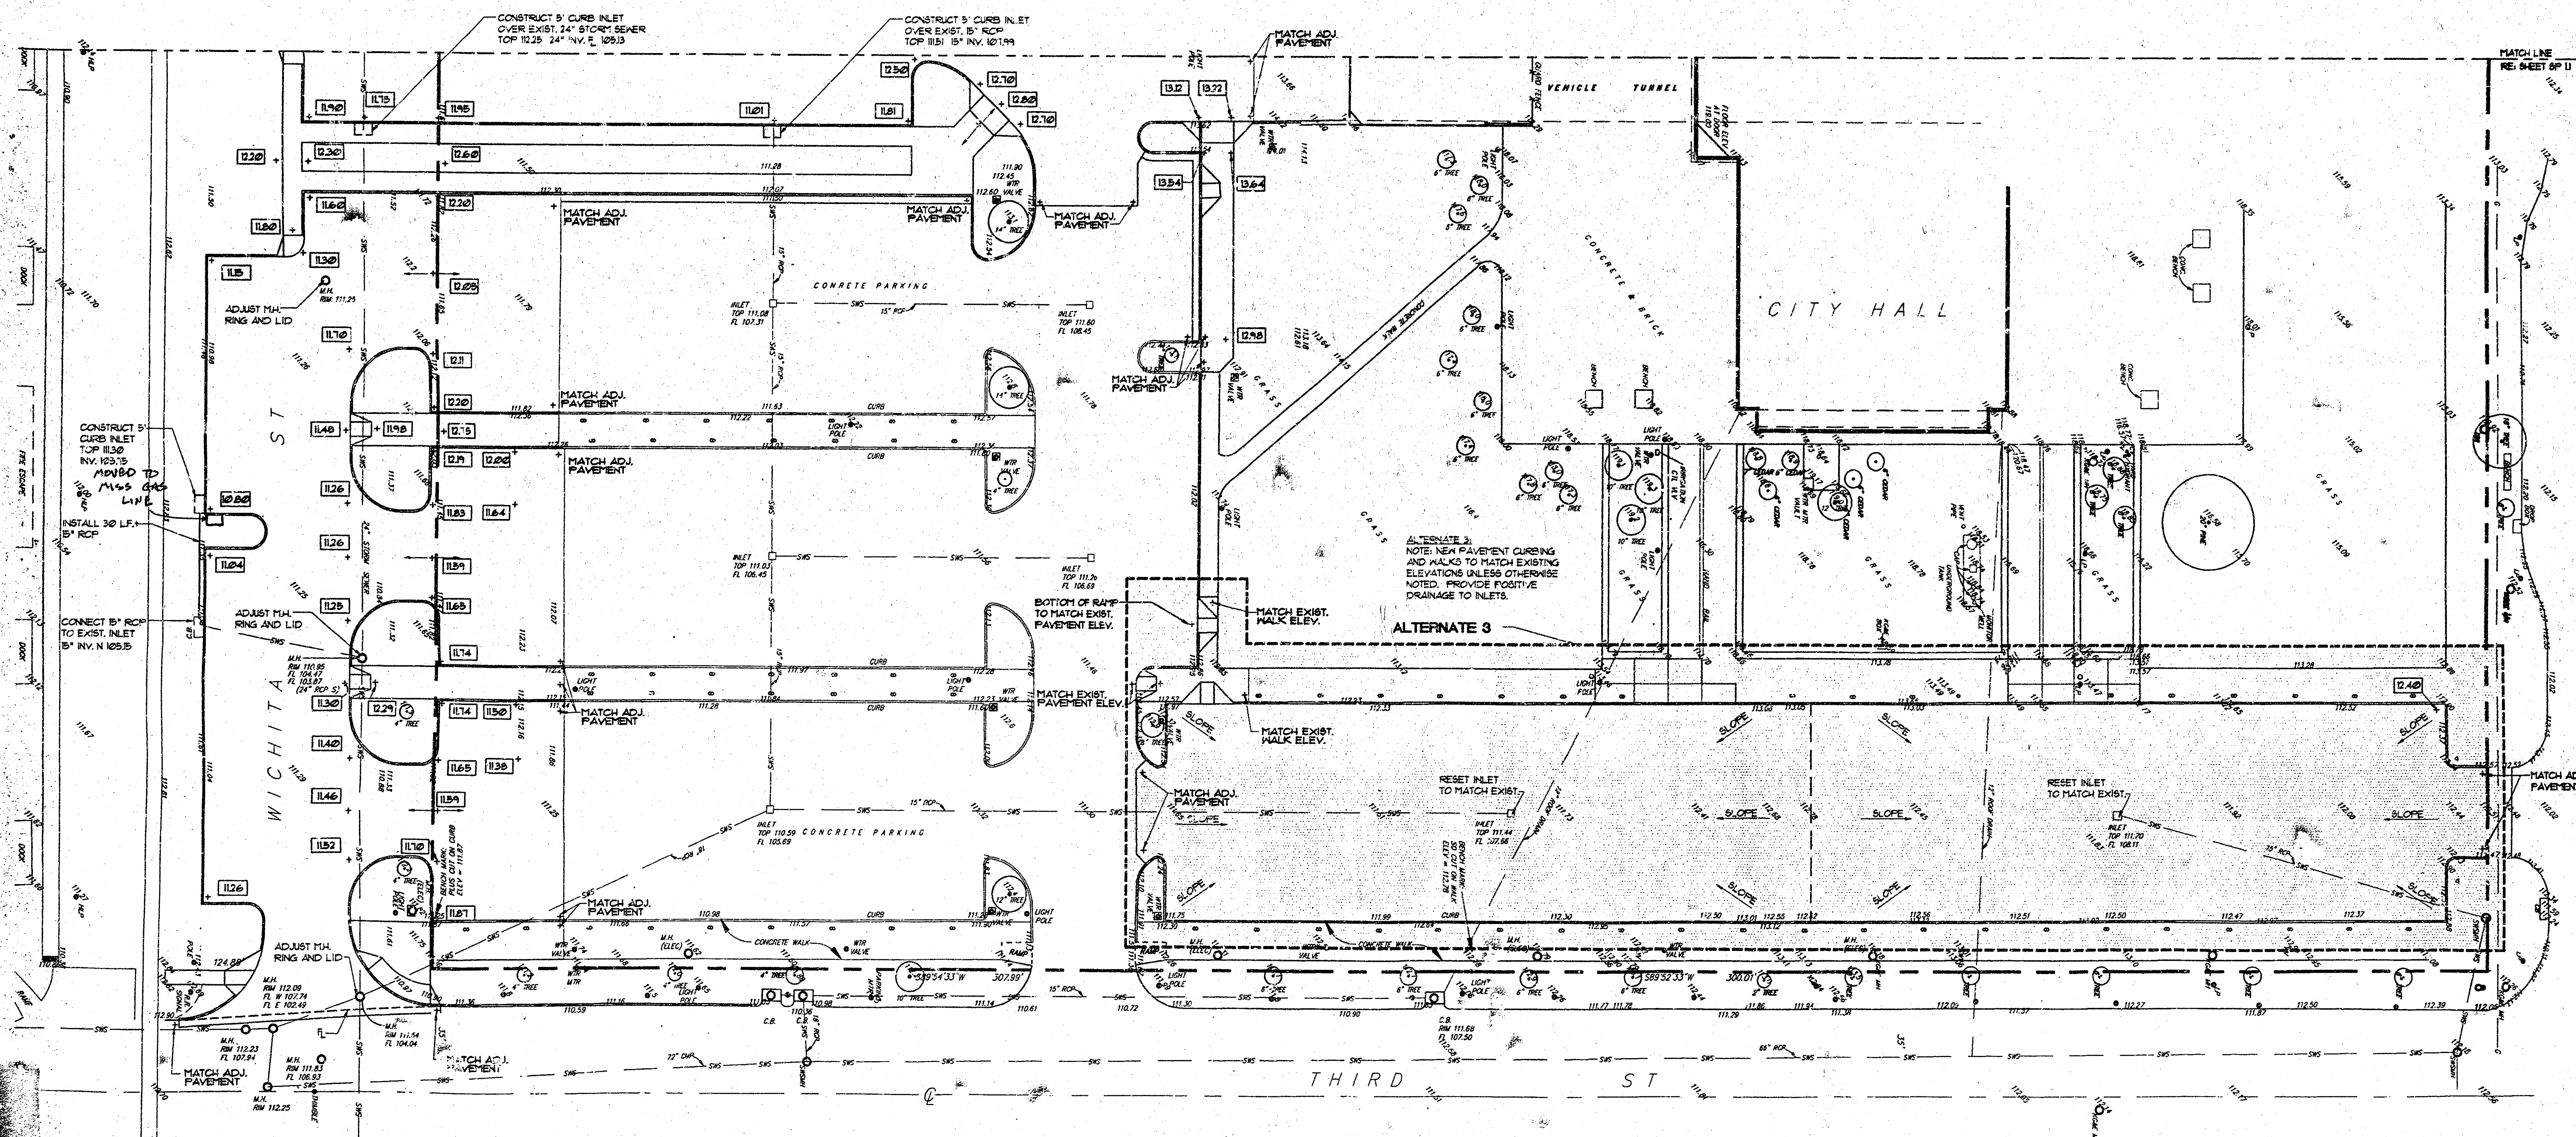


UTILITY/GRADING PLAN
1" = 20'-0"

**OBLINGER
MASON
McLIGGAGE
& VAN SICKLE
CORPORATION**



Architects, Engineers, Landscapers & Architects
P.O. Box 8848
Wichita, Kansas 67201
180 S. Washington
Wichita, Kansas 67202
(316) 862-0481
(316) 862-0485 FAX

**CITY HALL PARKING STRUCTURE
CITY OF WICHITA
WICHITA, KANSAS**

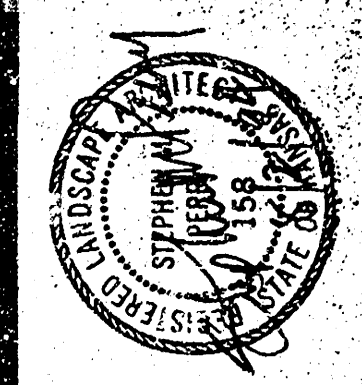

PROJECT NO. 923
DATE: AUGUST 2, 1994
REVIS: _____
DRAWN: _____
CHECKED: _____

**SHEET
SP12
OF SHEETS**