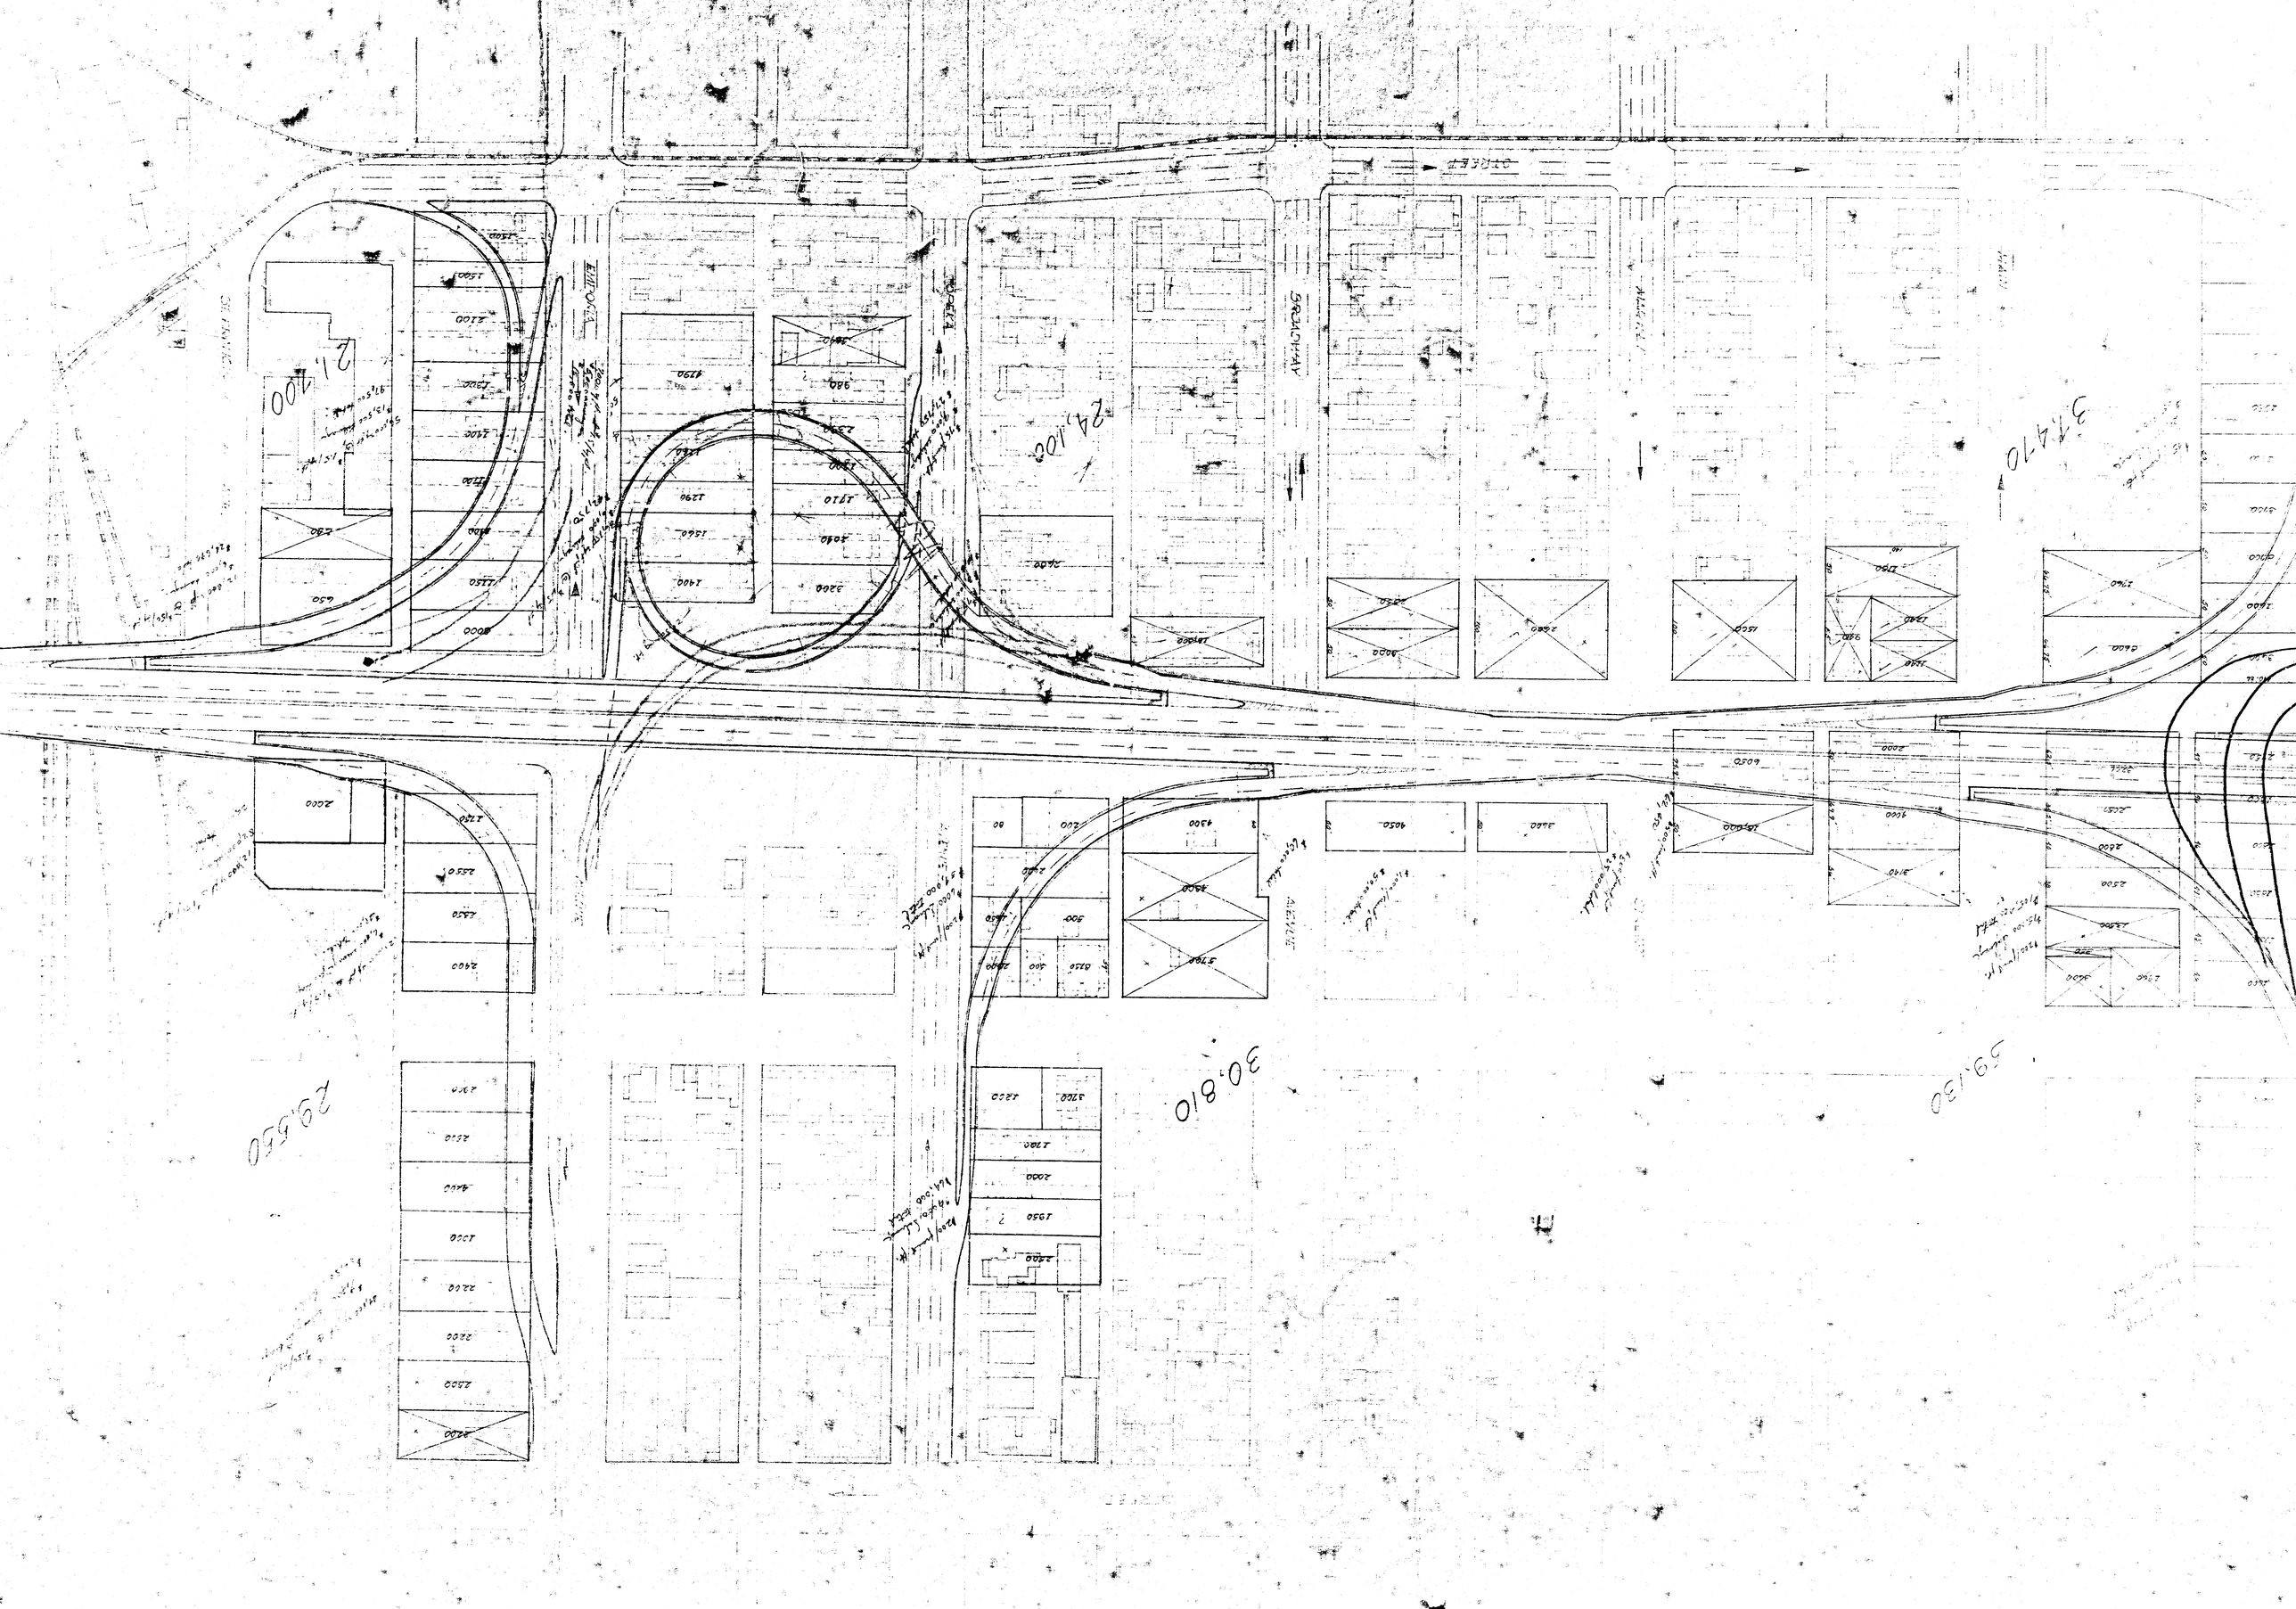
BROADWAY
24,100
21,400
29,650
30,810
59,130
31,470








STREET

