
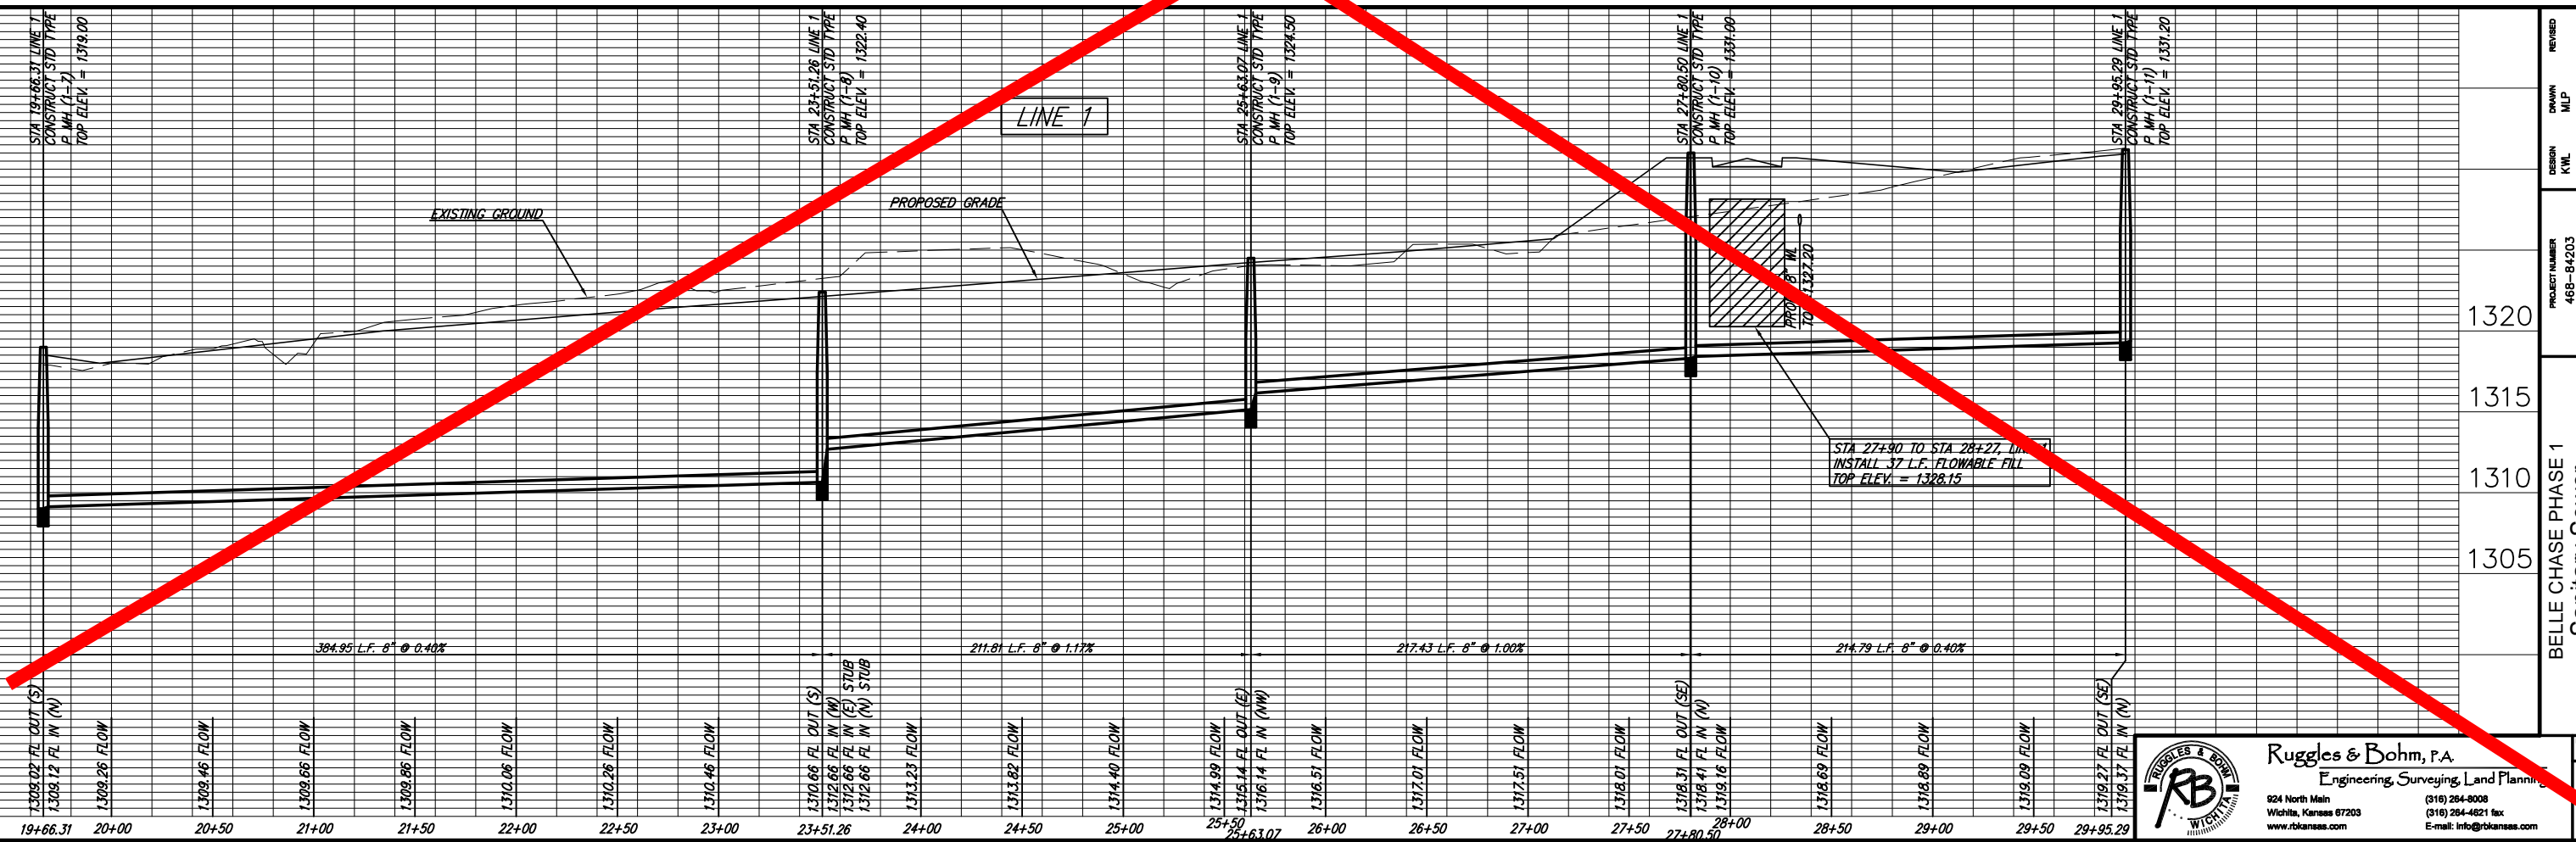
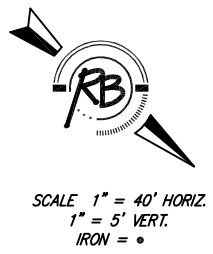


SEWER SERVICE TABLE

NUMBER	TYPE	LOCATION			FOR INFORMATION ONLY	
		LOT NO.	BLOCK NO.	LINE NO.	STATION \ DIRECTION	APPROXIMATE LENGTH 4" PIPE
8	8" X 4" Tee Saddle	10	-	1	28+70/R	VERTICAL: 10' HORIZONTAL: 15'

NOTE: Vertical Riser Pipe shall be extended to 2' minimum above ground and water elevation and 4' maximum below proposed ground elevation.

SEE REVISED SHEET

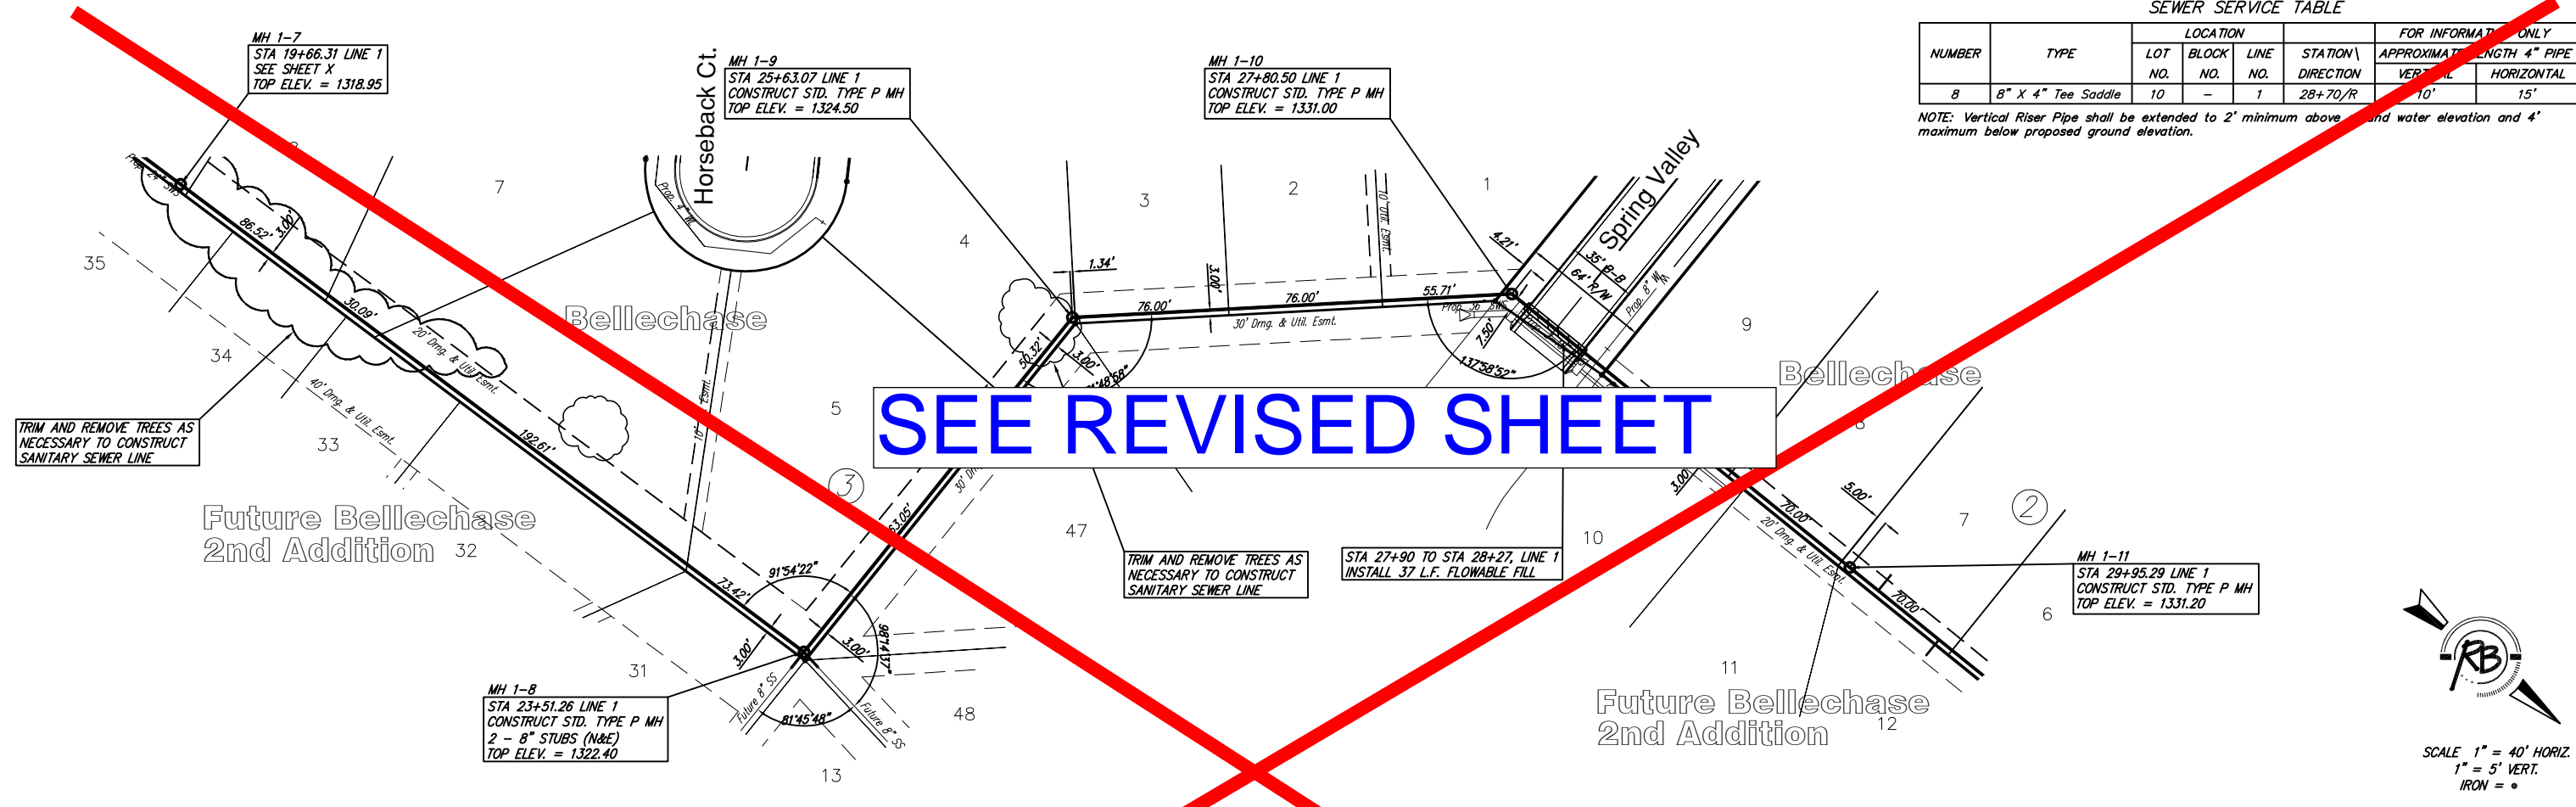

PROJECT NUMBER 468-84203	DESIGN KWL	DRAWN MLP	REVIEW MLP
DRAWING FILE Sanitary Sewer LINE 1CJ	UTILITY	DATE Sept. 11, 2006	REVIEW
BELLECHASE PHASE 1 Sanitary Sewer		WICHITA, KANSAS	
1320	1315	1310	1305

Ruggles & Bohm, P.A.
Engineering, Surveying, Land Planning
924 North Main
Wichita, Kansas 67203
www.rtkansas.com
(316) 264-8008
(316) 264-4621 fax
E-mail: info@rtkansas.com