



SEE REVISED SHEET

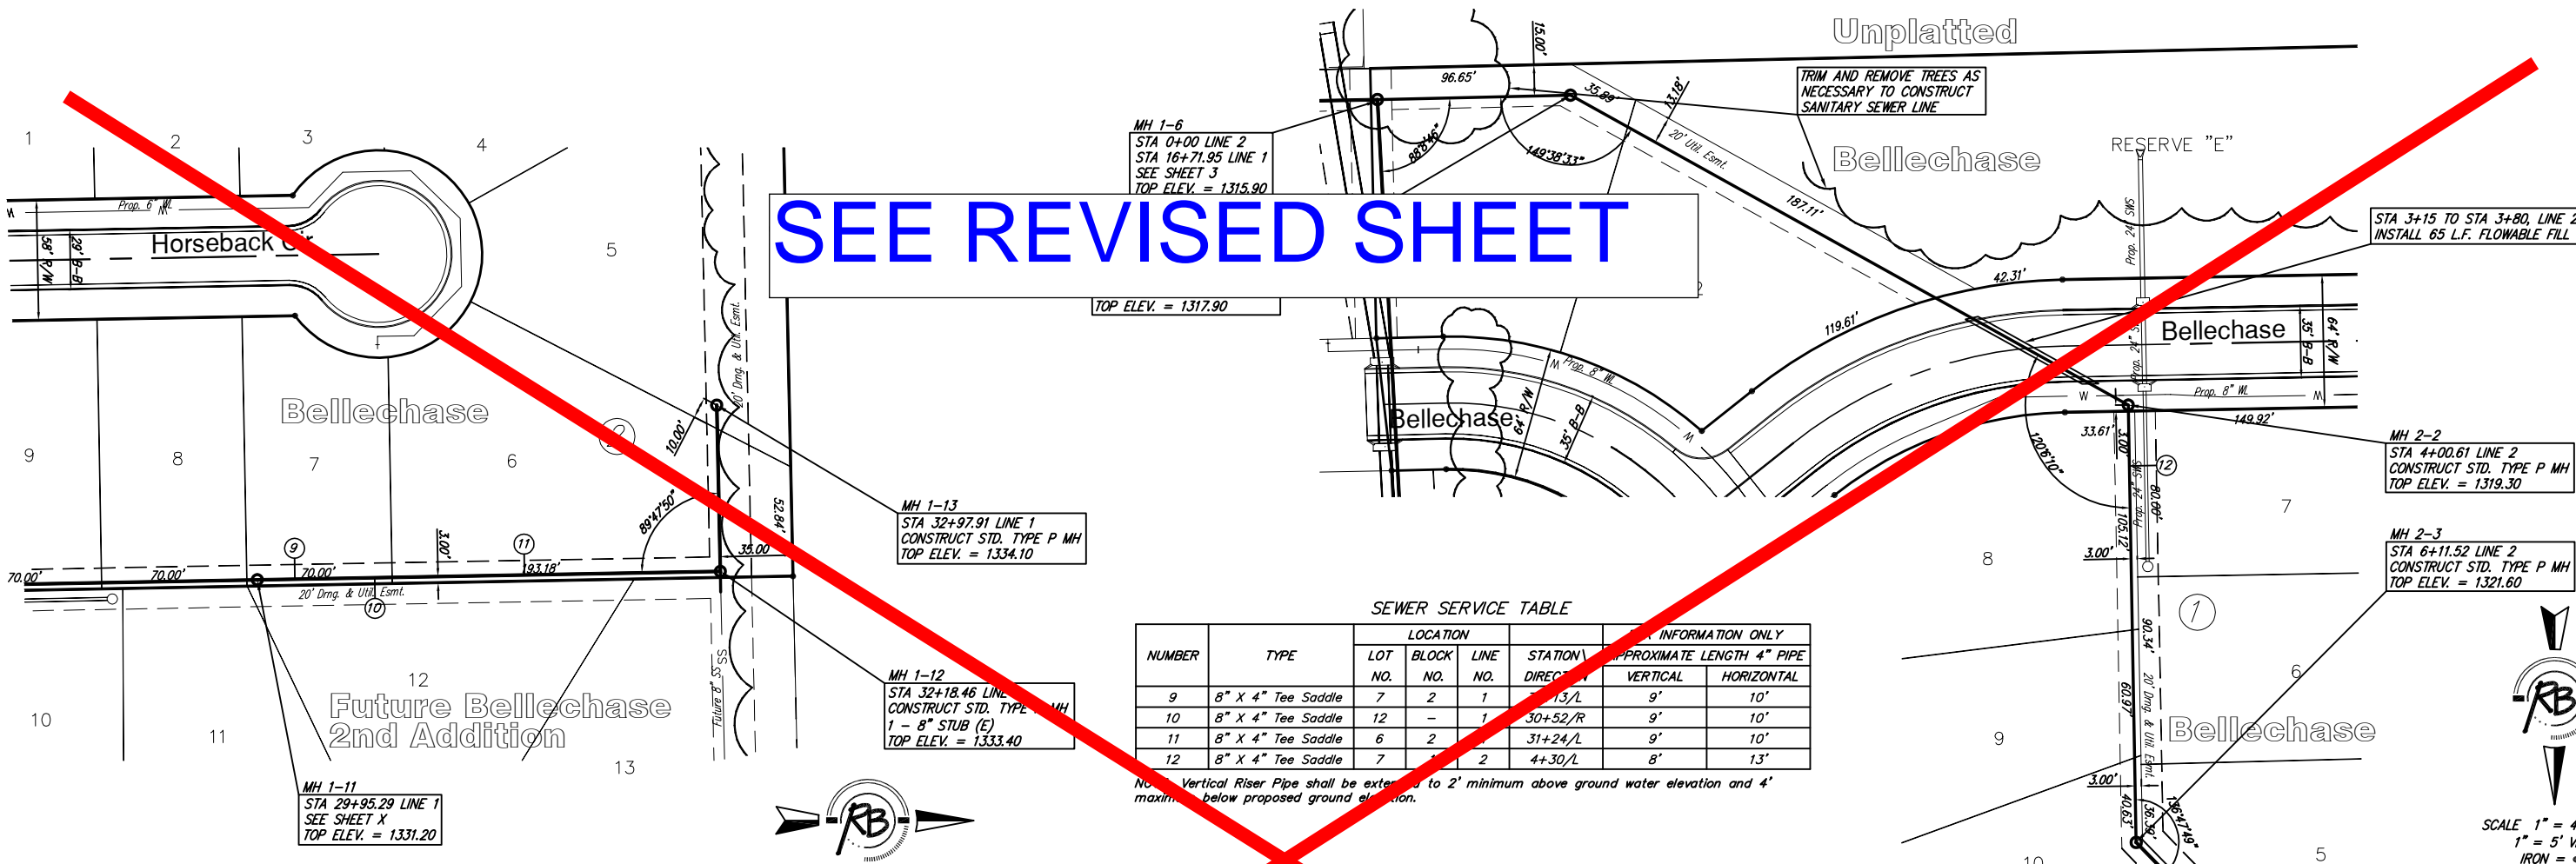

SEWER SERVICE TABLE

NUMBER	TYPE	LOCATION				INFORMATION ONLY	
		LOT NO.	BLOCK NO.	LINE NO.	STATION \ DIRECTION	APPROXIMATE LENGTH 4" PIPE	VERTICAL
9	8" X 4" Tee Saddle	7	2	1	13/L	9'	10'
10	8" X 4" Tee Saddle	12	-	1	30+52/R	9'	10'
11	8" X 4" Tee Saddle	6	2	1	31+24/L	9'	10'
12	8" X 4" Tee Saddle	7	2	2	4+30/L	8'	13'

No. Vertical Riser Pipe shall be extended to 2' minimum above ground water elevation and 4' maximum below proposed ground elevation.

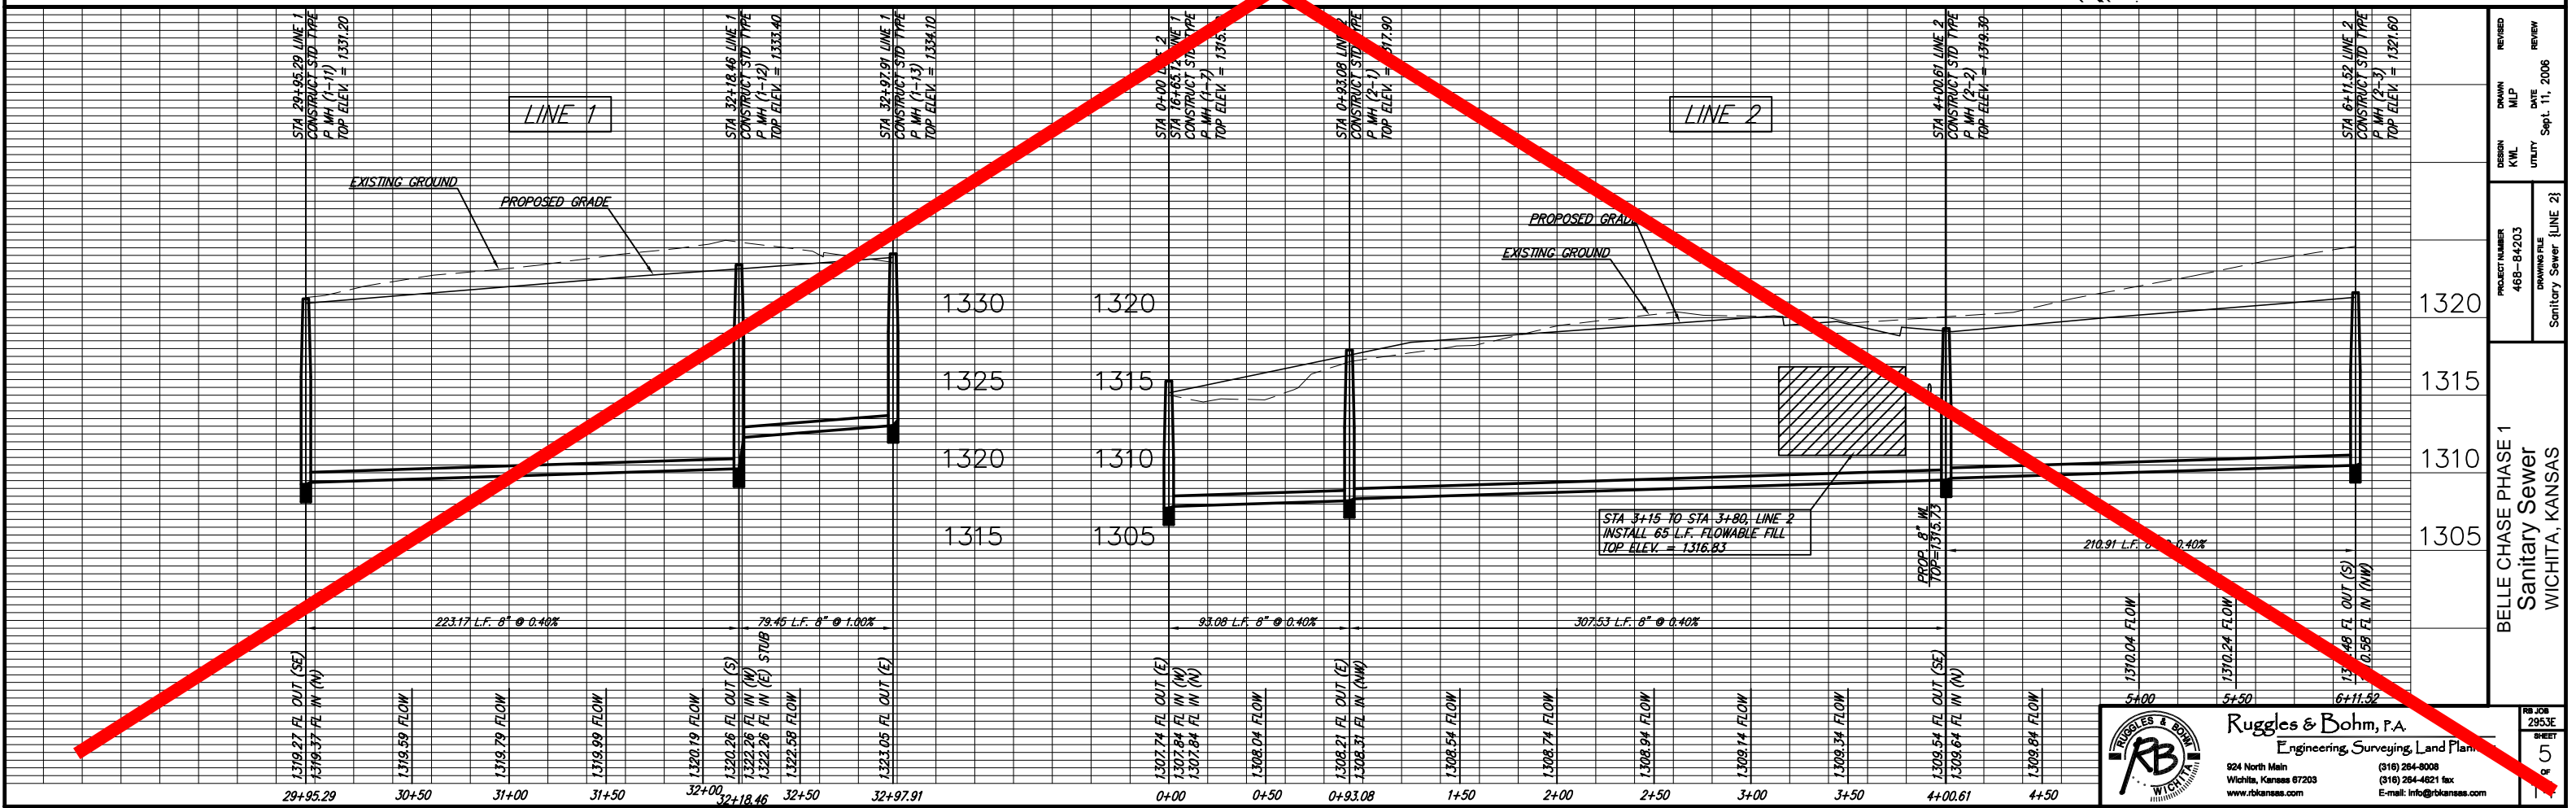

SCALE 1" = 40' HORIZ.
1" = 5' VERT.
IRON = ●



PROJECT NUMBER: 468-84203
 DESIGN: KWL
 DRAWING FILE: Sanitary Sewer [LINE 2]
 DRAWN: MLP
 DATE: Sept. 11, 2006
 REVIEW: []
 BELLECHASE PHASE 1
 Sanitary Sewer
 WICHITA, KANSAS
 RB JOB: 2953E
 SHEET: 8

Ruggles & Bohm, P.A.
 Engineering, Surveying, Land Planning
 924 North Main
 Wichita, Kansas 67203
 www.rtkansas.com
 (316) 264-8008
 (316) 264-4621 fax
 E-mail: info@rtkansas.com