


APPROVED AS NOTED
BY CITY ENGINEER OF INC. STA

Sewer Sewers _____
Storm Sewers VRH 9/15/95
Driveway Approaches _____
Water Mains _____
Paving _____

NOTE TO CONTRACTORS
Inspection and testing for this project are to be provided by a Licensed Consulting Engineering Firm under contract to the Owner / Developer. Said inspection to be in accordance with the City of Wichita standard construction engineering practices and carried by a Licensed Professional Engineer. No work shall be performed in dedicated easements or public right-of-way by the Contractor without such inspection nor shall any work be commenced without written authorization by the City Engineer. All Construction and Materials shall comply with the City of Wichita Specifications and Standards (on file and available in the City Engineer's Office).

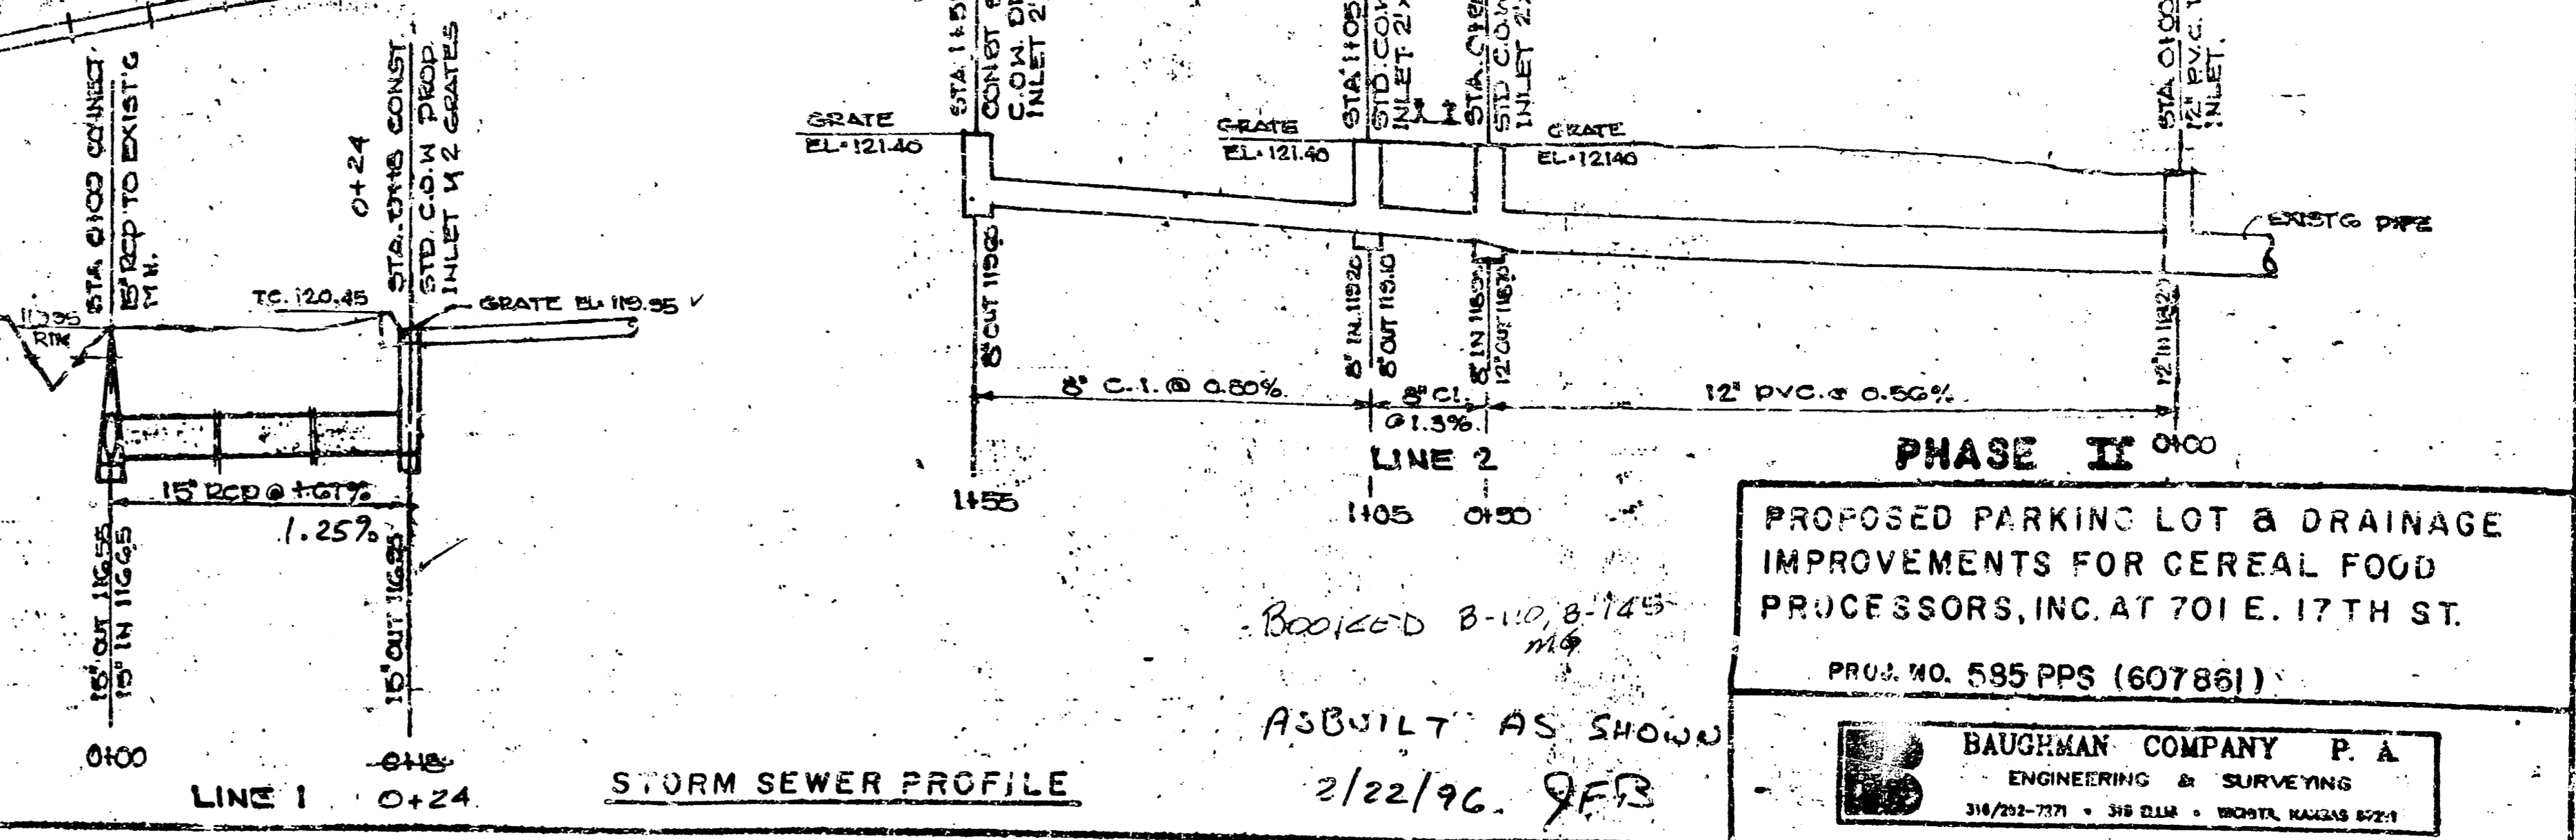

PHASE II
PROPOSED PARKING LOT & DRAINAGE IMPROVEMENTS FOR CEREAL FOOD PROCESSORS, INC. AT 701 E. 17TH ST.
PROJ. NO. 585 PPS (607861)

BAUGHMAN COMPANY P.A.
ENGINEERING & SURVEYING
314/281-7711 • 38 ELM • WORTH, KANSAS 67211

2/22/96 JFF

B.M. R.R. Sp. 3. Face R.P.
W. Side E. Drive of
Cereal Foods
Elev. 121.51