


Contact ARKLA Gas Company For Locates
Phone: 942-8350

Sta. 0+00 Line 1
Connect to Existing
30" RCP Storm Drain
Construct 5' x 4' Type
'A' SWS Manhole
Top Elev = 141.40

CAUTION!
ARKLA Gas Line

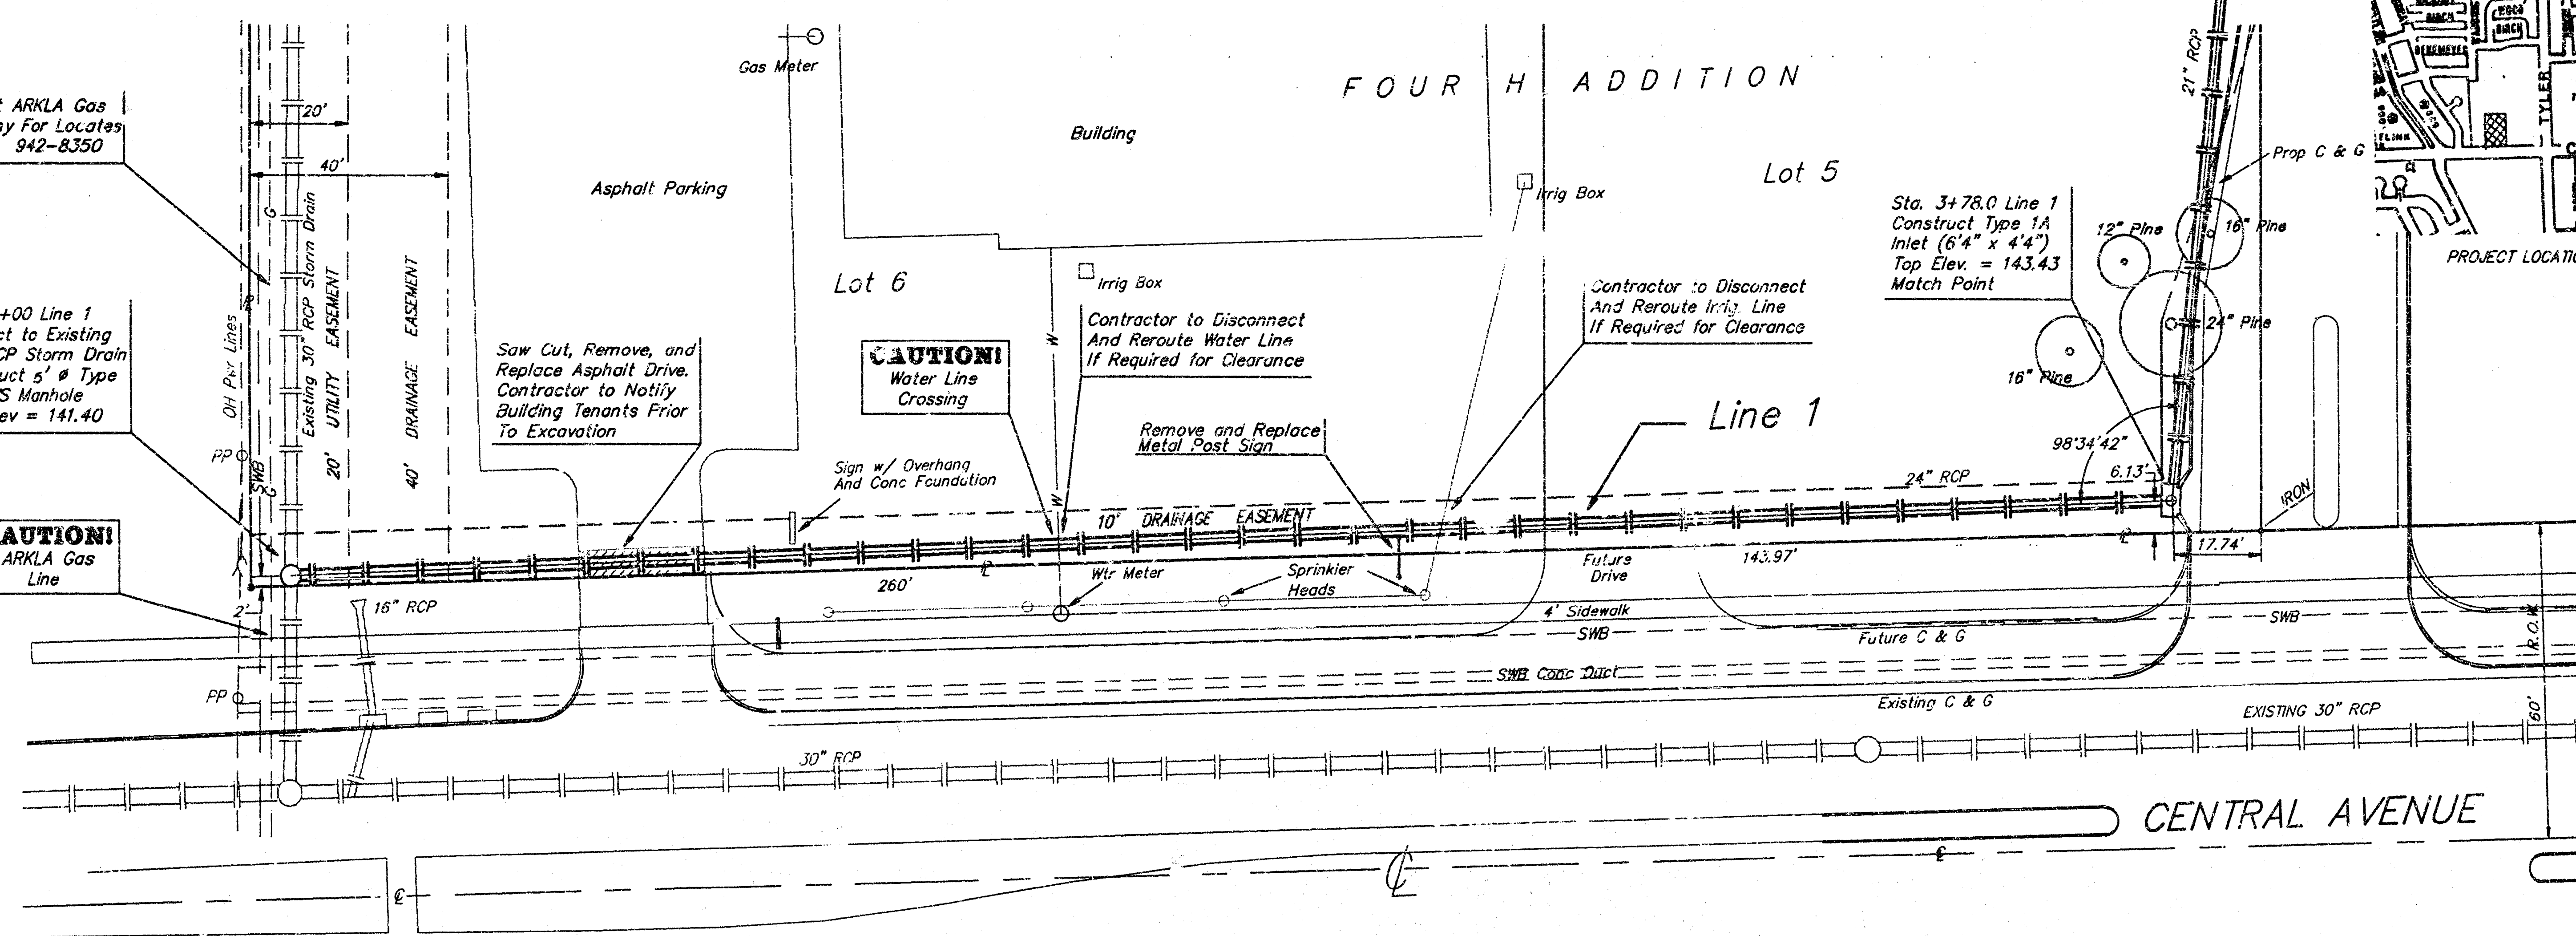

BENCHMARK:
City of Wichita Bench Mark Disk,
562' North and 38' West
of centerline both
Central Avenue and Tyler Road
Elev. = 143.90 City Datum
Elev. = 1331.30 KSL

SCALE:
1" = 20' HORIZONTAL
1" = 5' VERTICAL
• = IRON

APPROVED AS NOTED
BY CITY ENGINEER OF WICHITA

Sanitary Sewers _____

Storm Sewers VRH 11/8/93



Driveway Approaches _____

Water Mains _____

Paving _____


NOTE TO CONTRACTORS

Inspection and testing for this project is to be provided by a Licensed Consulting Engineering Firm under contract with the Owner/Developer. Said inspection to be in accordance with the City of Wichita standard construction engineering practices and certified by a Licensed Professional Engineer. No work shall be performed in dedicated easements or public right-of-way by the Contractor without such inspection nor shall any work be commenced without written authorization by the City Engineer.

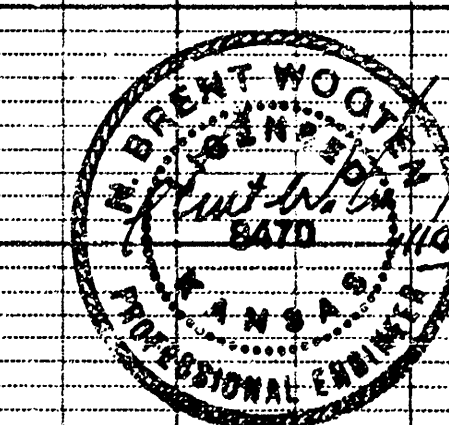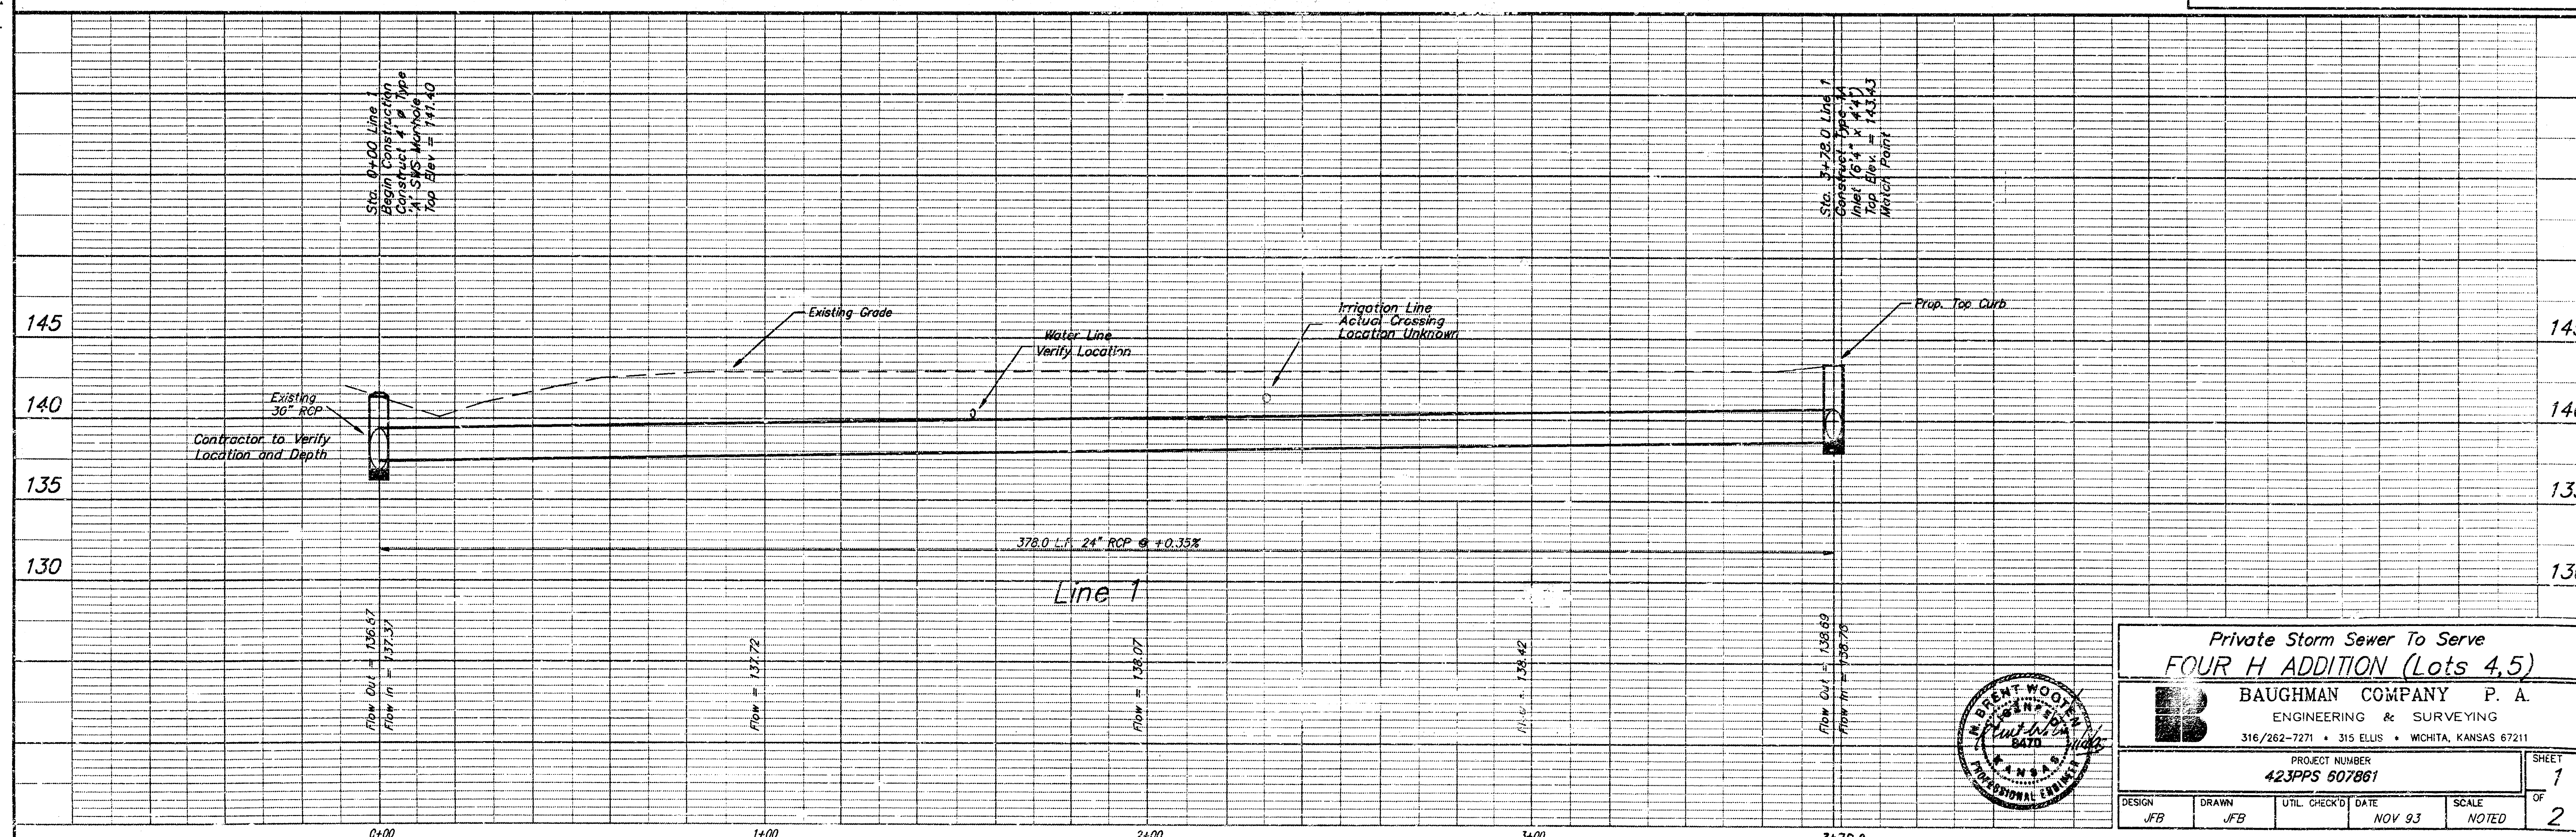


Private Storm Sewer To Serve FOUR H ADDITION (Lots 4,5)			
BAUGHMAN COMPANY P. A. ENGINEERING & SURVEYING 316/262-7271 • 315 ELLIS • WICHITA, KANSAS 67211			
PROJECT NUMBER 423PPS 607861		SHEET 1 OF 2	
DESIGN JFB	DRAWN JFB	UTIL. CHECK'D NOV 93	SCALE NOTED

249 834

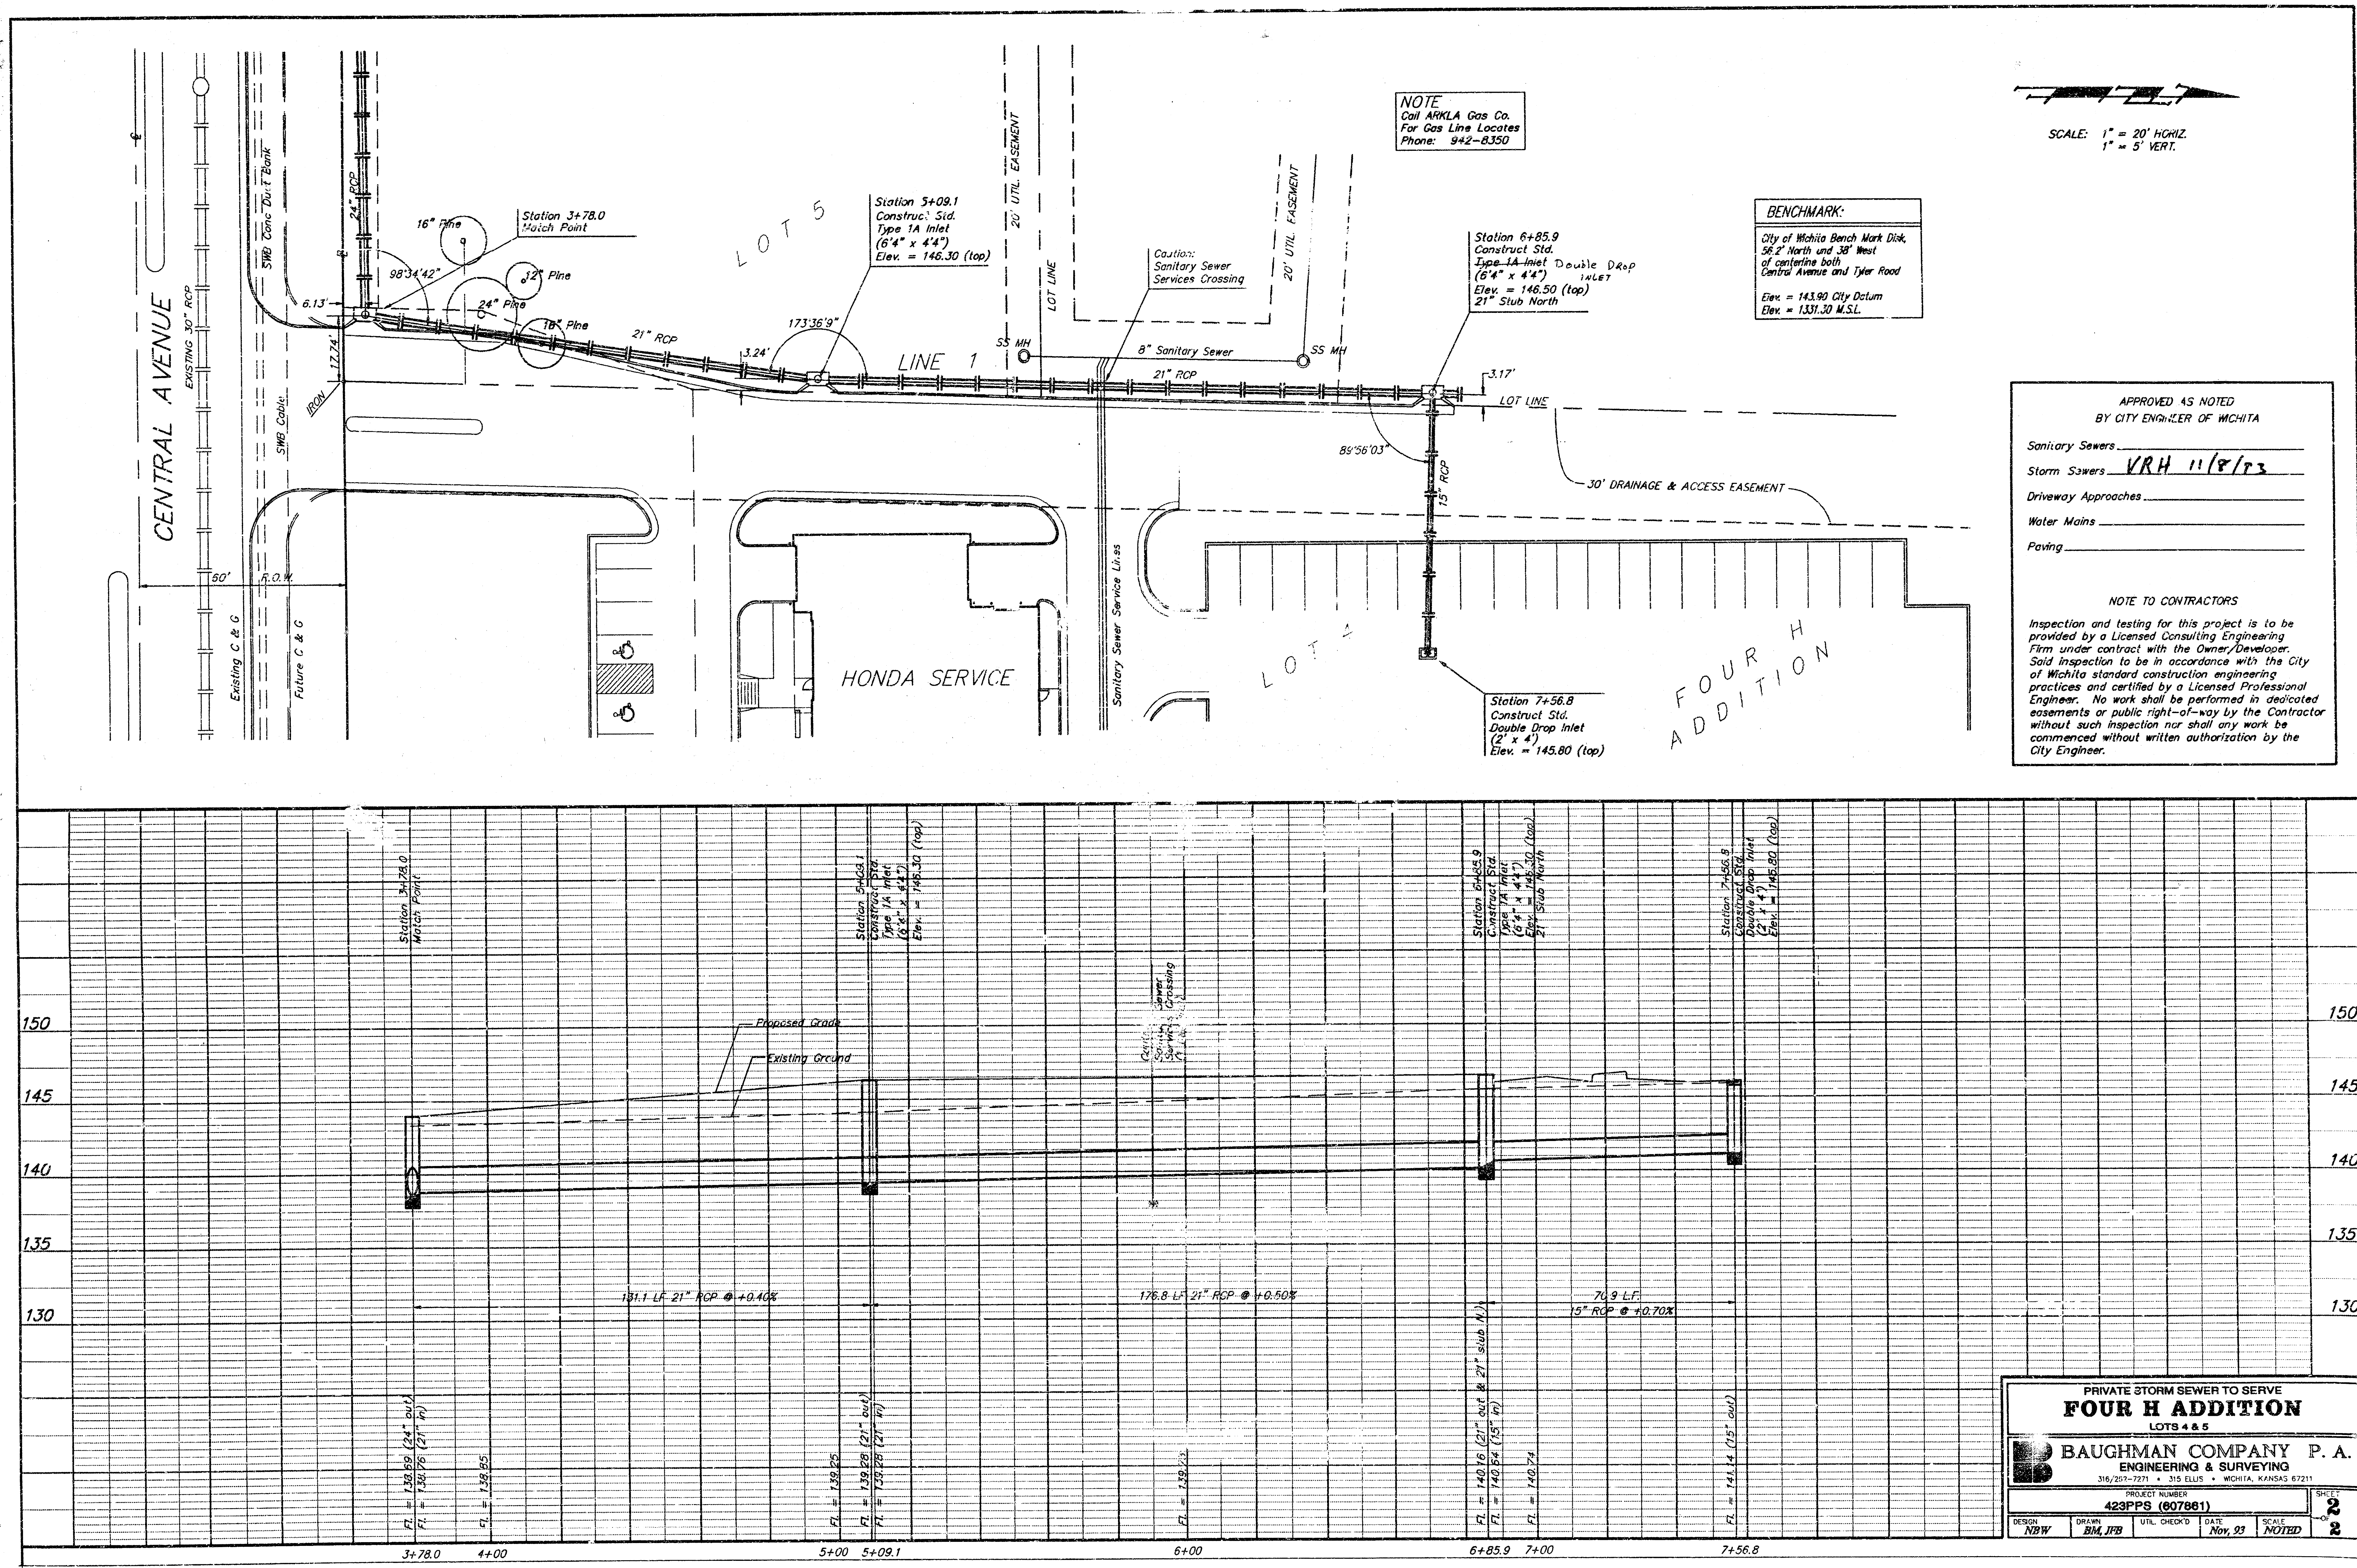

10-1-1-10

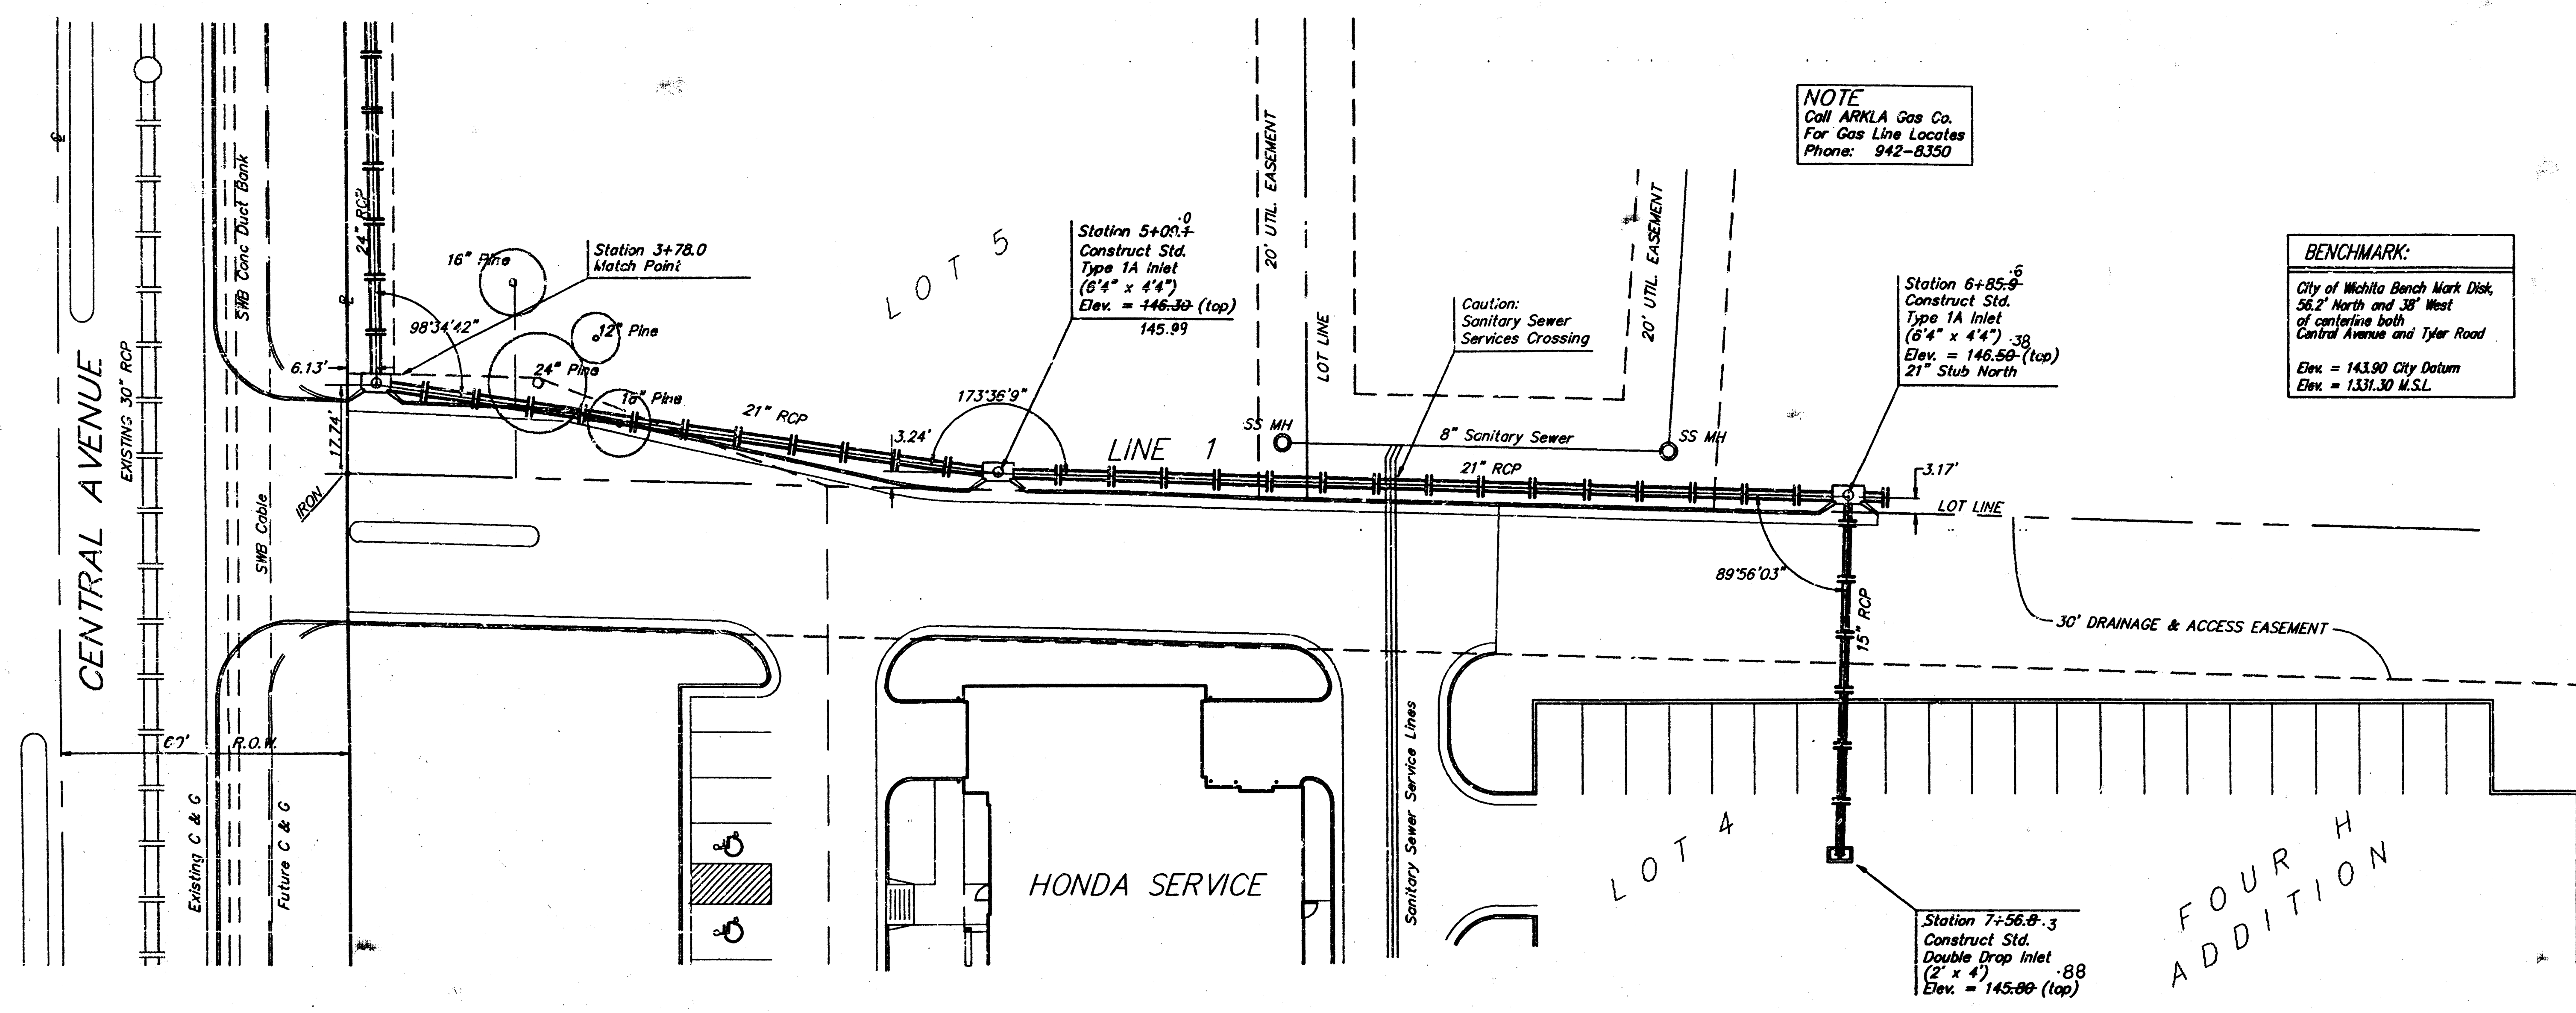


SCALE: 1" = 20' HORIZ.
1" = 5' VERT.

APPROVED AS NOTED
BY CITY ENGINEER OF WICHITA

Sanitary Sewers _____
Storm Sewers VRH 11/8/93
Driveway Approaches _____
Water Mains _____
Paving _____

NOTE TO CONTRACTORS
Inspection and testing for this project is to be provided by a Licensed Consulting Engineering Firm under contract with the Owner/Developer. Said inspection to be in accordance with the City of Wichita standard construction engineering practices and certified by a Licensed Professional Engineer. No work shall be performed in dedicated easements or public right-of-way by the Contractor without such inspection nor shall any work be commenced without written authorization by the City Engineer.

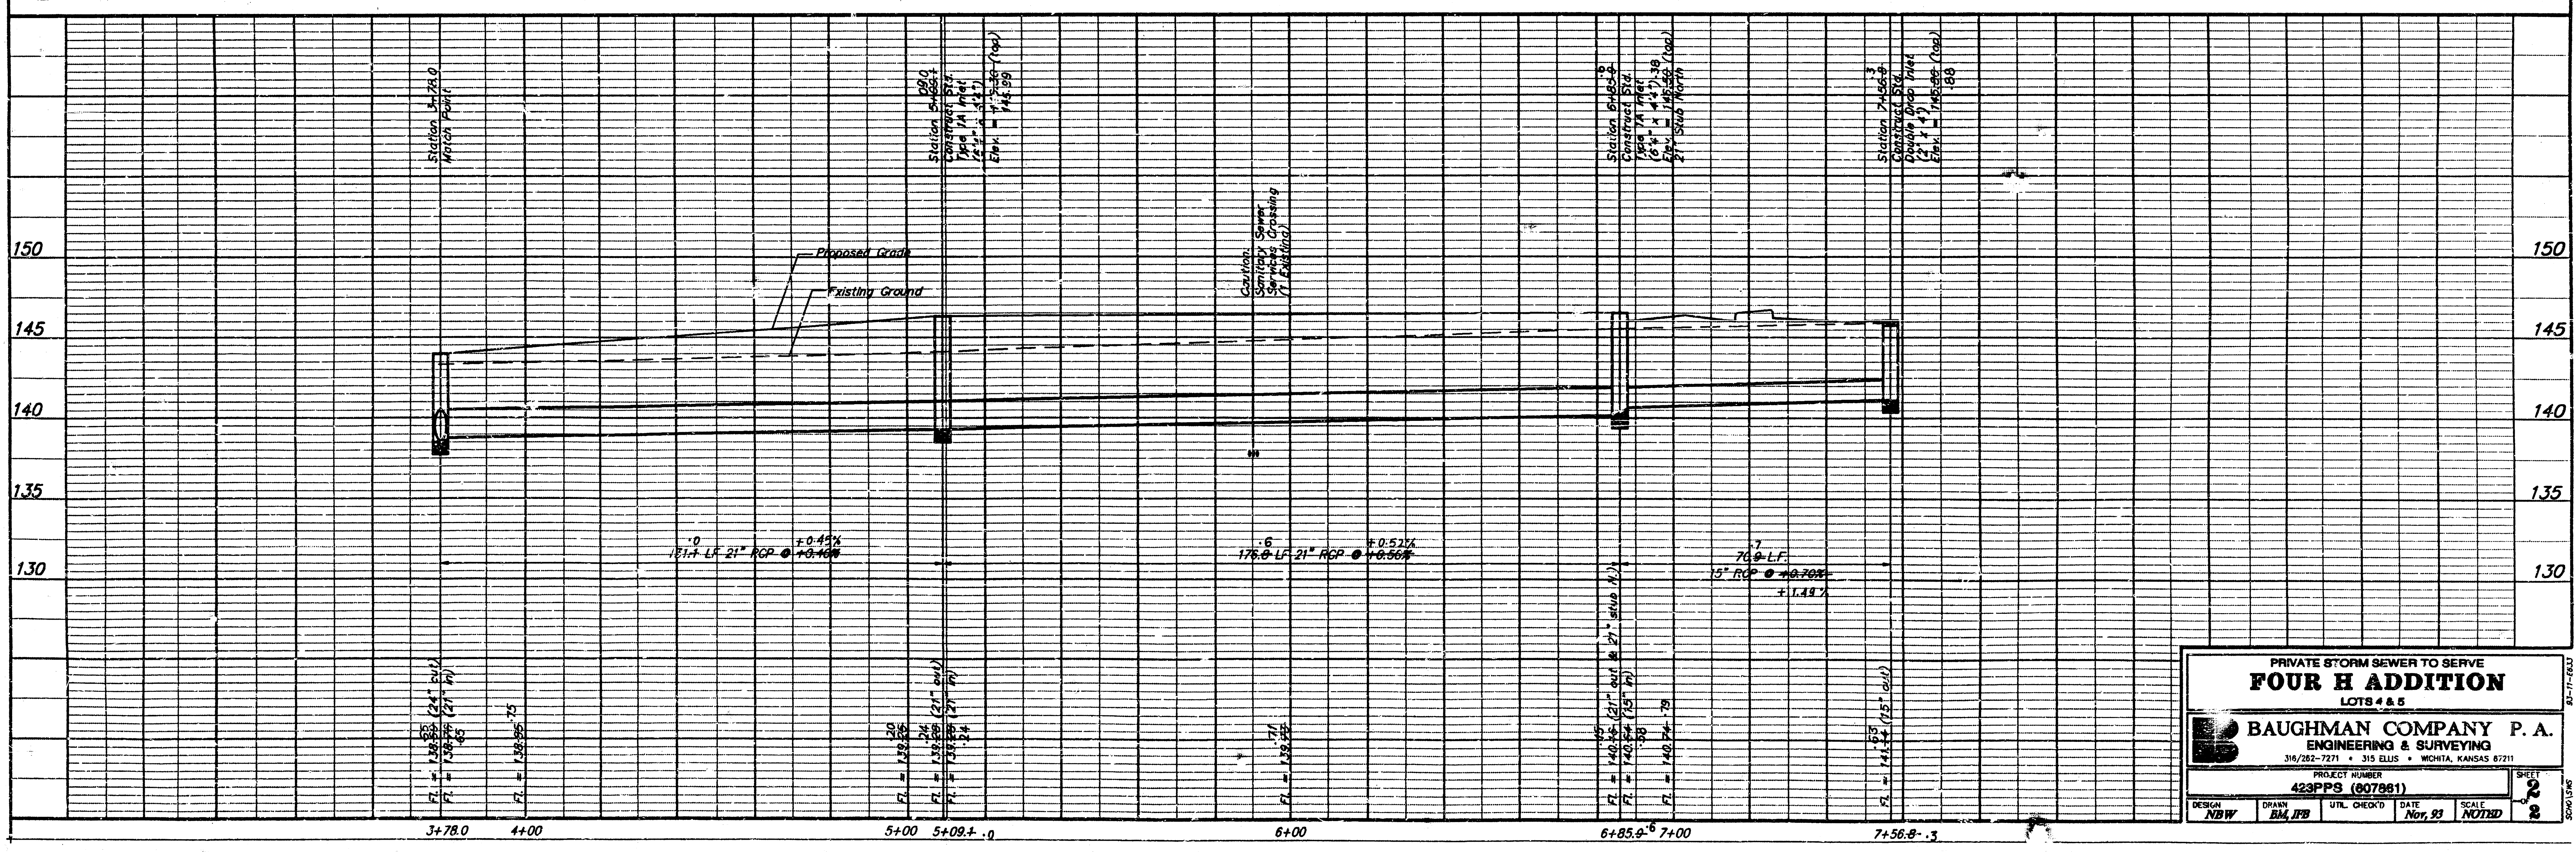

**PRIVATE STORM SEWER TO SERVE
FOUR H ADDITION
LOTS 4 & 5**

BAUGHMAN COMPANY P.A.
ENGINEERING & SURVEYING
316/282-7271 • 315 ELLIS • WICHITA, KANSAS 67211

PROJECT NUMBER
423PPS (807881)

DESIGN **NEW** DRAIN **BM, PB** UTIL CHECK **DATE** **NOTED** SCALE **NOTED** SHEET **2**